

NOTE: MVA #6 IS FULLY LOW AT -20°C OUTSIDE AIR AND VENT COMMAND.

MVA #1, 4, 6, & 7 ALL SHOULD BE ON A GPL PROGRAM TO MODULATE DAMPER POSITION IN OCCUPIED MODE TO: OA


-60 -40 -20 0
 0% 15% 35% 55%
 (DAMPER TURNDOWN FUNCTION) (THIS COULD BE USED ON STORAGE GARAGE AS WELL WITH PERHAPS AN ADJUST ZERO POINT)

SETPOINT DAMPER POSITION =
 50 + (0.1A.T_{temp})
 50 + (-18) = 32%
 50 + (-20) = 30%
 50 + (-30) = 20%
 50 + (-40) = 10%

LEGEND

- Point Desc. - DC-9100 DIGITAL CONTROLLER
- Term. Number - TERMINATIONS
- CO2 - CARBON DIOXIDE SENSOR
- CR - 24VAC CONTROL RELAY*
- DPS - DIFFERENTIAL PRESSURE SWITCH
- DPT - DIFFERENTIAL PRESSURE TRANSDUCER*
- TE - 1000Ω RESISTIVE TEMPERATURE ELEMENT
- VRT - VOLTAGE IN/RESISTIVE OUT TRANSDUCER*
- * - MOUNTED AT MUA UNIT IN 20" x 20" DDC CONTROL PANEL (REFER DWG. 1501-49)

- (2) - 18/2 TWISTED & SHIELDED CABLE
- (4) - 22/4 TWISTED CABLE

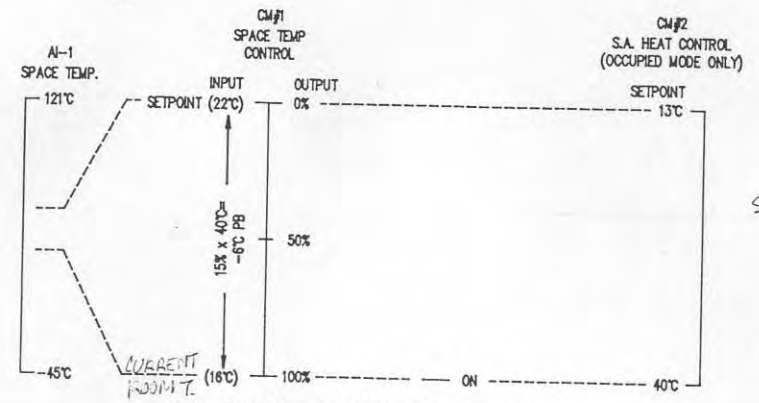

SEE DOW 44

DC-9100 SEQUENCE GRAPH

DRAWING TITLE FT. ROUGE G SECTION MUA UNITS TYPICAL OF MUA-4, 6 & 7		FILE: MUA-6-7	
SALES ENGR	PROJECT MGR	APPL. ENGR	DATE
BH	RC	RC	04/15/82
PROJECT WINNIPEG TRANSIT ADMINISTRATION AND G SECTION METASYS FACILITY MANAGEMENT SYSTEM		CONTRACT NUMBER 91098-5006 DRAWING NUMBER 1501-41C	
JOHNSON CONTROLS Systems & Services Division		204-885-8380	