

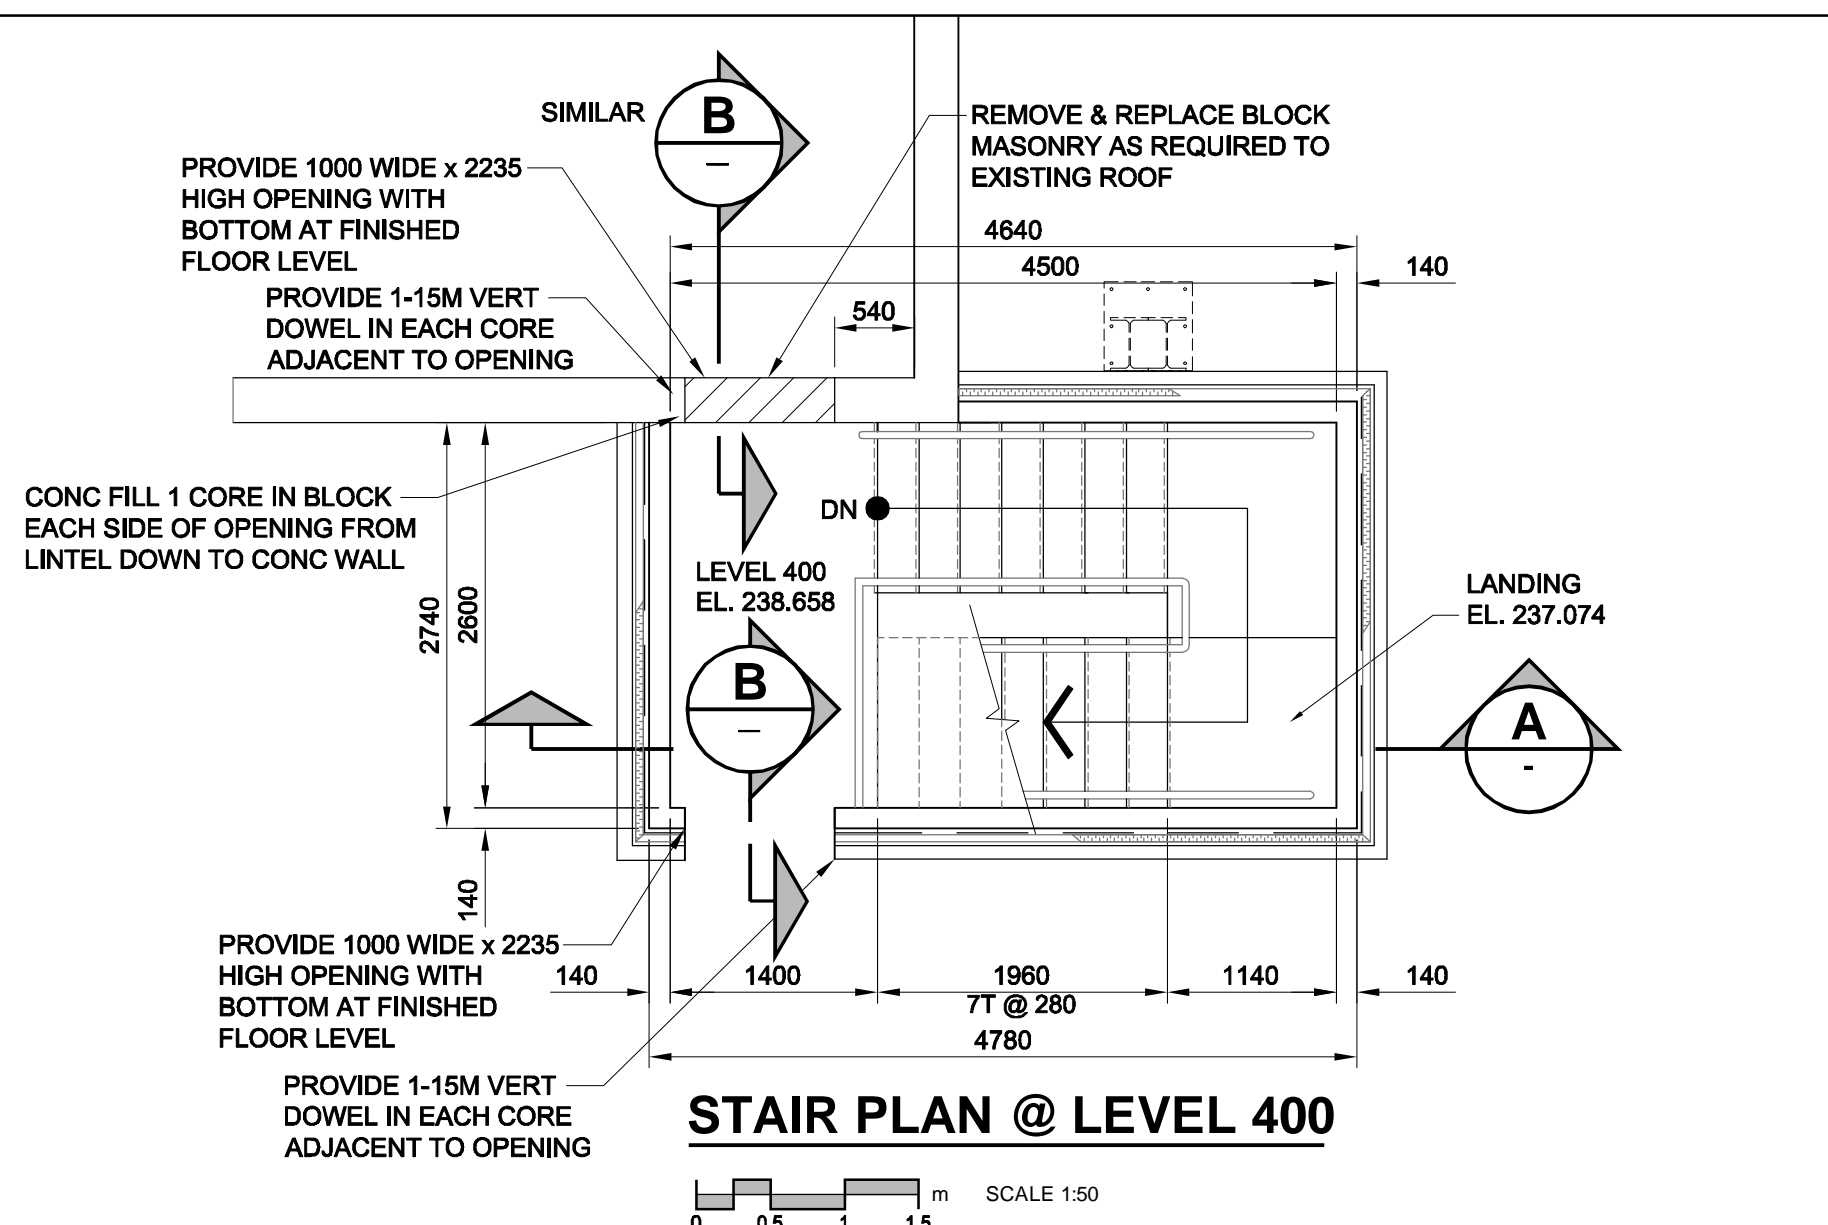


PLOT: 08/01/24 4:16:44 PM


UMA FILE NAME: D265-202-02_S-0012_RX.dwg Saved By: mpetrasanta

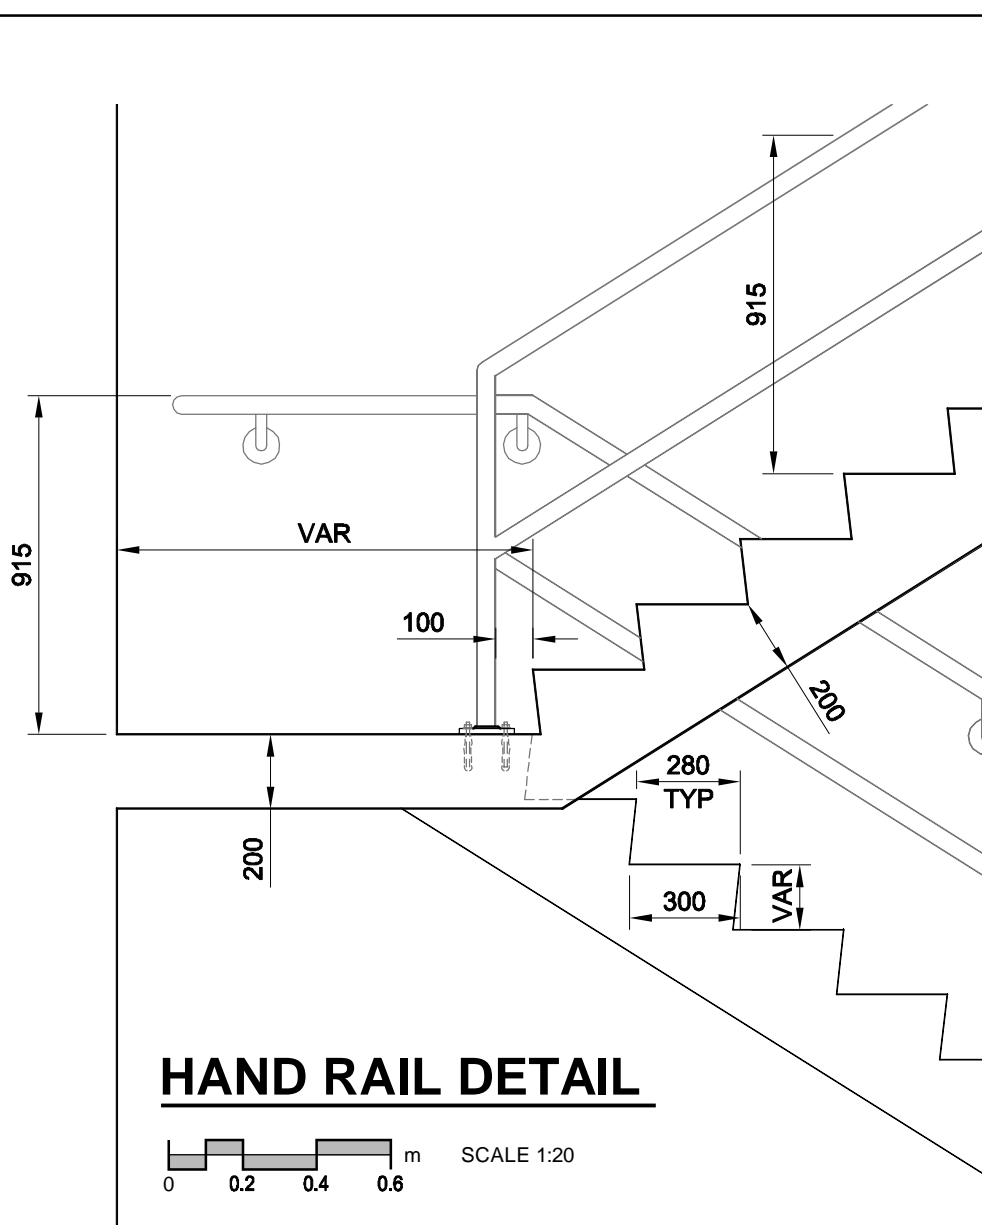



STAIR PLAN @ LEVEL 400

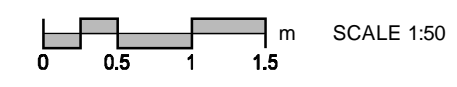



HAND RAIL DETAIL

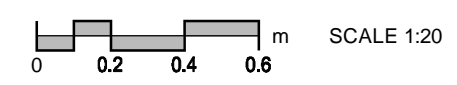



HAND RAIL DETAIL

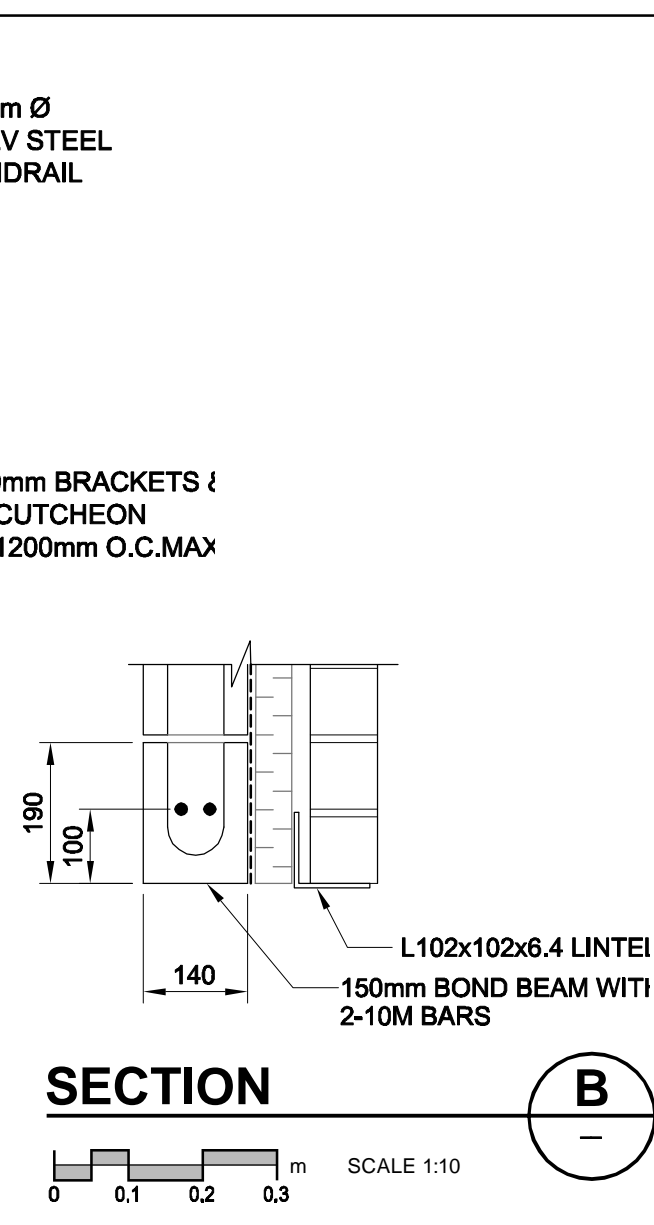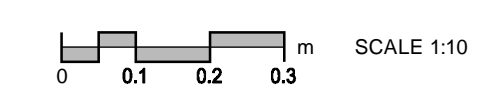


SECTION

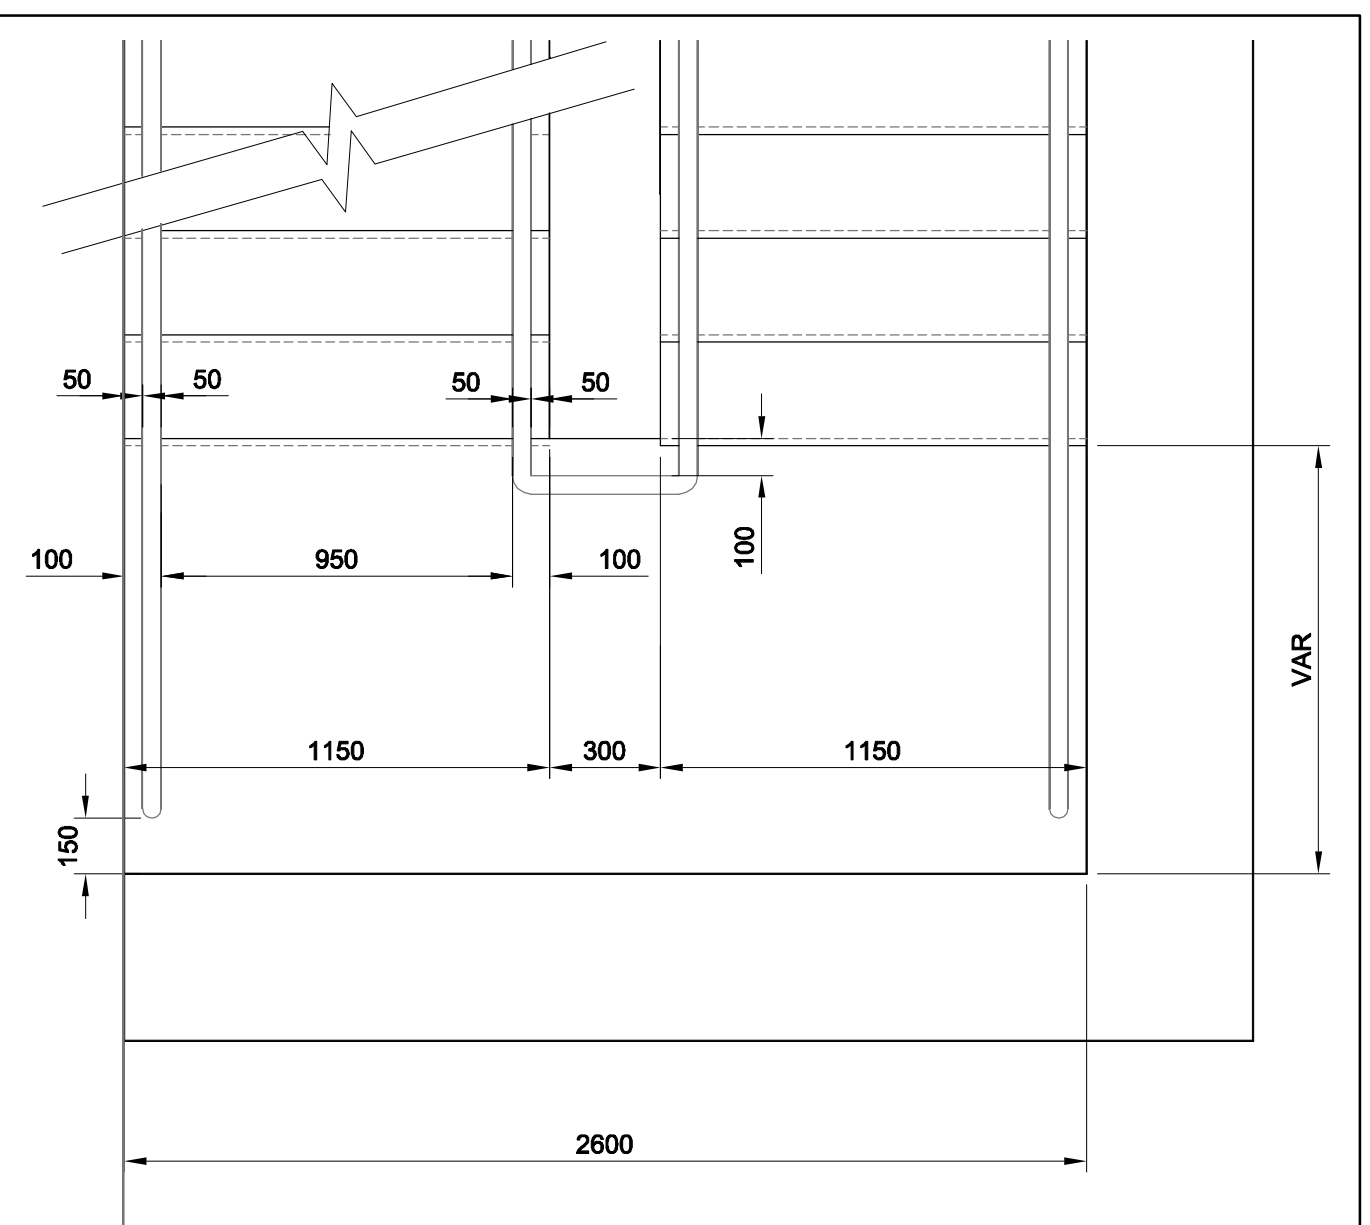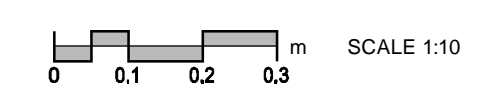


HAND RAIL DETAIL

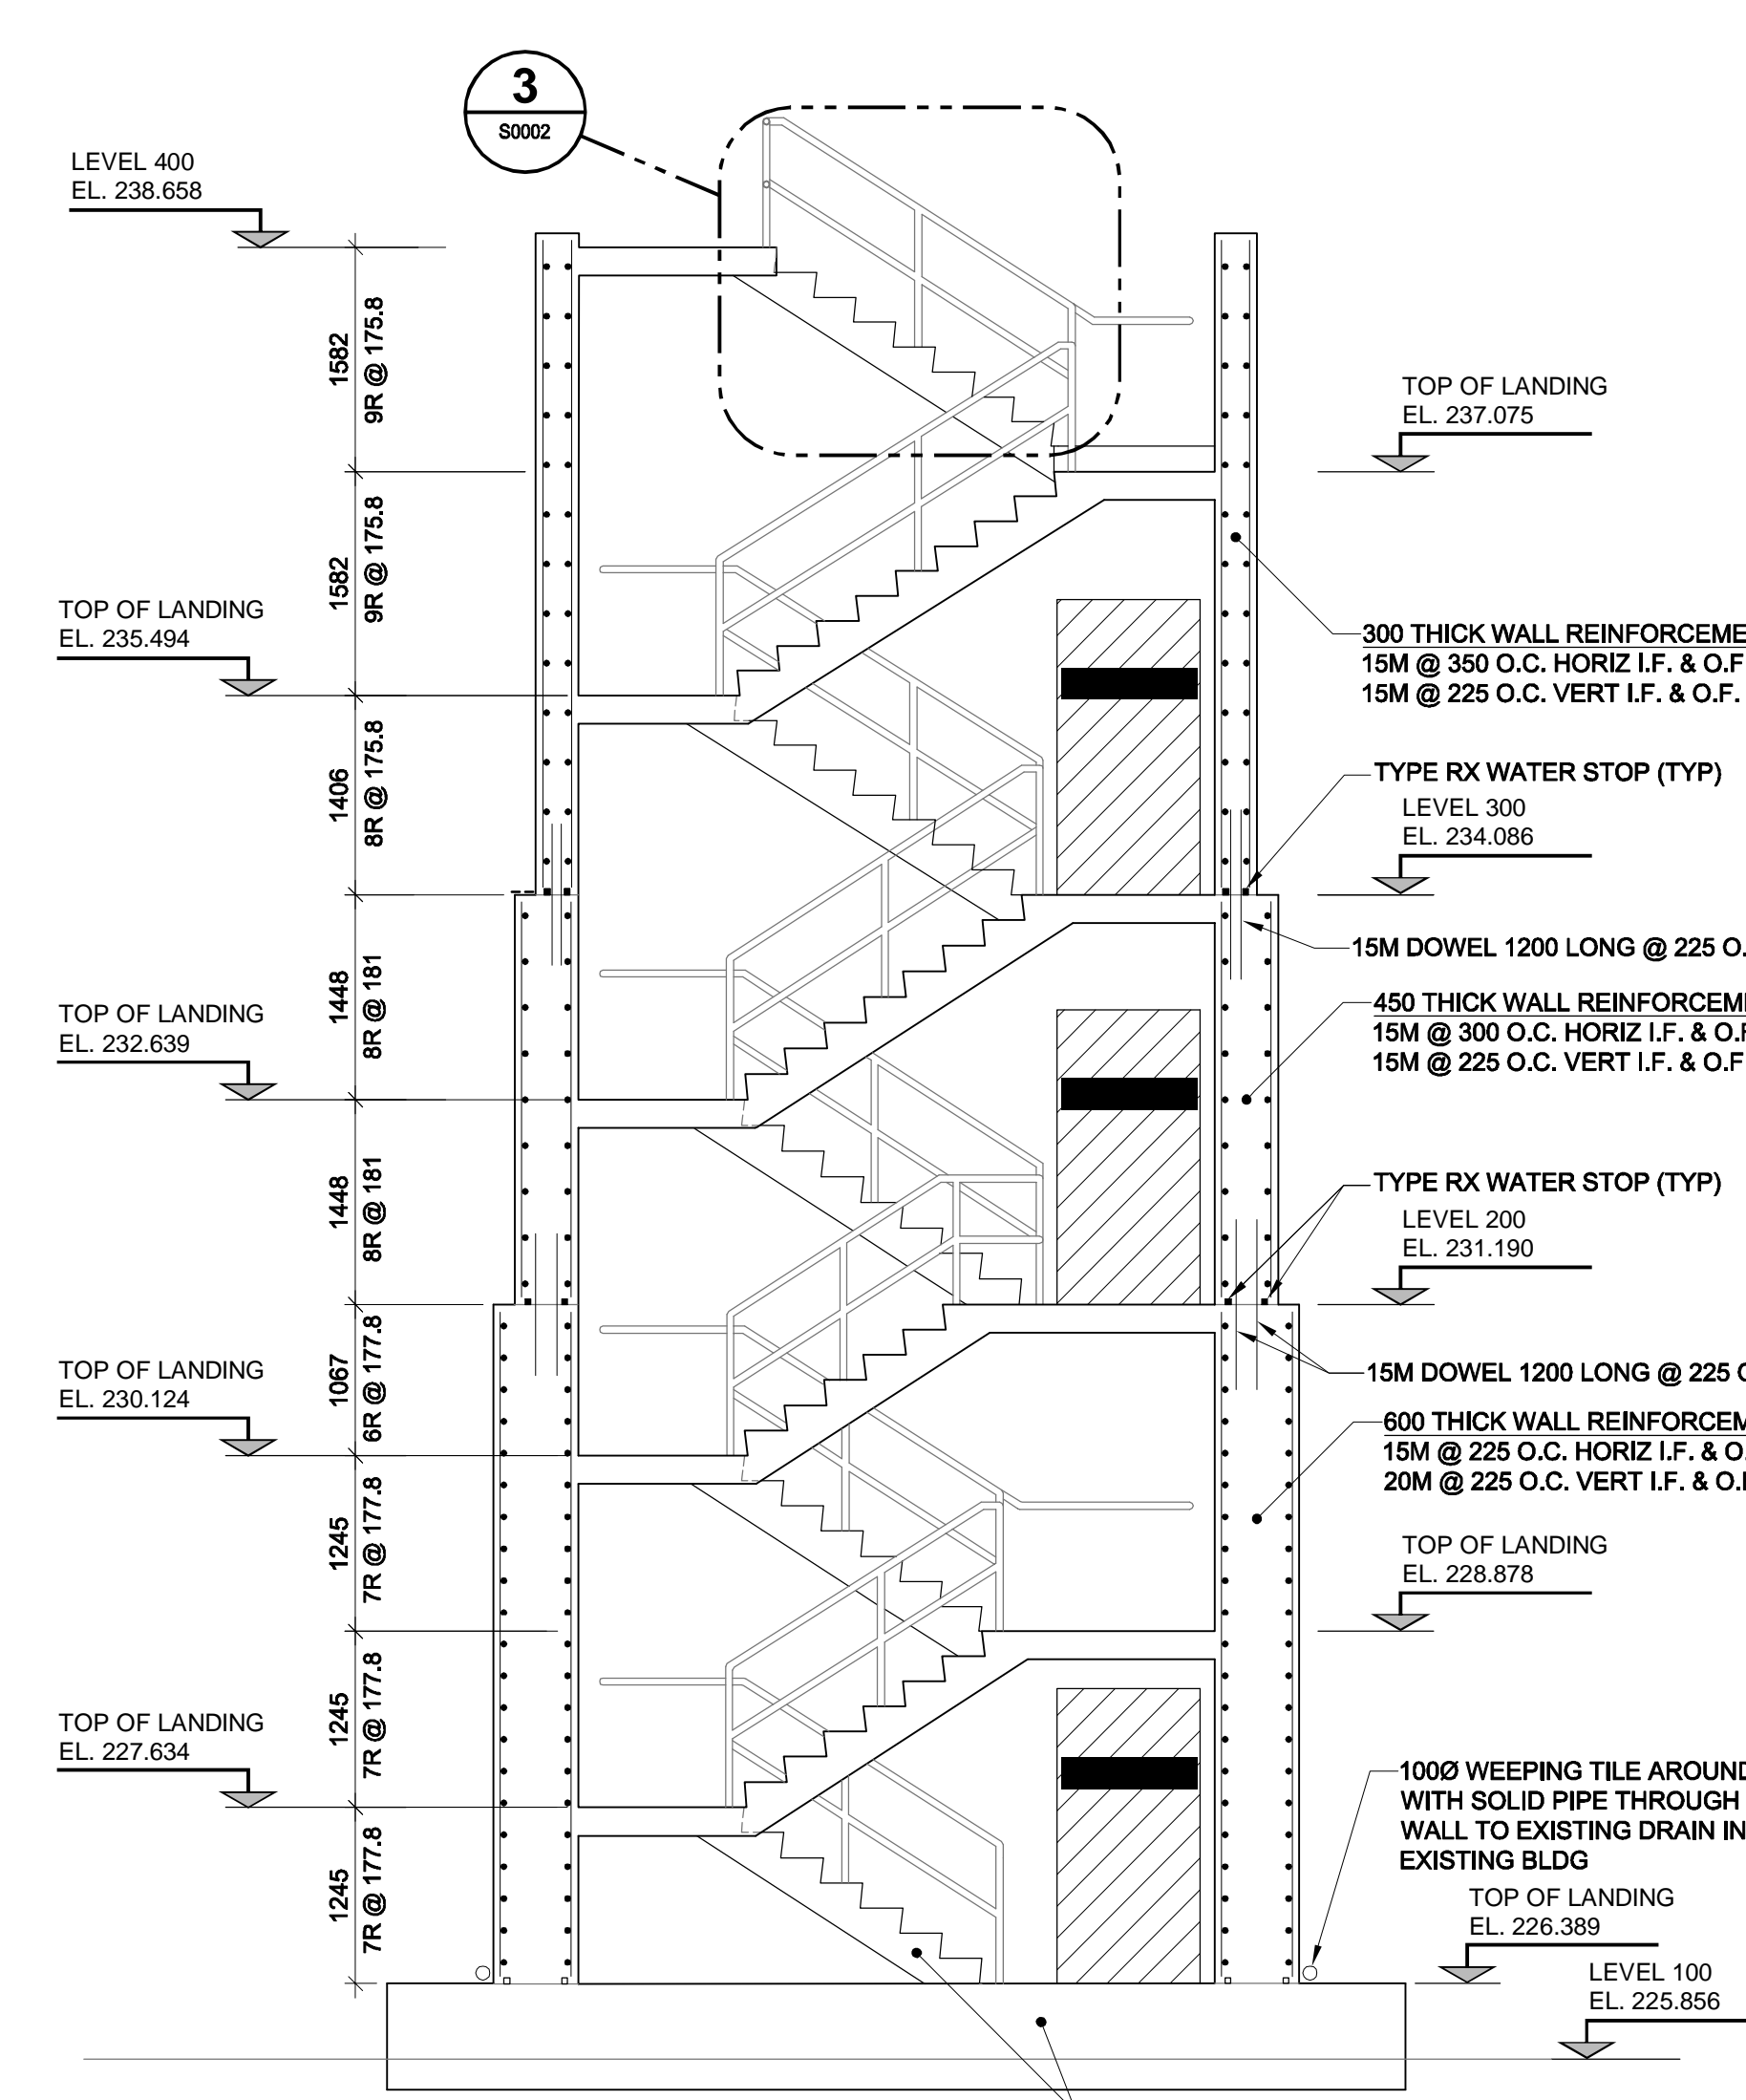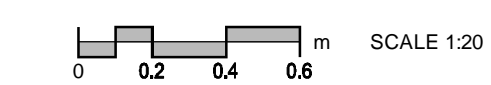


STAIR SECTION

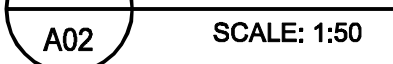



NOTE: DO NOT CUT OPENING UNTIL AFTER WALLS AND STAIRS FOR NEW STAIRS ARE COMPLETED AND THE VERTICAL STEEL BEAMS HAVE BEEN INSTALLED ON INSIDE OF EXISTING WALL

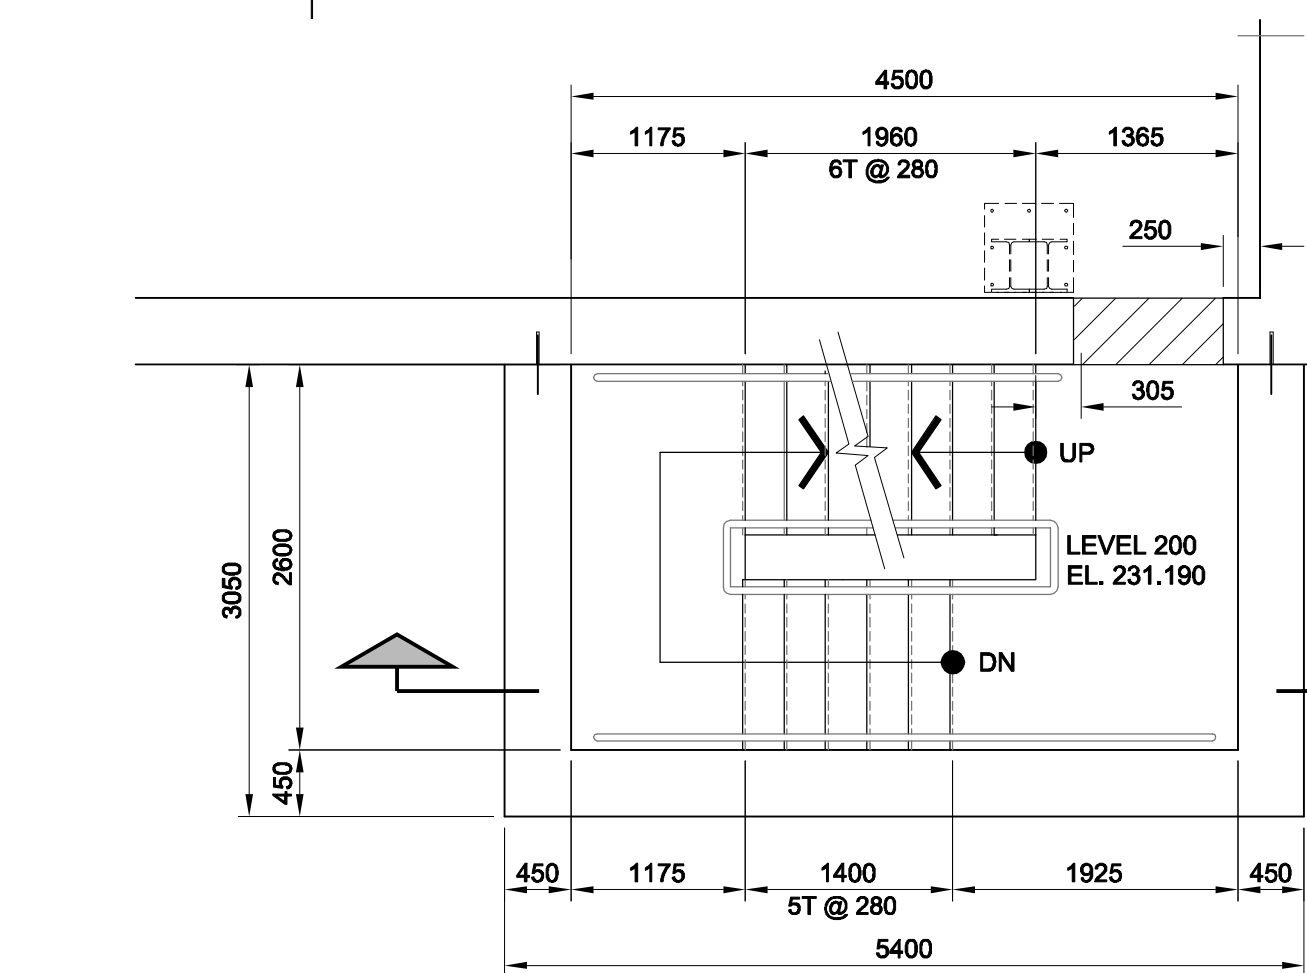


STAIR PLAN @ LEVEL 200

 



STAIR PLAN @ LEVEL 300

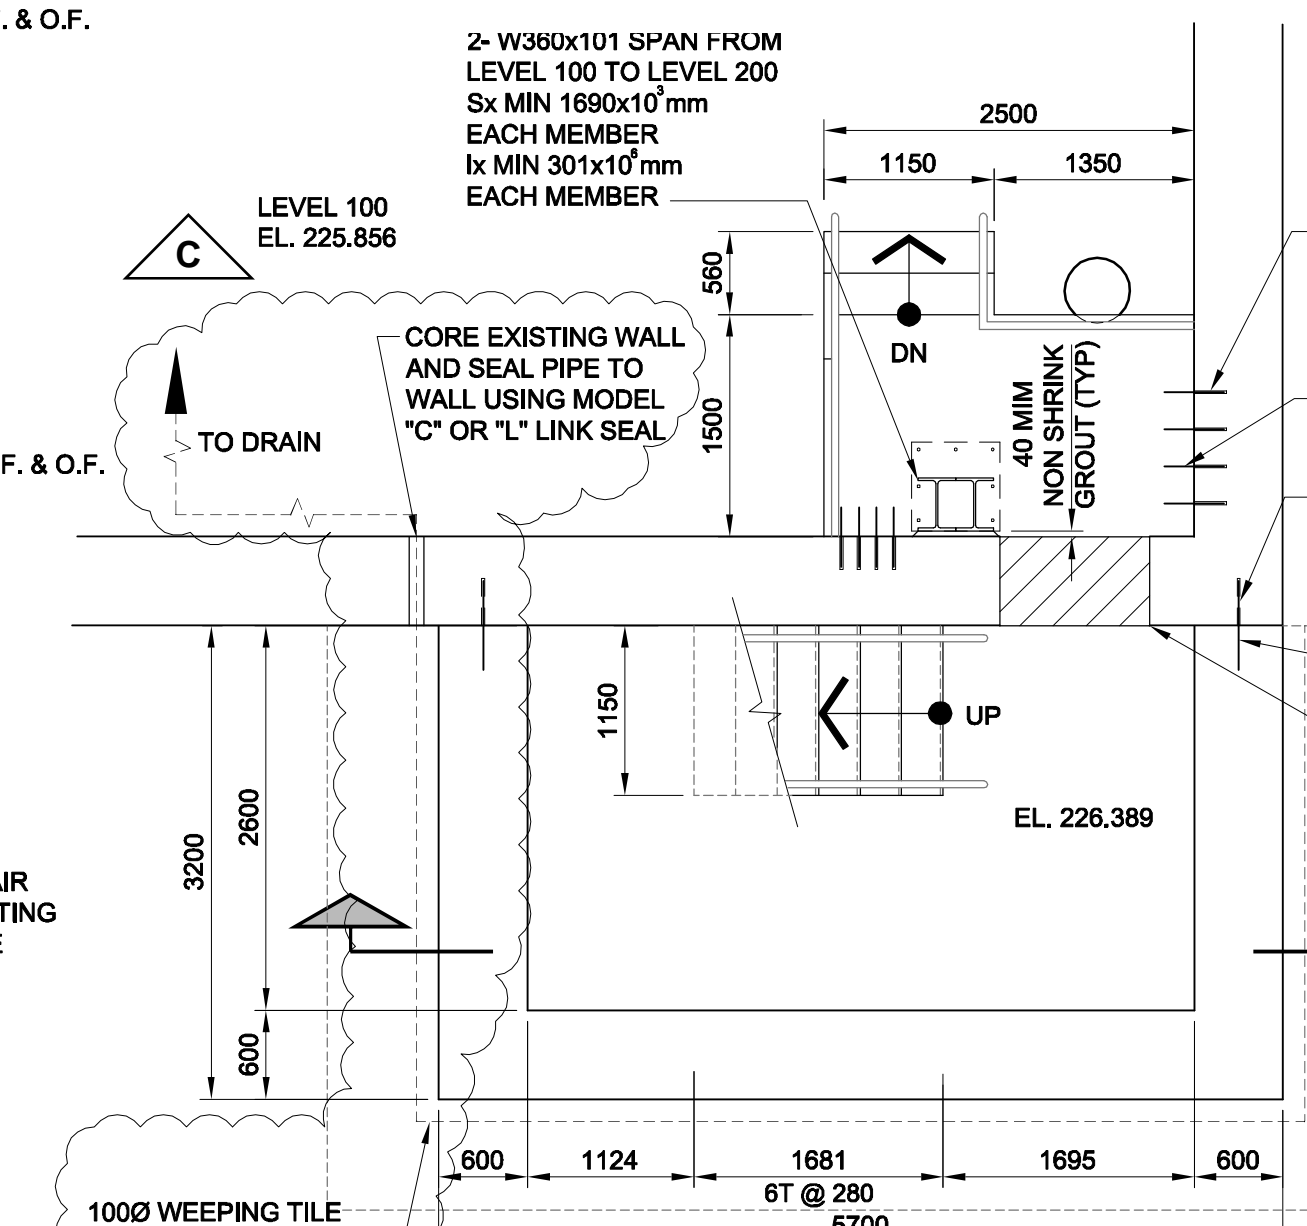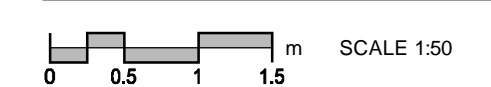


STAIR PLAN @ LEVEL 100

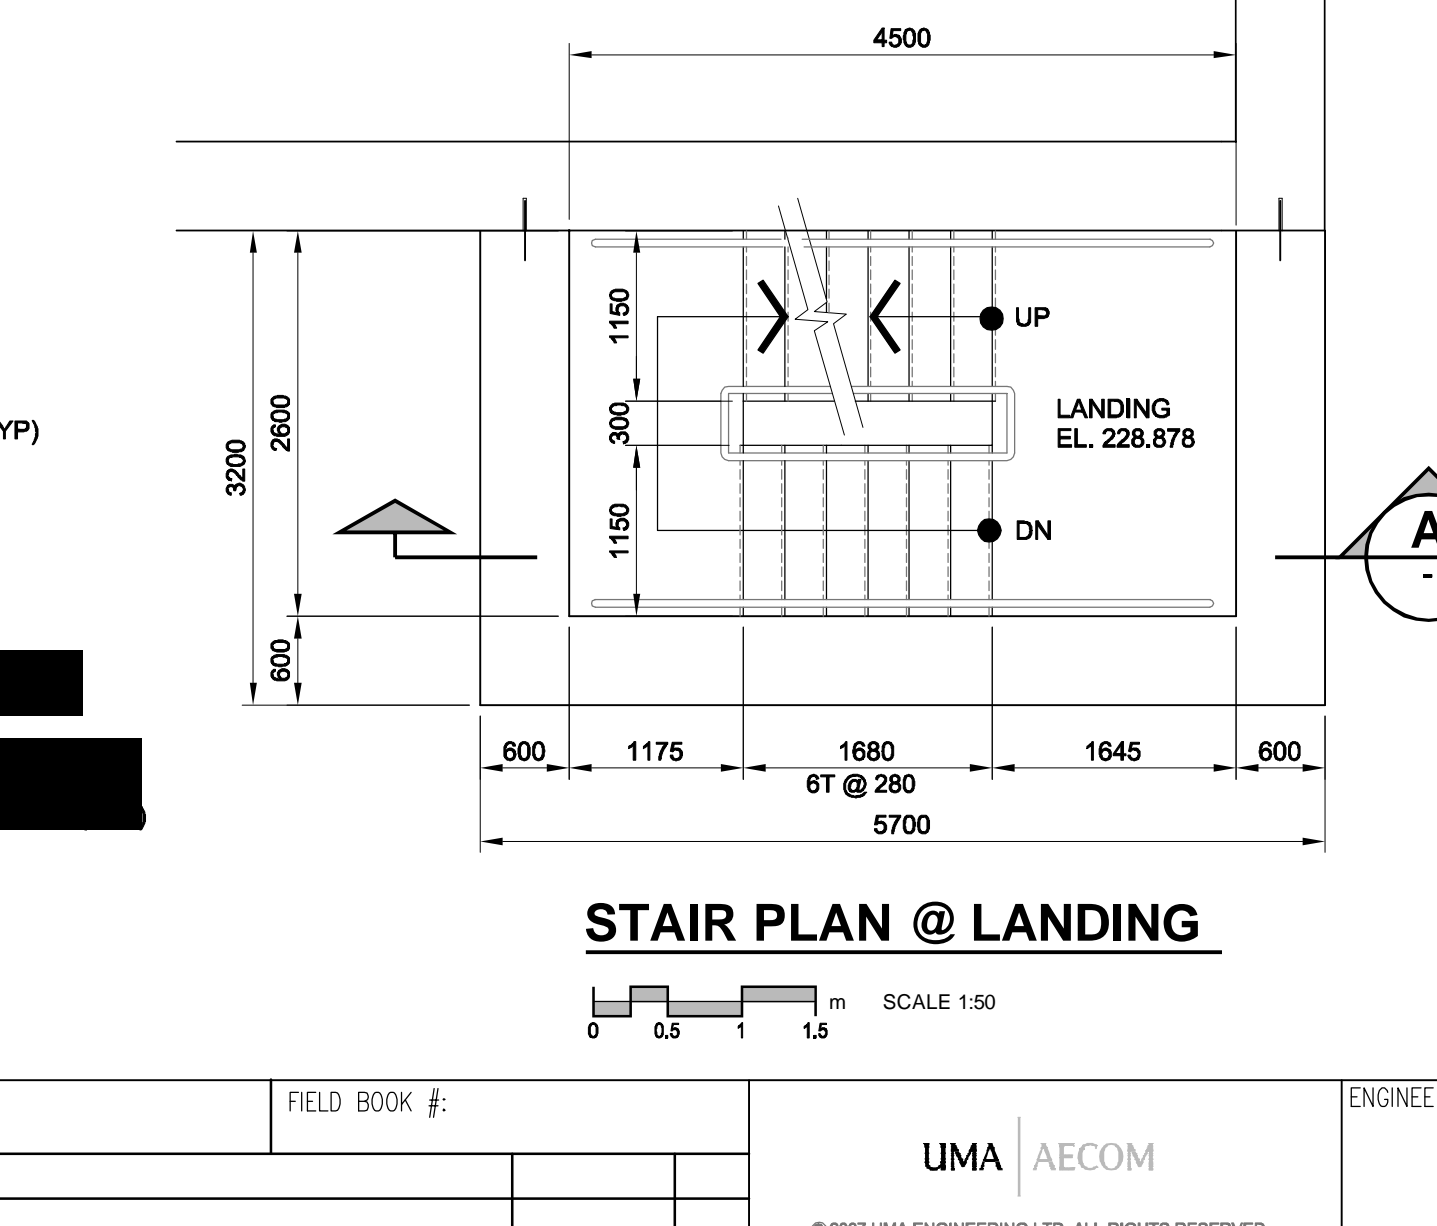

STAIR PLAN @ LANDING

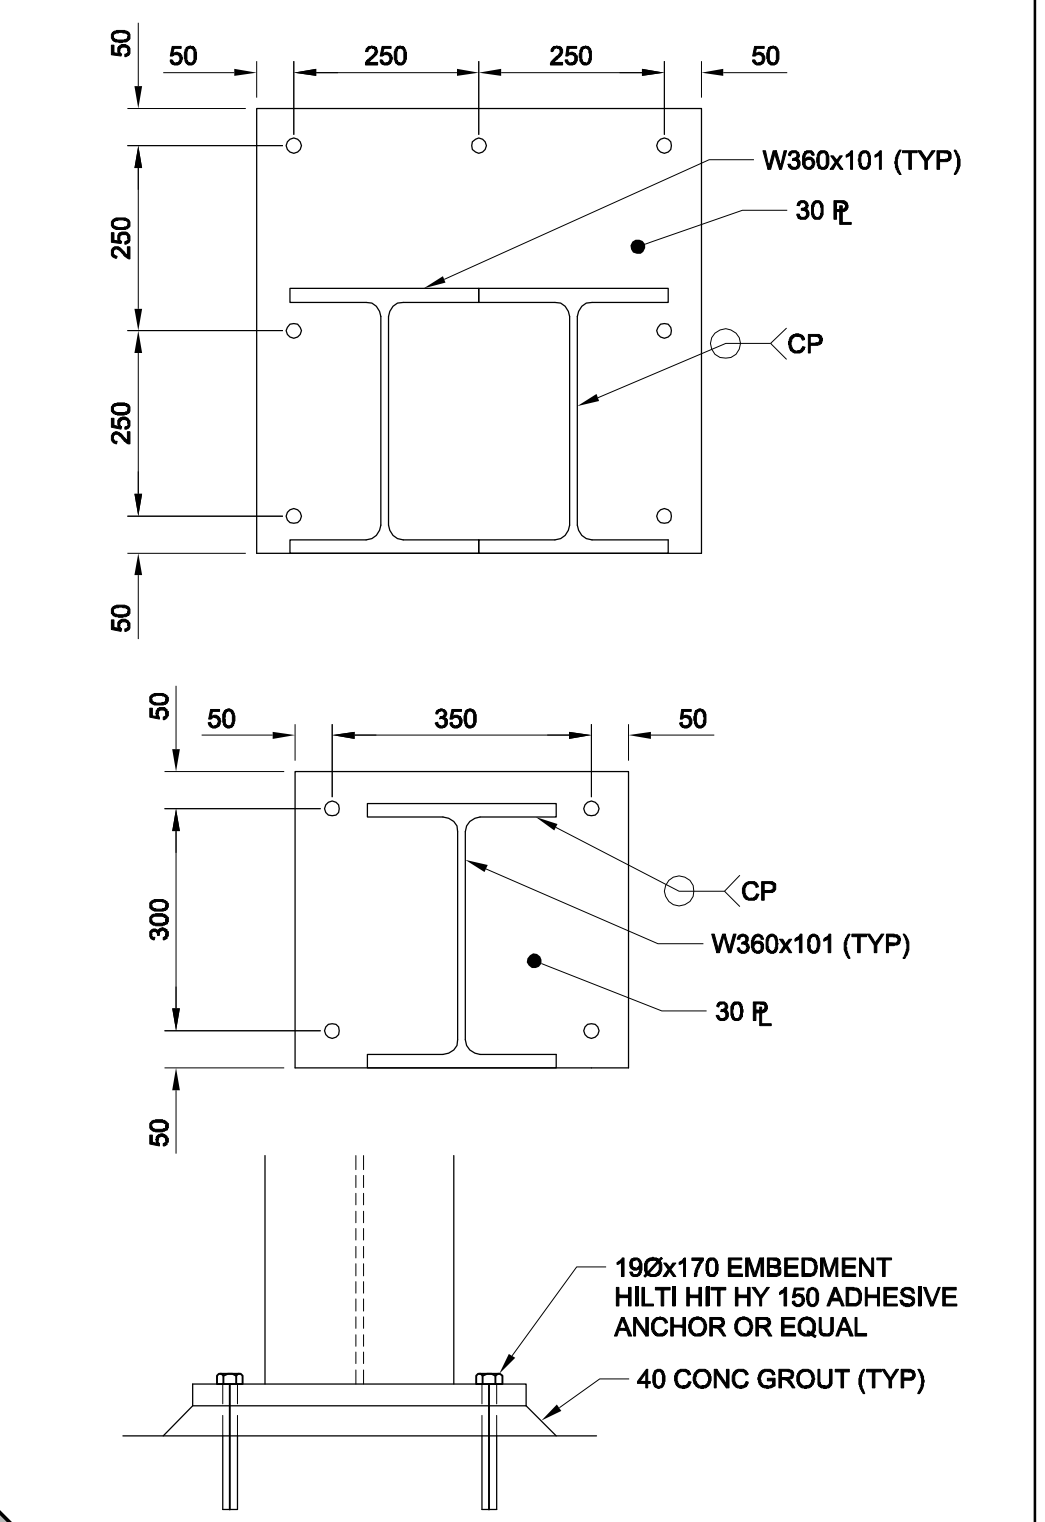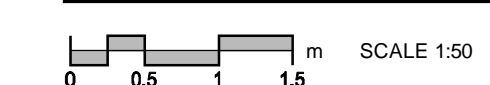

VERT BEAM CONNECTION DETAILS

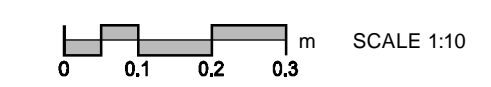

NO.	REVISIONS	DATE	BY	FILENAME: D265-202-02_S-0012_RX.dwg
C	ISSUED FOR ADENDUM 3	08/01/23	MP	
B	ISSUED FOR BID	07/12/14	LJV	
A	ISSUED FOR 100% REVIEW	09/11/07	KMB	

DESIGNED BY	CHECKED BY	APPROVED BY	RELEASED FOR CONSTRUCTION
GEB	----	---	---
WJD	---	---	---
DATE	DATE	DATE	DATE
08/01/23	07/09/12		

APECM
Certificate of Authorization
UMA Engineering Ltd. (MB)
No. 256 Date: 08/01/23

MP	CGC	SBB	SBB	BLL
DRN	CHK	DES	ENG	IDR
UMA REVIEW				

ENGINEER'S SEAL
ISSUE / REVISION C
ISSUED FOR ADDENDUM C
WAS SEALED BY
BARRY BISWANGER
AND DATED
08/01/23

THE CITY OF WINNIPEG
WATER AND WASTE DEPARTMENT

PERIMETER ROAD PUMPING STATION UPGRADES
Contract B - Building Upgrades

Structural - East Stair
PLANS, SECTIONS & DETAILS

CITY DRAWING NUMBER	SHEET	REV.	SIZE
1-0111L-S007	001	C	D