SHEET: COW-A1 (05/2005)

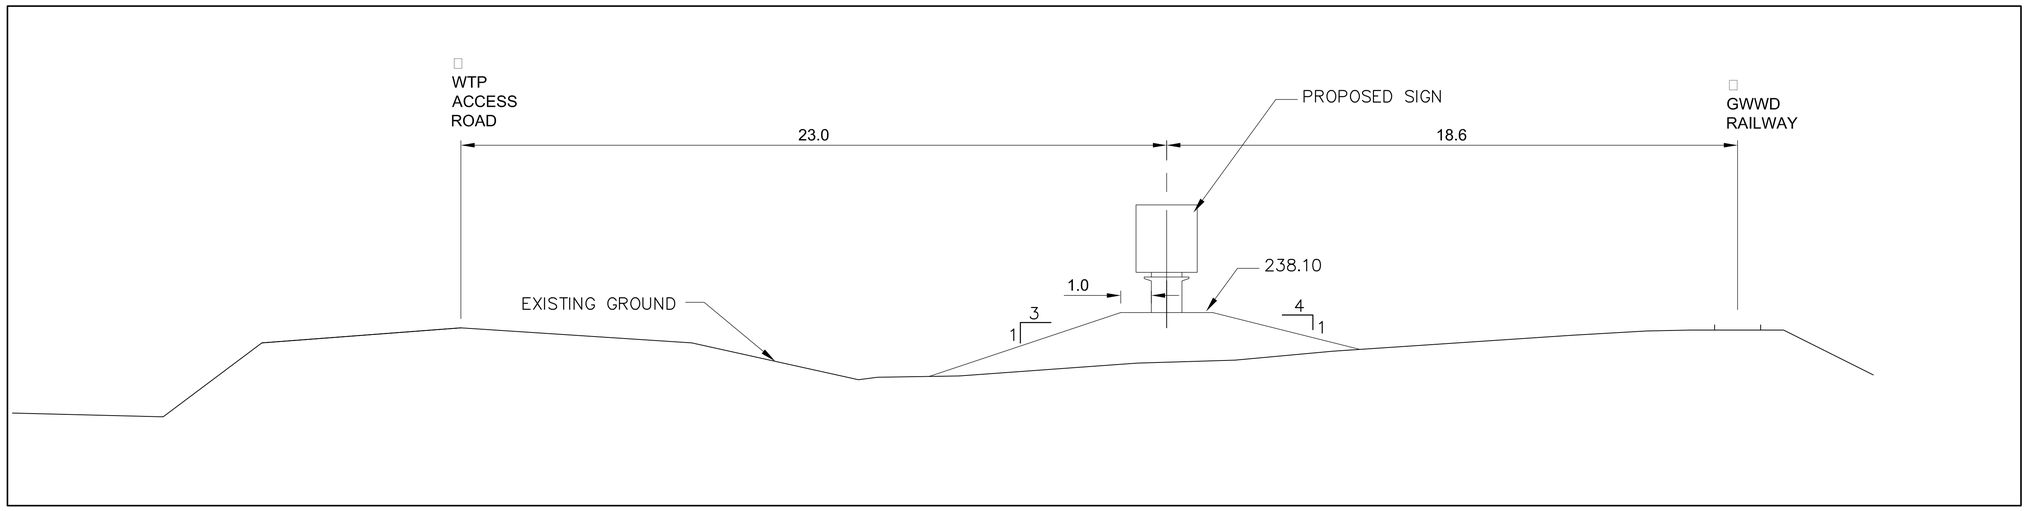

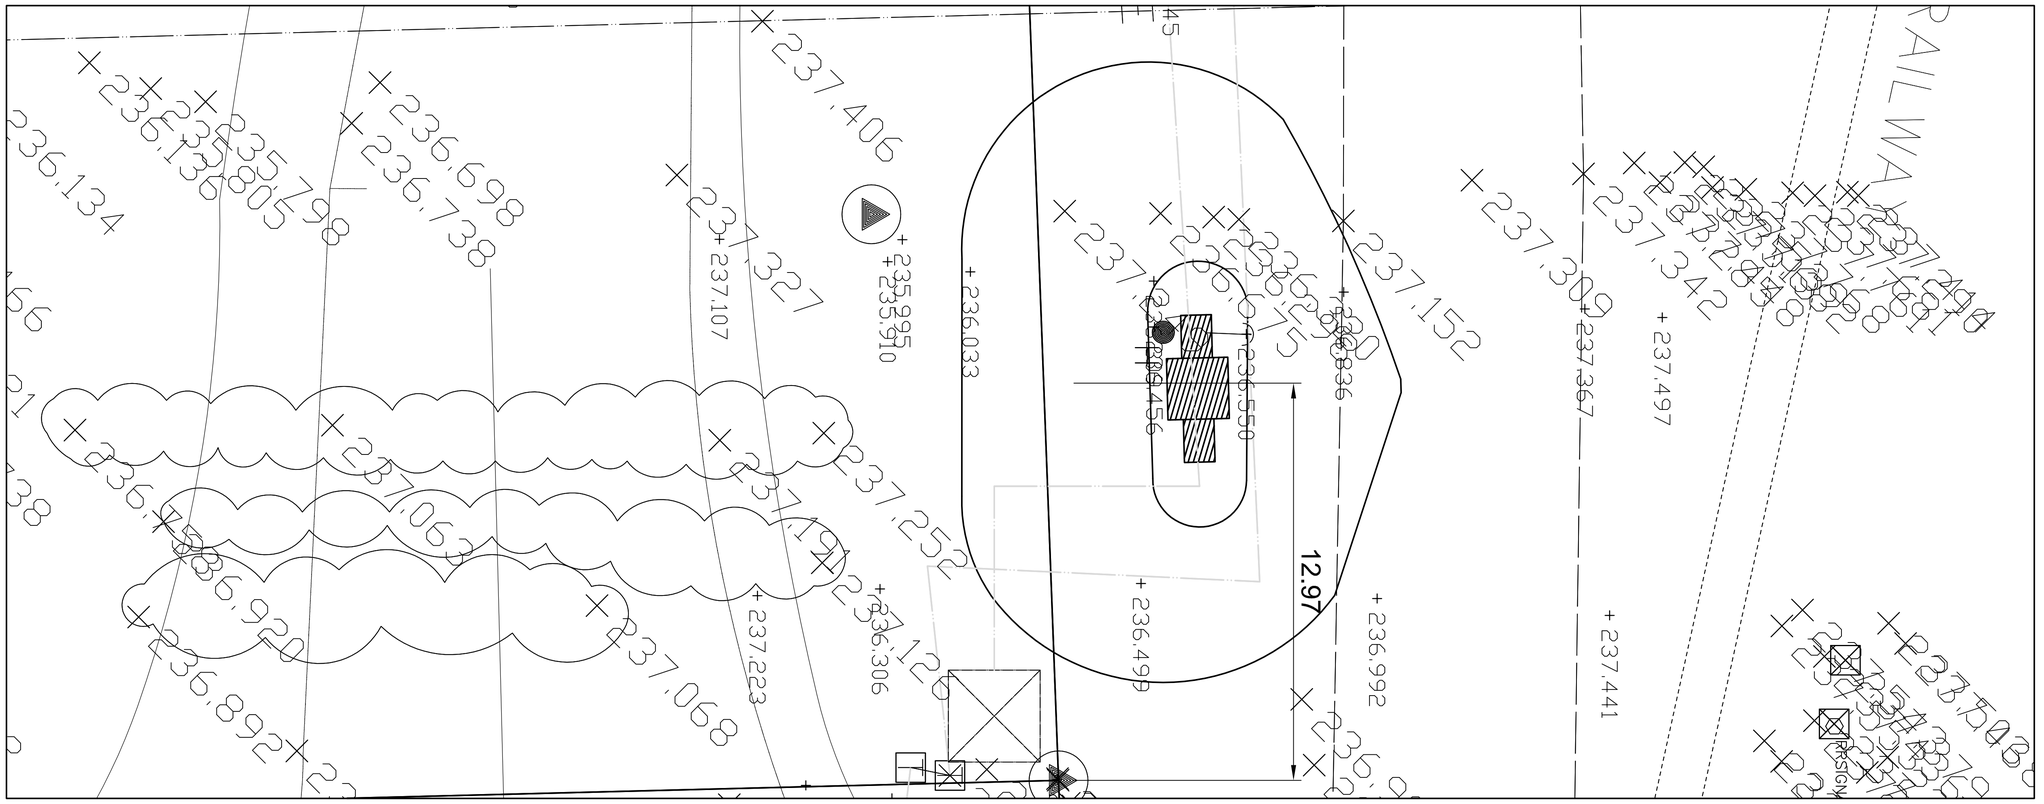

B.M. ELEV.			
01	ADDENDUM 2	07/12/07	PP
NO.	REVISIONS	DATE	BY

CH2MHILL
Frederickson Cooper ARCHITECTS
EarthTech A Tyco International Ltd. Company

DESIGNED BY JNC	CHECKED BY JC
DRAWN BY PAAP	APPROVED BY
SCALE: 1:100	RELEASED FOR CONSTRUCTION BY:
DATE 06/11/24	DATE

ENGINEER'S SEAL

PRELIMINARY
NOT FOR CONSTRUCTION

CONSULTANT DRAWING NO.
SK-1

Winnipeg

THE CITY OF WINNIPEG
WATER AND WASTE DEPARTMENT
ENGINEERING DIVISION

WATER TREATMENT PLANT
CONSTRUCTION OF ROADS AND LANDSCAPING

CIVIL
SIGN LOCATION

CITY FILE NUMBER

SHEET OF

CITY DRAWING NUMBER

Last Save: 2007-12-07 12:12 PM

L:\WORK\79000\79538\02A-CAD\TRA\SKETCH\SIGN SKETCH.DWG