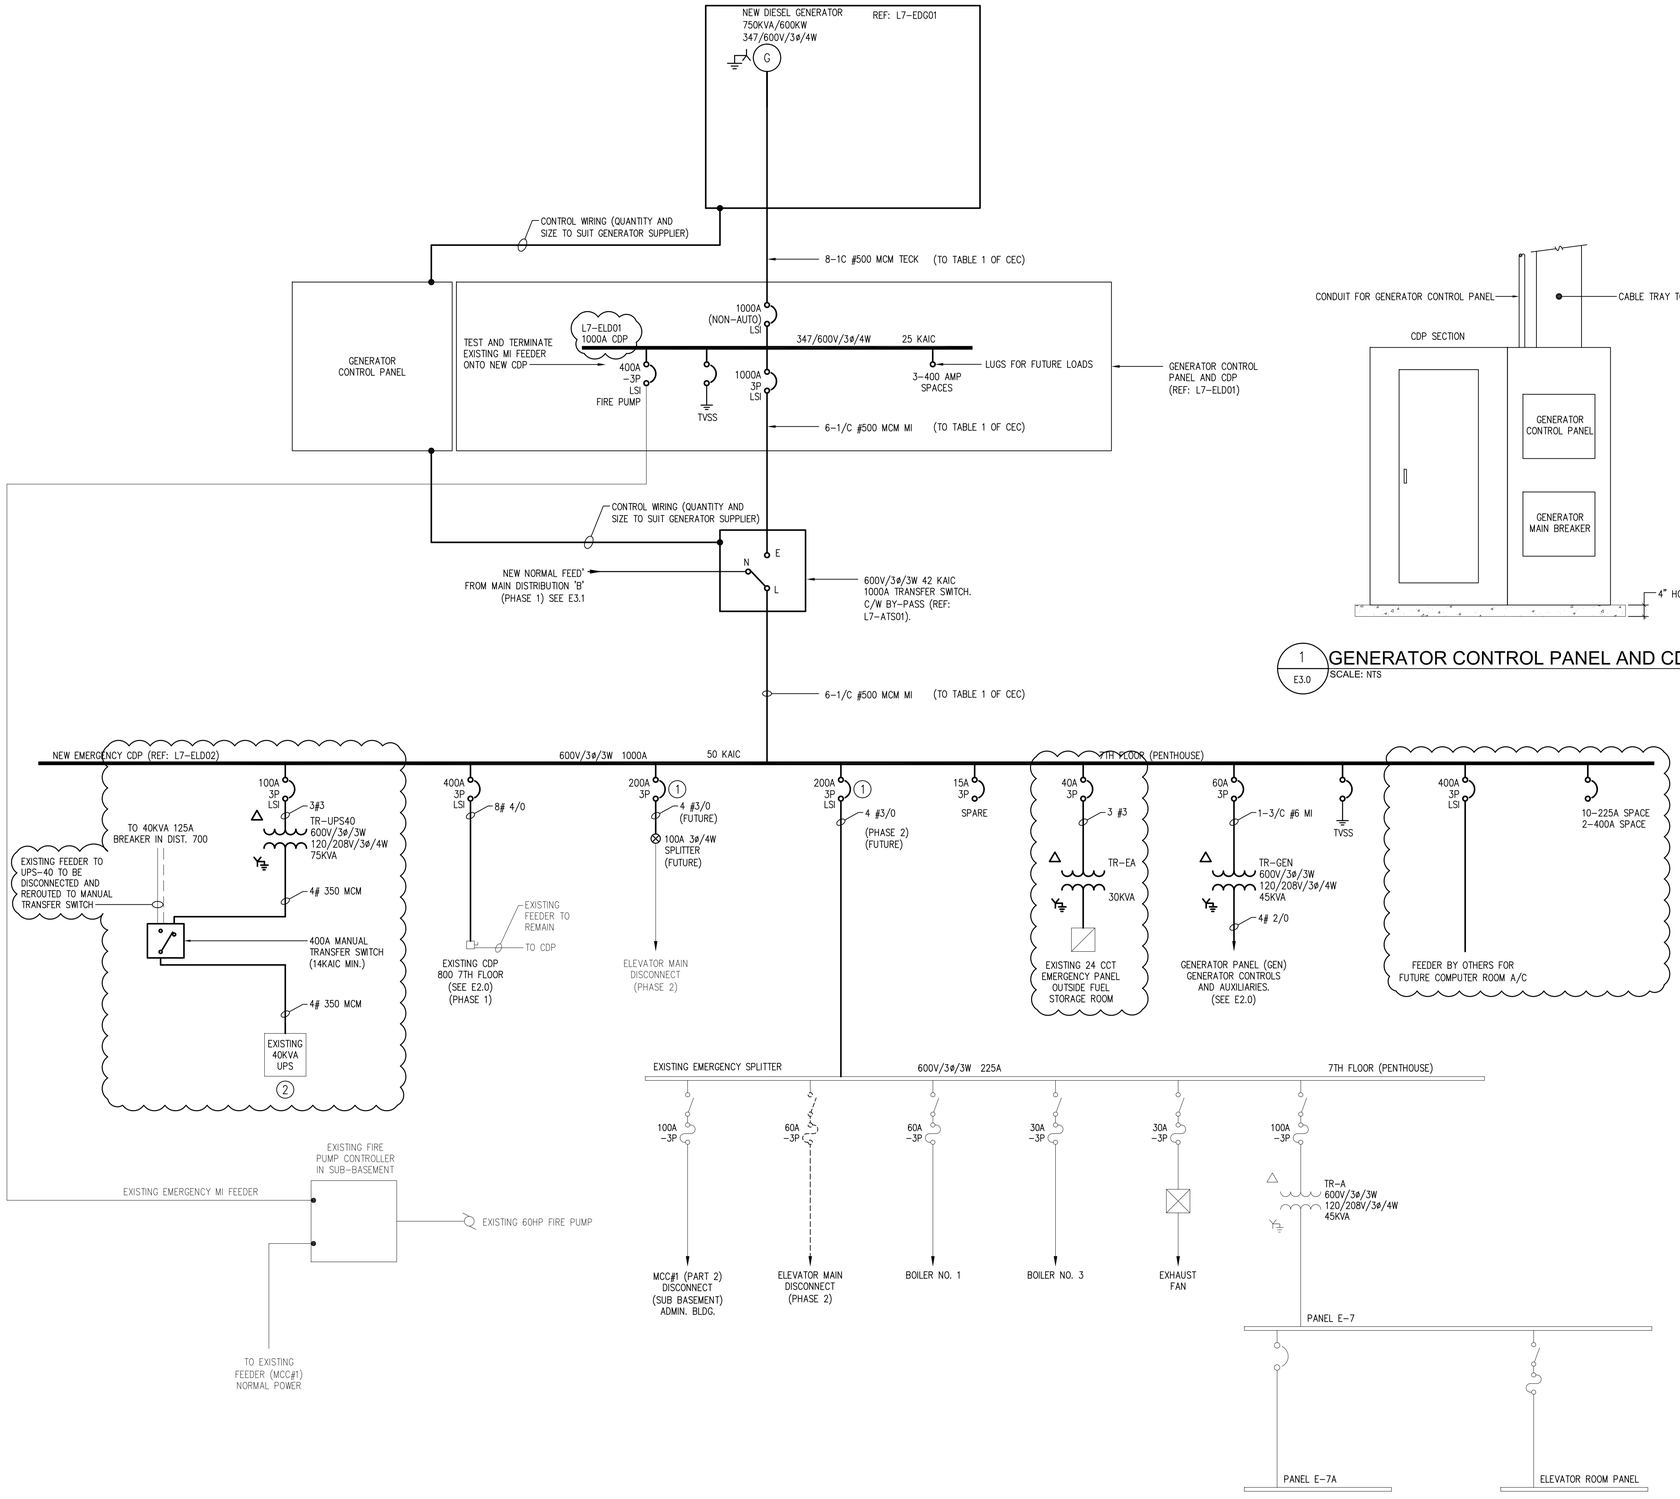

2 E3.0 NEW SINGLE LINE DIAGRAM
SCALE: NTS

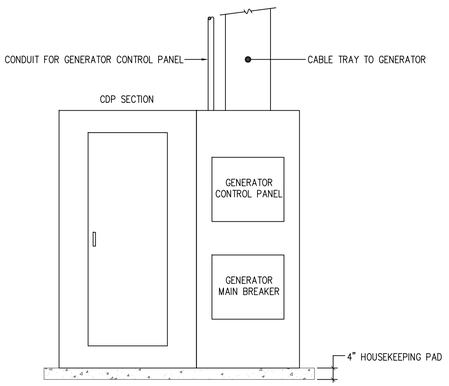

1 E3.0 GENERATOR CONTROL PANEL AND CDP (L7-ELD01)
SCALE: NTS

NOTES :

GENERAL NOTES

1. QUANTITY AND SIZE OF GENERATOR CONTROL/FUEL SYSTEM CONTROL WIRING IS TYPICAL AND SHALL BE COORDINATED BY CONTRACTORS. PROVIDE WIRE QUANTITY AND SIZE REQUIRED BY GENERATOR SUPPLIER.

DRAWING NOTES (#)

1. PROVIDE ALL BREAKERS FOR PHASE 1 AND PHASE 2 AS PART OF PHASE 1.
2. TEST UPS UPON COMPLETION OF WORK. EMPLOY POWERWARE.

SMS ENGINEERING
SMS Engineering Ltd. Consulting Engineers
770 Bradford Street Winnipeg MB Canada R3H 0N3
Telephone 204.775.0291 Fax 204.772.2153
sms@smseng.com

07-232-01

NO.	REVISION/DESCRIPTION	BY	DATE
2.	ISSUED FOR ADDENDUM NO. 2	CB	09.07.27
1.	ISSUED FOR BID OPPORTUNITY	CB	09.06.19

SEALS

APEGM Certificate of Authorization SMS Engineering Ltd. No. 166 Expiry: April 30, 2010

PROVINCE OF MANITOBA HEWITT 27 July 09 Member # 24022 REGISTERED PROFESSIONAL ENGINEER

DRAWN BY	KAM	CHECKED BY	CB	APPROVED	CJH
DATE	2009.04.17	USER APPROVAL			

Winnipeg
CITY OF WINNIPEG
PLANNING, PROPERTY & DEVELOPMENT DEPARTMENT
CIVIC ACCOMMODATIONS DIVISION
300 – 65 GARRY ST. R3C 4K4

PROJECT
CITY OF WINNIPEG 510 MAIN ST.
EMERGENCY DISTRIBUTION UPGRADE
PHASE 1

SHEET TITLE
NEW EMERGENCY GENERATOR
SINGLE LINE SCHEMATIC OF NEW
EMERGENCY SYSTEM UPGRADE

SCALE	PROJECT NO.	SHEET NO.
AS SHOWN	07-232-01	E3.0

DRAWING SHEET SIZE: A1 (841mm x 594mm) PLOT 1:1

ADDRESS: PROJECT No: 07-232-01 DESCRIPTION: DATE: FILE NAME: 07232201.dwg