


STAGE 1 - PROPOSED WORKS

- ① INSTALLATION OF TEMPORARY CONSTRUCTION FENCING
- ② RELOCATION OF LIGHT STANDARDS
- ③ INSTALLATION OF LAND DRAINAGE SEWER
- ④ INSTALLATION OF SHORING AND EXCAVATION
- ⑤ APPROACH ROADWAY EXCAVATION
- ⑥ CONSTRUCTION OF GRAVITY WALLS
- ⑦ CONSTRUCTION OF CANTILEVER WALLS
- ⑧ CONSTRUCTION OF TUNNEL, BACKFILLING AND SLOPE GRADING
- ⑨ RECONSTRUCT QUINTEX & PEMBINA DODGE PARKING LOTS WITHIN PROJECT LIMITS
- ⑩ RELOCATION OF BELL FIBER OPTIC CABLE TO WEST SIDE OF C.N. PROPERTY (BY OTHERS)
- ⑪ RELOCATION OF ROGERS CABLE OVER COMPLETED TUNNEL (BY OTHERS)
- ⑫ CONSTRUCTION OF STAGE 2 TRACK DETOUR OVER COMPLETED STAGE 1 TUNNEL (BY OTHERS)
- ⑬ REMOVAL OF STAGE 1 TRACK DETOUR (BY OTHERS)

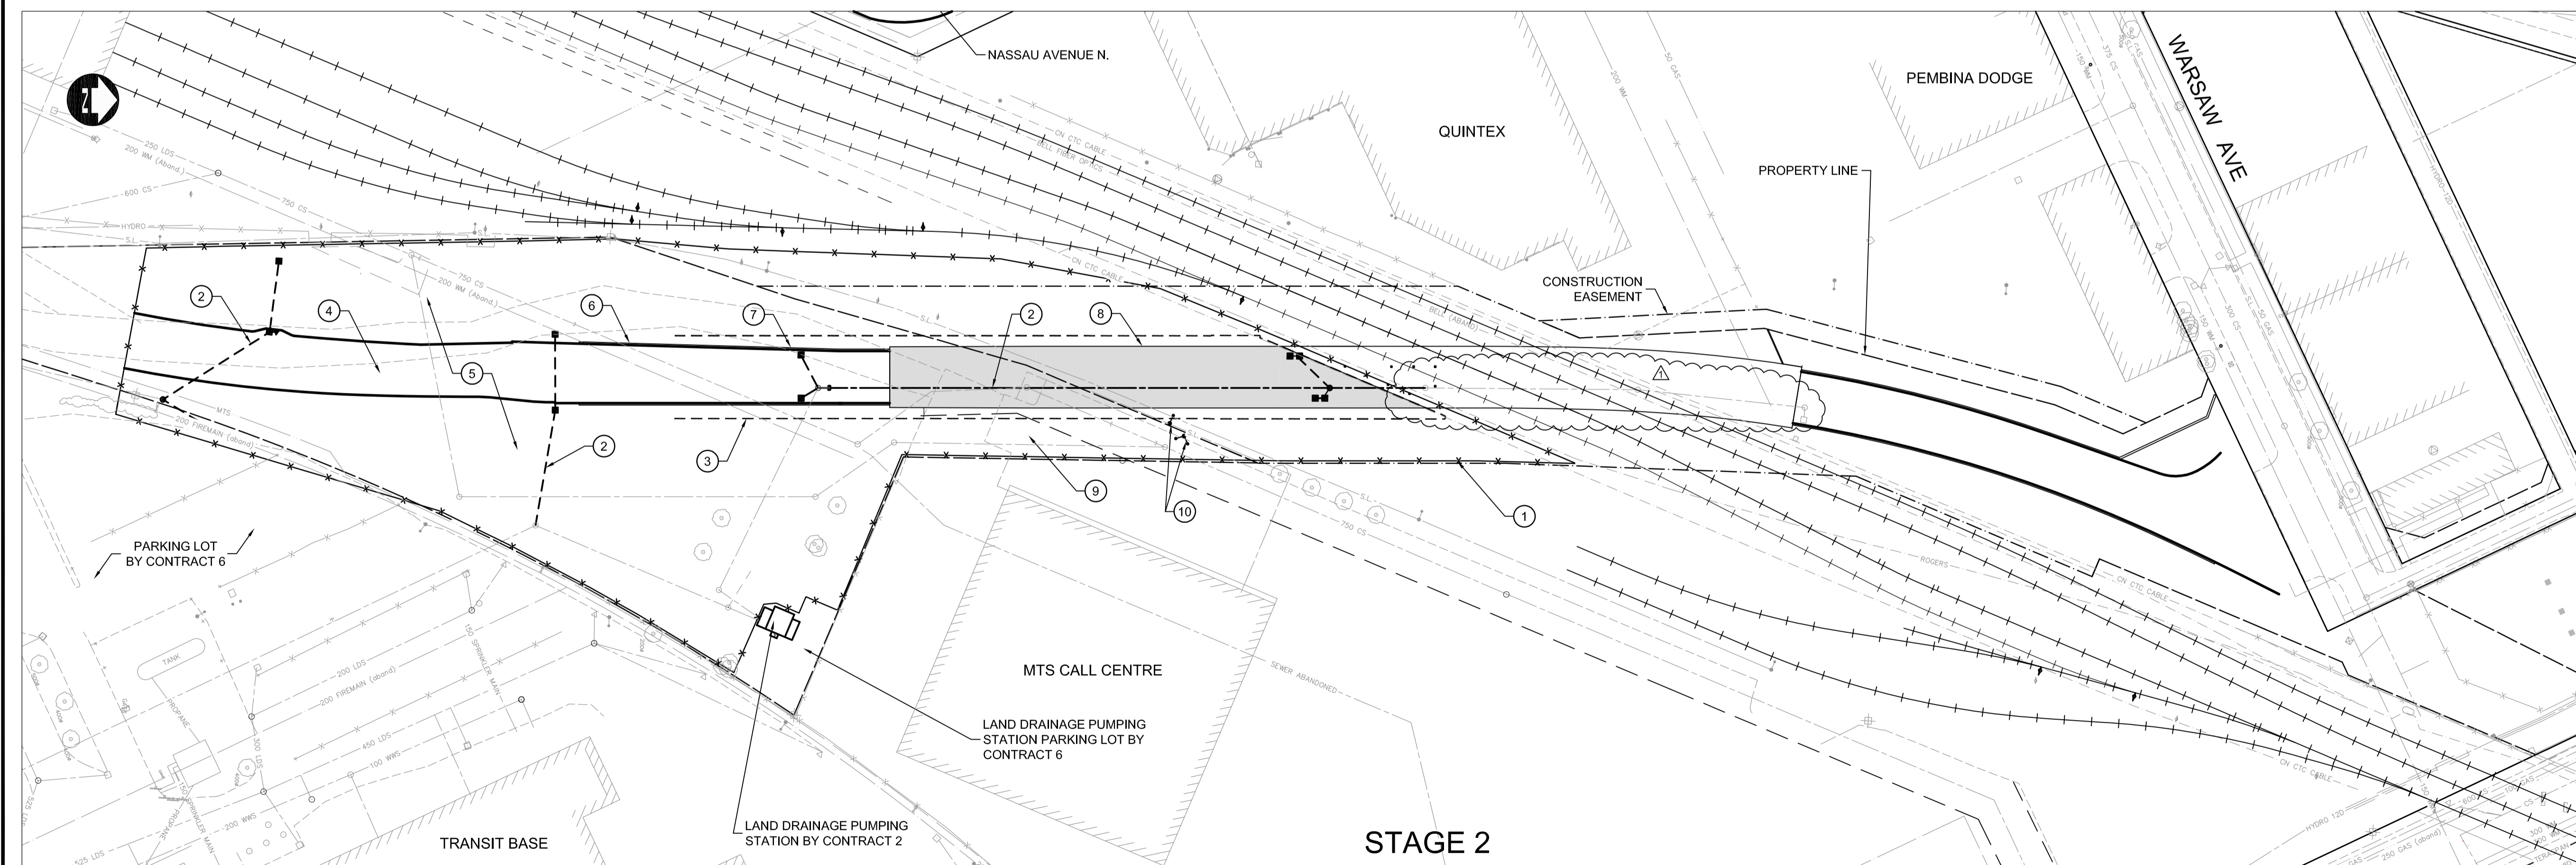

STAGE 2 - PROPOSED WORKS


- ① INSTALLATION OF TEMPORARY CONSTRUCTION FENCING
- ② INSTALLATION OF LAND DRAINAGE SEWER AND DRAINAGE INLETS
- ③ INSTALLATION OF SHORING AND EXCAVATION
- ④ APPROACH ROADWAY EXCAVATION
- ⑤ SITE GRADING
- ⑥ CONSTRUCTION OF GRAVITY WALLS
- ⑦ CONSTRUCTION OF CANTILEVER WALLS
- ⑧ CONSTRUCTION OF TUNNEL, BACKFILLING AND SLOPE GRADING
- ⑨ RECONSTRUCT MTS CALL CENTER PARKING LOT
- ⑩ REINSTALL VIA RAIL AND MTS LIGHT STANDARDS.

G:\CAD\088813\Contract\Contract 4-Underpass\Current\C4-G103A-P.dwg



LOCATION UNDERGROUND	APPROVED STRUCTURES	B.M. ELEV.
SUPPLY U/G STRUCTURES COMMITTEE	DATE	
NOTE: LOCATION OF UNDERGROUND STRUCTURES AS SHOWN ARE BASED ON THE BEST INFORMATION AVAILABLE, BUT NO GUARANTEE IS GIVEN THAT ALL EXISTING UTILITIES ARE SHOWN OR THAT THE GIVEN LOCATIONS ARE EXACT. CONFIRMATION OF EXISTENCE AND EXACT LOCATION OF ALL SERVICES MUST BE OBTAINED FROM THE INDIVIDUAL UTILITIES BEFORE PROCEEDING WITH CONSTRUCTION.		
2	ISSUED FOR ADDENDUM #5	11.10.2009 TJH
1	ISSUED FOR ADDENDUM #4	11.04.2009 TJH
0	ISSUED FOR TENDER	10.13.2009 TJH
NO.	REVISIONS	DATE BY

DESIGNED BY	RTP
DRAWN BY	TJH
CHECKED BY	DPK
APPROVED BY	DPK
HOR. SCALE	1 : 750
VERTICAL	
DATE	10/13/2009

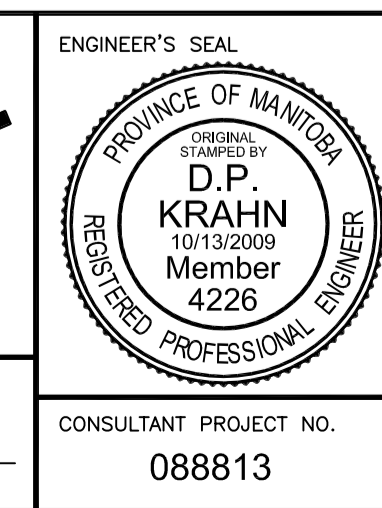

THE CITY OF WINNIPEG
TRANSIT DEPARTMENT

Winnipeg

SOUTHWEST RAPID TRANSIT CORRIDOR - STAGE 1
TRANSITWAY TUNNEL AT CN RIVERS SUBDIVISION
MILEAGE 1.38 & ASSOCIATED WORKS

OVERALL STAGING PLAN AND MAJOR ITEMS OF WORK

CITY DRAWING NUMBER: U237-09-04A
SHEET OF 73: 04A
CONSULTANT DRAWING NUMBER: C4-G103A-T

CONSULTANT PROJECT NO.: 088813