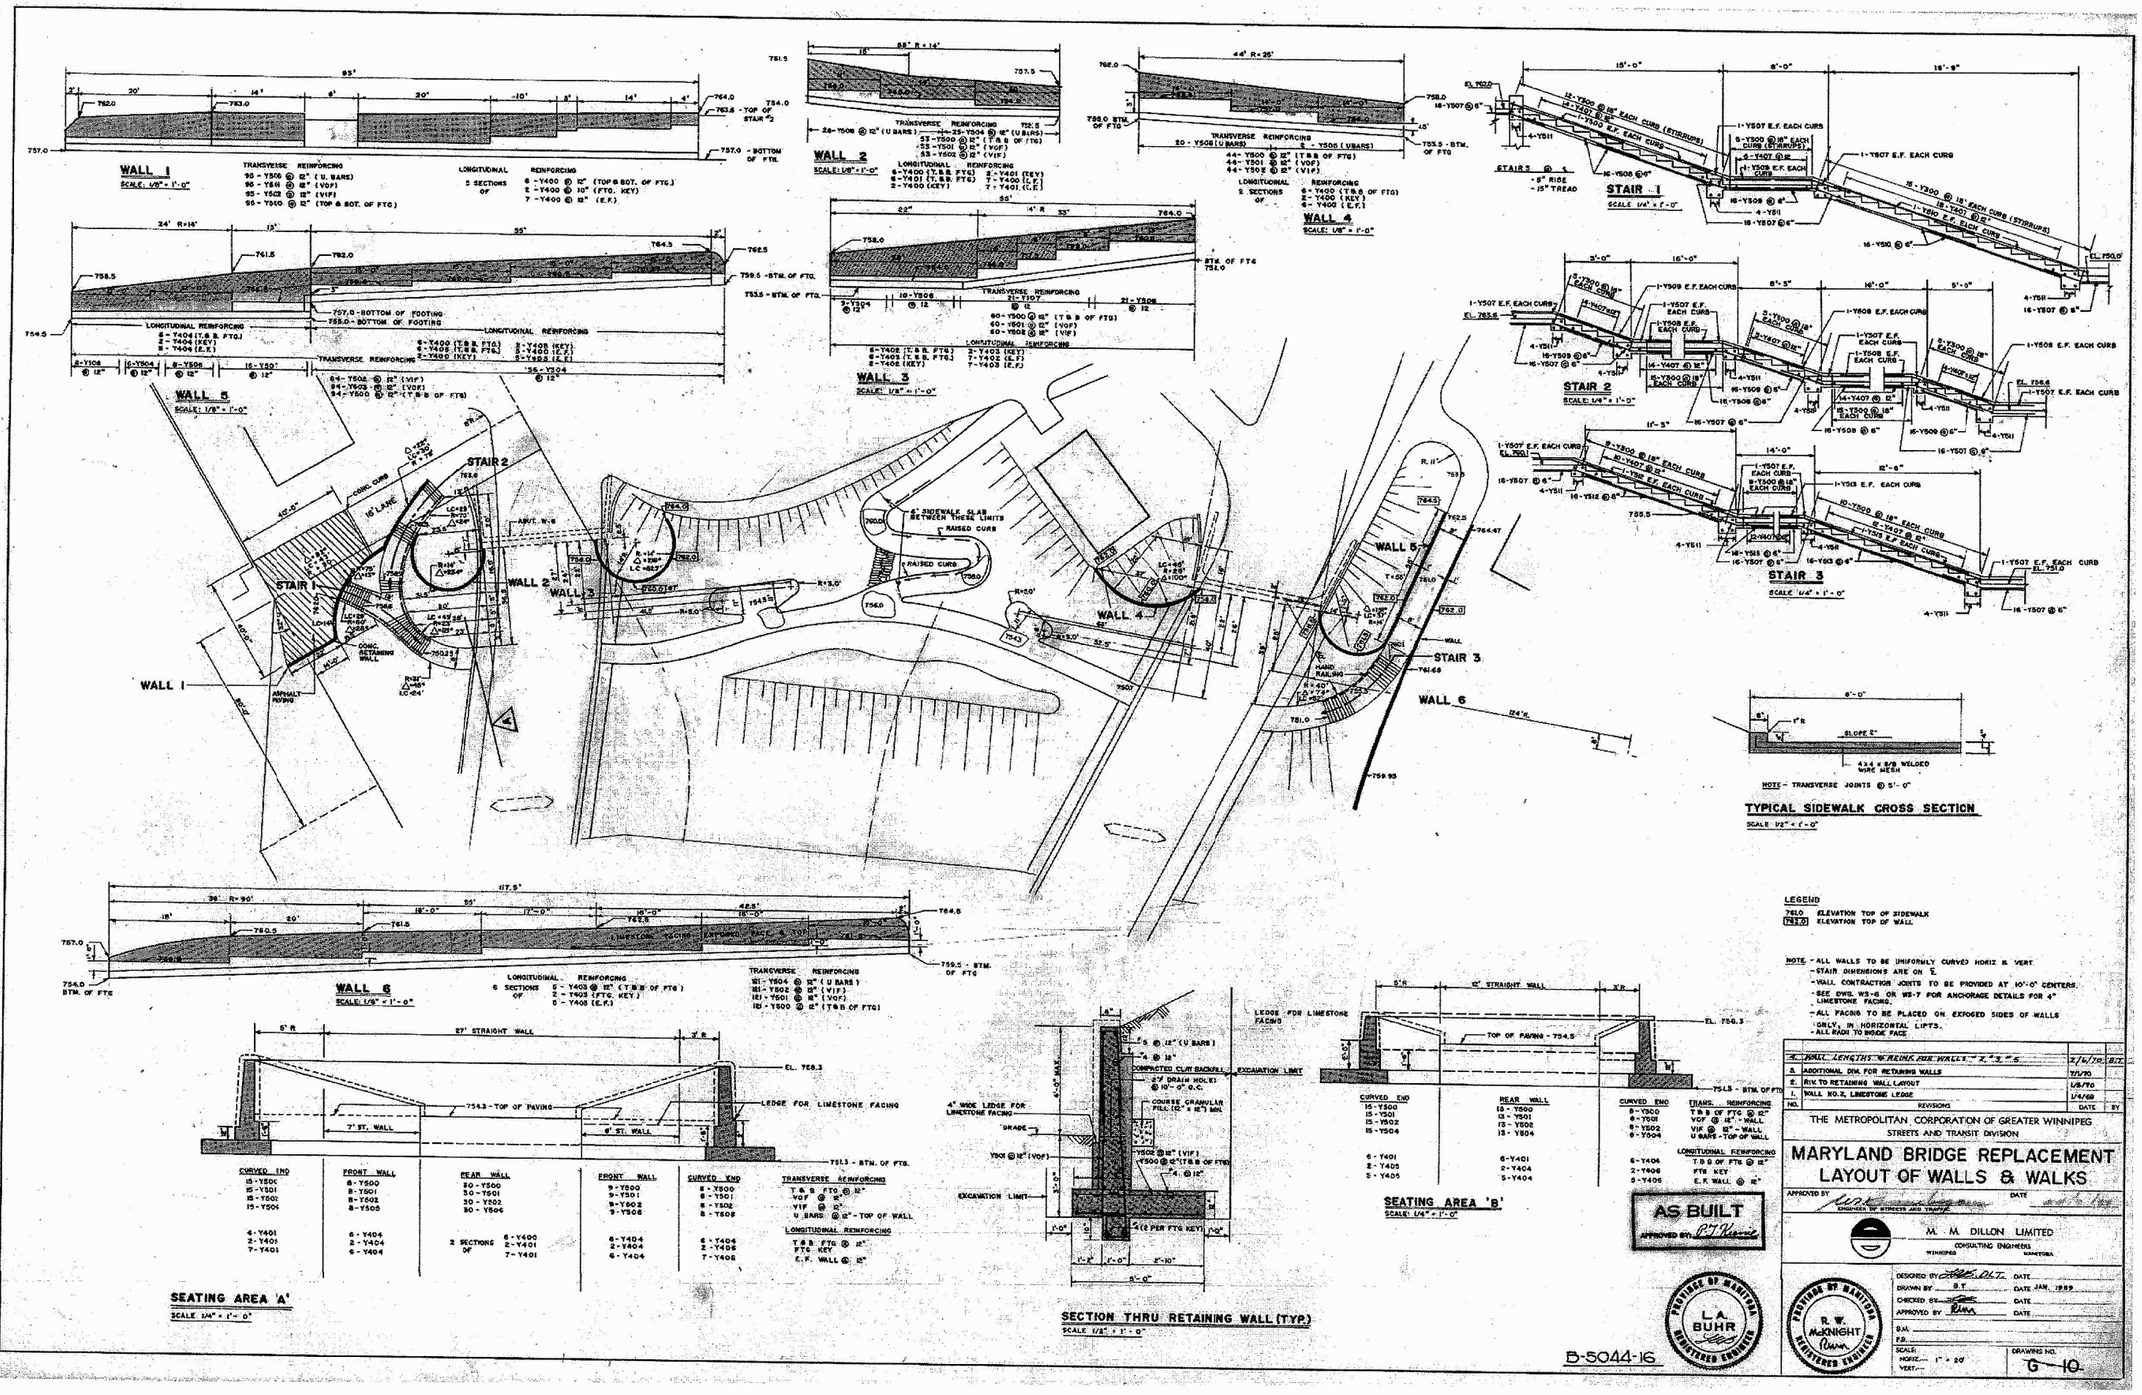

REFERENCE DRAWING ONLY

B.M. ELEV.				DESIGNED BY	DILLON CONSULTING	ENGINEER'S SEAL	ENGINEER'S SEAL	THE CITY OF WINNIPEG PUBLIC WORKS DEPARTMENT	
				DRAWN BY				MARYLAND TWIN BRIDGES REHABILITATION PROJECT MAJOR REPAIRS TO NORTH END PEDESTRIAN RAMPS AND STAIRS	CITY DRAWING NUMBER B108-09-08
				CHECKED BY					SHEET 09 OF 09
				REVIEWED BY				REFERENCE DRAWING G-10	BID OPPORTUNITY 630-2009
				HOR. SCALE	RELEASED FOR CONSTRUCTION	CONSULTANT PROJECT NO.			
				VERTICAL		05-5069-4000			
NO.	REVISIONS	DATE	BY	DATE AUGUST 2009	DATE				