


SOUTHBOUND APPROACH & REINFORCED ROAD SLAB PLAN

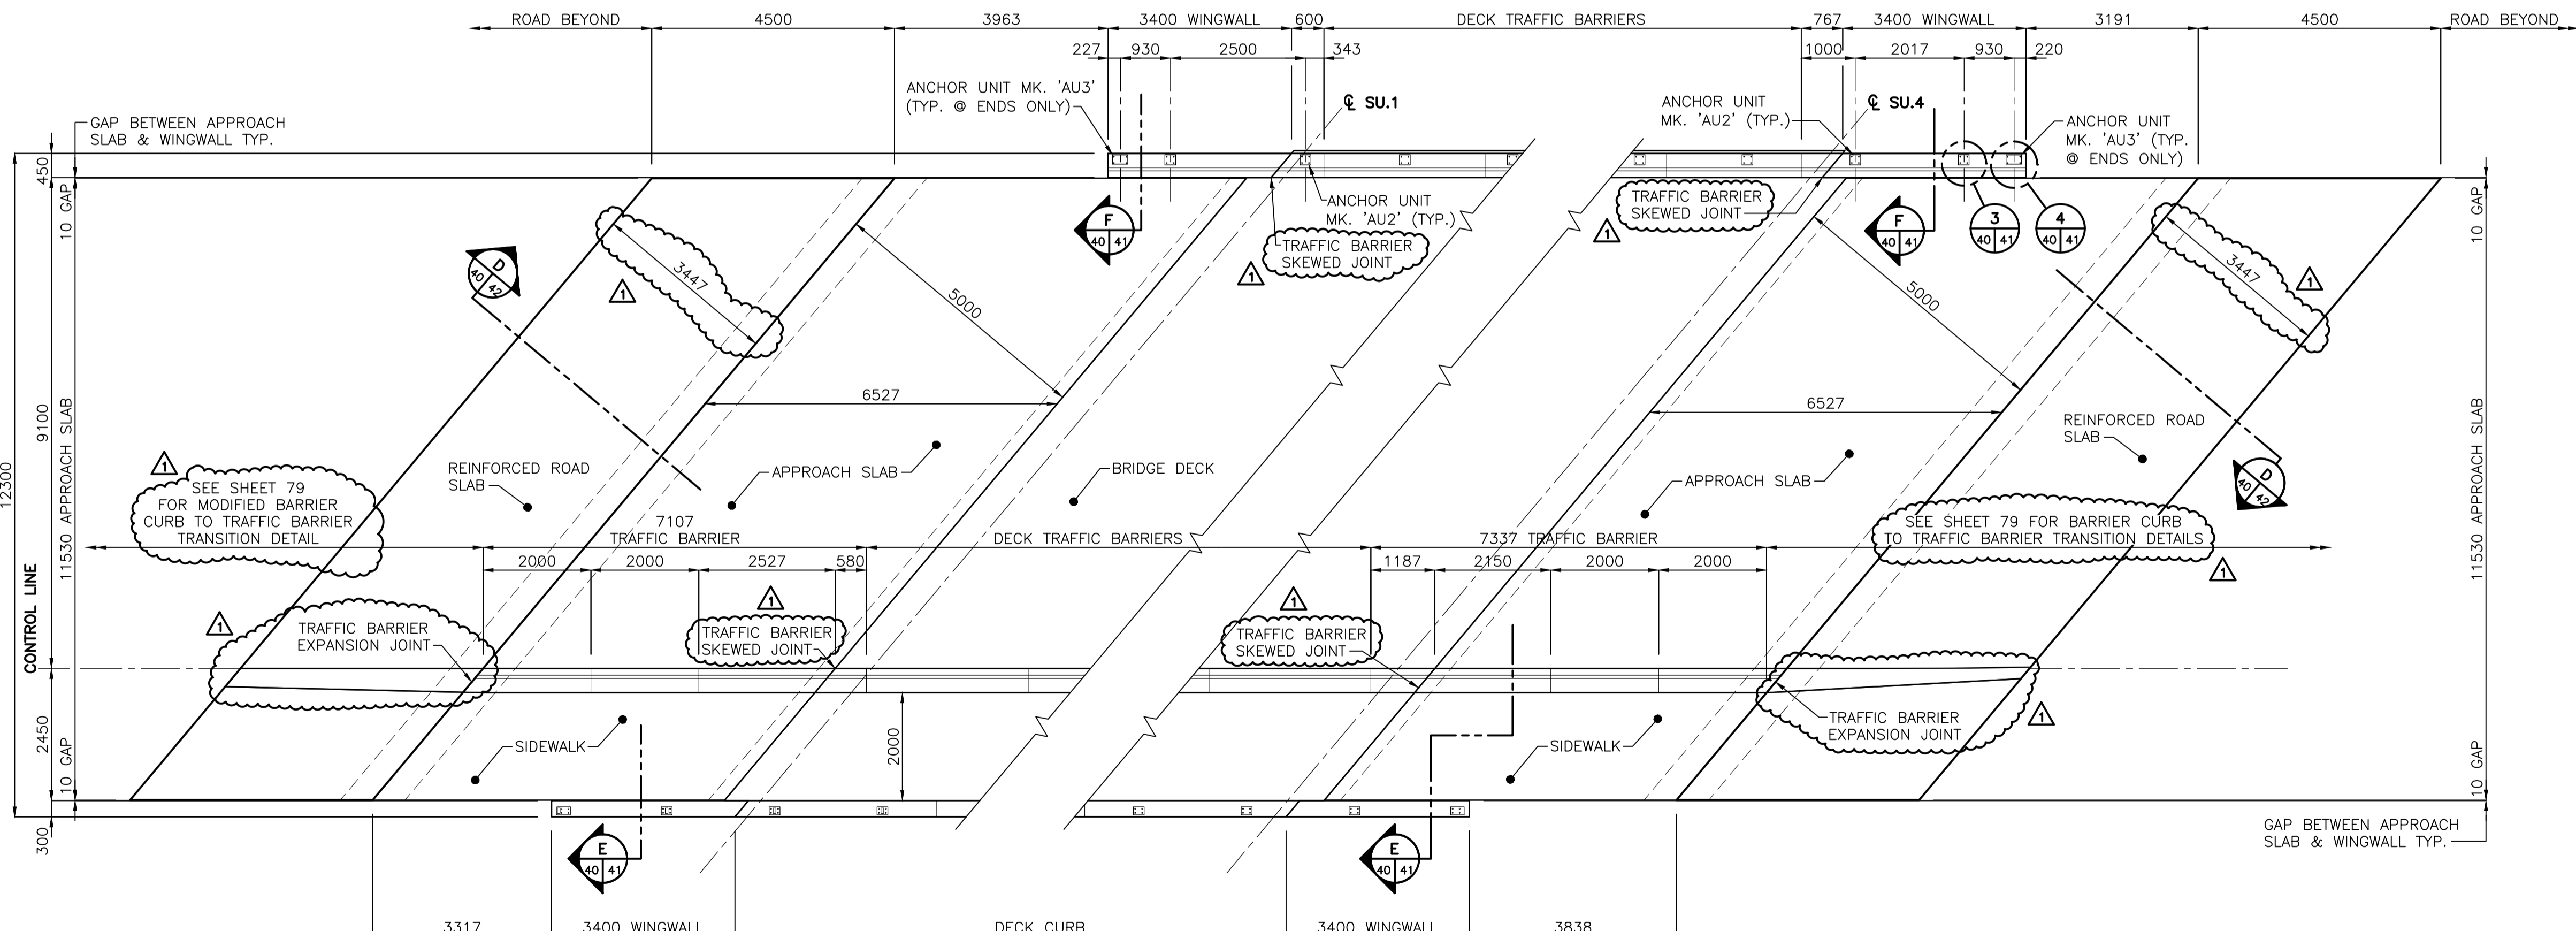

NORTHBOUND APPROACH & REINFORCED ROAD SLAB PLAN

**APEGM**  
 Certificate of Authorization  
 Stantec Consulting Ltd.  
 No. 1301 Date: \_\_\_\_\_

**METRIC**  
 WHOLE NUMBERS INDICATE MILLIMETRES  
 DECIMALIZED NUMBERS INDICATE METRES

LOCATION APPROVED UNDERGROUND STRUCTURES

SUPV. U/G STRUCTURES COMMITTEE DATE

NOTE:  
 LOCATION OF UNDERGROUND STRUCTURES AS SHOWN ARE BASED ON THE BEST INFORMATION AVAILABLE BUT NO GUARANTEE IS GIVEN THAT ALL EXISTING UTILITIES ARE SHOWN OR THAT THE GIVEN LOCATIONS ARE EXACT. CONFIRMATION OF EXISTENCE AND EXACT LOCATION OF ALL SERVICES MUST BE OBTAINED FROM THE INDIVIDUAL UTILITIES BEFORE PROCEEDING WITH CONSTRUCTION.

NO.	REVISIONS	DATE	BY	B.M. ELEV.
1	REVISED PER ADDENDUM No.1	12.01.18	K.S.A.	
0	ISSUED FOR TENDER	11.12.15	K.S.A.	

**Stantec Consulting Ltd.**  
 905 Waverley Street, Winnipeg, Manitoba  
 Tel 204-489-5900 Fax 204-453-9012

DESIGNED BY	K.S.A.	CHECKED BY	K.S.A.
DRAWN BY	J.M.B.	APPROVED BY	B.J.W.
HOR. SCALE:	1:75	RELEASED FOR CONSTRUCTION:	
VERTICAL:	U.N.O.	DATE	DEC. 15, 2011

ENGINEER'S SEAL

CONSULTANT DRAWING NO. S-602

**THE CITY OF WINNIPEG**  
 PUBLIC WORKS DEPARTMENT  
 ENGINEERING DIVISION

**STURGEON ROAD**  
 BRIDGE REPLACEMENT  
 PORTAGE AVENUE TO HALLONQUIST DRIVE  
 CONCRETE PLANS  
 APPROACH & REINFORCED ROAD SLAB

SHEET 40 OF 82  
 CAD FILE DRAWING NUMBER 31590s-601-767.dwg  
 CITY DRAWING NUMBER B120-12-040

V:\1137\active\1137\1590\drawing\403\_oddedo\sheet\_files\bridge\31590s-601-767.dwg  
 Date: 2012 Jan 16 5:06pm Login: Bremeris, James