



THIS DRAWING MUST NOT BE SCALED.
 THE GENERAL CONTRACTOR SHALL VERIFY ALL DIMENSIONS, DATUMS, AND LEVELS PRIOR TO COMMENCEMENT OF WORK. ALL ERRORS AND OMISSIONS TO BE REPORTED TO NUMBER TEN ARCHITECTURAL GROUP BEFORE PROCEEDING.
 VARIATIONS AND MODIFICATIONS TO WORK SHOWN ON THESE DRAWINGS SHALL NOT BE CARRIED OUT WITHOUT WRITTEN PERMISSION OF NUMBER TEN ARCHITECTURAL GROUP.
 THIS DRAWING IS THE EXCLUSIVE PROPERTY OF NUMBER TEN ARCHITECTURAL GROUP AND THE COPYRIGHT IN THE SAME BEING RESERVED TO THEM. IT MAY BE REPRODUCED ONLY WITH THE PERMISSION OF NUMBER TEN ARCHITECTURAL GROUP, IN WHICH CASE THE REPRODUCTION MUST BEAR THEIR NAME.


REVISED/ ISSUED/ PLOTTED	DATE
ADDENDA REVISION	8 MARCH 2012

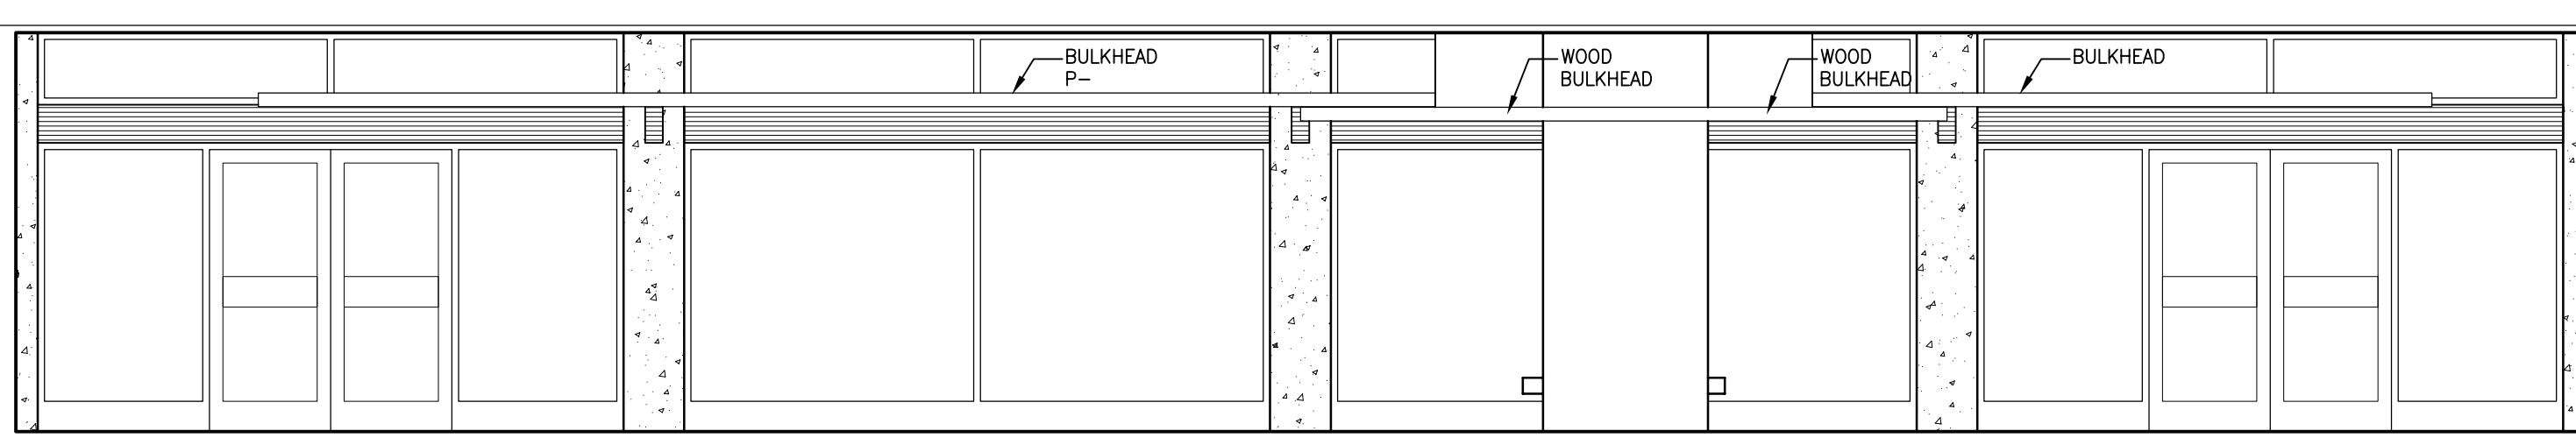


1 DINING ROOM A/B - NORTH ELEVATION
 A4.3 SCALE: 1/4"=1'-0"

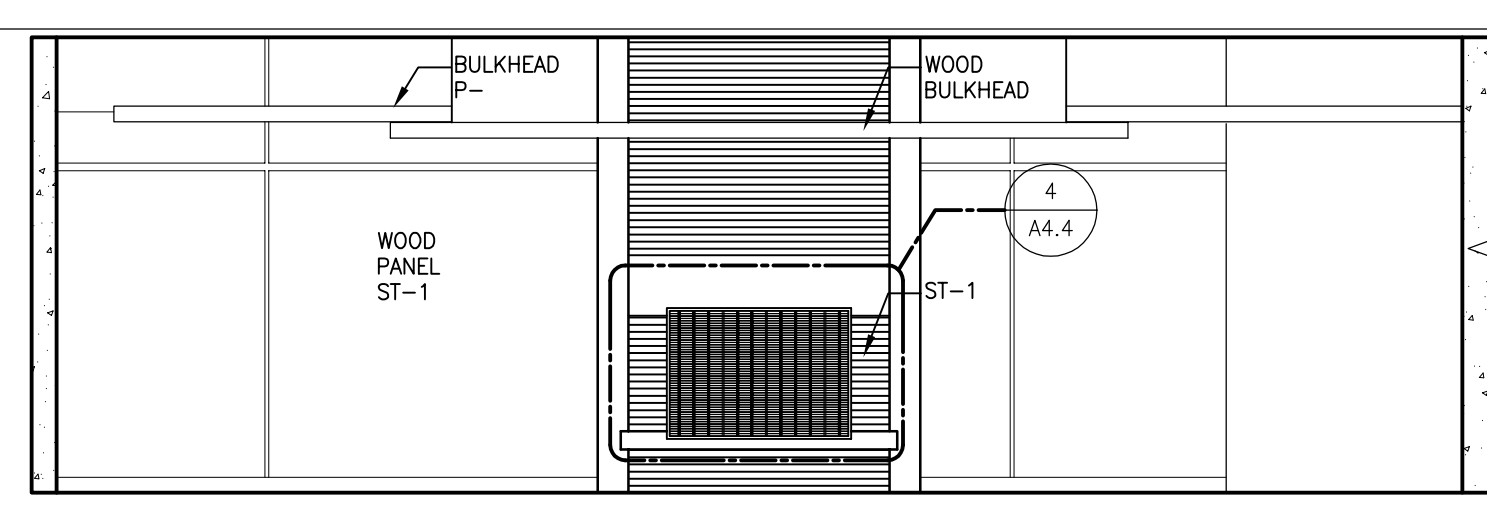


2 DINING ROOM A/B - EAST ELEVATION
 A4.3 SCALE: 1/4"=1'-0"

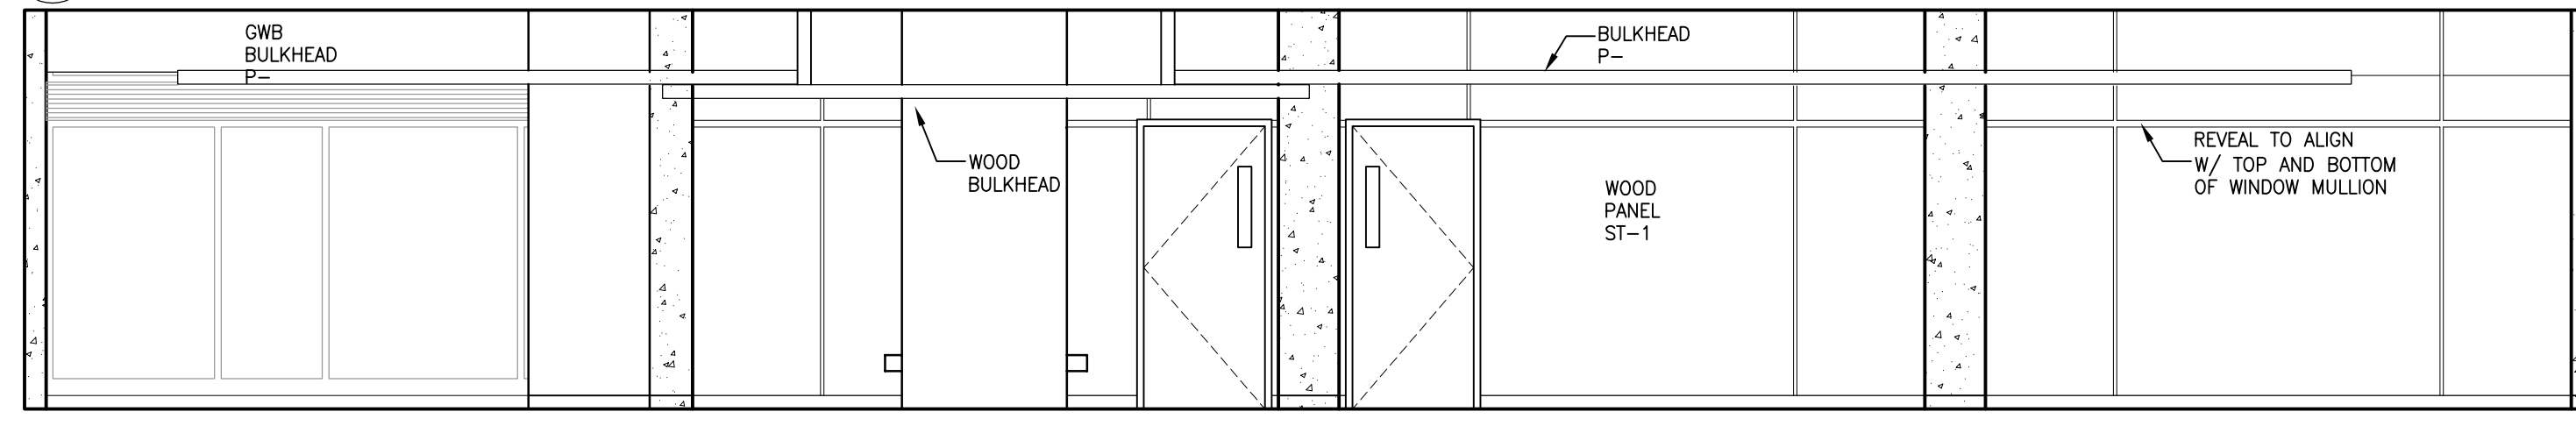


3 DINING ROOM A/B - SOUTH ELEVATION
 A4.3 SCALE: 1/4"=1'-0"

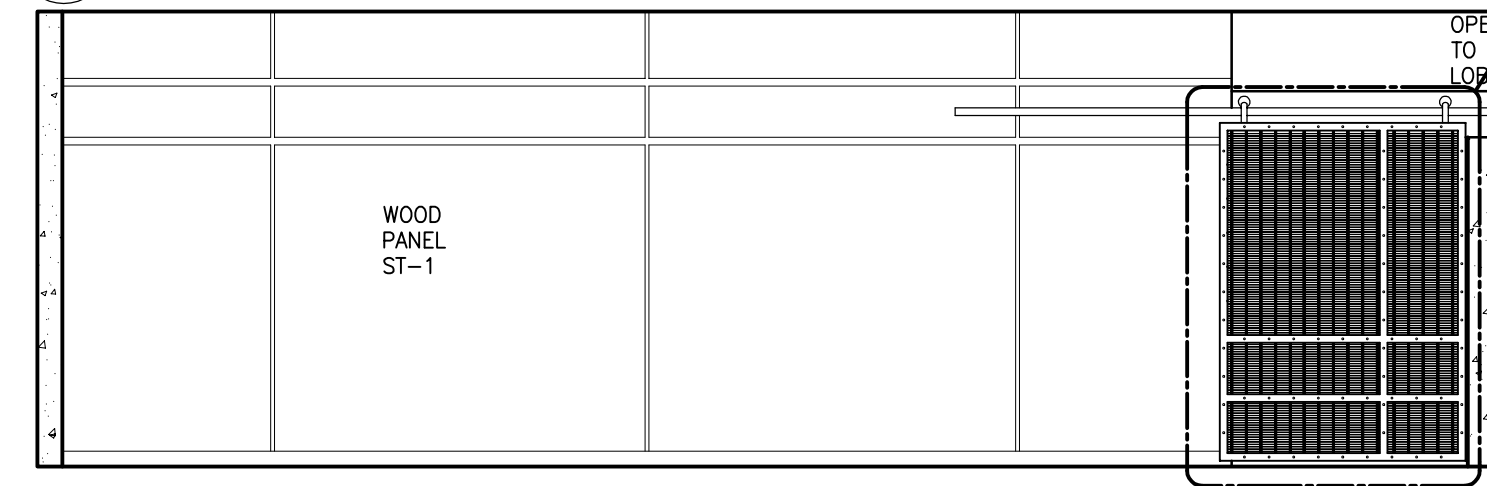


4 DINING ROOM B - EAST ELEVATION
 A4.3 SCALE: 1/4"=1'-0"

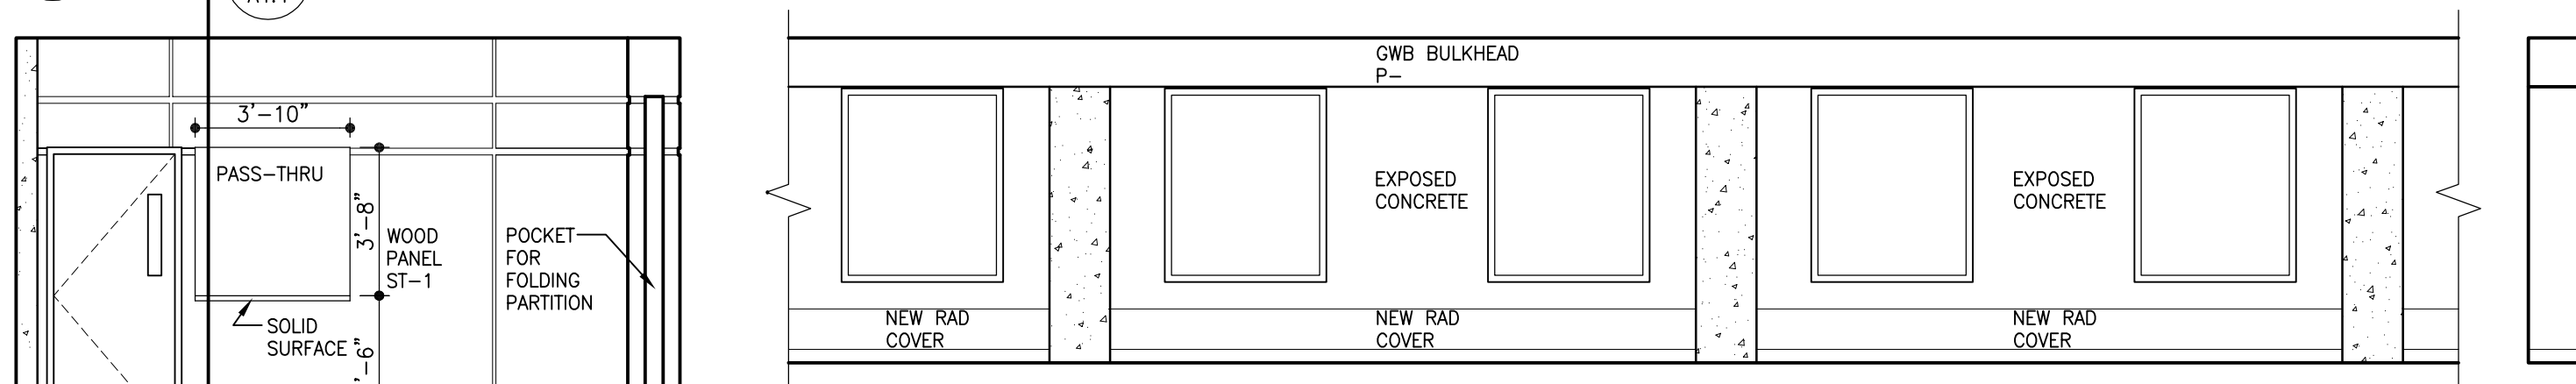

6 SKATERS LOUNGE 001 - NORTH ELEVATION
 A4.3 SCALE: 1/4"=1'-0"

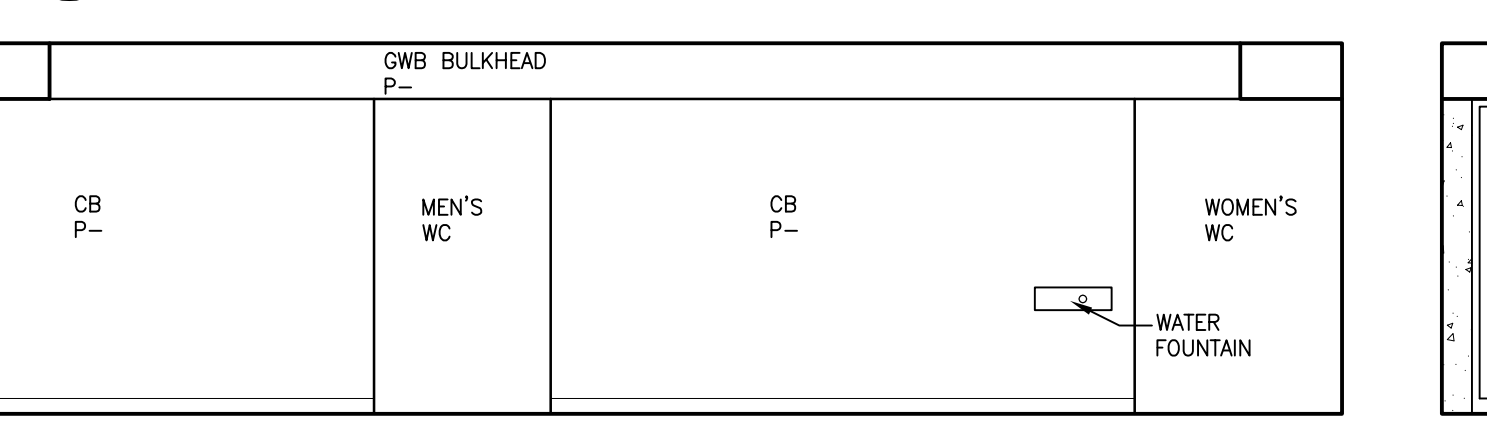


7 SKATERS LOUNGE 001 - WEST ELEVATION
 A4.3 SCALE: 1/4"=1'-0"

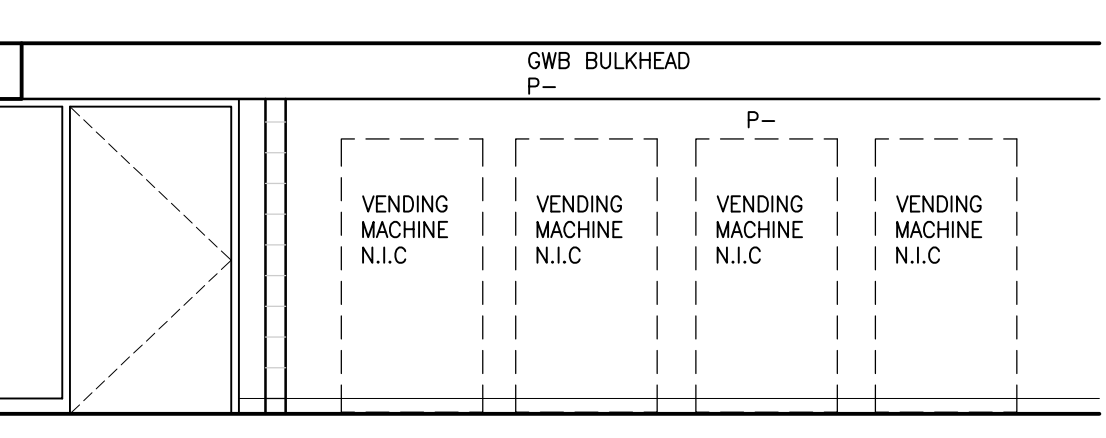


8 SKATERS LOUNGE 001 - EAST ELEVATION
 A4.3 SCALE: 1/4"=1'-0"


5 CAFE 102 - WEST ELEVATION
 A4.3 SCALE: 1/4"=1'-0"

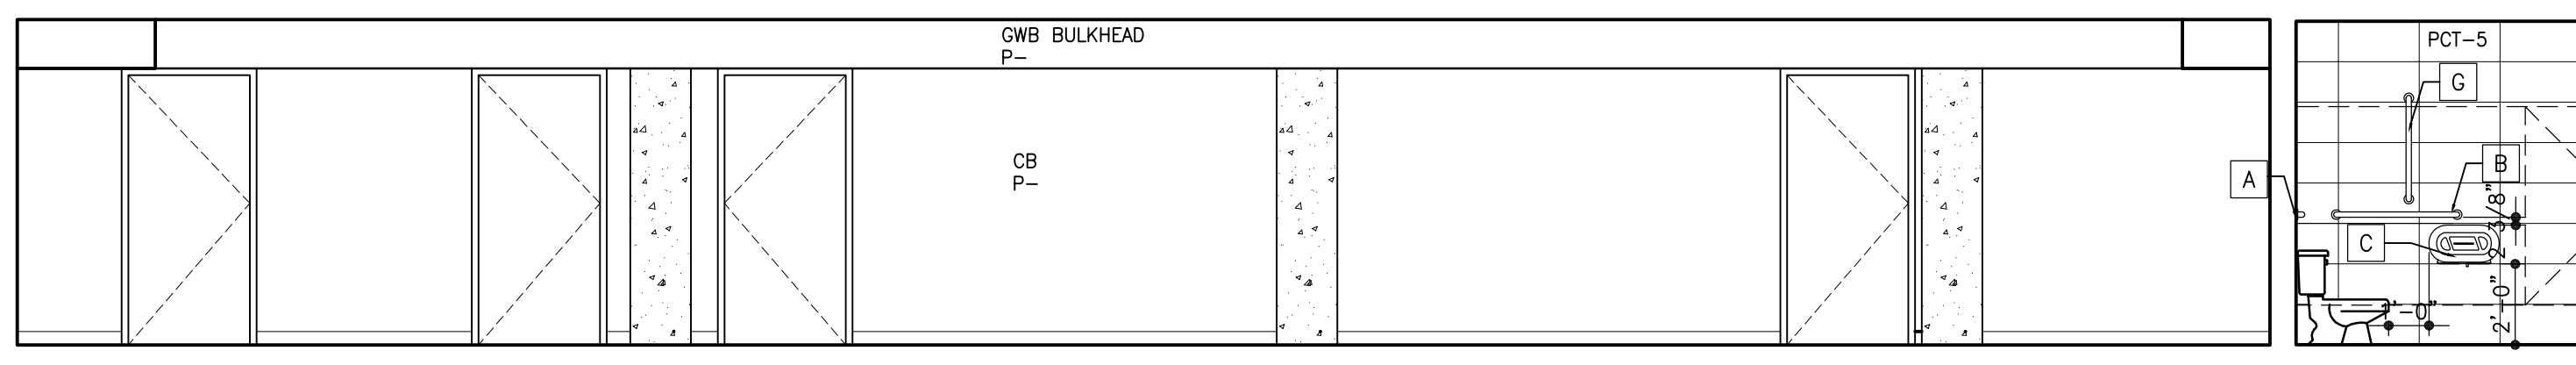


9 SKATERS LOUNGE 001 - SOUTH ELEVATION
 A4.3 SCALE: 1/4"=1'-0"

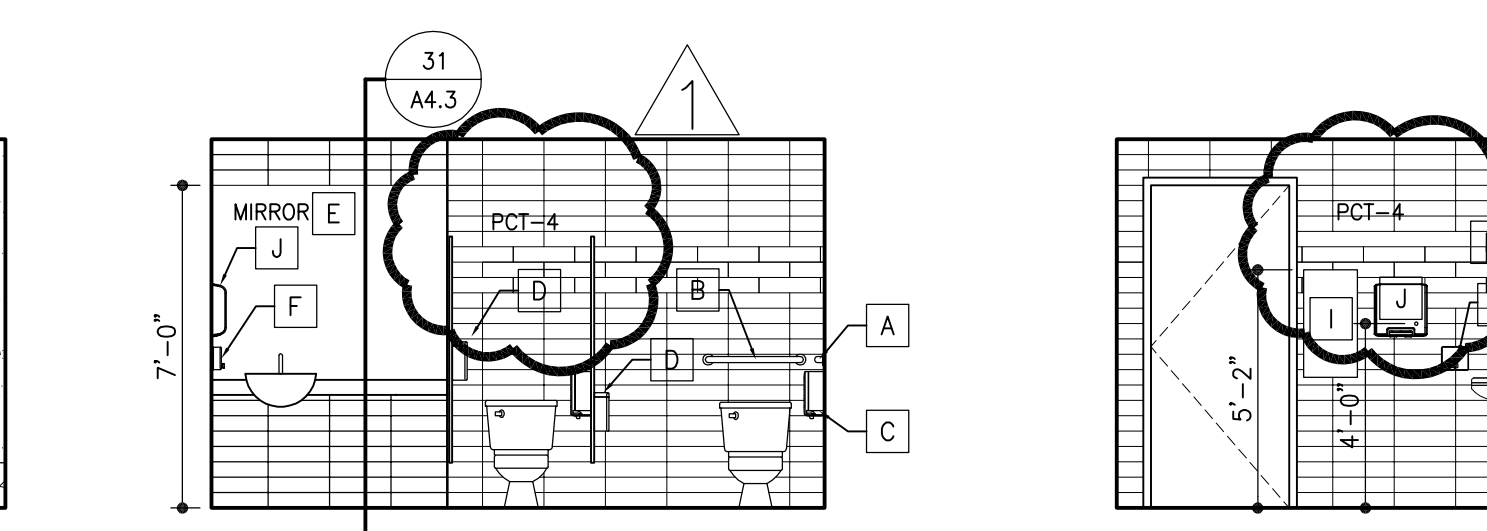


10 WOMEN'S WC 107 NORTH ELEVATION
 A4.3 SCALE: 1/4"=1'-0"

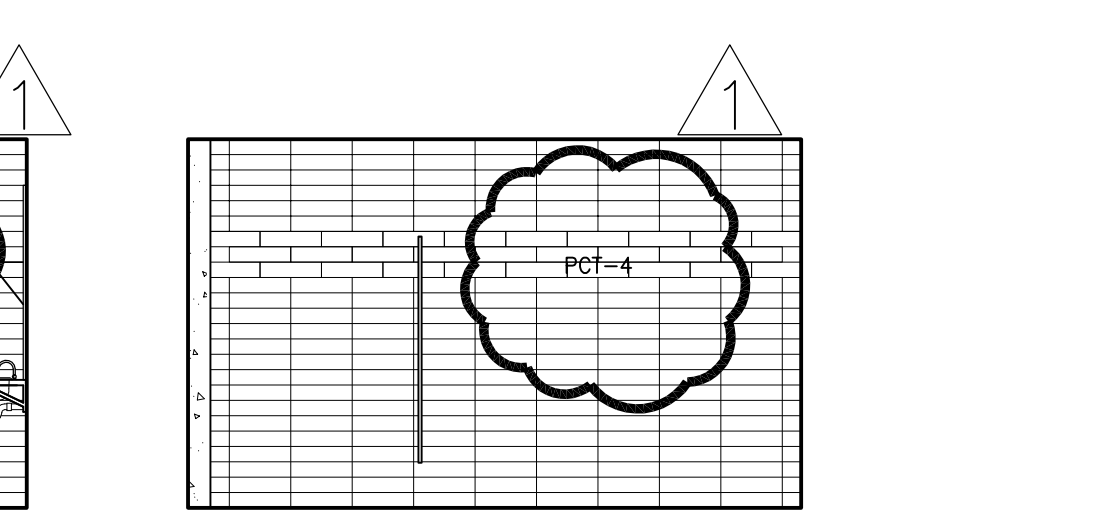


11 WOMEN'S WC 107 WEST ELEVATION
 A4.3 SCALE: 1/4"=1'-0"

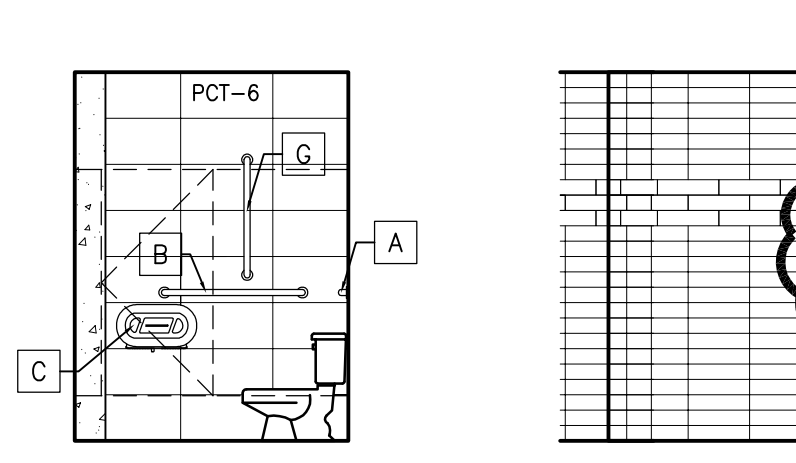


14 MEN'S WC 106 NORTH ELEVATION
 A4.3 SCALE: 1/4"=1'-0"

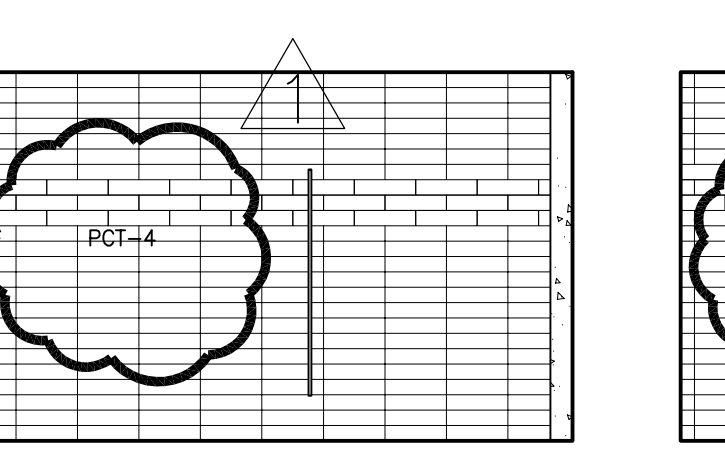


15 MEN'S WC 106 WEST ELEVATION
 A4.3 SCALE: 1/4"=1'-0"

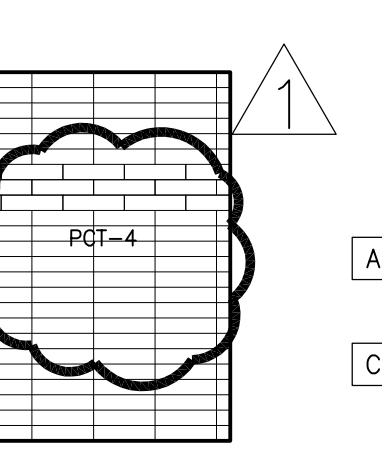


16 MEN'S WC 106 SOUTH ELEVATION
 A4.3 SCALE: 1/4"=1'-0"

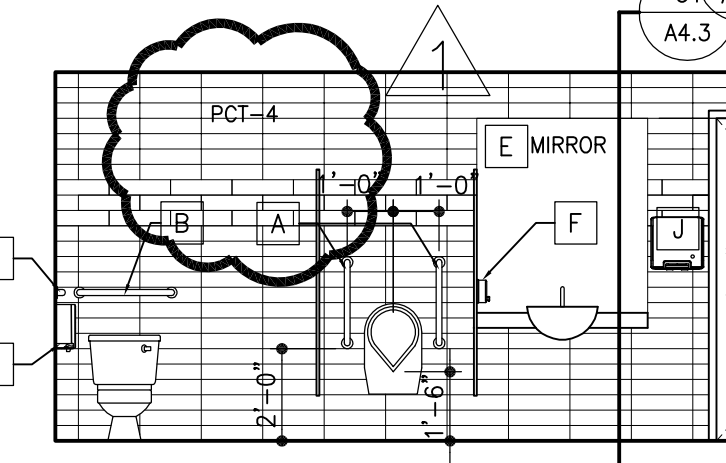


17 MEN'S WC 106 EAST ELEVATION
 A4.3 SCALE: 1/4"=1'-0"

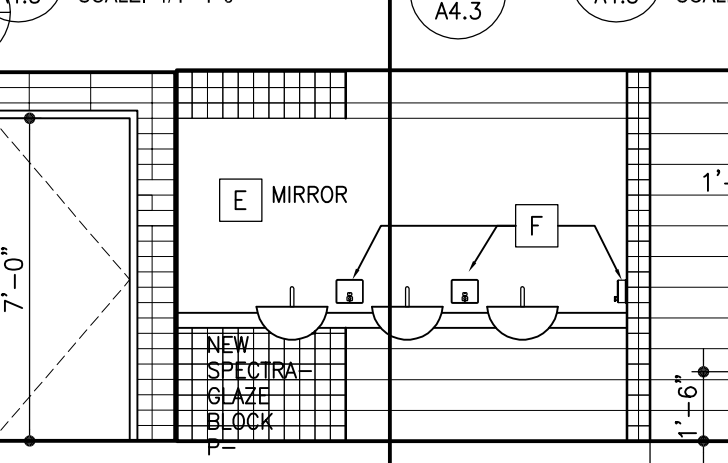


18 MEN'S WC 003 SOUTH ELEVATION
 A4.3 SCALE: 1/4"=1'-0"

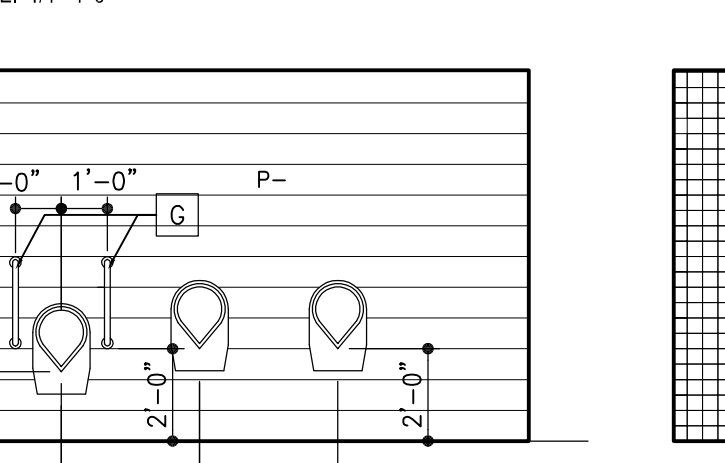


19 WOMEN'S WC 002 SOUTH ELEVATION
 A4.3 SCALE: 1/4"=1'-0"

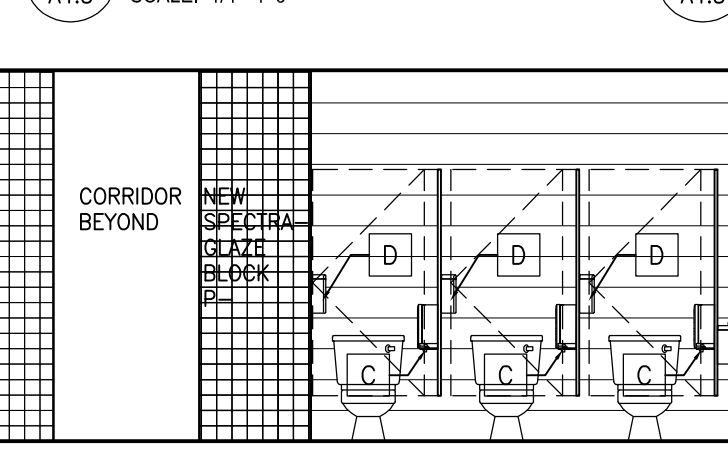


12 WOMEN'S WC 107 SOUTH ELEVATION
 A4.3 SCALE: 1/4"=1'-0"

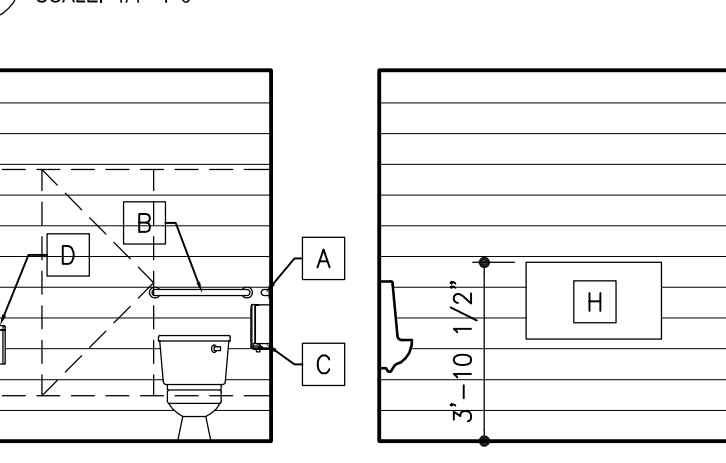


13 WOMEN'S WC 107 EAST ELEVATION
 A4.3 SCALE: 1/4"=1'-0"

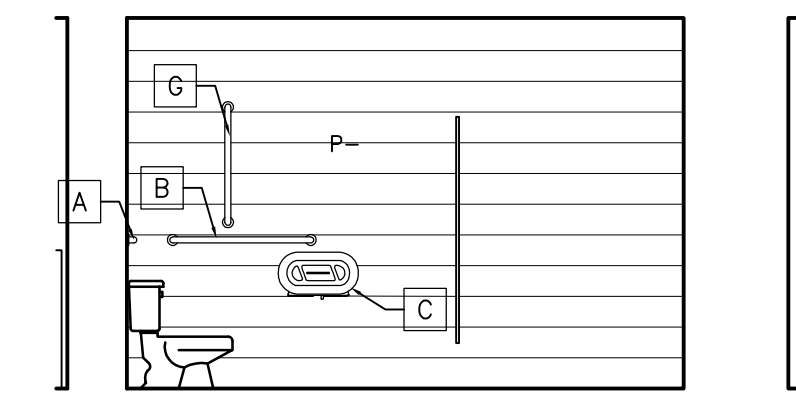


21 WOMEN'S WC 002 WEST ELEVATION
 A4.3 SCALE: 1/4"=1'-0"

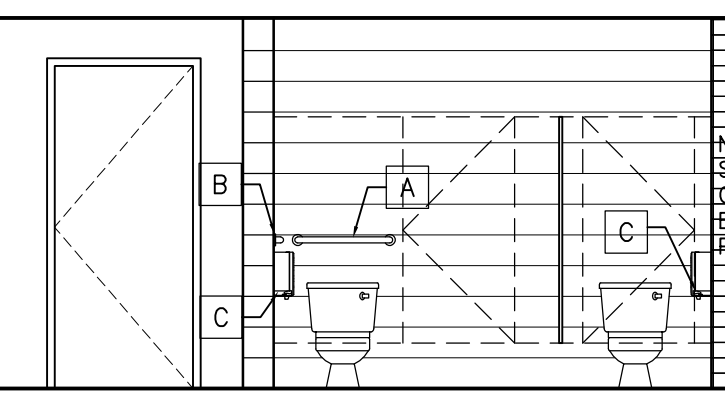


22 MEN'S WC 003 NORTH ELEVATION
 A4.3 SCALE: 1/4"=1'-0"

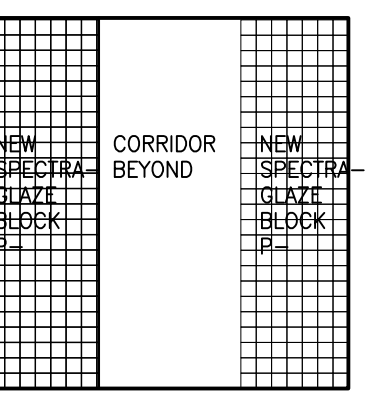


23 WOMEN'S WC 002 NORTH ELEVATION
 A4.3 SCALE: 1/4"=1'-0"

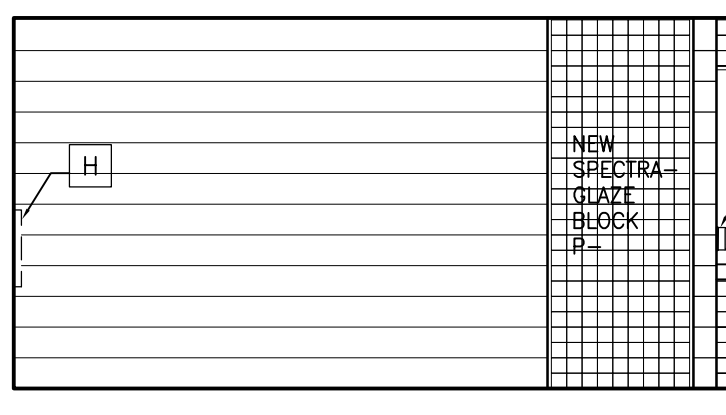


24 WOMEN'S WC 002 EAST ELEVATION
 A4.3 SCALE: 1/4"=1'-0"

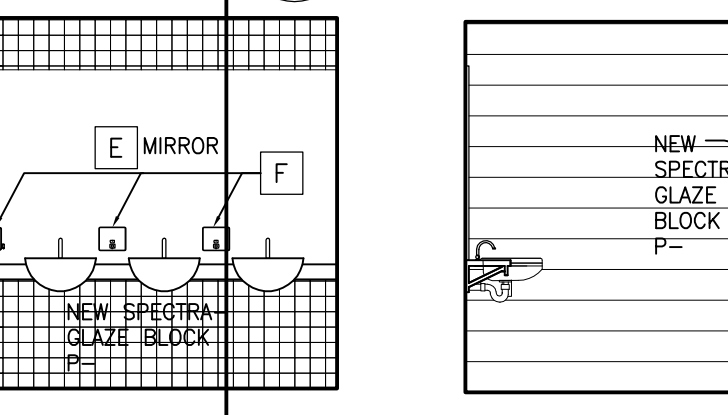


25 MEN'S WC 003 EAST ELEVATION
 A4.3 SCALE: 1/4"=1'-0"

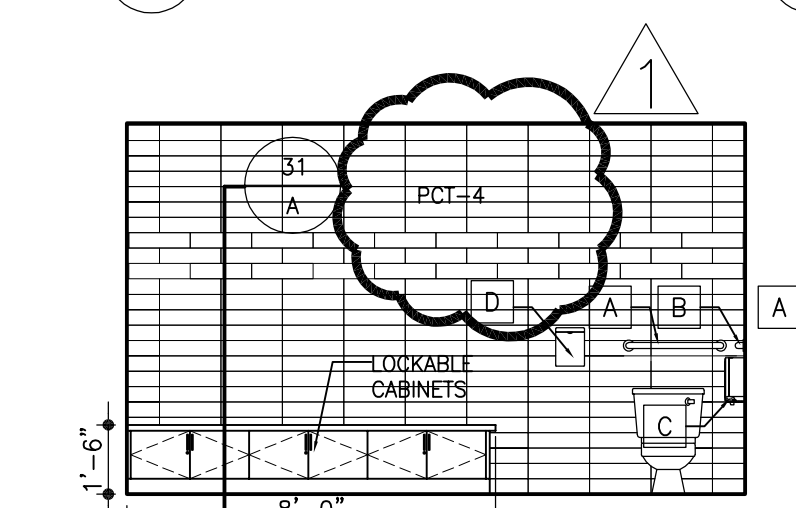


26 FAMILY WC 010 EAST ELEVATION
 A4.3 SCALE: 1/4"=1'-0"

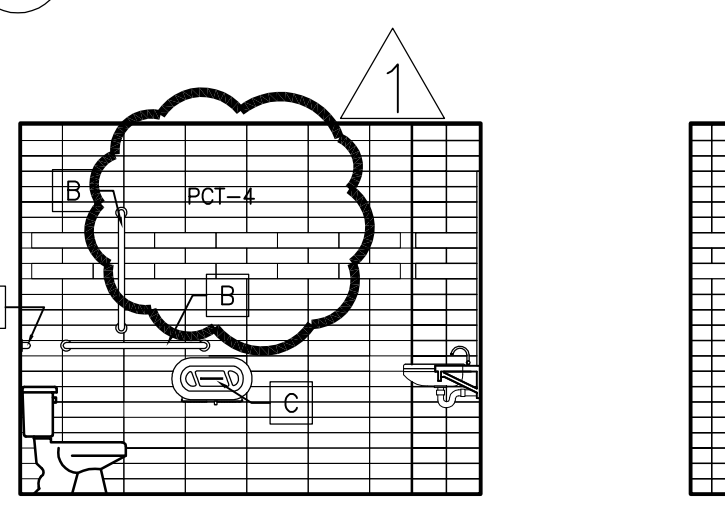


27 FAMILY WC 010 SOUTH ELEVATION
 A4.3 SCALE: 1/4"=1'-0"

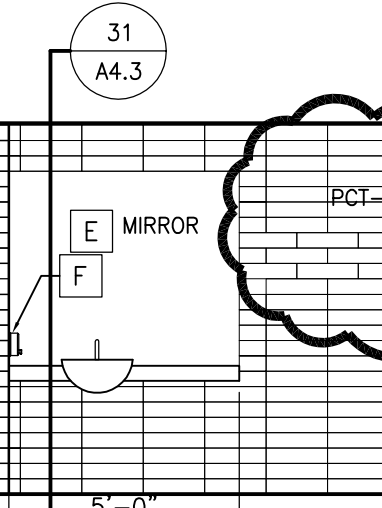


28 FAMILY WC 010 WEST ELEVATION
 A4.3 SCALE: 1/4"=1'-0"

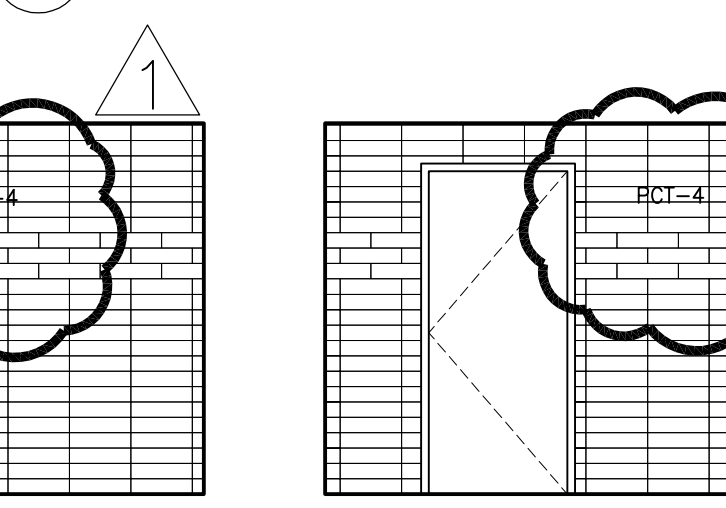

29 FAMILY WC 010 NORTH ELEVATION
 A4.3 SCALE: 1/4"=1'-0"

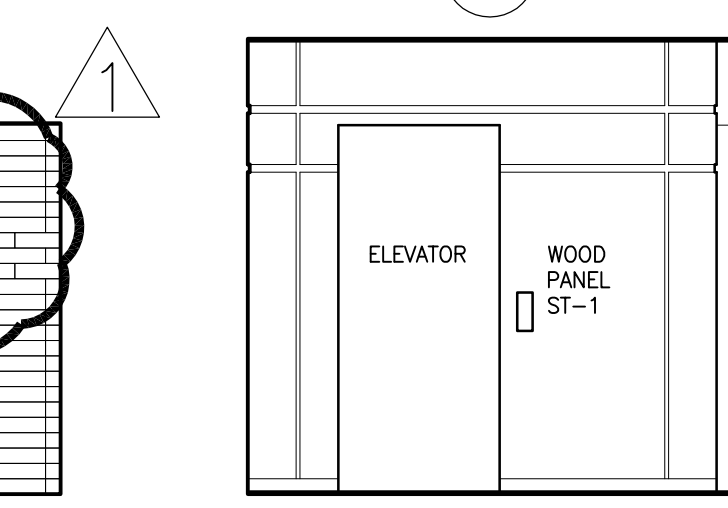

30 MAIN LOBBY 110 NORTH ELEVATION
 A4.3 SCALE: 1/4"=1'-0"

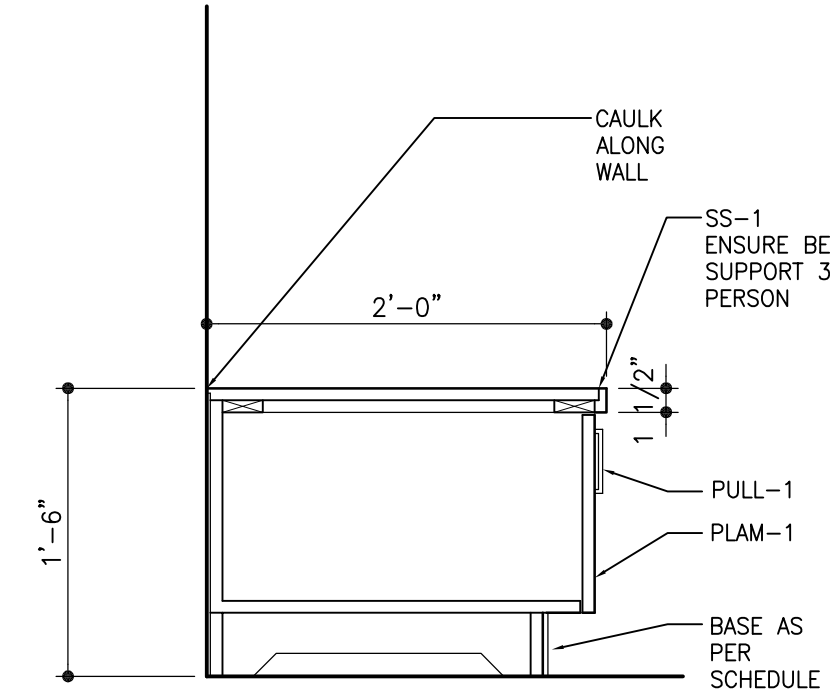

32 CHANGING BENCH WASHROOM VANITY DI
 A4.3 SCALE: 1"=1'-0"

numberTEN
 architectural group
 winipeg MB regina SK victoria BC
 204 942.0981 306 721.1501 250 360.2106
 architecture • interior design • graphic design


PEGUIS PAVILION
 UPGRADES AND ADDITION

project
 INTERIOR ELEVATIONS
 DETAILS

sheet title

consultant

scale: AS NOTED
 date: 23 NOV 11
 drawn by: KDS
 checked by: RB
 project no. 2011026
 sheet no. A4.3

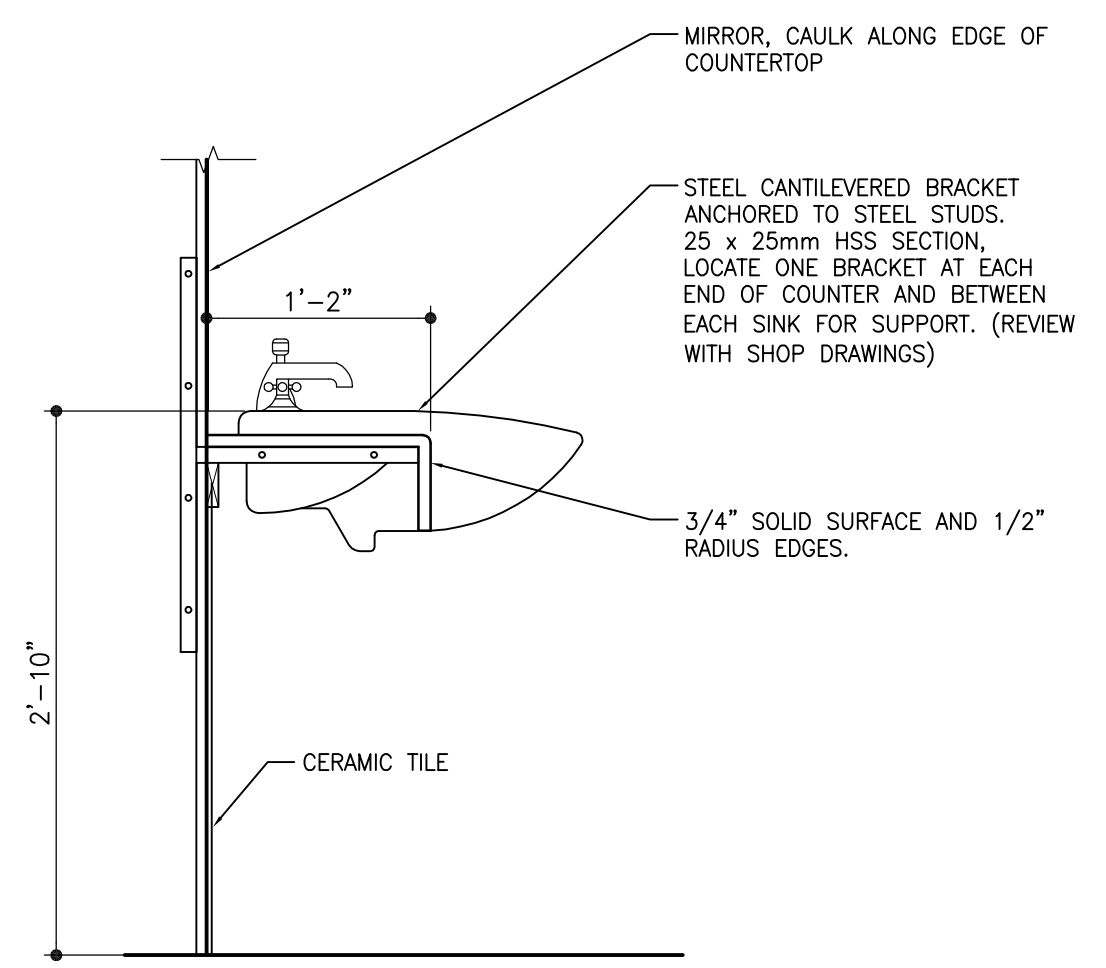

31 WASHROOM VANITY DETAIL
 A4.3 SCALE: 1"=1'-0"