

CITY OF WINNEPEG  
 ENGINEERING DEPARTMENT  
 W. J. ADAMSON, ENGINEER


**RIVER CROSSING OF  
 WATER MAIN AT REDWOOD  
 BRIDGE.**

J.A.M. April 30-1945  
 J.R.M.

CHECKED BY  
 APPROVED FOR CONSTRUCTION

REFERENCES

Large F.B. No. H. p. 5.  
 1" = 40' 7996.2075  
 W. line Glenwood Cres.

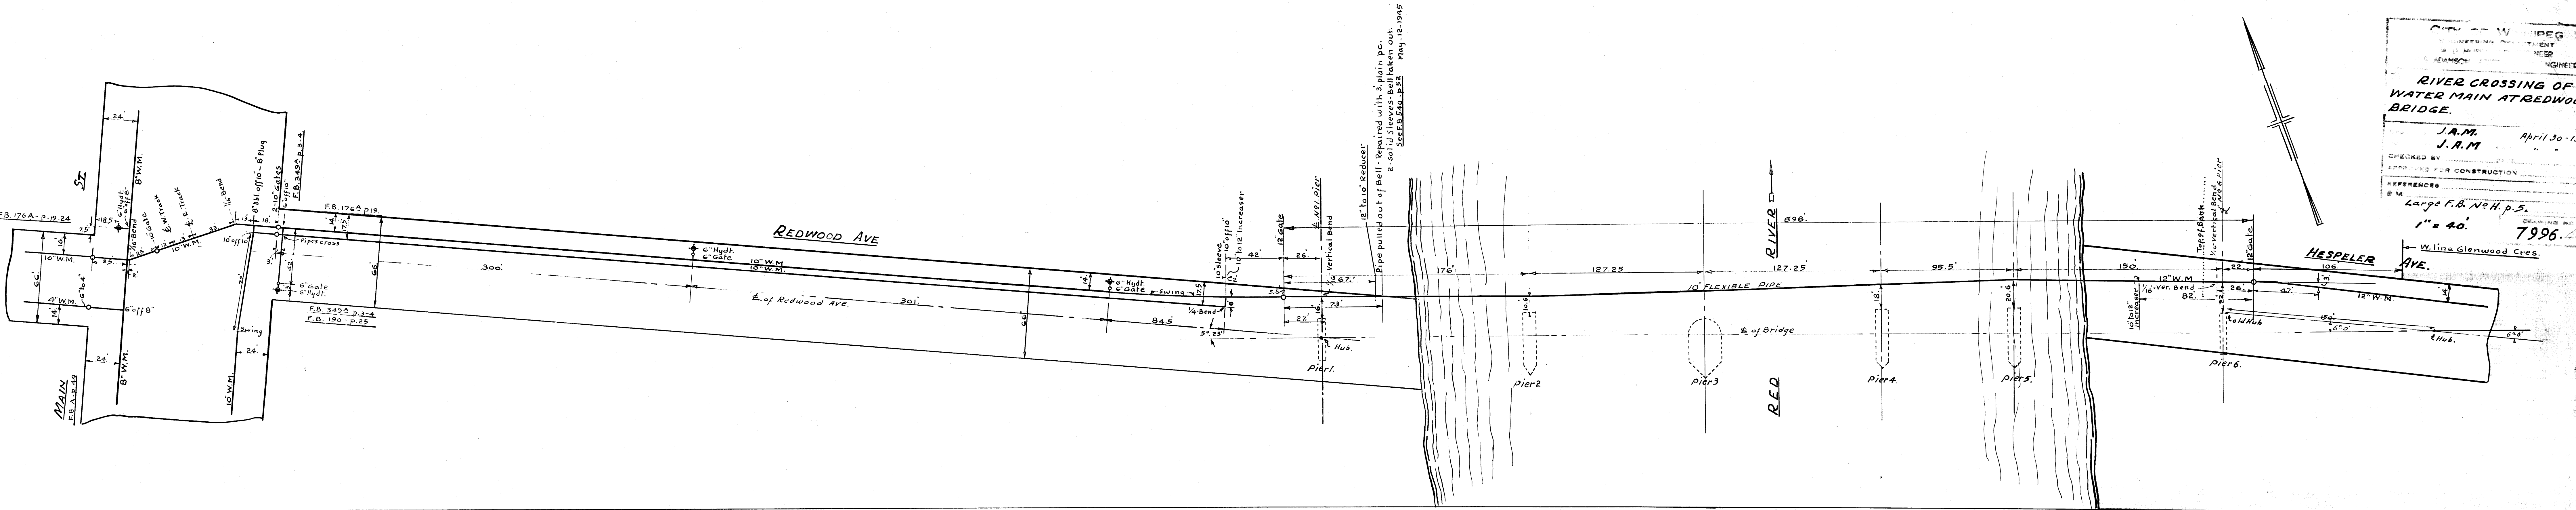

Pipe pulled out of Bell - Repaired with 3 plain pc.  
 2 solid sleeves - Bell taken out.  
 See F.B. 349 - P. 25 May 12-1945

07996

7996