295C REF. or DRAWING NO. [redacted]

295-3 DETAILS [redacted]

file # IN 10293

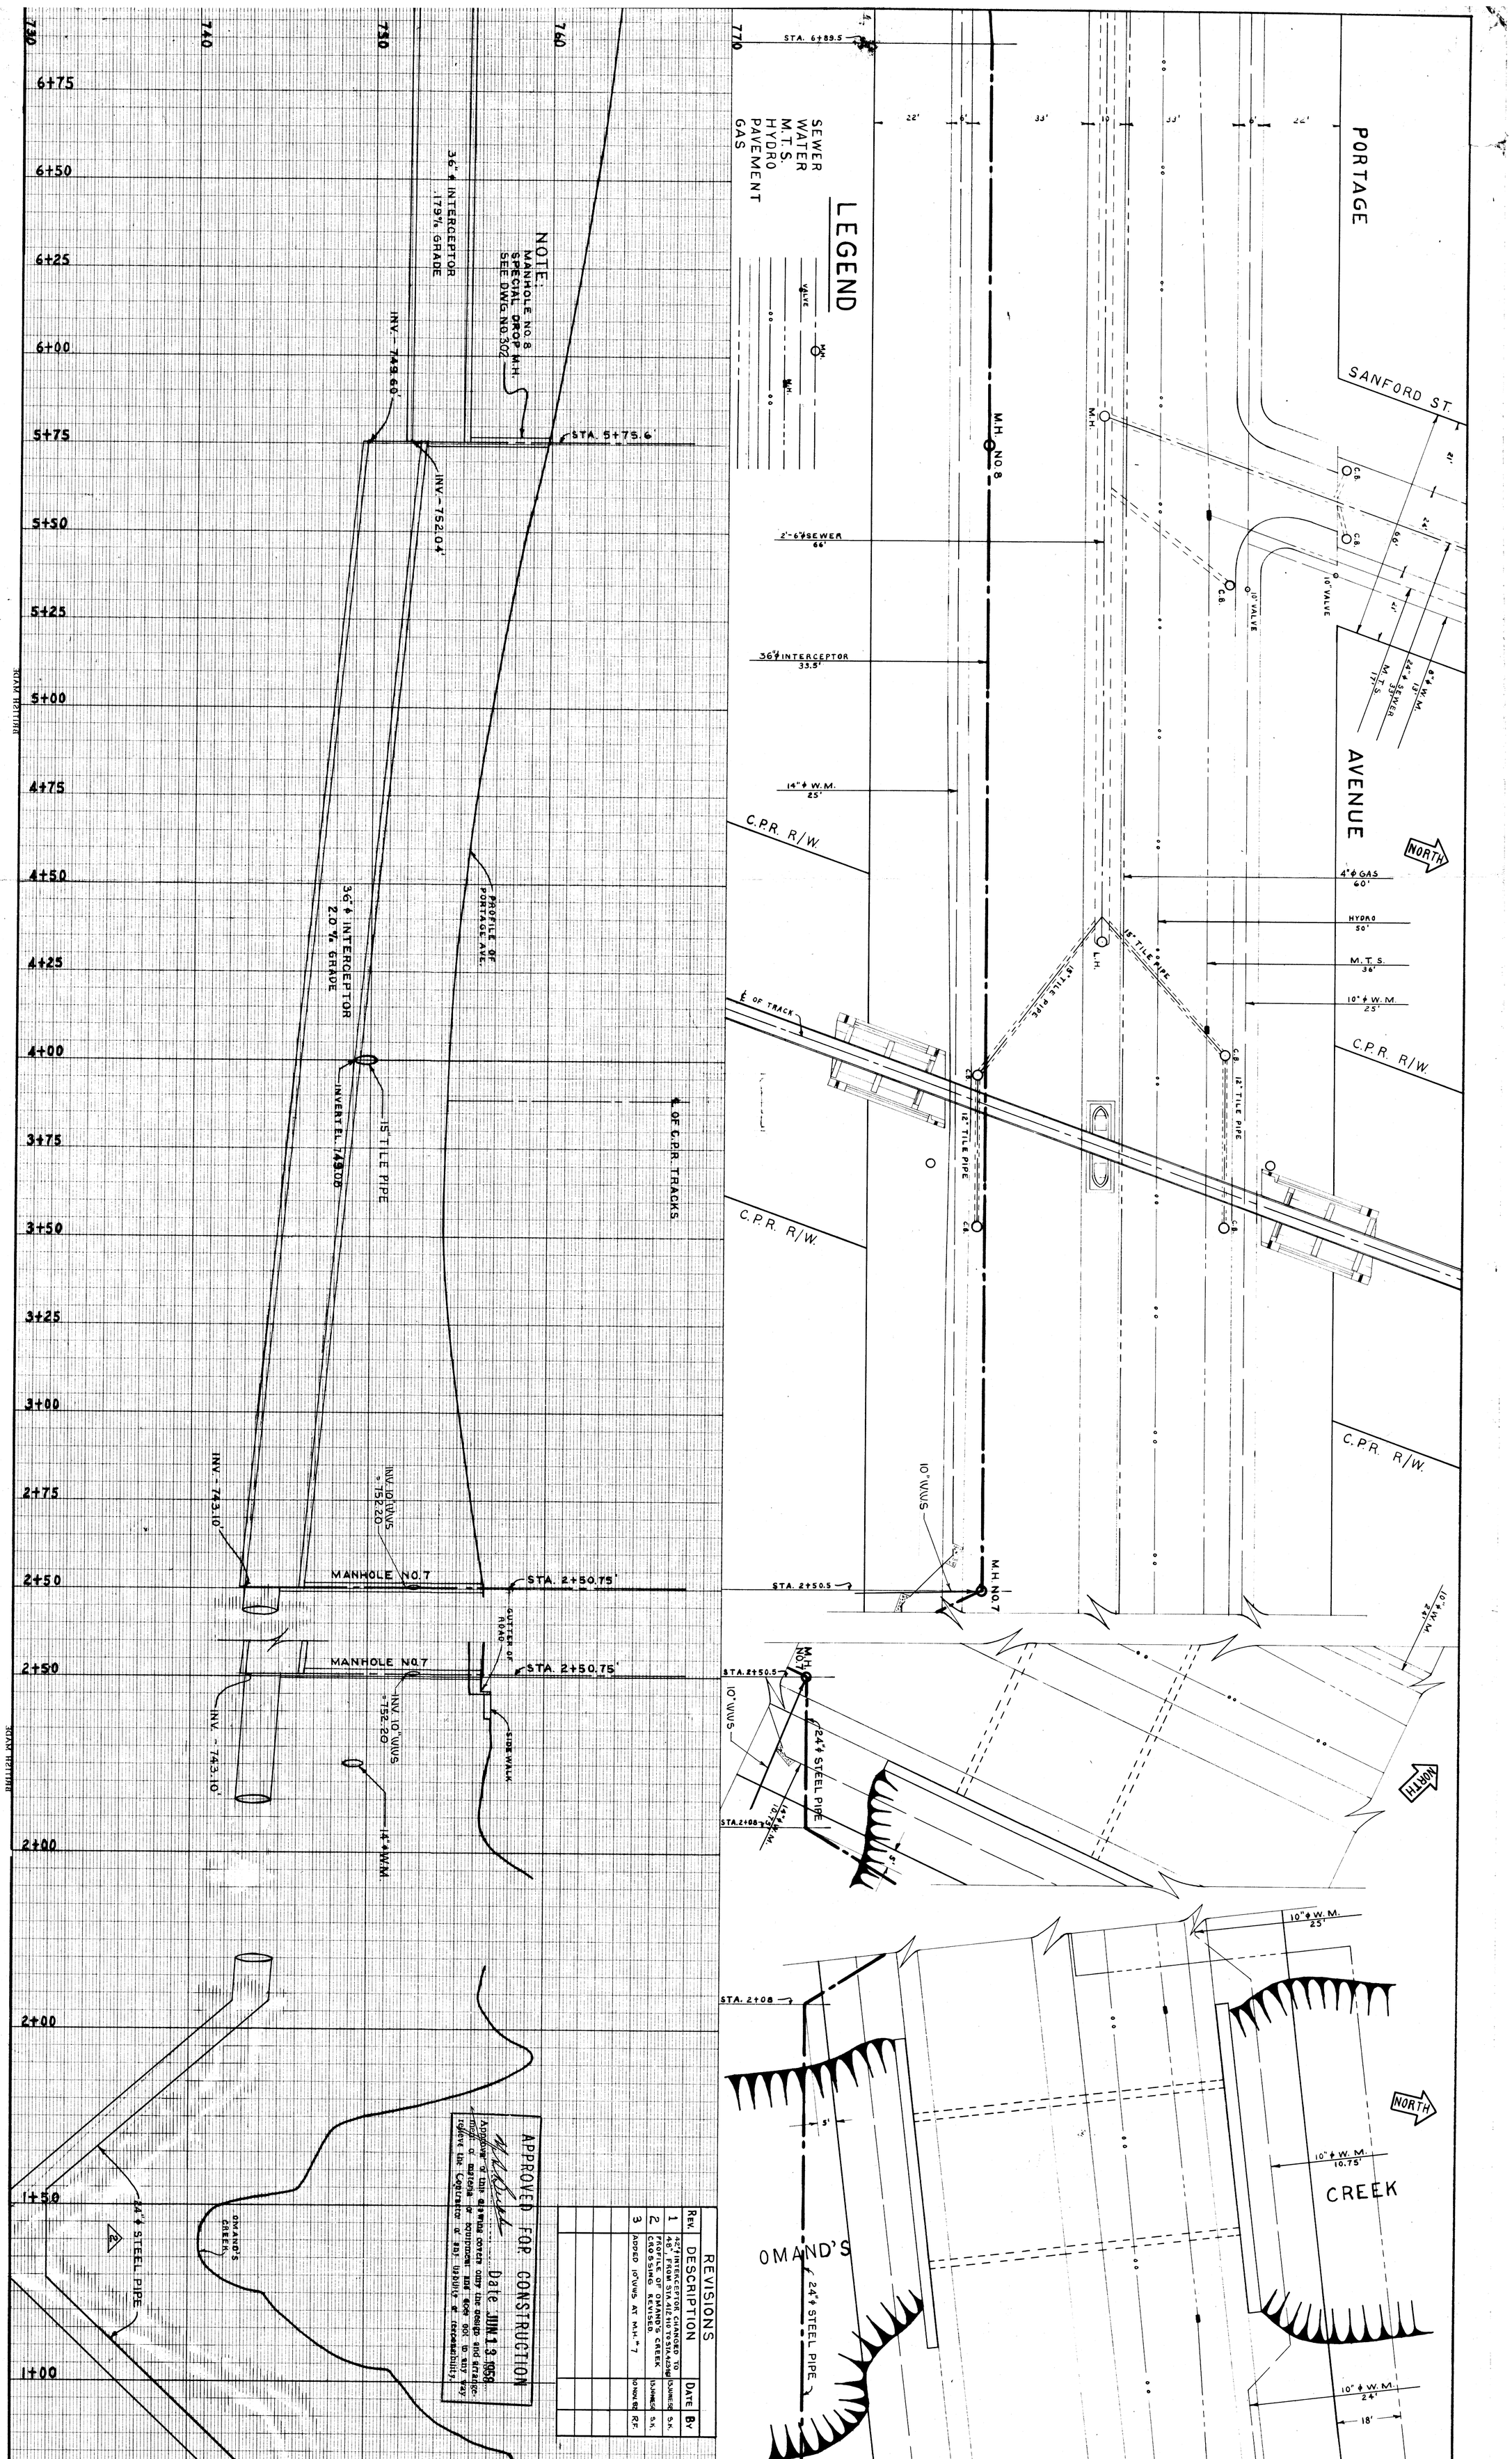

APPROVED FOR CONSTRUCTION

Approval of this drawing covers only the design and arrangement of materials or equipment and does not in any way relieve the Contractor of any liability or responsibility.

Date JUN 13 1958

Rev.	DESCRIPTION	Date	By
1	42"ϕ INTERCEPTOR CHANGED TO 48", FROM STA. 416+10 TO STA. 425+90	13 JUNE 58	S.K.
2.	PROFILE OF OMAND'S CREEK CROSSING REVISED	13 JUNE 58	S.K.
3	ADDED 10"WVS AT M.H. # 7	10 NOV. 82	R.F.

GREATER WINNIPEG SANITARY DISTRICT

PLAN PROFILE OF MAIN INTERCEPTOR EXTENSION, PORTAGE AVE. FROM OMAND'S CREEK TO C.P.R. SUBWAY X-ING.

DRAWN SK
TRACED
APPROVED
DATE 4 DEC. 1957
CHECKED GES
SUPT.
ENGR.

HOR. SCALE 1" = 20'
VERT. 1" = 4'

DWG. NO. 295

PROVINCE OF MANITOBA REGISTERED ENGINEER R.C. SOMMERVILLE

Microfilmed 1985 295C 295-3