


PLAN

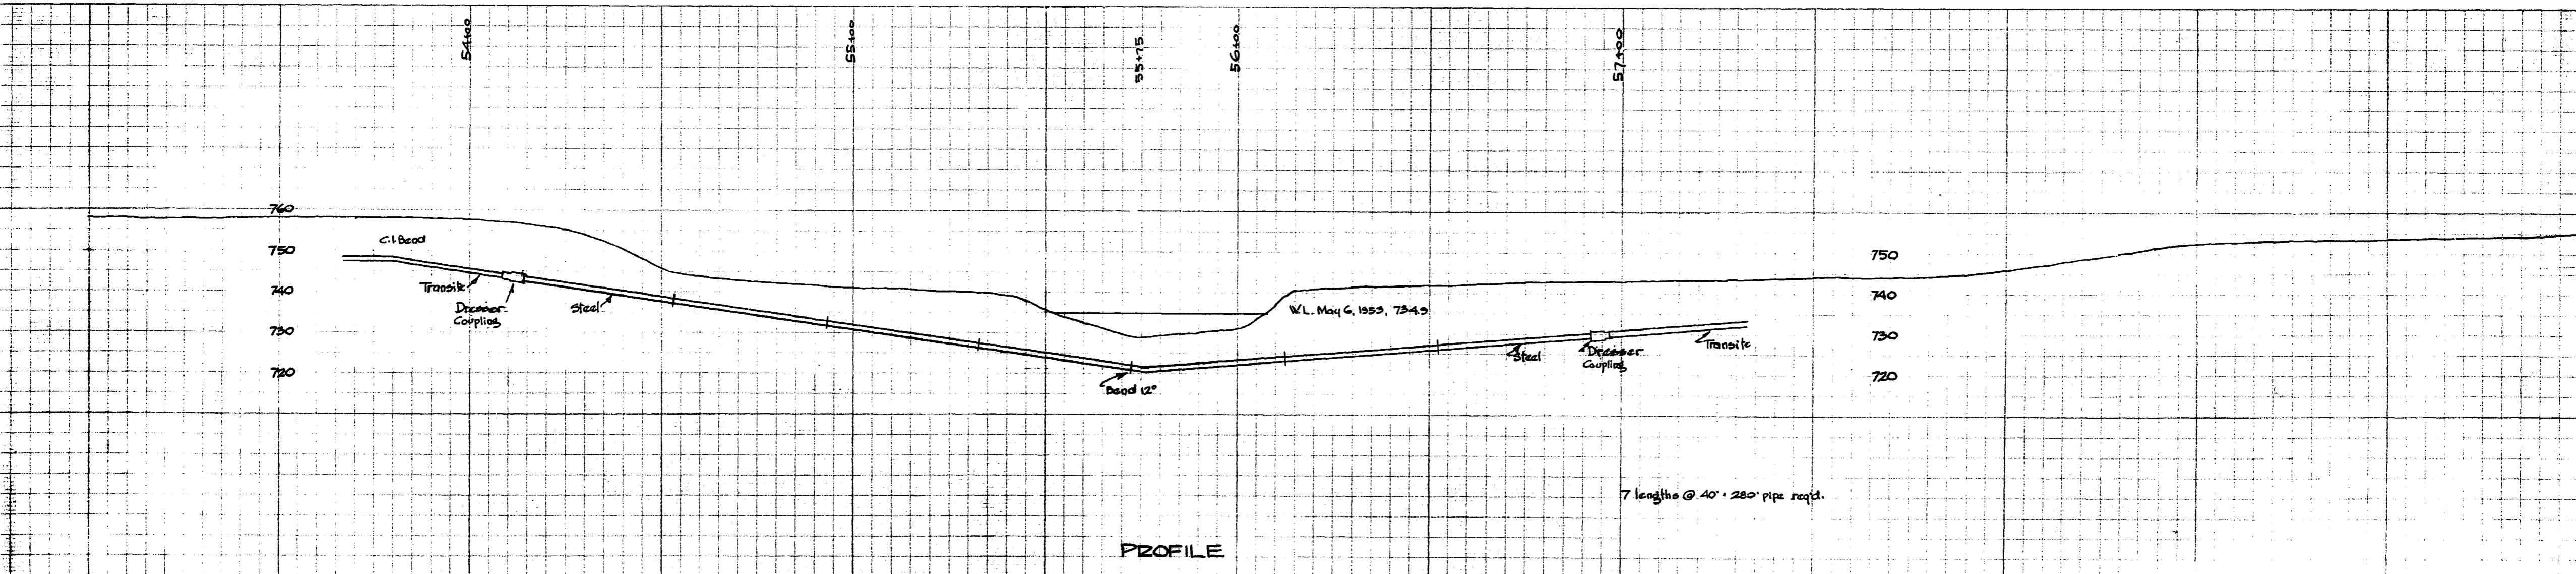

PROFILE

GREATER WINNIPEG WATER DISTRICT
 ST. VITAL CONNECTION CROSSING
 OF SEINE RIVER
 SCALE: Hor. 1" = 20'
 VER. 1" = 20'

Winnipeg, June 3, 1933

J. H. Smith
 PROJECT MANAGER

Revised June 29, 1933 - Dresser Couplings added.