




ENLARGED FLOOR PLAN RENOVATION NOTES:

- 1 RELOCATED STAINLESS STEEL COUNTER, SINKS, AND ELECTRIC FAUCETS. CONTRAST TO VERIFY DIMENSIONS PRIOR TO CONSTRUCTION OF ADJACENT CONCRETE BLOCK WALL. COORDINATE ELECTRICAL FOR FAUCETS.
- 2 FOLD DOWN SHOWER BENCH.
- 3 FIXED 30" X 72" TRANSFER BENCH.
- 4 DOUBLE TIER COIN OPERATED LOCKERS WITH SLOPED TOPS ON A-TYPED BASE WITH STAINLESS STEEL FINISH.
- 5 BABY CHANGE STATION.
- 6 RELOCATED EXISTING STAINLESS STEEL COIN OPERATED LOCKERS WITH SLOPED TOPS ON BASE AS NOTED IN NOTE 4. BENCH REFER TO A-504 FOR DETAILS.
- 7 RELOCATED REFRIGERATOR(28Wx30Dx62 1/4"H). REVERSE HINGES.
- 8 RELOCATED BLEACHER.
- 9 RELOCATED EXISTING AND NEW COLLAPSIBLE COAT HOOKS.
- 10 RELOCATED VENDING MACHINE.
- 11 RELOCATED BABY CHANGE STATION.
- 12 COUNTER WITH INTEGRATED TRANSFER BENCH. REFER TO A-504 FOR PERFORATION DETAILS.
- 13 RECEPTION DESK. REFER TO A-505 FOR DETAILS.
- 14 AUTOMATIC DOOR OPENER - BOTH SIDES OF DOOR.
- 15 SERVER.
- 16 NEW ALUMINUM WINDOW WITH FROSTED GLAZING. REFER TO SPECIFICATION.
- 17 BLUE STROBE LIGHT.
- 18 TRENCH FOR FLOOR DRAIN.
- 19 PROVIDE FAKE LOCKER WITH SLOPPED TOP IN FRONT OF STEEL COLUMN.
- 20 SALVAGED STAINLESS STEEL VANITY CUT DOWN TO LENGTH OF WALL. PLACE CUT EDGE AGAINST WALL. POLISH SMOOTH.
- 21 EXISTING ROOF ACCESS LADDER TO REMAIN.
- 22 NEW VANITY. REFER TO A-504 FOR DETAILS.
- 23 COAT RACK. REFER TO A-503 FOR DETAILS.
- 24 TRANSOM WINDOW ABOVE.
- 25 RELOCATED EXISTING PAPER TOWEL DISPENSER.
- 26 MILLWORK COUNTERTOP CUV LOWERS.
- 27 WORK STATION CUV UPPEERS AND LOWERS. REFER TO A-504 FOR DETAILS.
- 28 RELOCATED HAND DRYER.
- 29 EXISTING HEATER TO RECEIVE PAINT FINISH.
- 30 DISTRESS ALARM.
- 31 EXISTING COMMERCIAL PLATE TO BE REINSTALLED.
- 32 EXISTING BULLETIN BOARD TO BE REINSTALLED.
- 33 PAMPHLETS HOLDER.
- 34 DOUBLE TIER COIN OPERATED LOCKERS ON BASE AS NOTED IN NOTE 4.
- 35 SOUND ALARM.
- 36 DOUBLE TIER LOCKERS WITH SLOPED TOPS ON BASE AS NOTED IN NOTE 4.

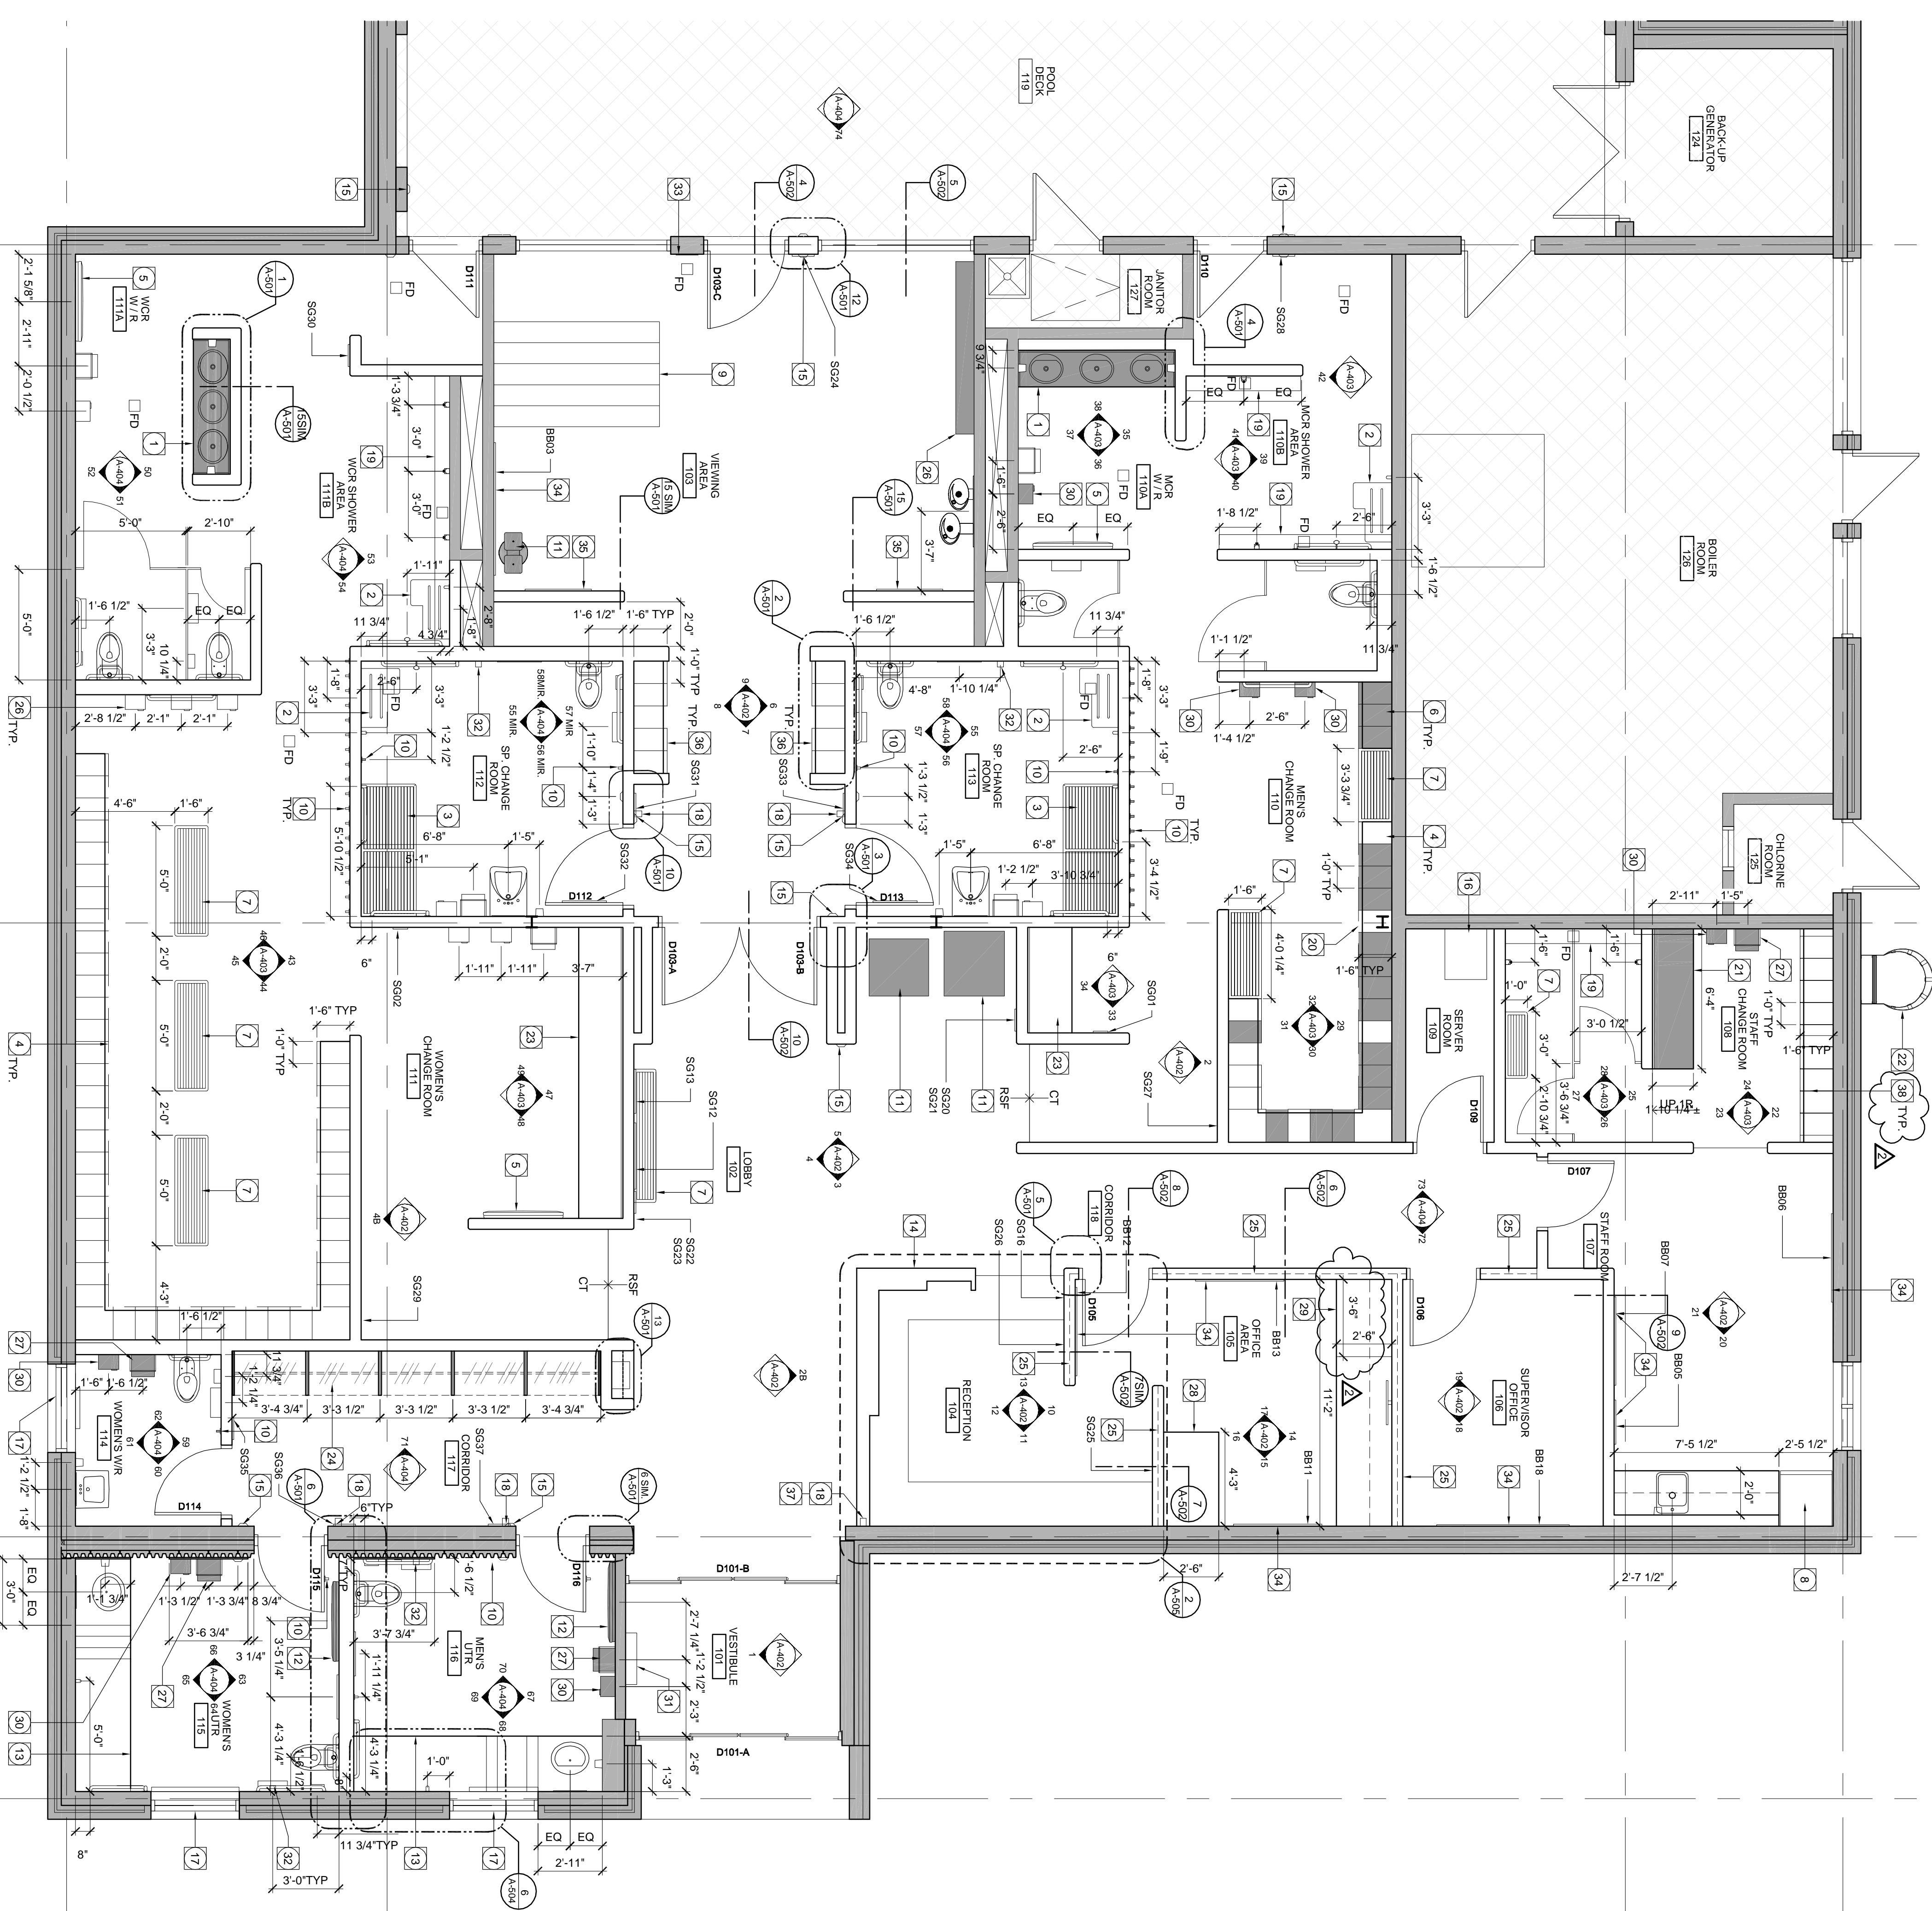

Ownership of Documents: The Architect shall retain the ownership of the project documents, including but not limited to, drawings, specifications, and reports, and shall remain the property of the Architect whether the project is completed or not. They are not to be used for any other project without the written consent of the Architect. The Architect's liability is limited to the compensation to the Architect.

This drawing shall not be scaled. Follow given dimensions only.

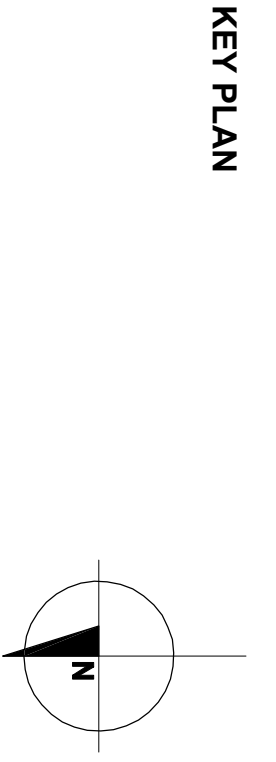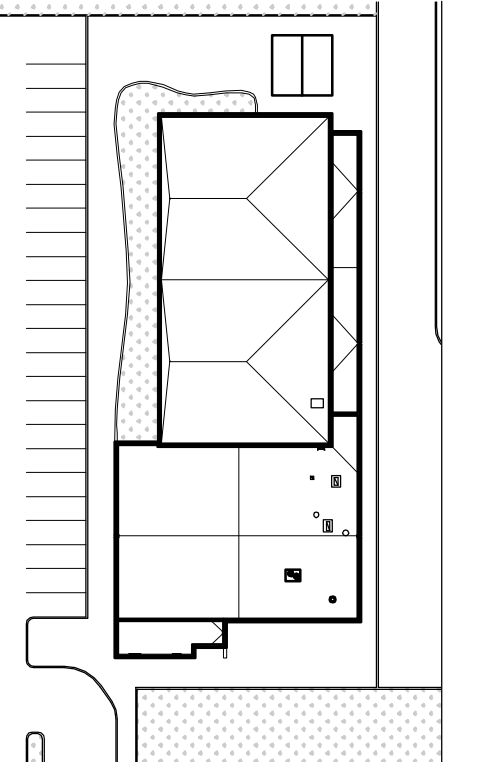

ADDENDUM #

ISSUED FOR
CONSTRUCTION

ARCHITECT / PRIME CONSULTANT
SYNSHYN
ARCHITECTURE + INTERIOR DESIGN INC.
www.synshyn.com

ENGINEERING CONSULTANT
CROSIER KILGOUR & PARTNERS Ltd.
300-275 Carlton Street
Winnipeg, Manitoba
F: 204-843-7507

OWNER
CITY OF WINNIPEG
Planning and Development Department
300-65 Garry Street
Winnipeg, Manitoba
F: 204-944-4444

PROJECT TITLE
**MARGARET GRANT POOL
INTERIOR RENOVATIONS
BID OPPORTUNITY
NO.12-2013**

DRAWING TITLE
ENLARGED FLOOR PLANS

DESIGNED BY JS DRAWN BY LB
ISSUE DATE 02-28-2013 REVISION No. 01
PROJECT No. 12904 DRAWING No. **A-401**

1 ENLARGED FLOOR PLAN
Scale 1/4" = 1'-0"