
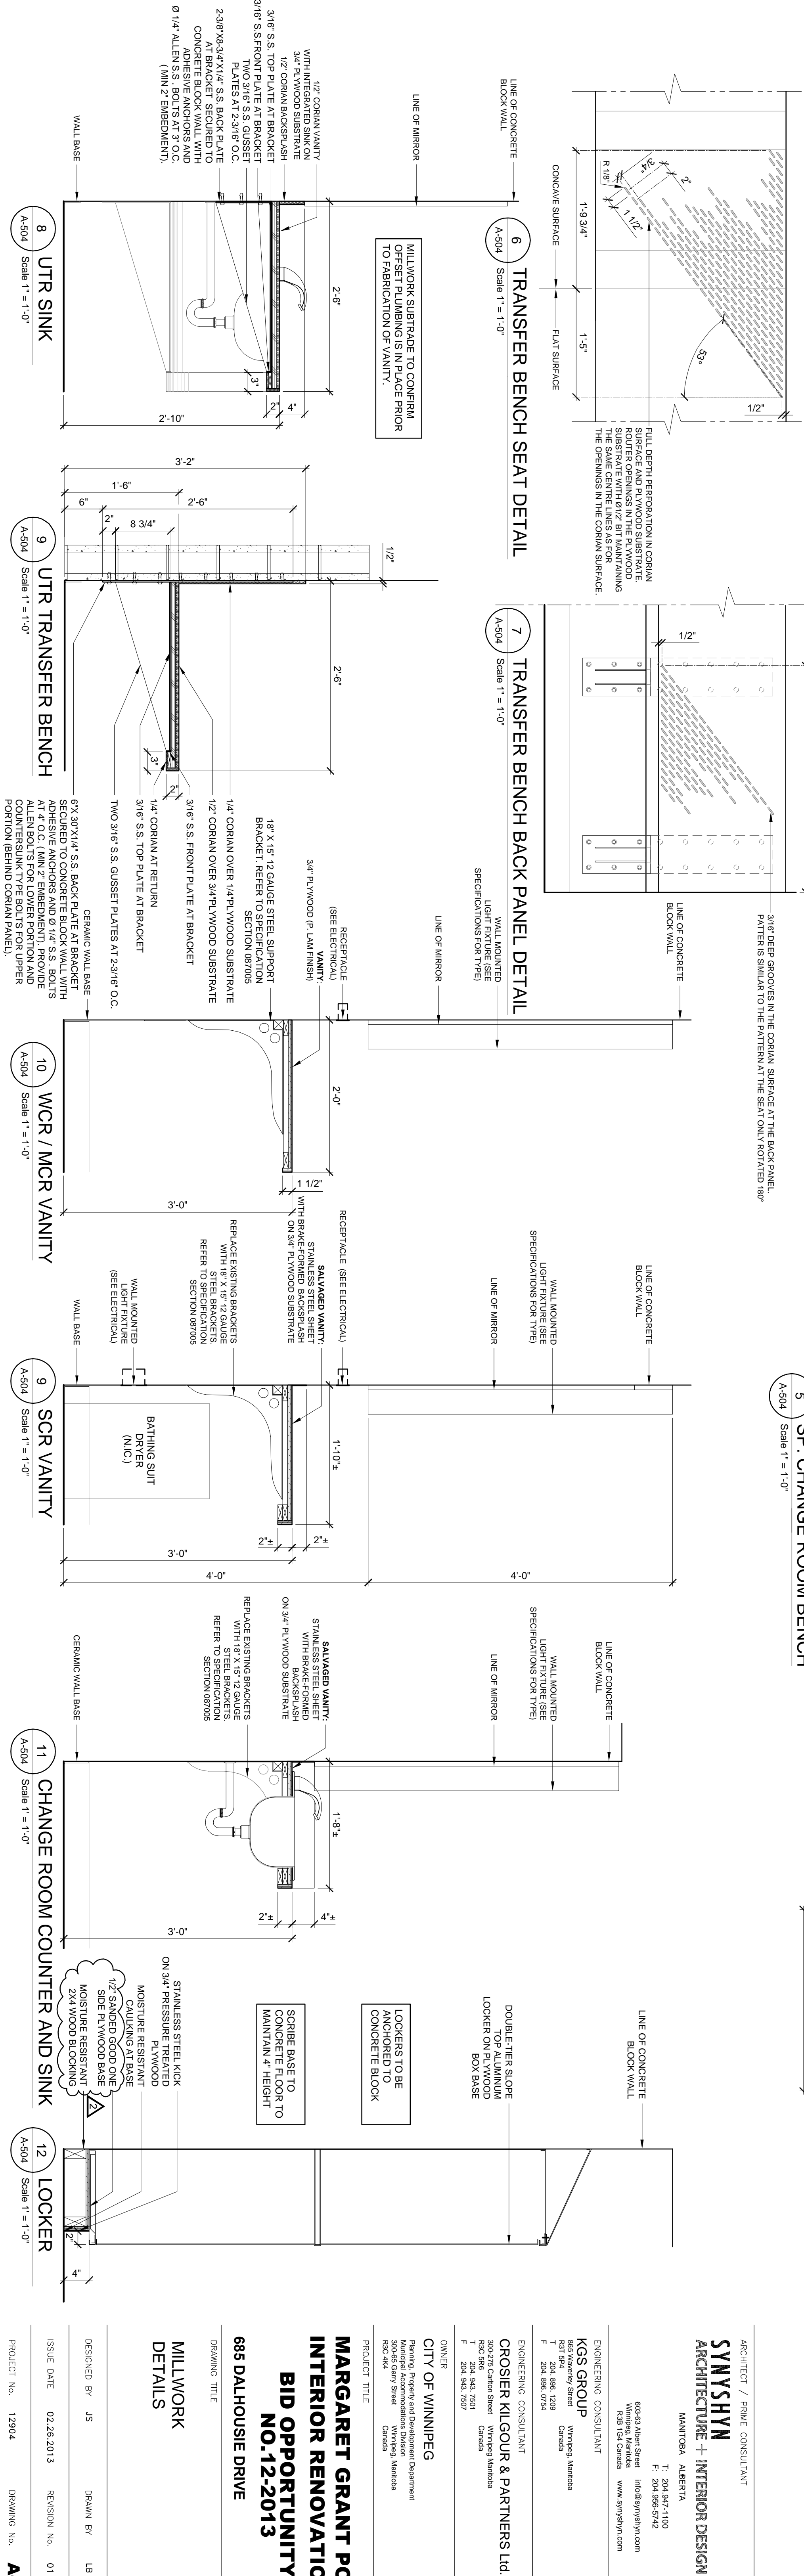


**NOTES:**  
SUPPORT BRACKETS FOR DIFFERENT SIZE CEDAR SLAT BRACKETS ARE SIMILAR IN DESIGN. REFER TO 1/4-5/8\"/>

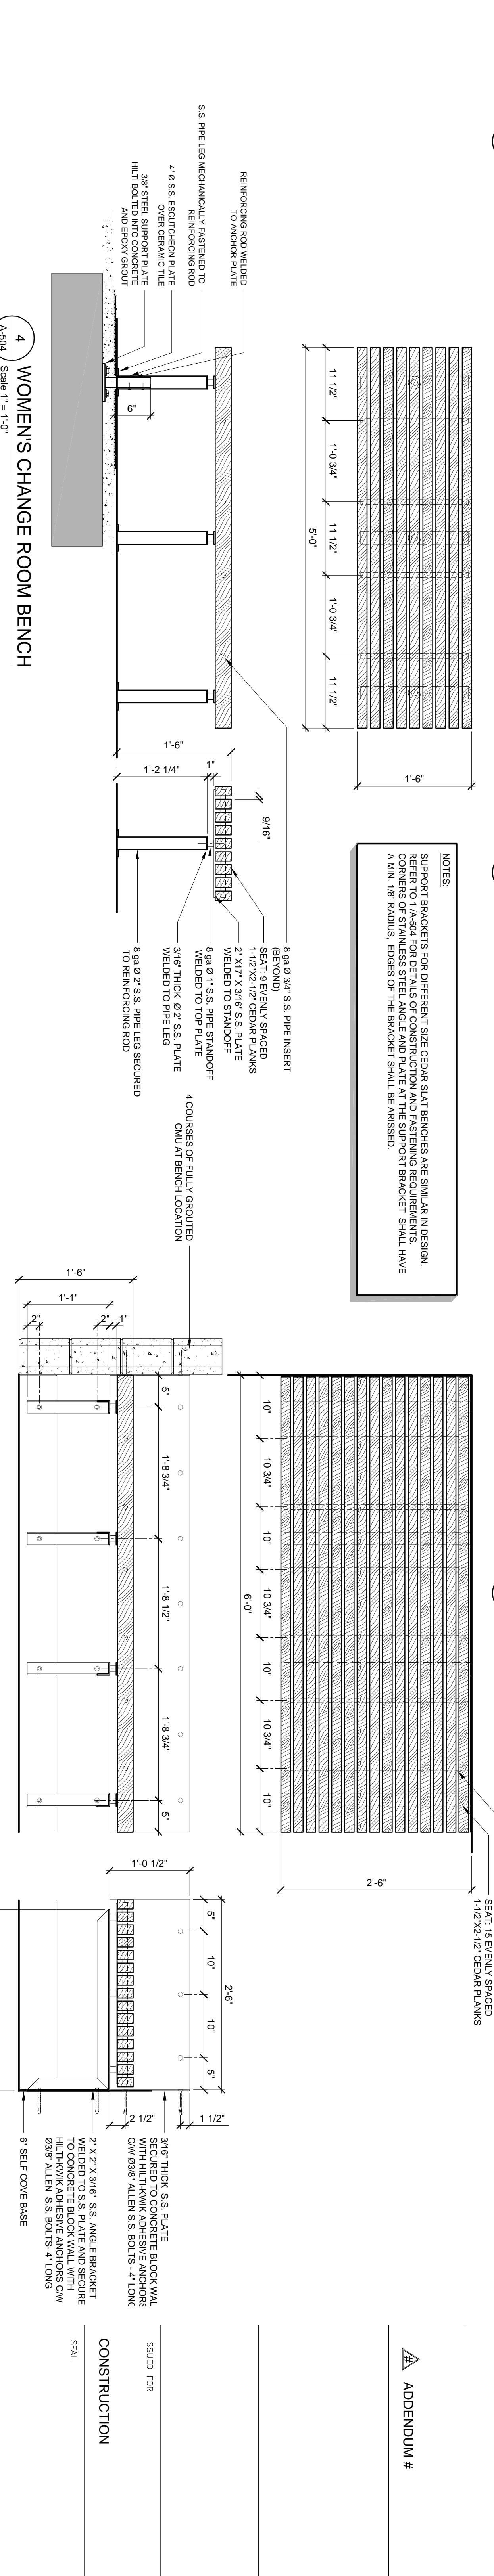

**ADDENDUM #**

ISSUED FOR  
CONSTRUCTION  
SEAL

ARCHITECT / PRIME CONSULTANT  
**SYMSHYN ARCHITECTURE + INTERIOR DESIGN INC.**  
MANTOBA ALBERTA  
T: 204.947.1100  
403-43 Albert Street  
Winnipeg, Manitoba  
www.symsbyn.com

ENGINEERING CONSULTANT  
**KGS GROUP**  
Winnipeg, Manitoba  
Winnipeg, Manitoba  

ENGINEERING CONSULTANT  
**CROSIER KILGOU & PARTNERS Ltd.**  
300-275 Carlton Street  
Winnipeg, Manitoba  

OWNER  
**CITY OF WINNIPEG**  
300-655 Garry Street  
Winnipeg, Manitoba  

**MARGARET GRANT POOL INTERIOR RENOVATIONS BID OPPORTUNITY NO.12-2013**


DRAWING TITLE  
**MILLWORK DETAILS**  
DESIGNED BY: JS  
DRAWN BY: LB  
ISSUE DATE: 02.26.2013  
REVISION No. 01  
PROJECT No. 12904  
DRAWING No. **A-504**