


DISTANCE FROM  $\phi$  SUCTION TO MOTOR RM. FLOOR PUMP # 1 = 7.23'  
 " " " " " " " " " # 2 = 7.17'  
 EXIST. PUMP RM. FLOOR ELEV. -2.10'

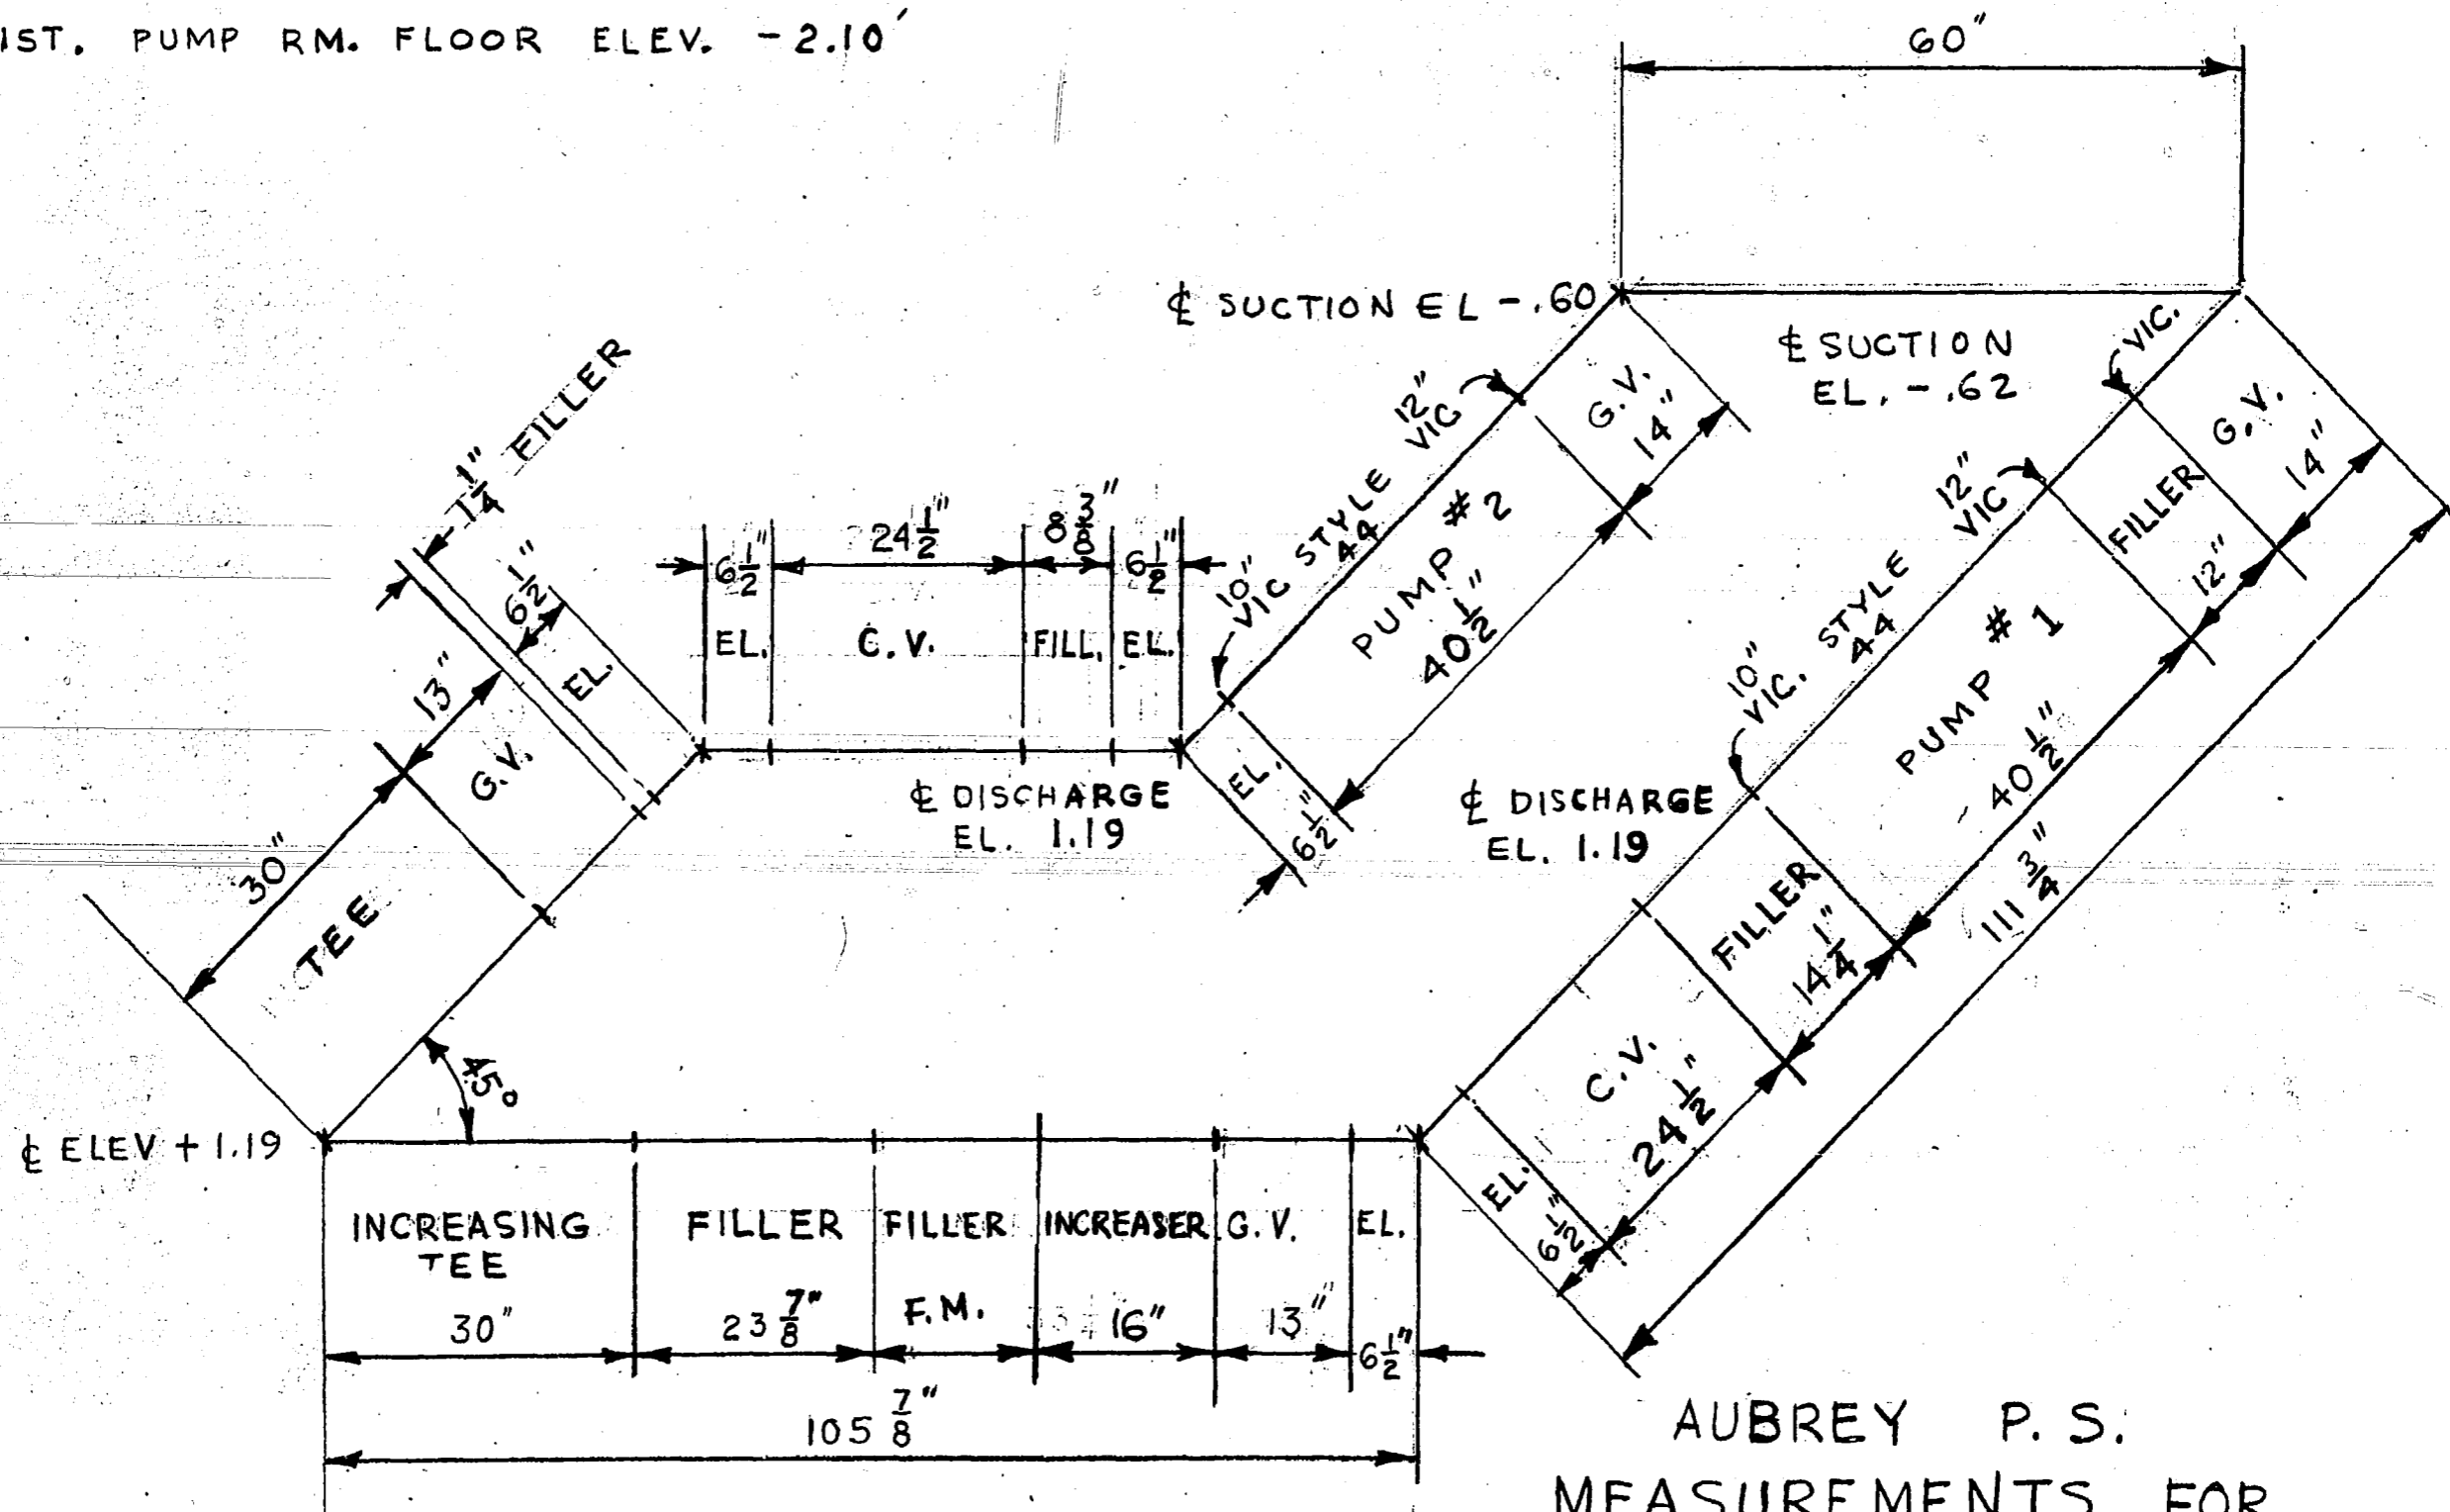

FLANGED FITTINGS EXCEPT WHERE NOTED.  
 ALL DIMENSIONS FACE TO FACE OF FITTINGS.

SCALE: 1/2" = 1'-0"

AUBREY P. S.  
 MEASUREMENTS FOR  
 NEW PUMP INSTALLATION

**S-358**