


B SIZE - 279mm x 432mm

LAST SAVE: 2013/01/15 - 3:08pm  
 PATH: M:\112577\0106\4ENG\481&C\DD - General DWG\1-0102G-A0058-001-02.dwg

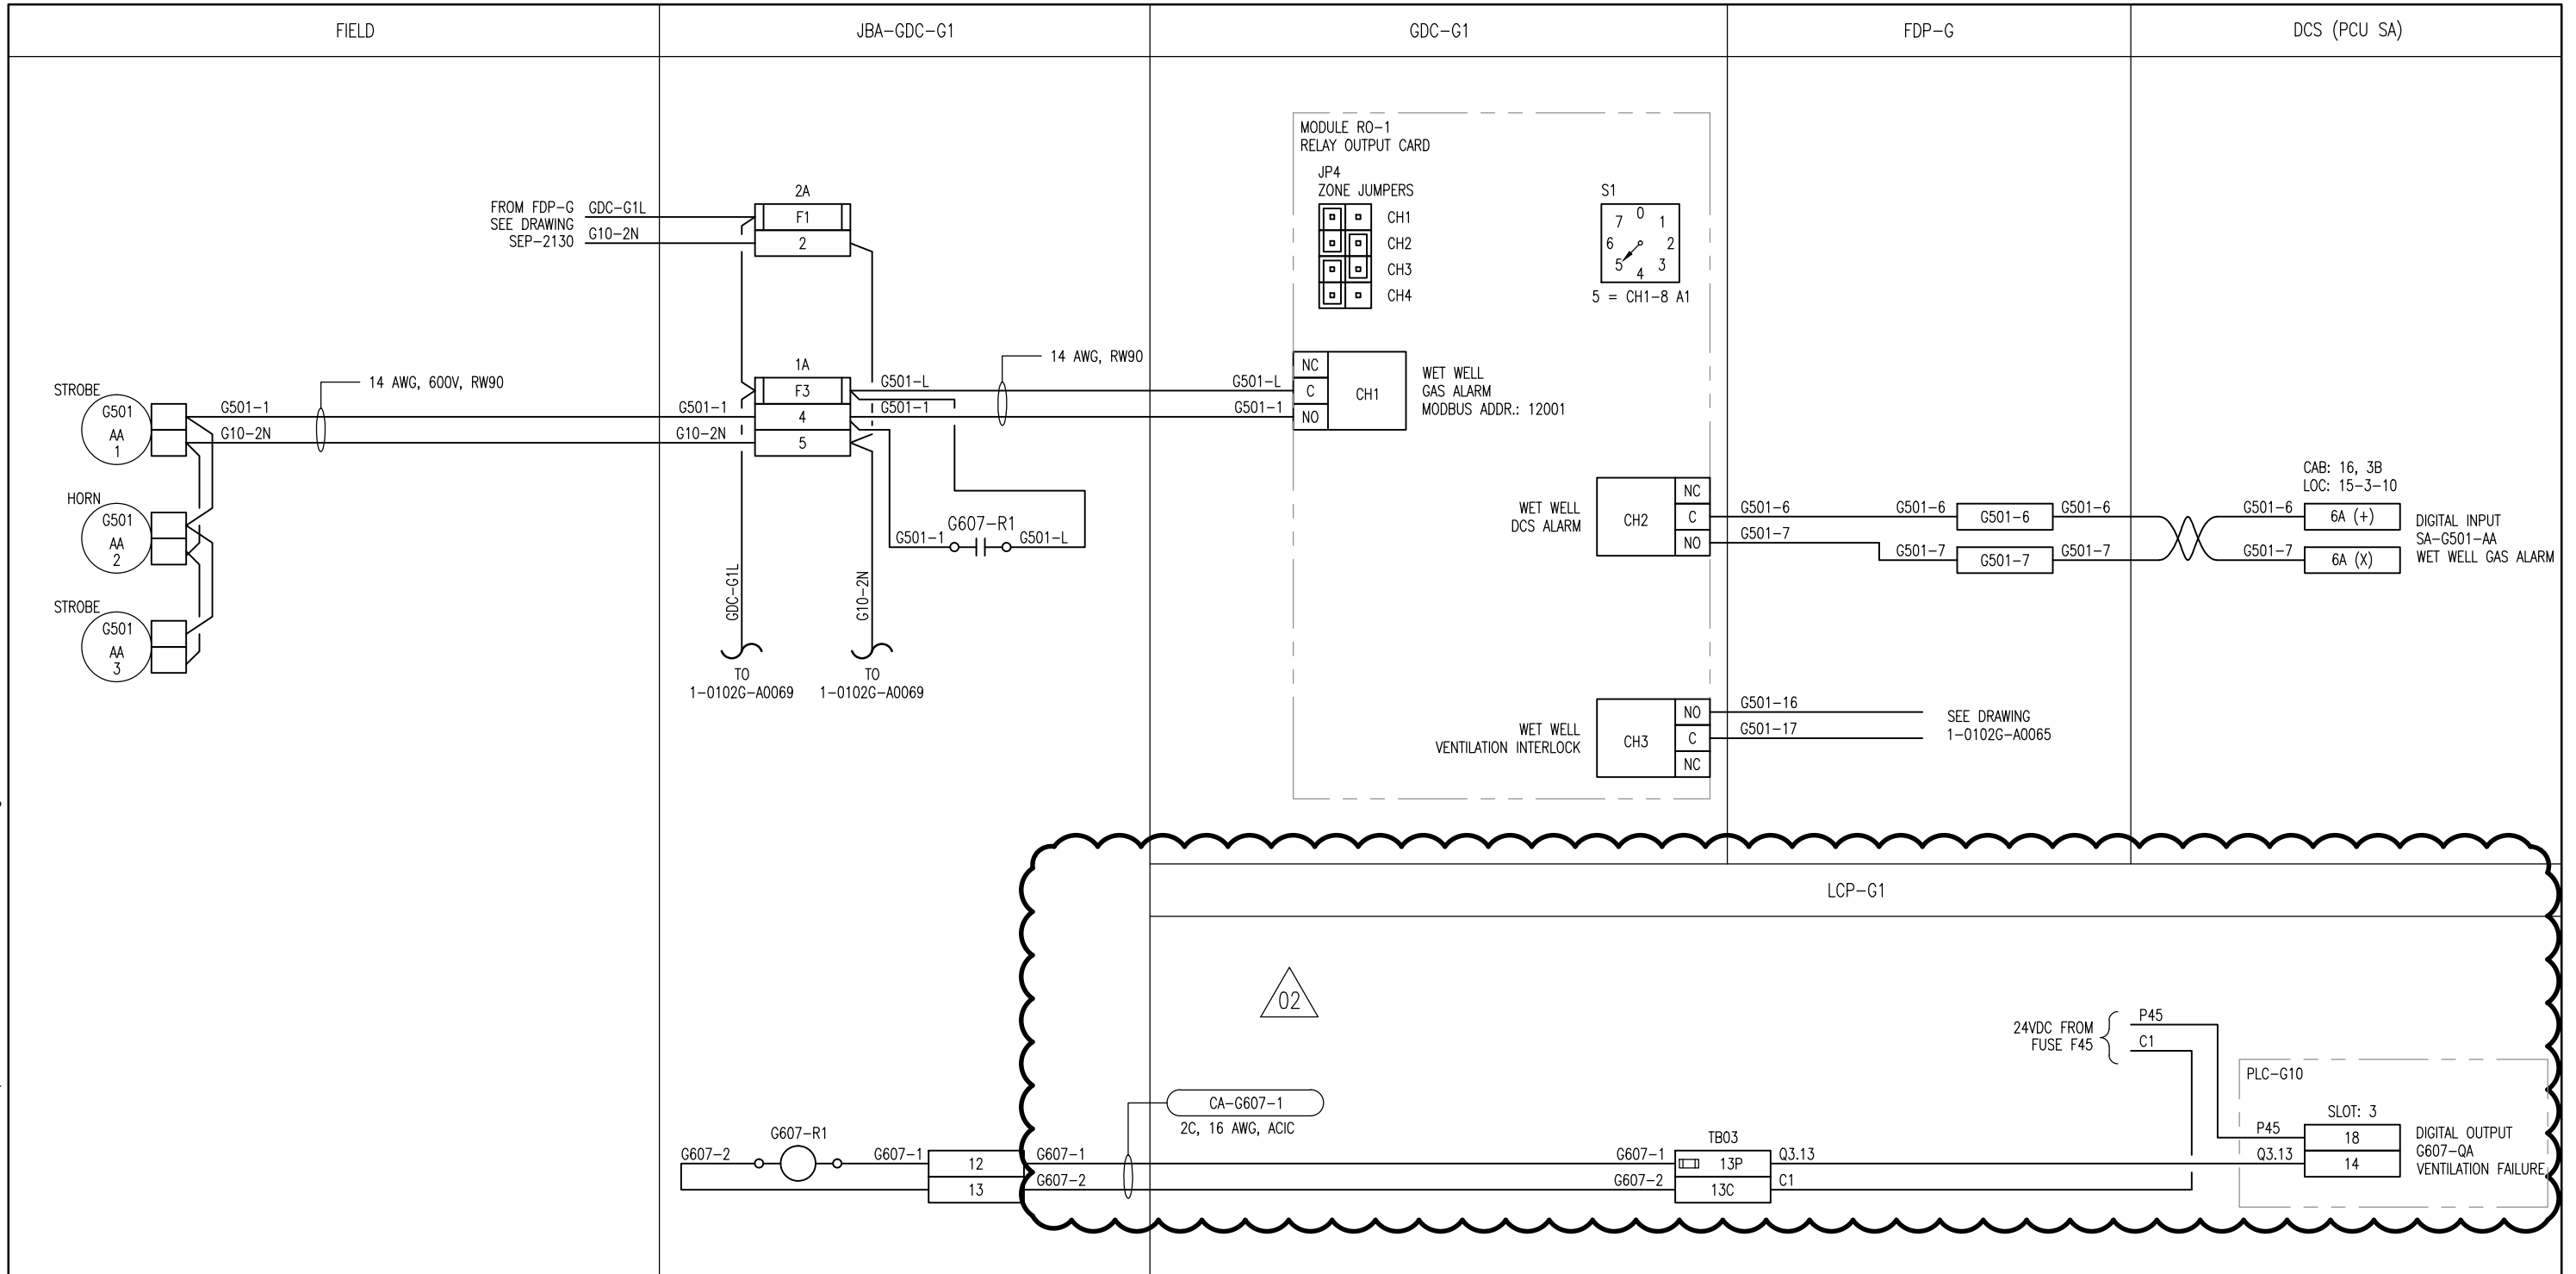

- NOTES:**
- G607-R1 IS A WET WELL VENTILATION FAILURE ALARM. SEE DRAWING 1-0102G-A0051 FOR WIRING DETAILS.
  - INSTALL IN ACCORDANCE WITH HAZARDOUS CLASS I, ZONE 2 REQUIREMENTS.



**SNC-LAVALIN INC.**  
 148 Nature Park Way  
 Winnipeg, MB, Canada R3P 0X7  
 204-786-8080

ENGINEER'S SEAL

NO.	REVISIONS	DATE	DESIGN	CHECK
02	ADDED LCP-G1 CONNECTION, BID OPP. 42-2013	2013/01/15	TMC	CJR
01	ADDED LCP-G1 CONNECTION, BID OPP. 545-2012	2012/08/31	TMC	CJR
00	ISSUED FOR TENDER, BID OPP. 209-2011	2011/03/11	TMC	CJR

DESIGNED BY: T. CHURCH	CHECKED BY: C. REIMER
DRAWN BY: S. COATES	APPROVED BY: C. REIMER
SCALE: NTS	DATE: 2009/10/23
RELEASED FOR CONSTRUCTION	
BY: N. HARRINGTON	DATE: 2011/03/11
CONSULTANT NO.: 112577-0106-48DD-1214	



SOUTH END WATER POLLUTION CONTROL CENTRE  
 ESSENTIAL SYSTEM UPGRADES  
 INSTRUMENT LOOP DIAGRAM  
 G501 WET WELL GAS ALARM & G607 VENT FAILURE

CITY DRAWING NUMBER	SHEET	REV.	SIZE
1-0102G-A0058	001	02	B