


B SIZE - 279mm x 432mm

LAST SAVE: 2013/01/15 - 3:33pm  
 PATH: M:\112577\0113\4ENG\47ELE\DD - General DWG\1-0102G-A0090-001-02.dwg

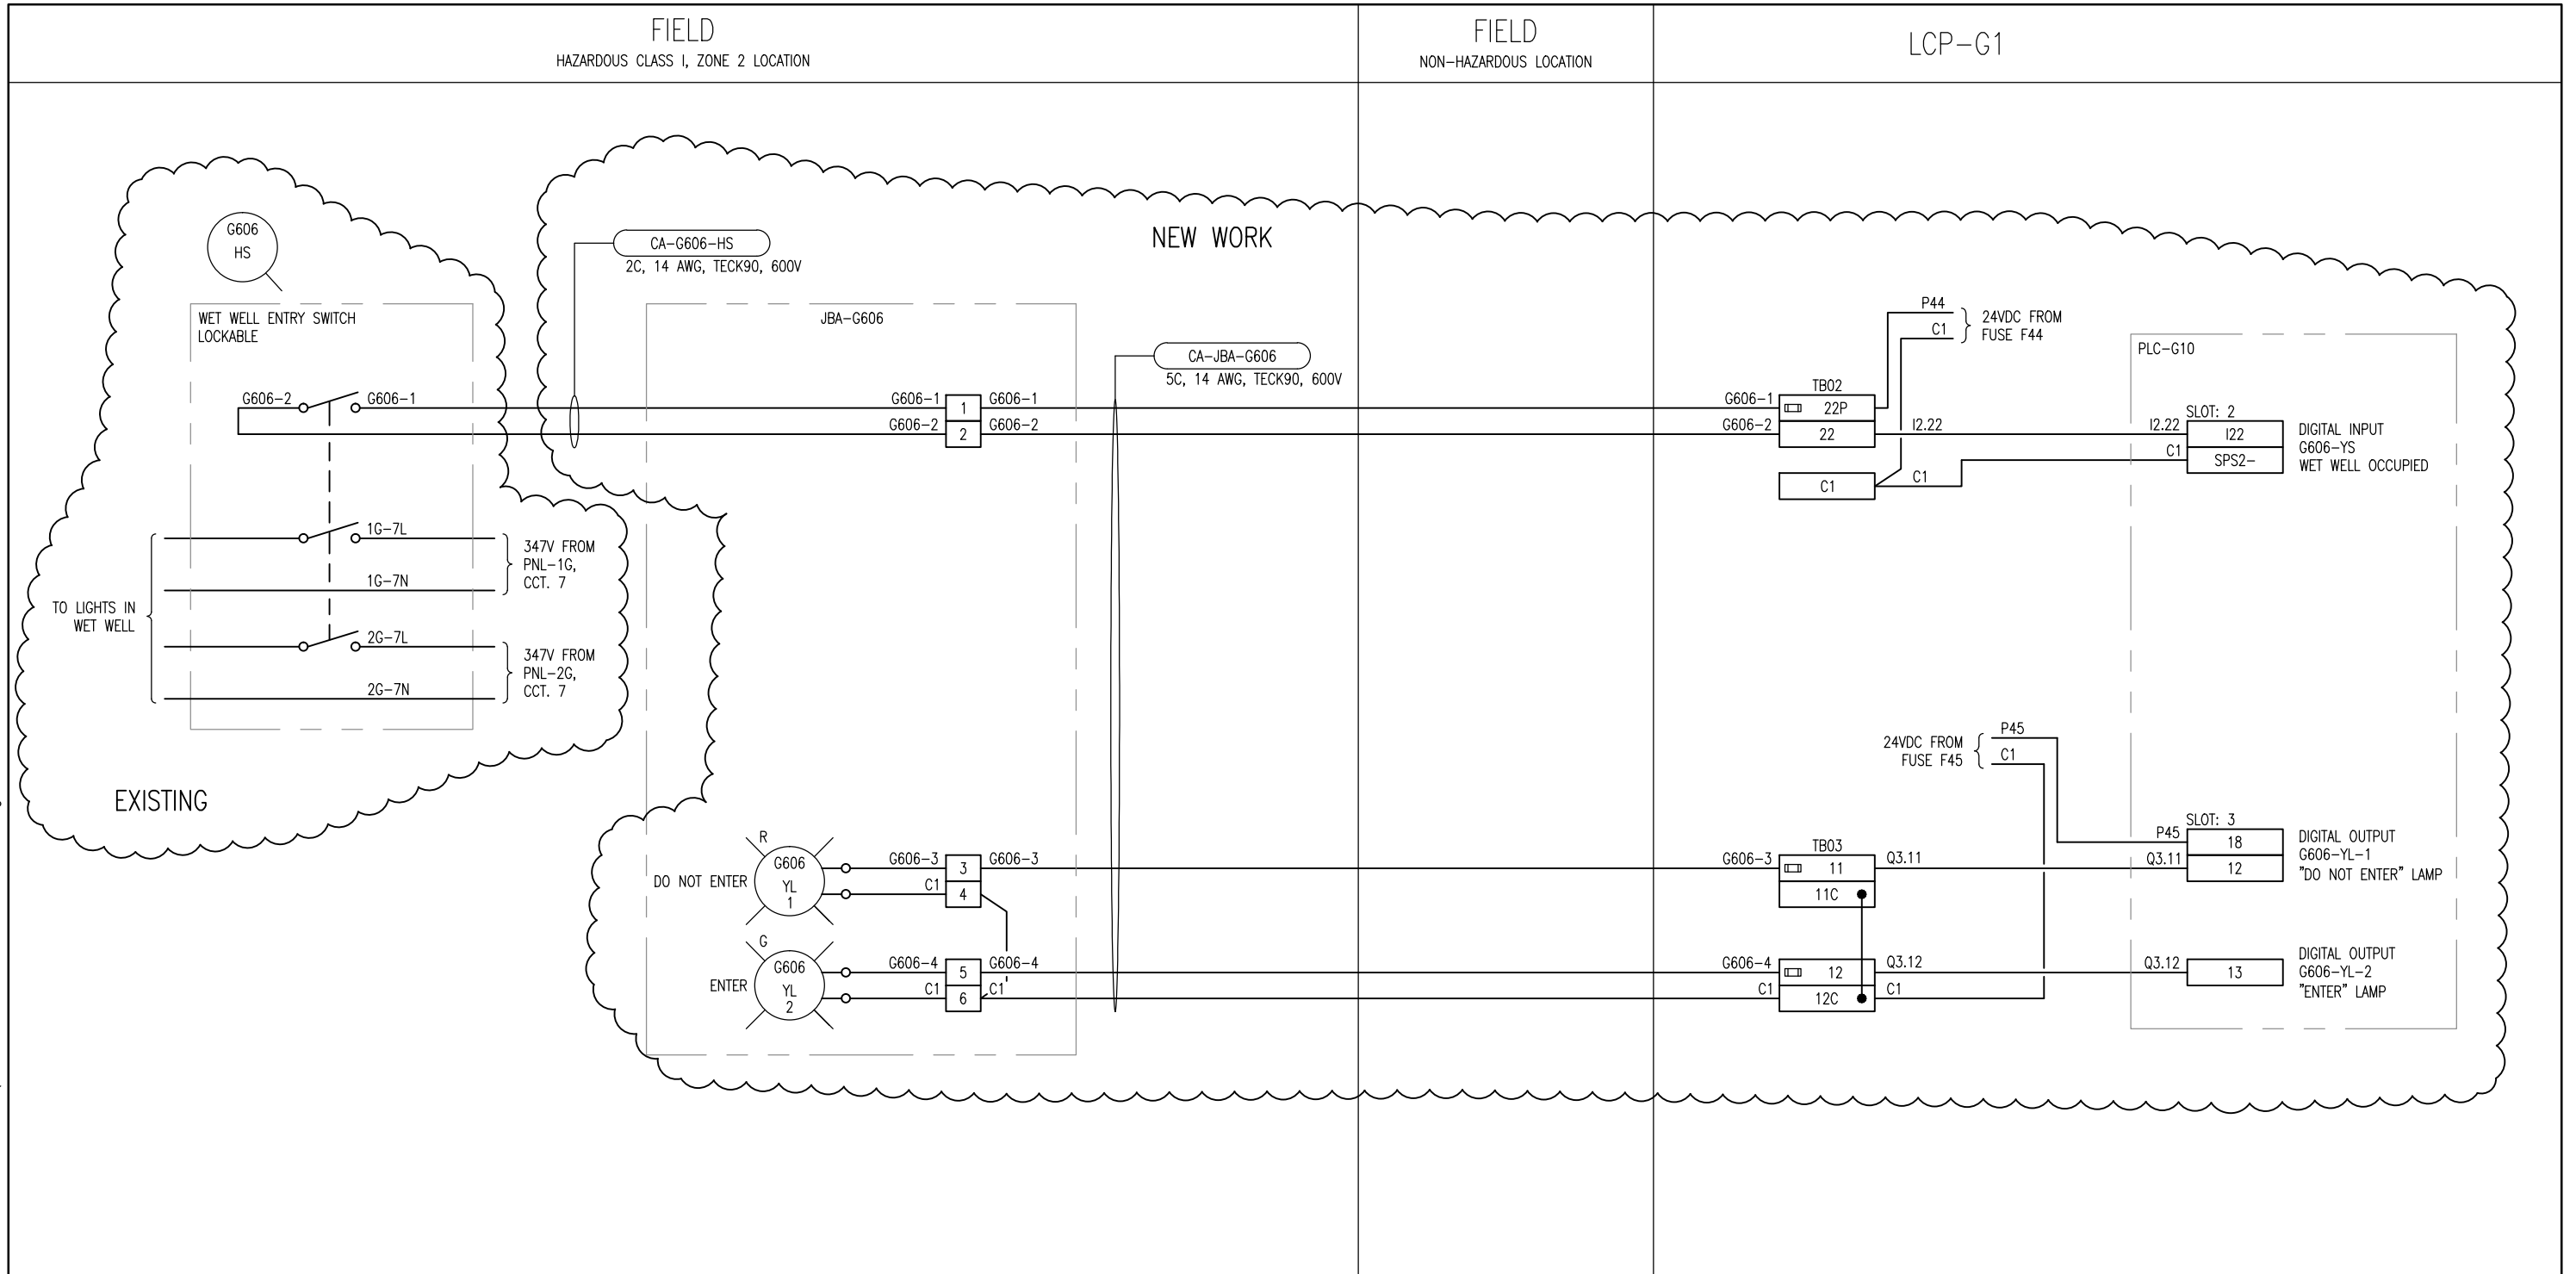

**NOTES**  
 1. UTILIZE HAZARDOUS RATED TECK CABLE CONNECTORS.

**APECM**  
 Certificate of Authorization  
 SNC-Lavalin Inc.  
 No. 4489

NO.	REVISIONS	DATE	DESIGN	CHECK
02	ADDED CONNECTION TO LCP-G1, BID OPP. 42-2013	2013/01/15	TMC	CJR
01	ADDED CONNECTION TO LCP-G1, BID OPP. 545-2012	2012/08/31	TMC	CJR
00	ISSUED FOR TENDER, BID OPP. 7-2012	2012/02/08	TMC	CJR

**SNC-LAVALIN INC.**  
 148 Nature Park Way  
 Winnipeg, MB, Canada R3P 0X7  
 204-786-8080

DESIGNED BY: T. CHURCH  
 CHECKED BY: C. REIMER

DRAWN BY: MJ. PERSSON  
 APPROVED BY: C. REIMER

SCALE: NTS  
 DATE: 2011/12/15

RELEASED FOR CONSTRUCTION  
 BY: N. HARRINGTON  
 DATE: 2012/02/15

CONSULTANT NO.: 112577-0113-47DD-0225

ENGINEER'S SEAL

**THE CITY OF WINNIPEG**  
 WATER AND WASTE DEPARTMENT

SOUTH END WATER POLLUTION CONTROL CENTRE  
 ELECTRICAL CLASSIFICATION UPGRADES  
 LOOP DIAGRAM  
 G606-HS, G606-YL-1, G606-YL-2

CITY DRAWING NUMBER	SHEET	REV.	SIZE
1-0102G-A0090	001	02	B