



**GRIT AREA ELECTRICAL ROOM**  
 SCALE: 1 : 30

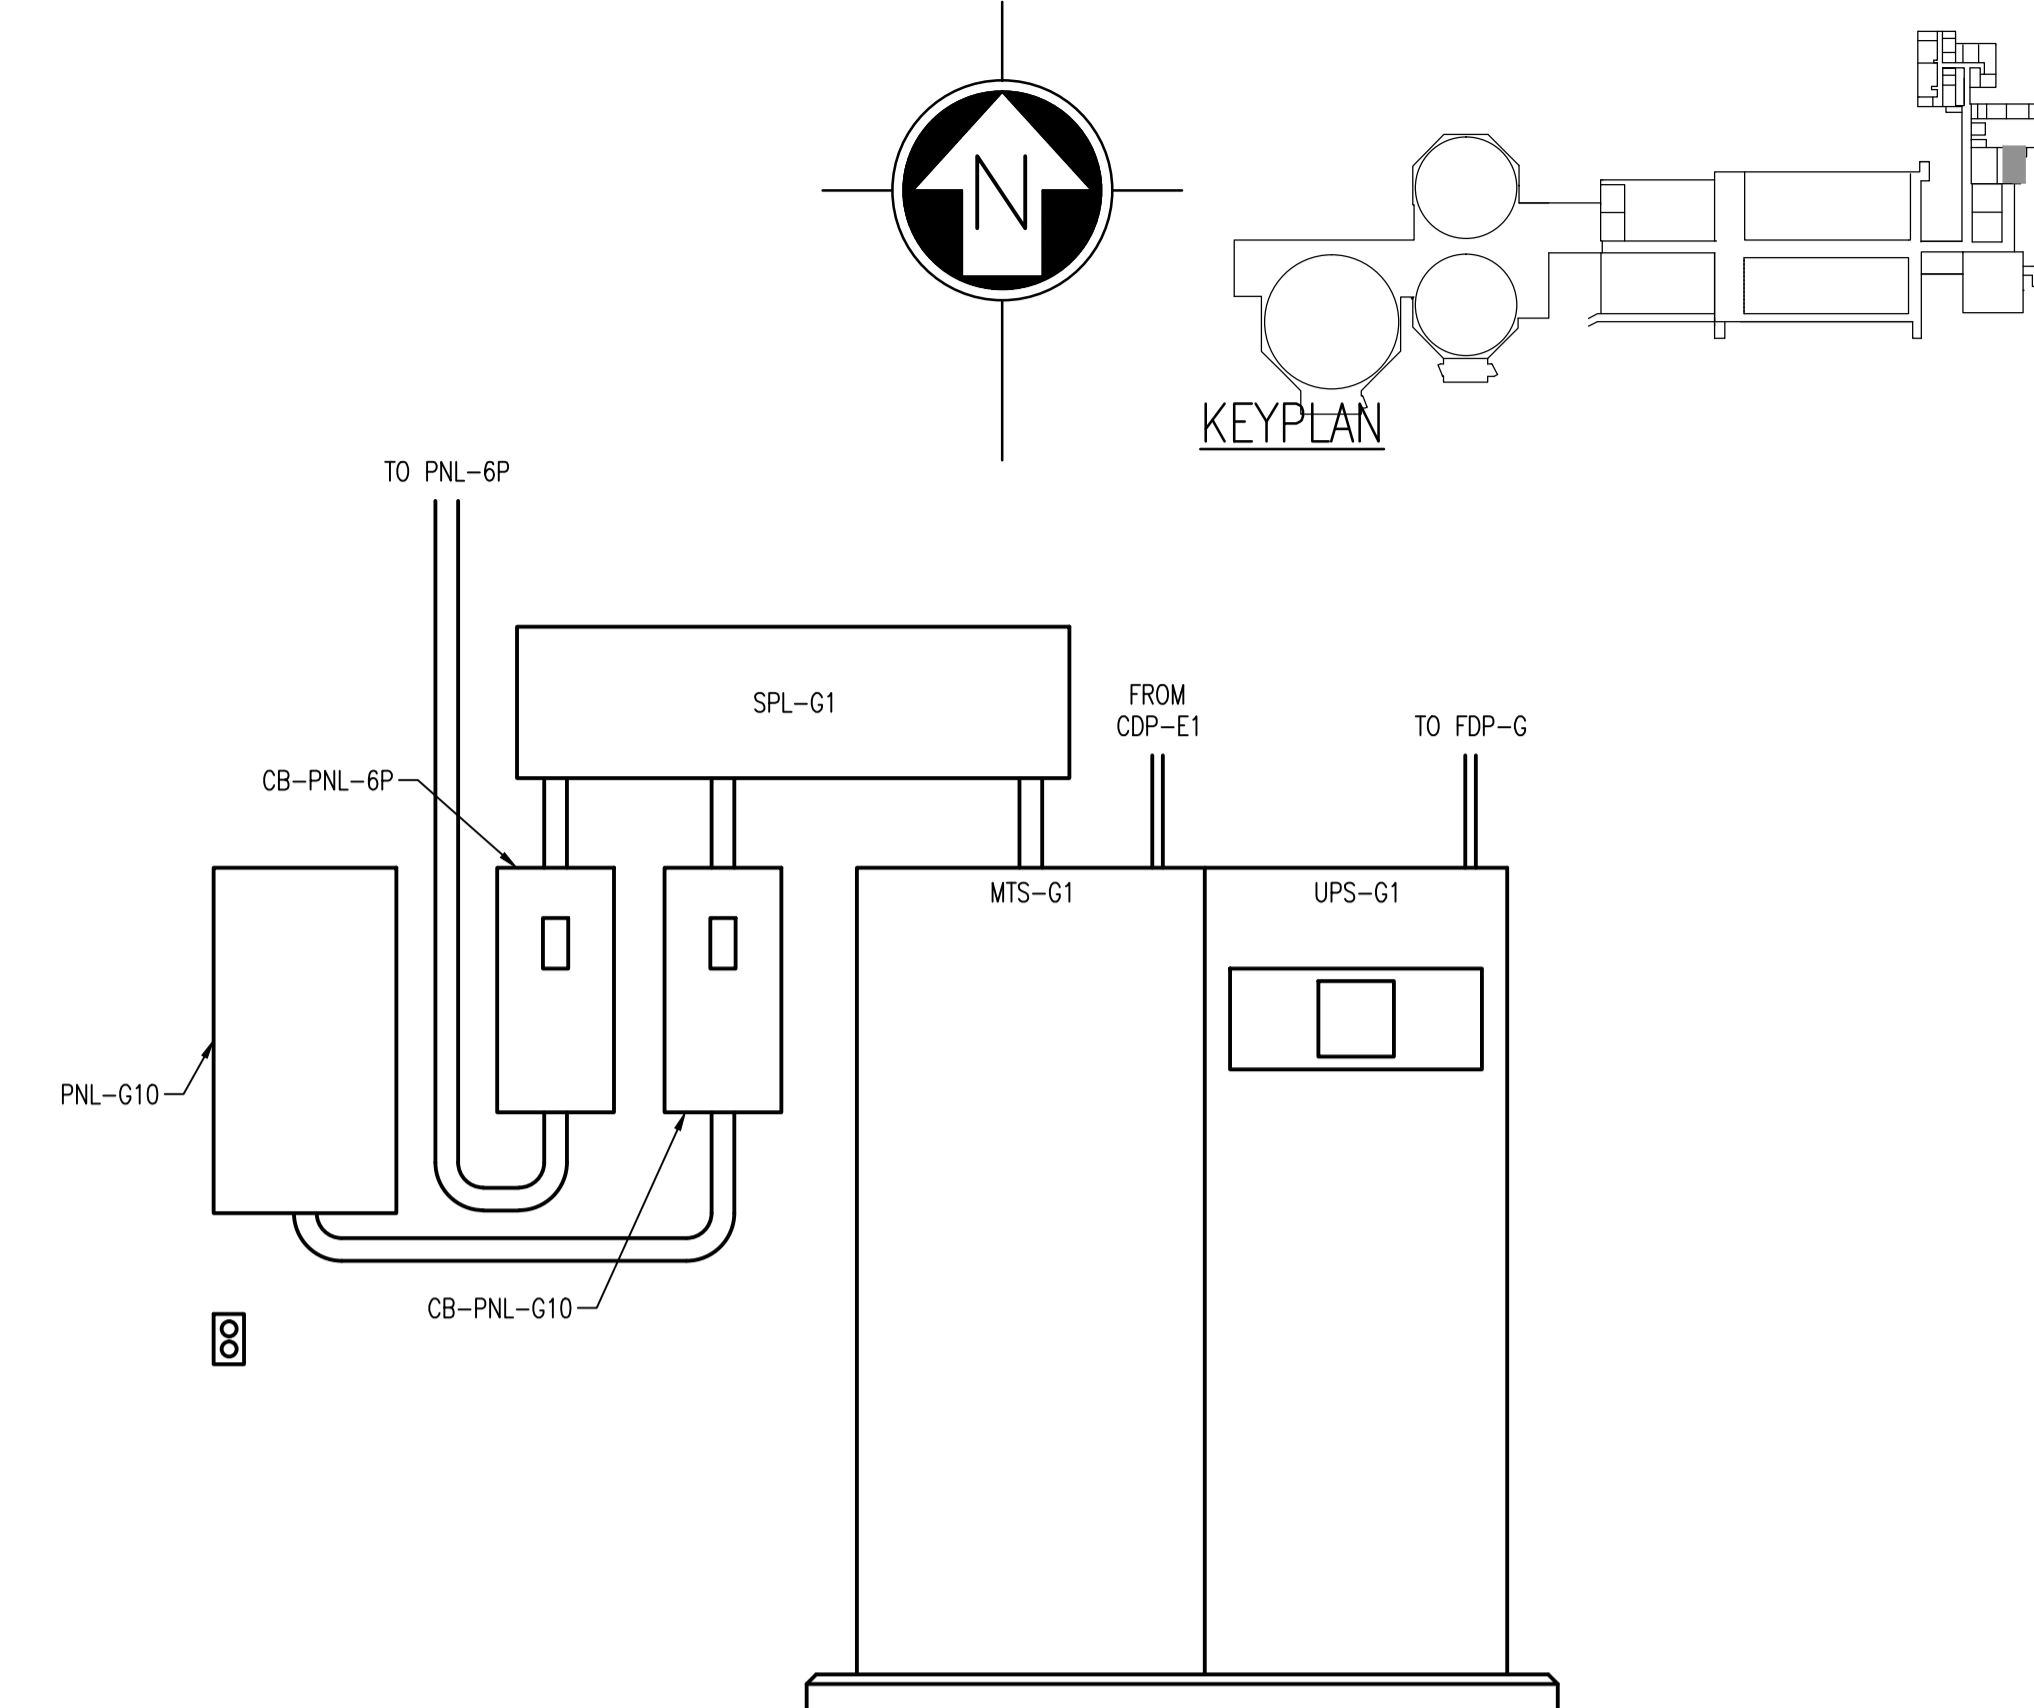

**UPS ELEVATION**  
 SCALE 1:15

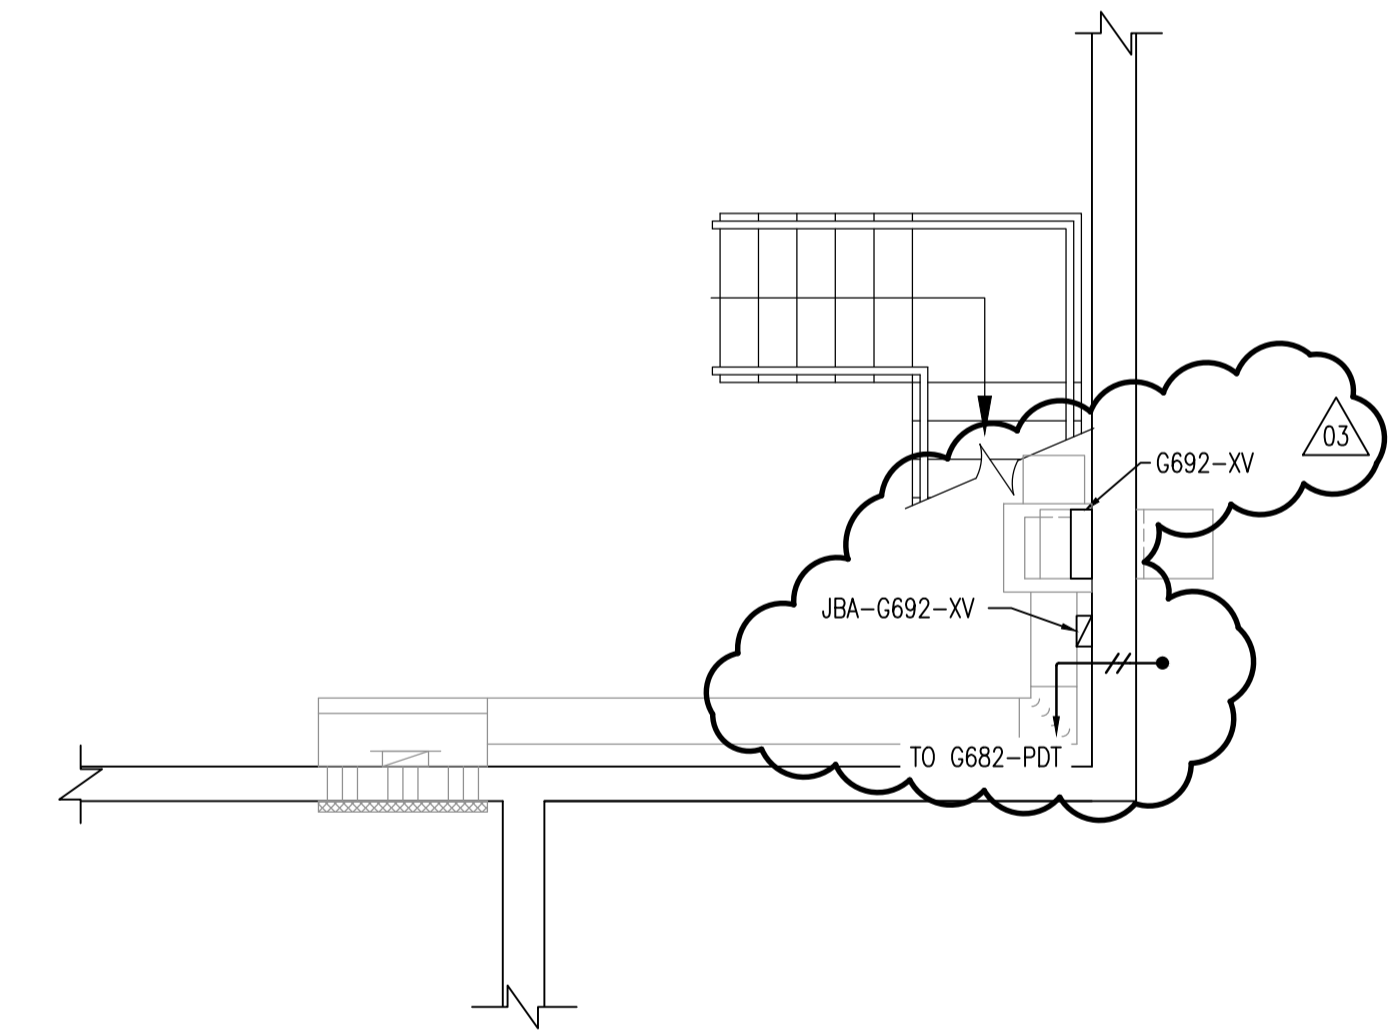

**MOTOR ROOM**  
 SCALE: 1 : 50

NO.	REMOVAL NOTES
(A)	REMOVE ABANDONED FLUSH MOUNT PANEL IN MOTOR ROOM.
(B)	REMOVE EXISTING CONDUIT FEEDING ABANDONED PANEL IN MOTOR ROOM BACK TO EXISTING JUNCTION BOX.

NO.	CONSTRUCTION NOTES
(1)	MODIFY MCC-1G AND MCC-2G AS SHOWN ON OTHER DRAWINGS.
(2)	ATTACH SAMPLE TUBING TO CEILING.
(3)	FOR BUILDING WALL PENETRATION, SEE DETAIL ON 1-0102G-A0128.
(4)	FIRE STOP THE AREA ABOVE THE SOUTH DOOR. USE APPROVED FIRE STOPPING BLOCKS AND FIRE STOPPING SEALANT AS REQUIRED TO COMPLETELY SEAL OPENING.
(5)	FIRE STOP EXISTING PIPES AND CONDUIT PASSING THROUGH ELECTRICAL ROOM WALLS. APPROXIMATE LOCATIONS: 7.
(6)	COORDINATE WITH MECHANICAL DUCTWORK FOR REPAIR OF EXISTING WALL.

**NOTES:**  
 1. THIS DRAWING IS BASED ON THE EXISTING LAYOUT OF THE ELECTRICAL ROOM.



NO.	REVISIONS	DATE	DESIGN	CHECK
03	ISSUED FOR TENDER, BID OPP. 42-2013	2013/01/15	TMC	CJR
02	ISSUED FOR TENDER, BID OPP. 545-2012	2012/09/10	TMC	CJR
01	ADDED UPS-G1 AND ASSOCIATED EQUIPMENT	2011/03/11	TMC	CJR
00	ISSUED FOR TENDER, BID OPP. 837-2009	2009/12/07	NB	CJR

**SNC-LAVALIN INC.**  
 148 Nature Park Way  
 Winnipeg, MB, Canada R3P 0X7  
 204-786-8080

DESIGNED BY: EXISTING/N. BRADDO  
 DRAWN BY: E. BOHNCKE  
 SCALE: AS NOTED  
 DATE: 2009/12/07  
 CONSULTANT NO.: 112577-0105-47DD-0103

CHECKED BY: C. REIMER  
 APPROVED BY: C. REIMER  
 RELEASED FOR CONSTRUCTION BY: J. VEILLEUX  
 DATE: 2009/12/02

**THE CITY OF WINNIPEG**  
 WATER AND WASTE DEPARTMENT

SOUTH END WATER POLLUTION CONTROL CENTRE  
 ESSENTIAL SYSTEM UPGRADES  
 PLAN LAYOUT  
 GRIT BUILDING ELECTRICAL ROOM

CITY DRAWING NUMBER: 1-0102G-E0007  
 SHEET: 001  
 REV: 03  
 SIZE: A1