


H MOLSON STREET - STA. 0+800
SCALE - H-1:100 V-1:50

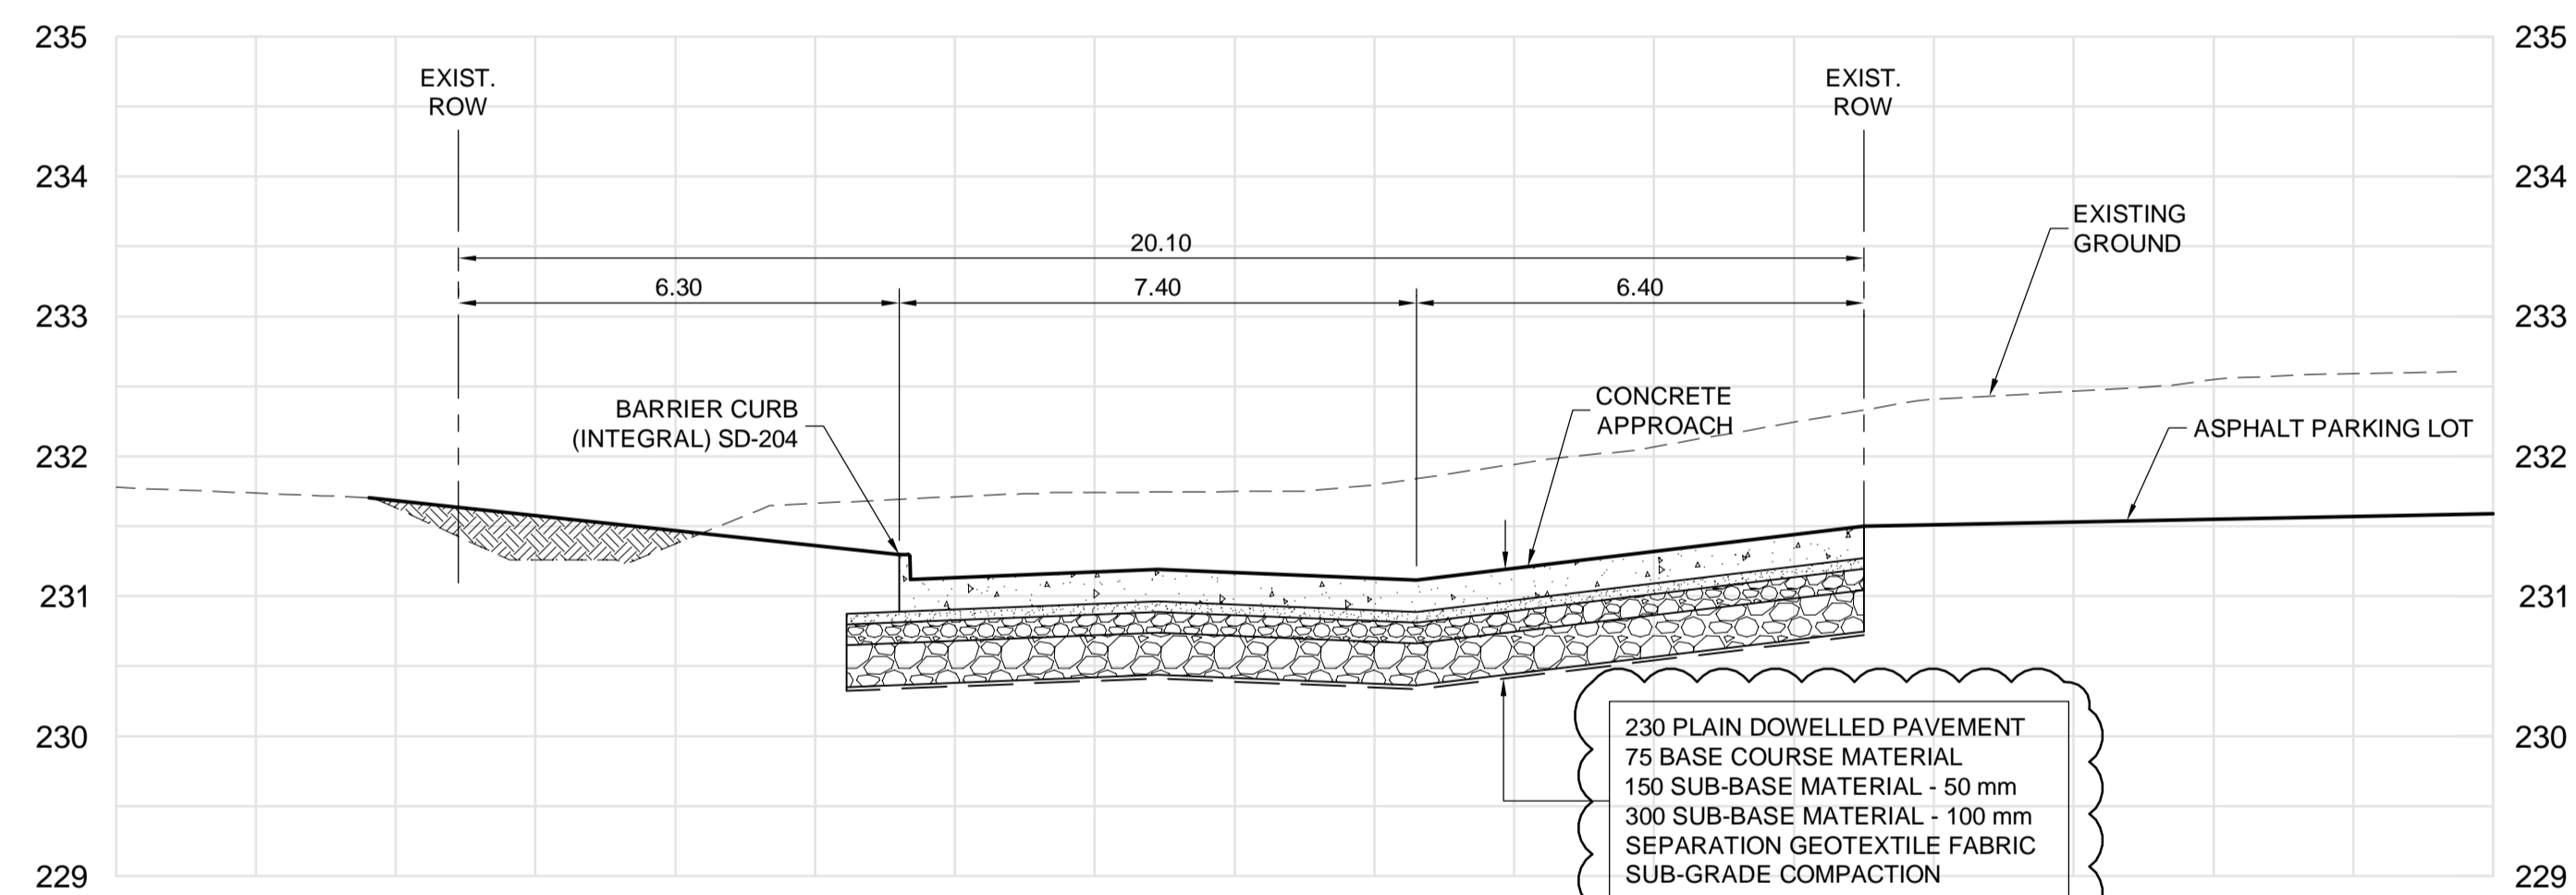

I CALLSBECK AVENUE
SCALE - H-1:100 V-1:50

METRIC

WHOLE NUMBERS INDICATE MILLIMETRES
DECIMALIZED NUMBERS INDICATE METRES

APEGM
Certificate of Authorization
Dillon Consulting Limited (MB)
No. 1789 Date: 01/14/2014

G:\CAD\127055\02-Civil\01-Contract\20-Sections-Details.dwg

150 WM	WATERMAIN	150 WM	HYDRO	HYDRO	HYDRO	150 WM	WATERMAIN	150 WM
+	HYDRANT	+	MTS	MTS	MTS	+	HYDRANT	+
+	VALVE	+	MTS	MTS	MTS	+	VALVE	+
300 LDS	LAND DRAINAGE SEWER	300 LDS		CONCRETE		300 LDS	LAND DRAINAGE SEWER	300 LDS
250 WWS	WASTE WATER SEWER	250 WWS		ASPHALT		250 WWS	WASTE WATER SEWER	250 WWS
○	MANHOLE	●		PLANING		○	MANHOLE	●
□	CATCH BASIN	■		SIDEWALK		□	CATCH BASIN	■
▽	CURB INLET	▽		PAVING STONES		▽	CURB INLET	▽
+	JUNCTIONS	+		PARTIAL DEPTH REPAIR		+	JUNCTIONS	+
+	CULVERT	+		PROPERTY LINE		+	CULVERT	+
100 GAS	GAS	100 GAS		DRAINAGE ARROW		100 GAS	GAS	100 GAS
EXISTING	LEGEND-PLAN	PROPOSED	EXISTING	LEGEND-PLAN	PROPOSED	EXISTING	LEGEND-PROFILE	PROPOSED

UNDERGROUND STRUCTURES	
SUPV. U/G STRUCTURES	DATE
LOCATION OF UNDERGROUND STRUCTURES AS SHOWN ARE BASED ON THE BEST INFORMATION AVAILABLE, BUT NO GUARANTEE IS GIVEN THAT ALL EXISTING UTILITIES ARE SHOWN OR THAT THE GIVEN LOCATIONS ARE EXACT. CONFIRMATION OF EXISTENCE AND EXACT LOCATION OF ALL SERVICES MUST BE OBTAINED FROM THE INDIVIDUAL UTILITIES BEFORE PROCEEDING WITH CONSTRUCTION.	

B.M. ELEV.	NO.	REVISIONS	DATE	BY
	4	ISSUED FOR ADDENDUM NO. 3	01/14/14	JNC
	3	ISSUED FOR TENDER	12/16/13	JNC
	2	ISSUED FOR REVIEW	07/22/13	JNC
	1	ISSUED FOR REVIEW	06/21/13	JNC

DESIGNED BY	JMS/MRD
DRAWN BY	TJH
CHECKED BY	JNC
APPROVED BY	DPK
HOR. SCALE	
VERTICAL	
DATE	01/14/2014

DILLON CONSULTING

ENGINEER'S SEAL
PROVINCE OF MANITOBA
ORIGINAL STAMPED BY
J.N. CRANG
01/14/2014
REGISTERED PROFESSIONAL ENGINEER

THE CITY OF WINNIPEG
PUBLIC WORKS DEPARTMENT

PANET ROAD/MOLSON STREET
RECONSTRUCTION AND TWINNING

CITY DRAWING NUMBER
P-3350-30

SHEET 30 OF 47

CONSULTANT DRAWING NUMBER

CONSULTANT PROJECT NUMBER
12-7055

SECTIONS (4 OF 5)