




1 SECTION DETAIL - CEMENTITIOUS CLADDING @ GRADE
1:5

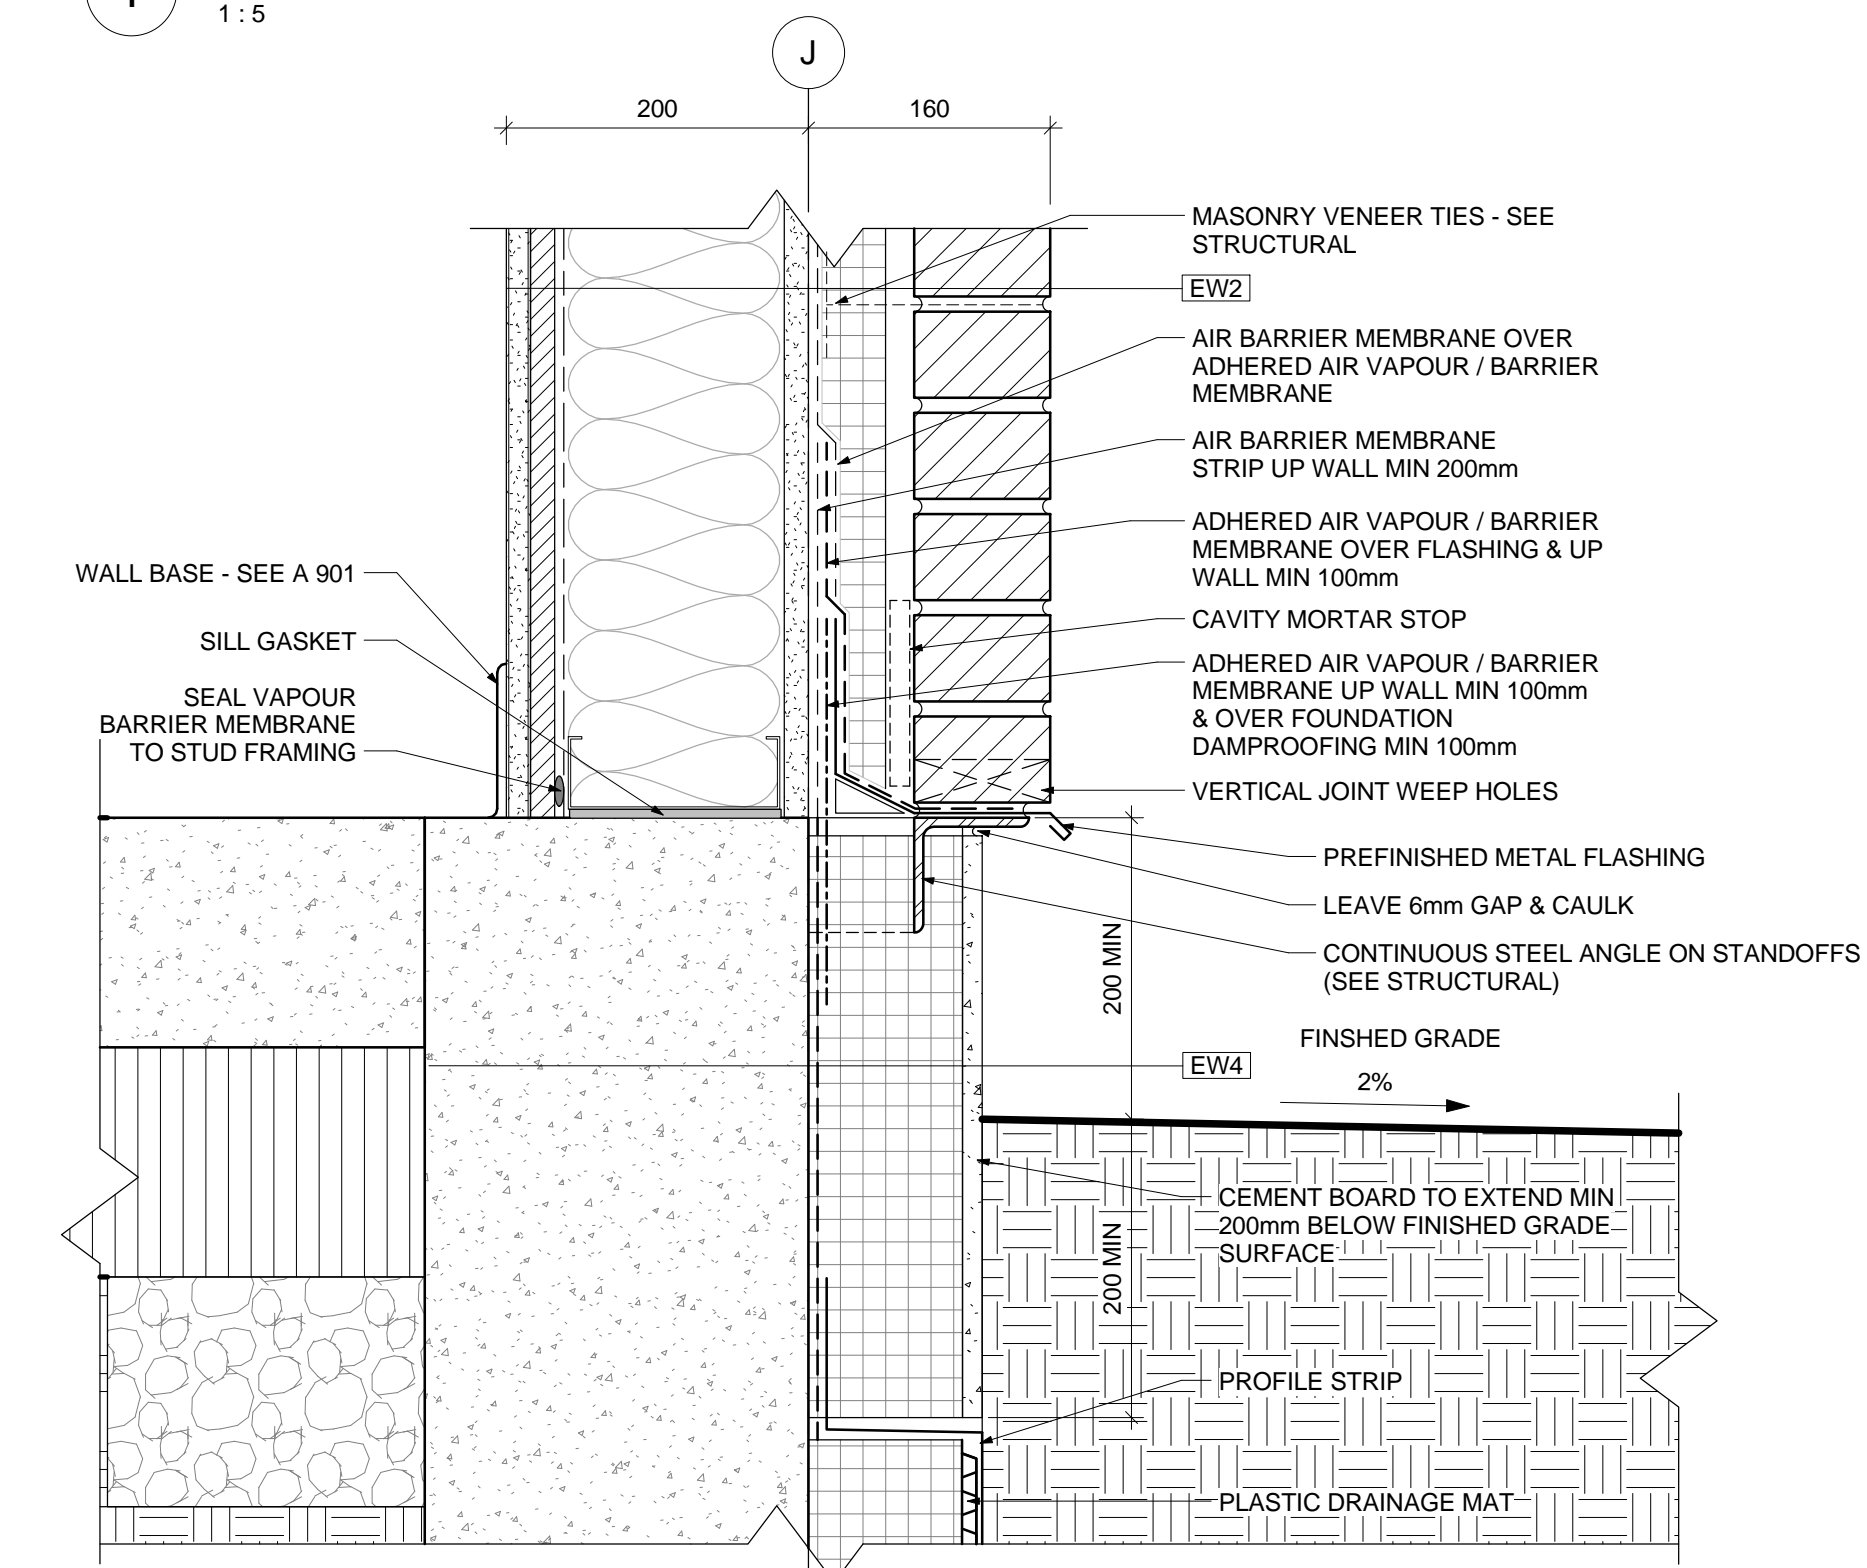


2 SECTION DETAIL - MASONRY CLADDING @ GRADE
1:5

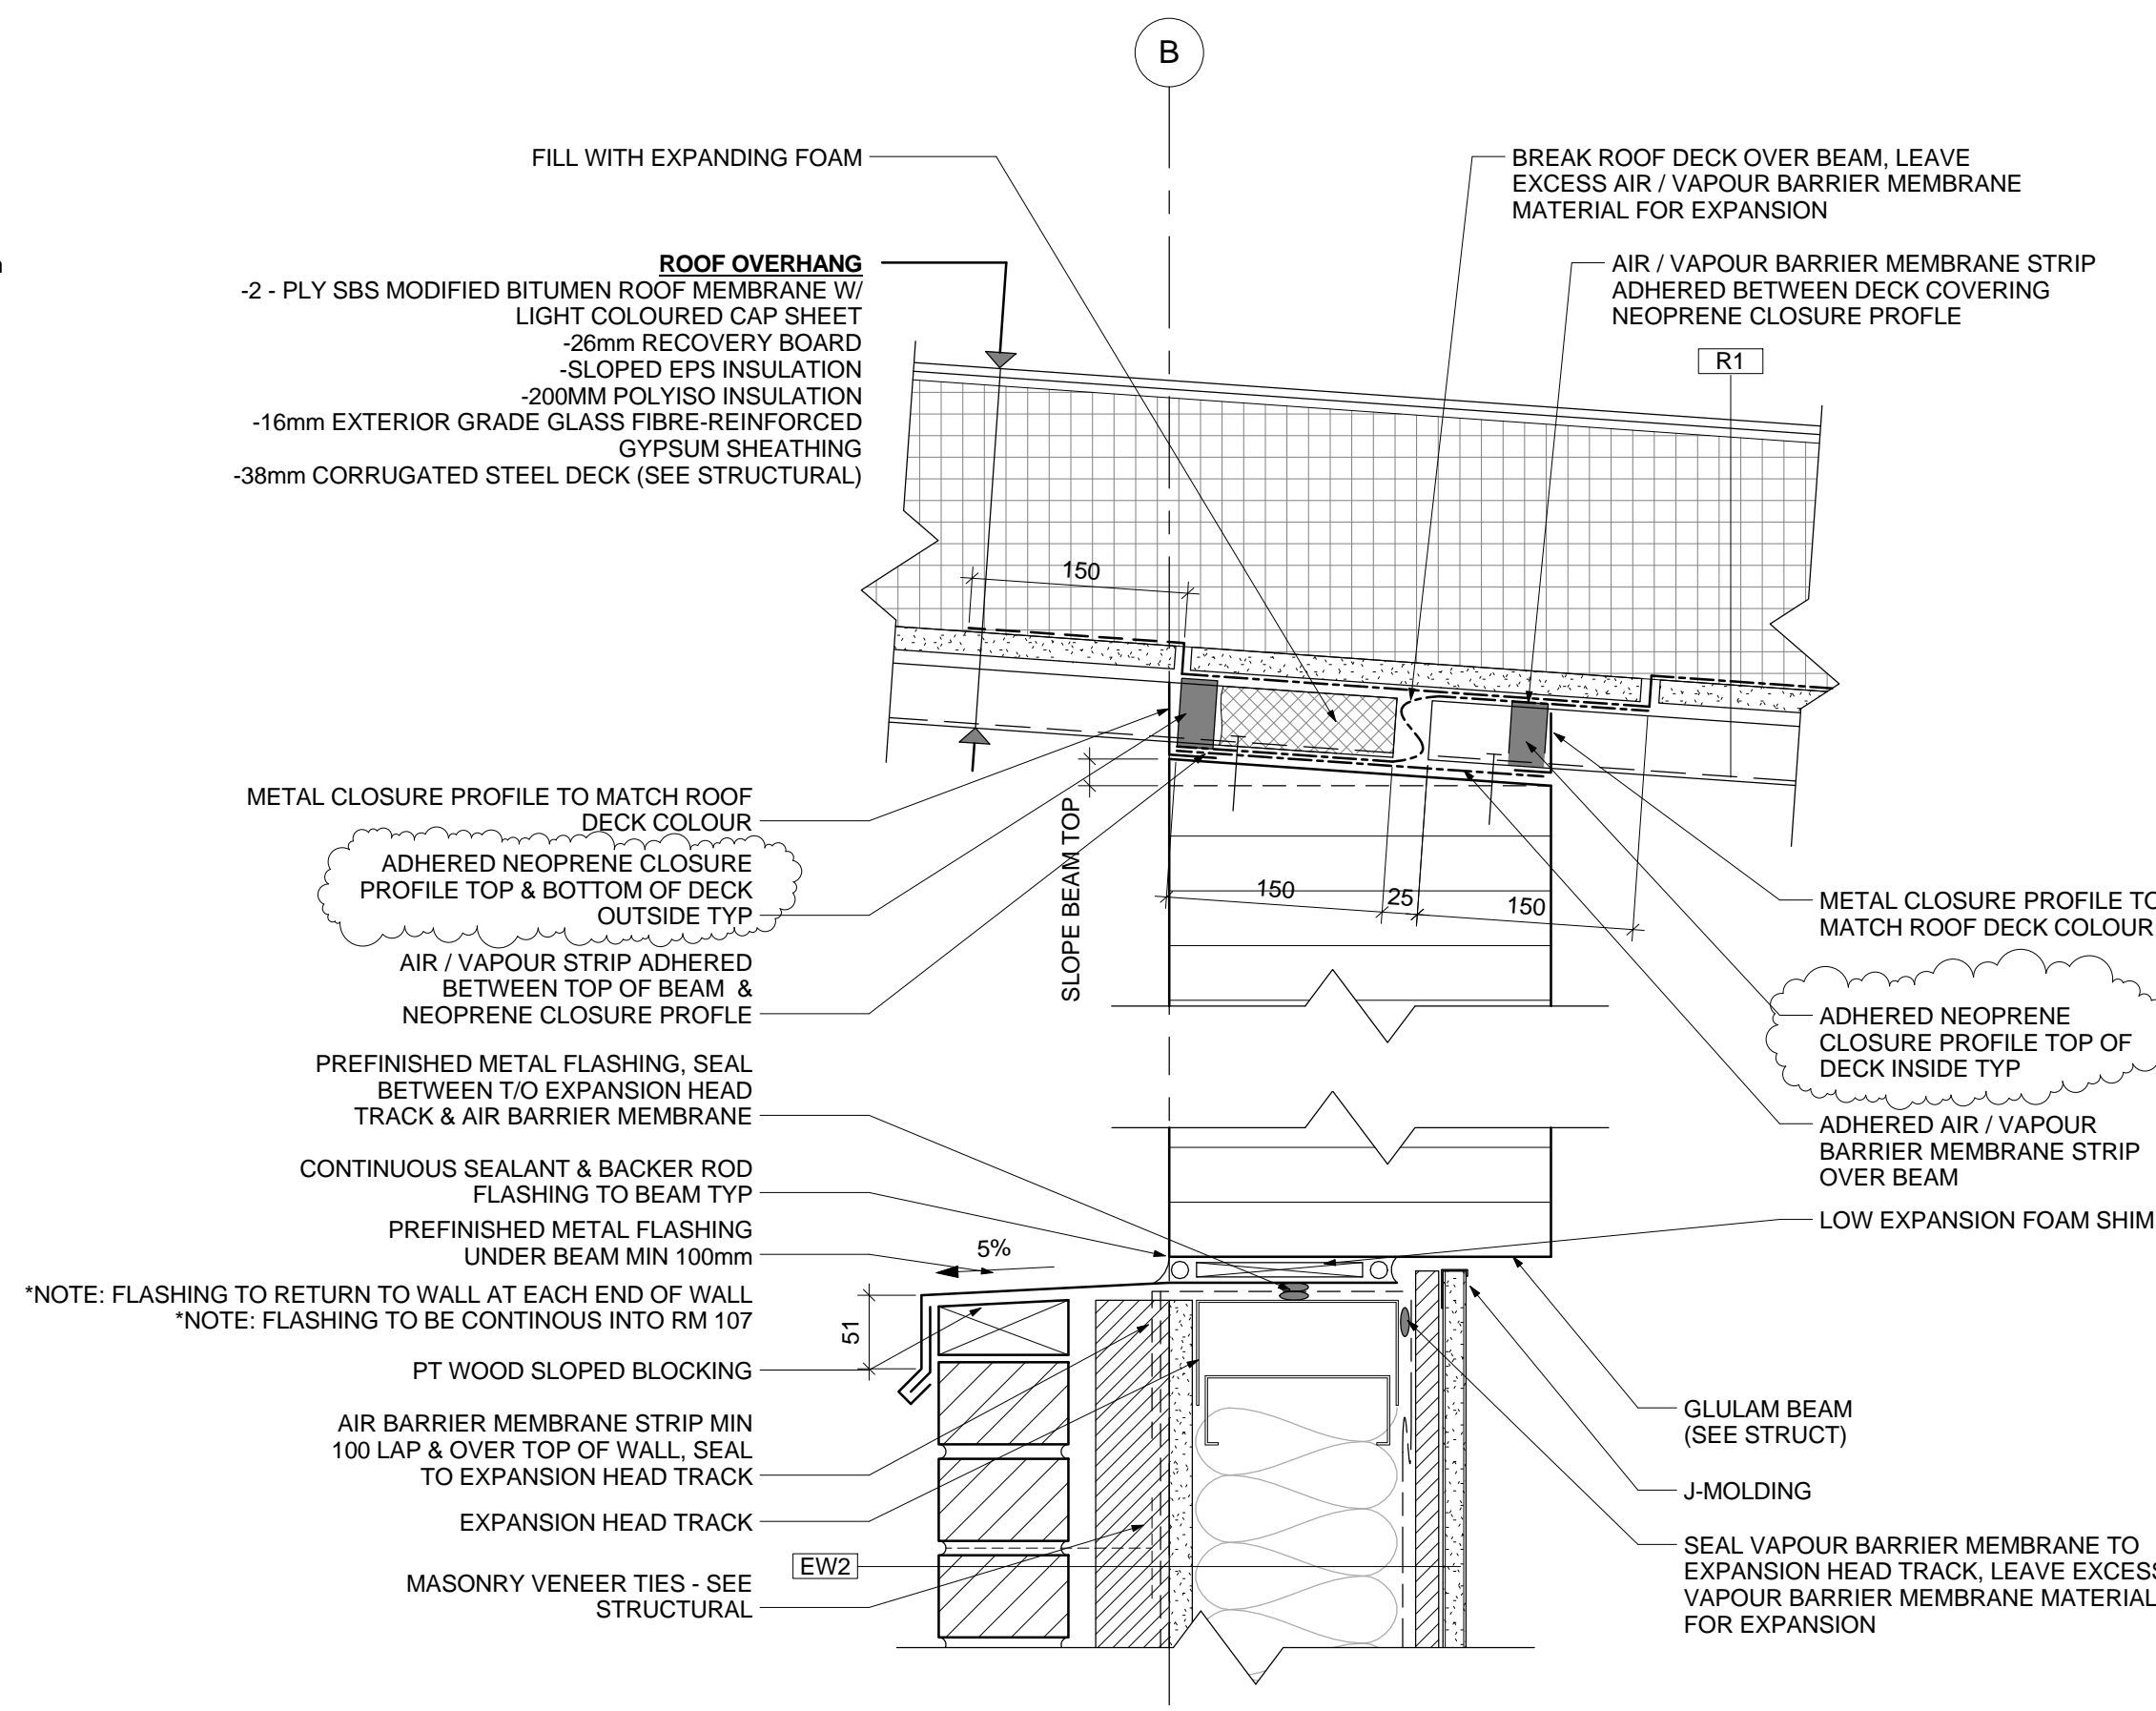


4 SECTION DETAIL - T/O MASONRY VENEER
1:5

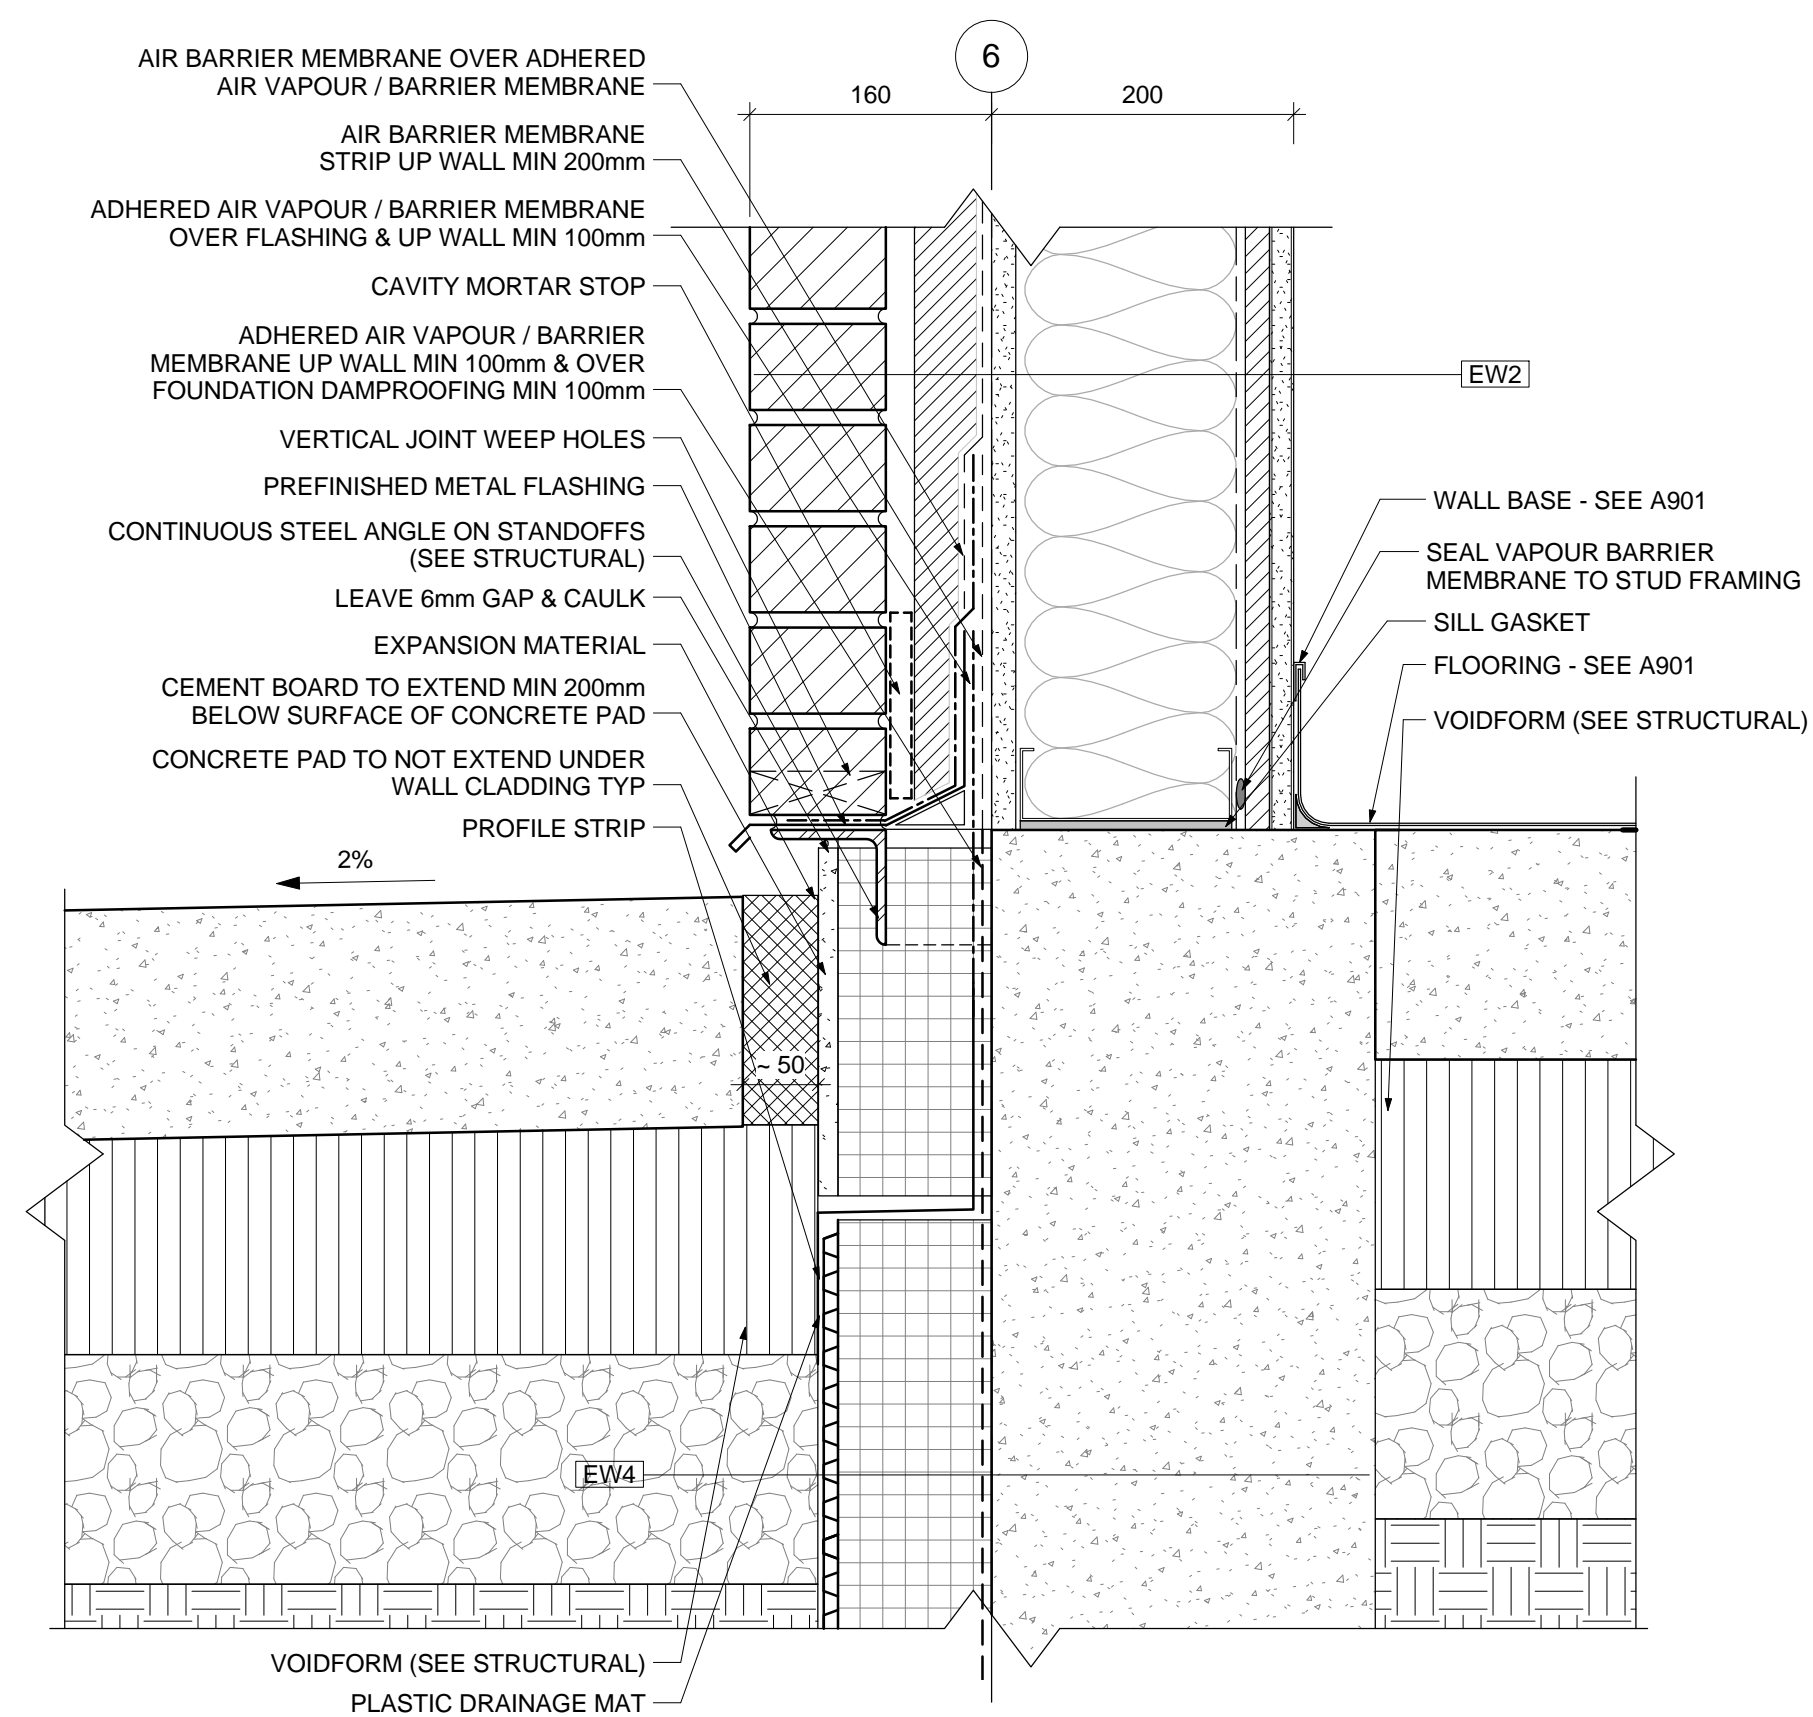

3 SECTION DETAIL - MASONRY CLADDING @ EXT WALK
1:5

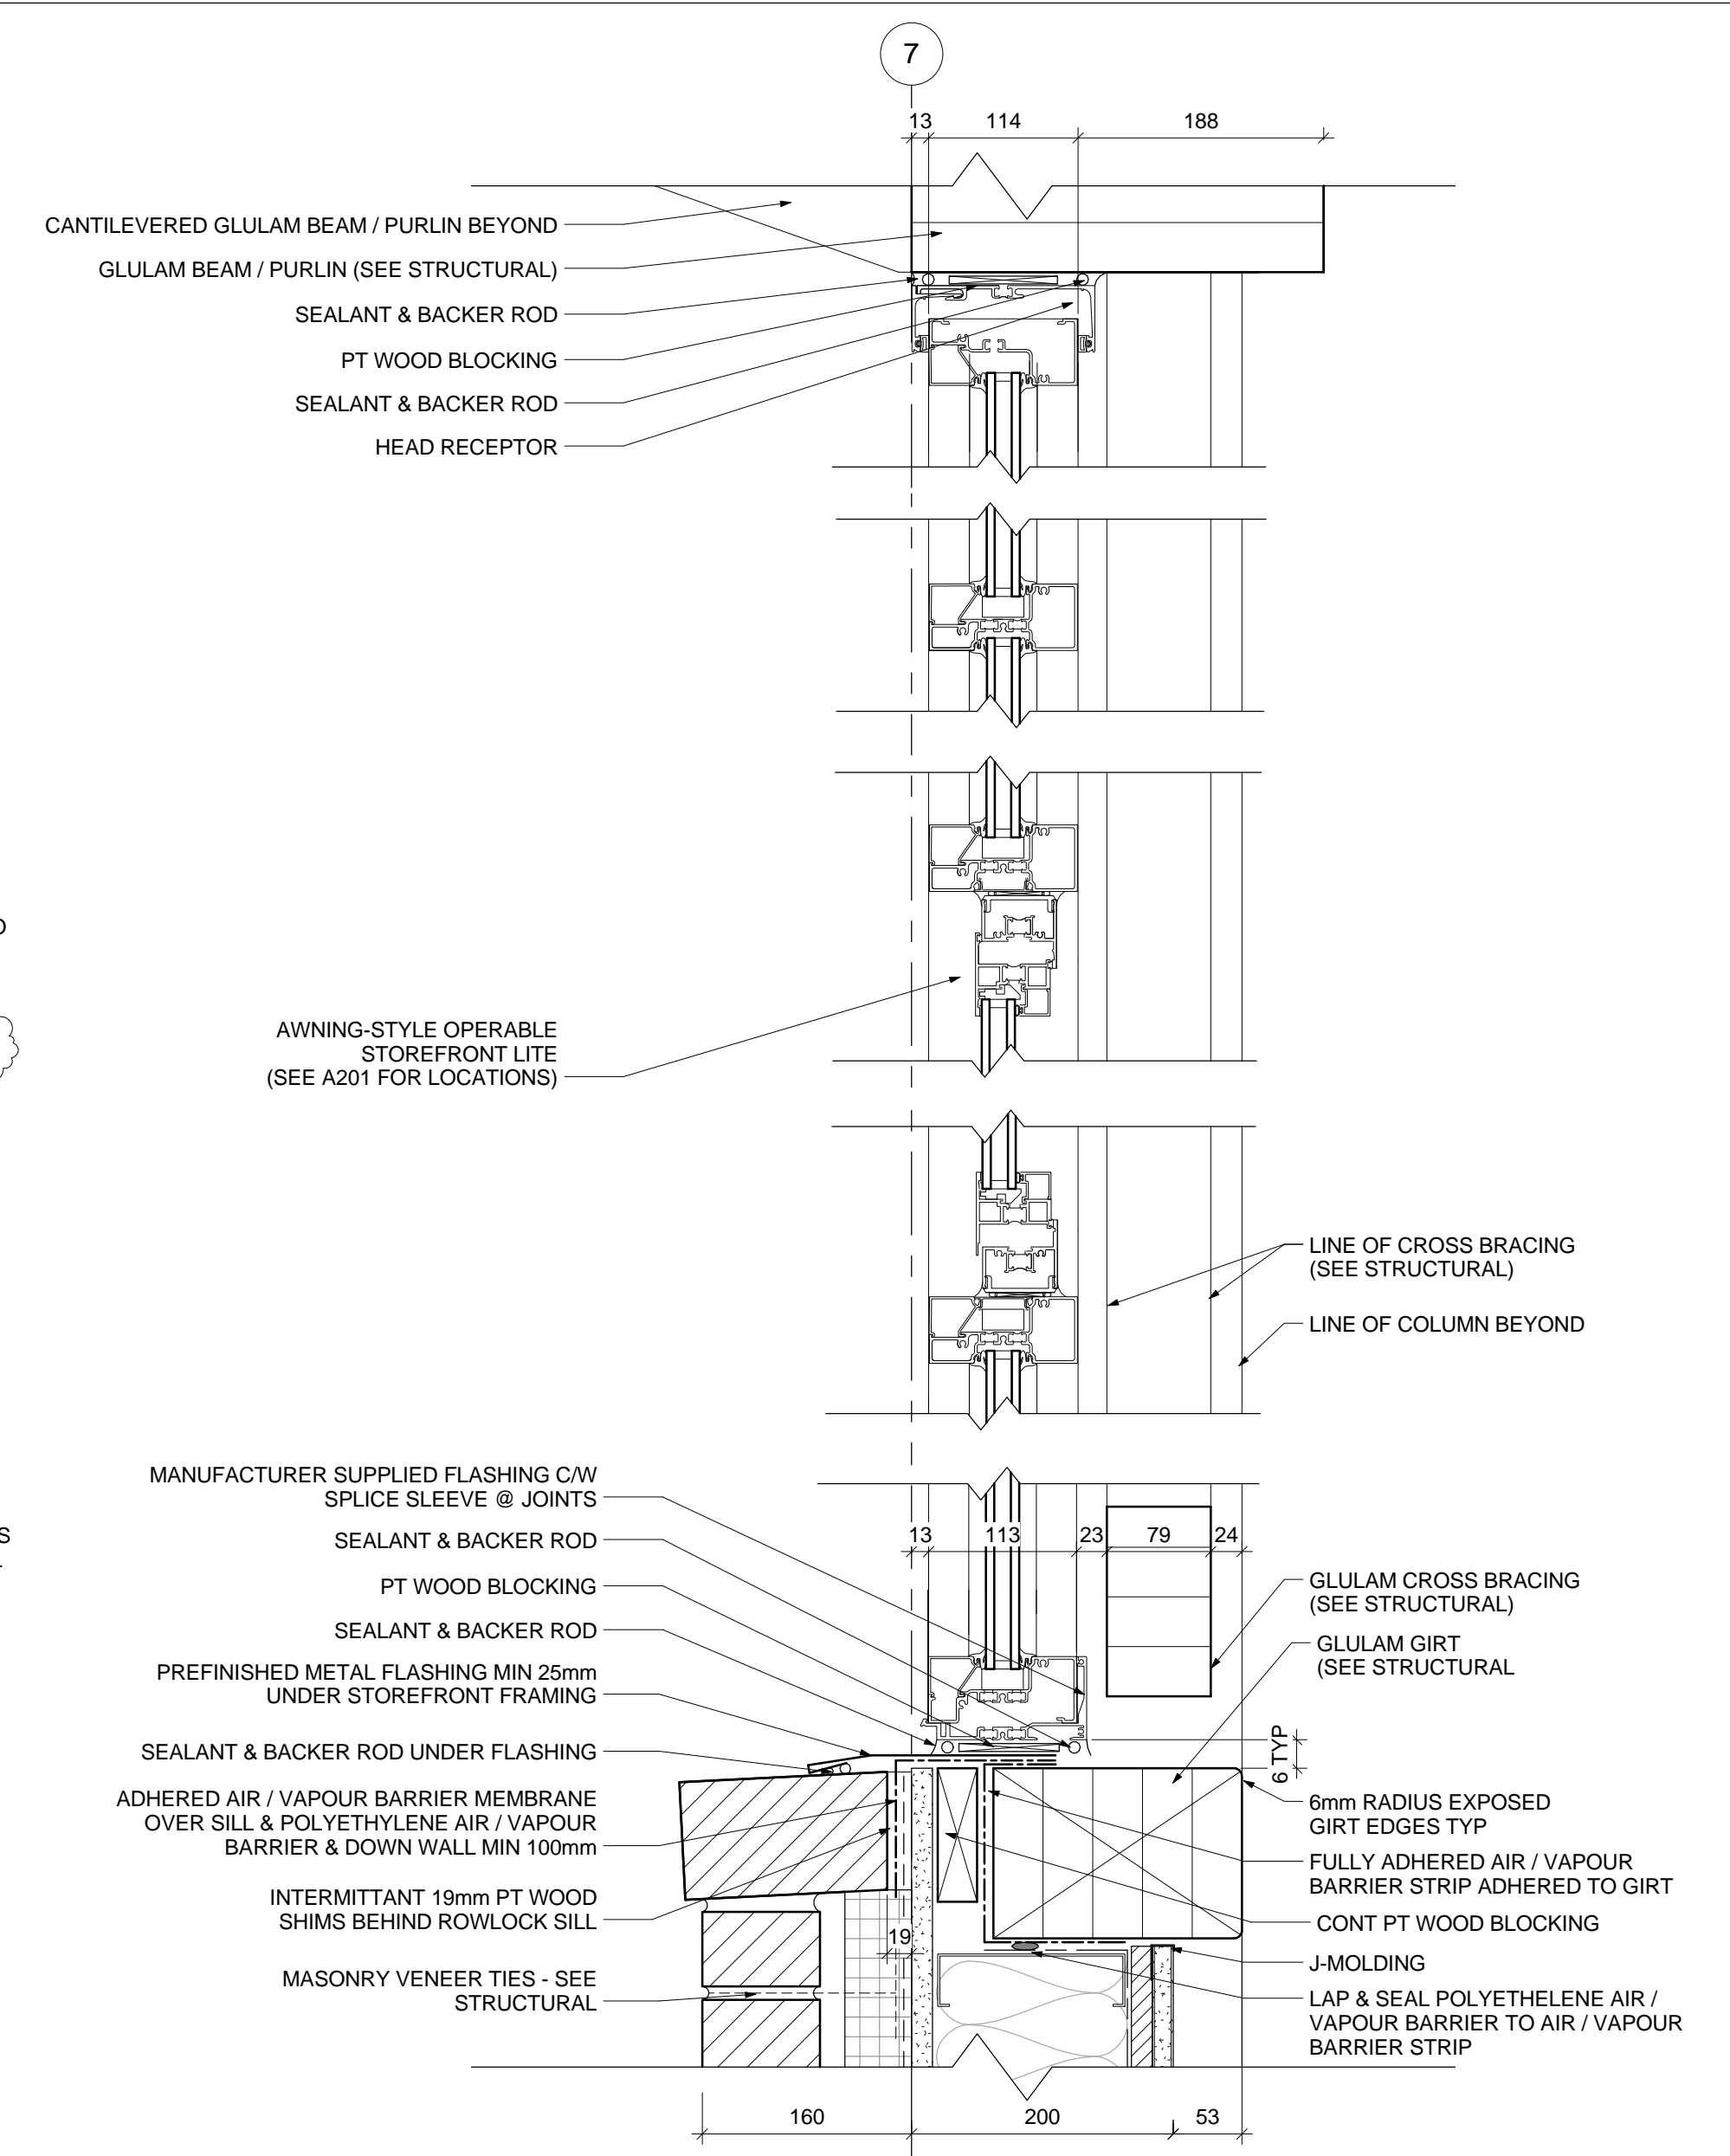

5 TYPICAL SECTION DETAIL - HEAD / SILL @ STOREFRONT GLAZING
1:5

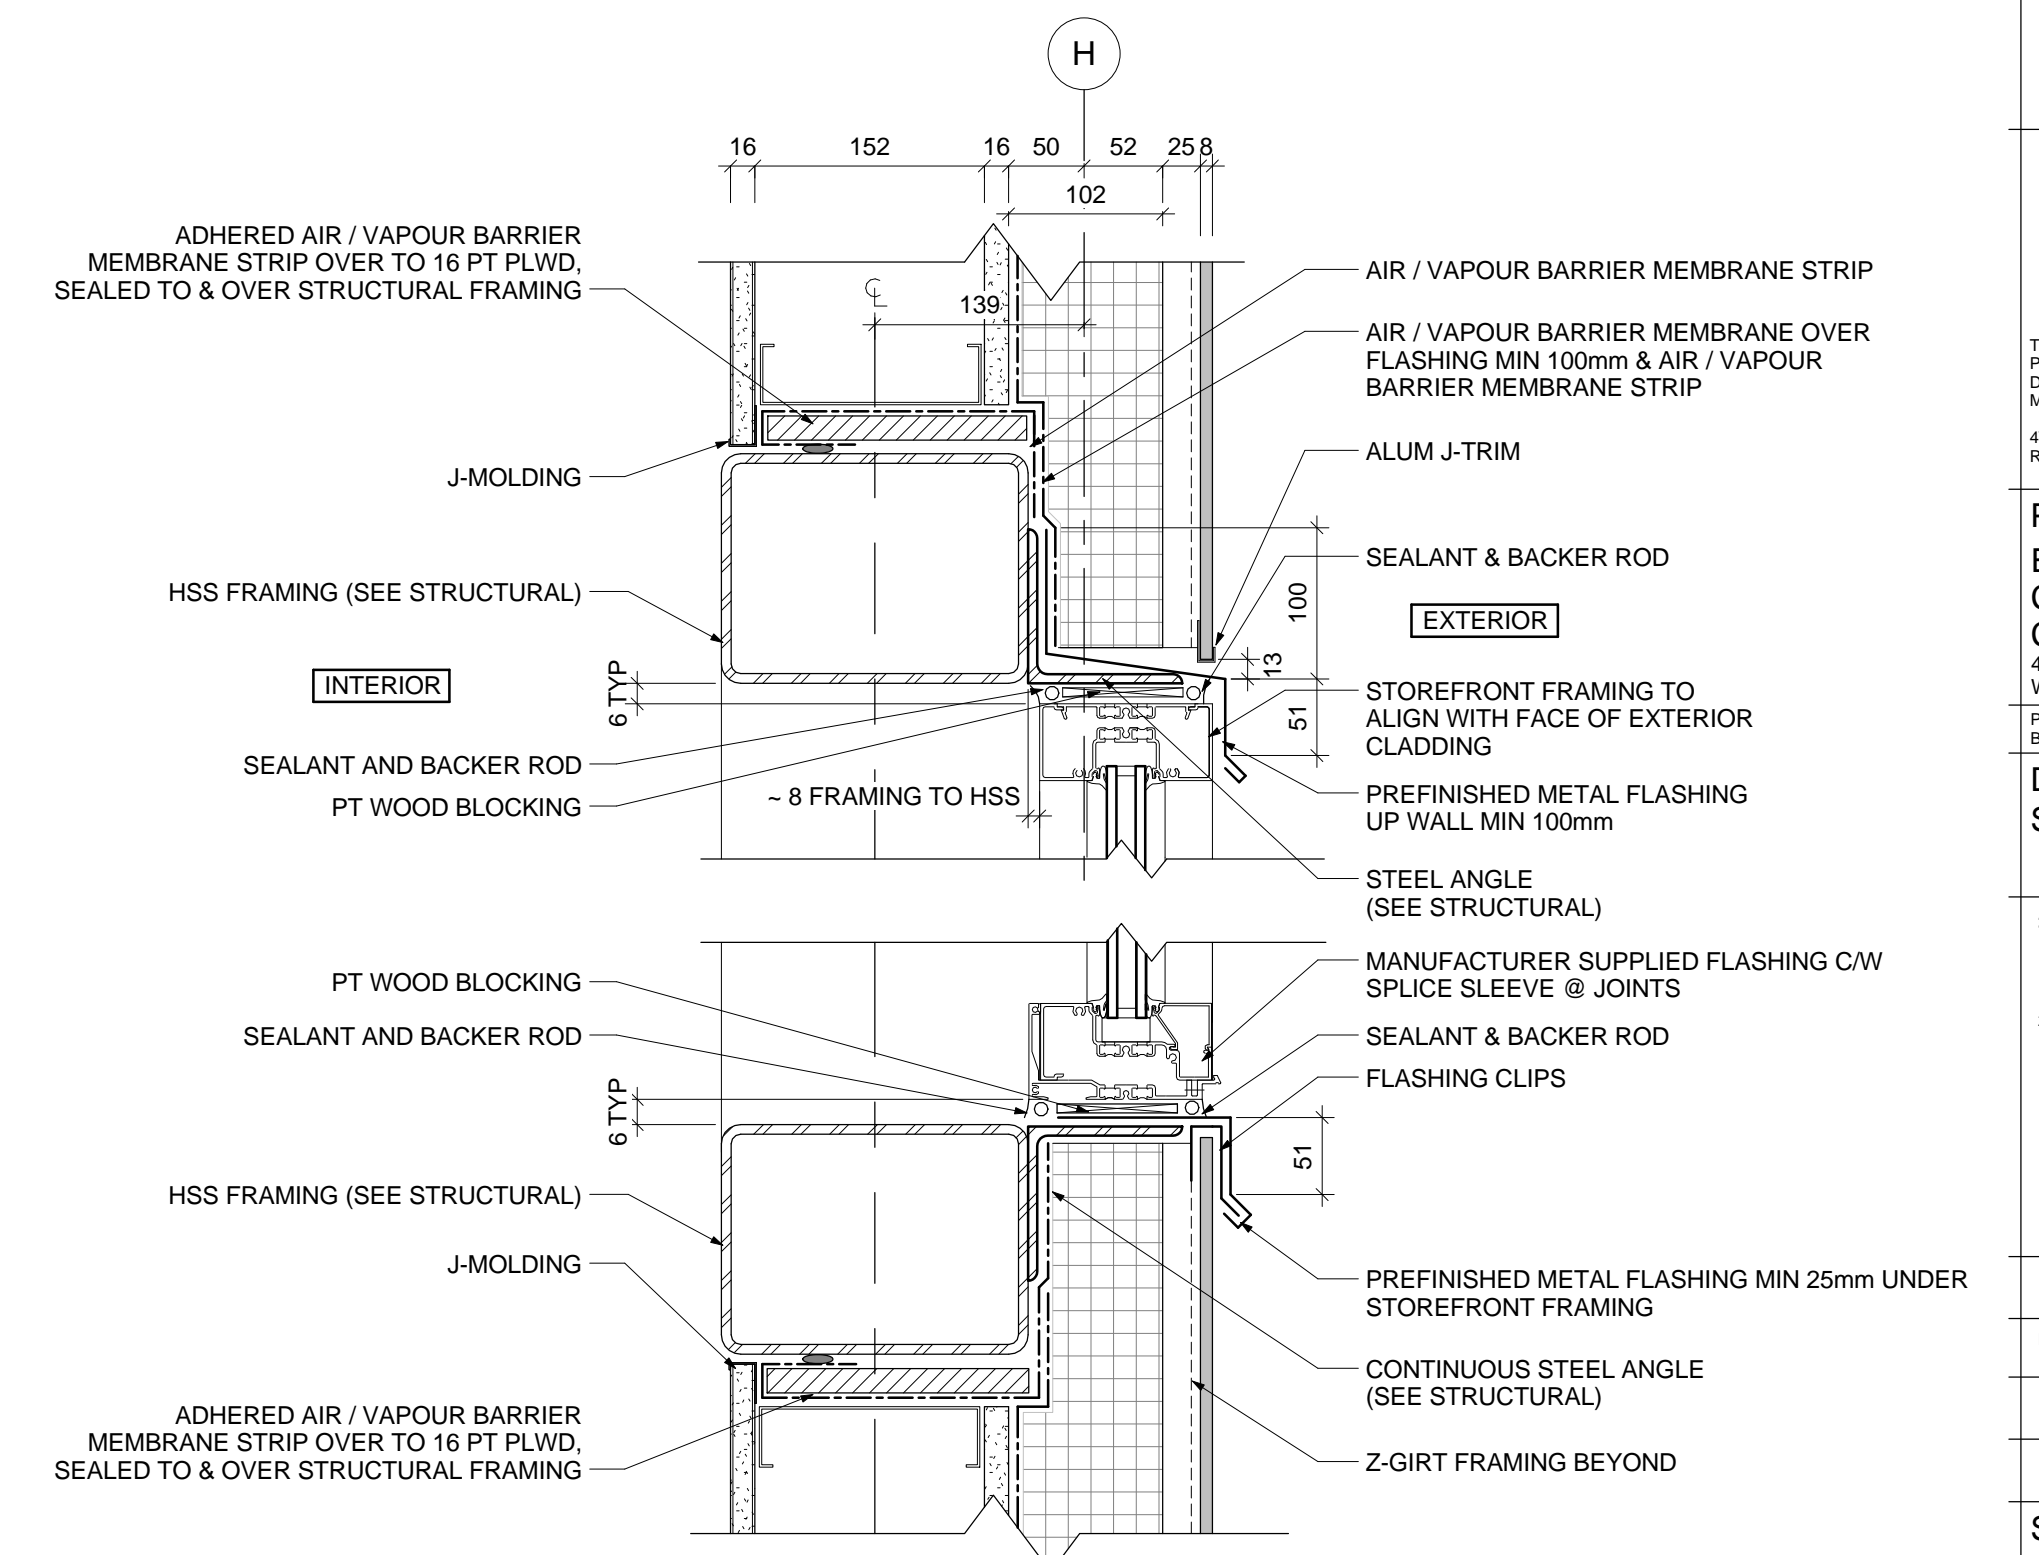

6 SECTION DETAIL - GLAZING HEAD / SILL
1:5

#	Issue/Revision	Date
1	ISSUED FOR TENDER	2013-12-09
2	ISSUED FOR ADDENDUM 2	2014-01-06

Design By: _____
Date: _____
Design Check: _____
Date: _____
Drawn By: _____
Date: _____
DWG Check: _____
Date: _____