## LIGHTING FIXTURE SCHEDULE

| TYPE | MANUFACTURER | PART NUMBER | TYPE |
|---|---|---|---|
| 'A' | MCGRAW-ED | OVF-40-P-3-D | MH |

**NOTE:**

1. PULL BOX SHALL BE WEATHERPROOF, WATERTIGHT, RAINPROOF, NEMA4, MANUFACTURING WJBF. CHECKERED COVER SIDEWALK JUNCTION BOX. CAT No. WJBF121218.
2. ALL BURIED CABLING SHALL BE INSTALLED IN HDPE CONDUIT BURIED 1000 mm BELOW FINISHED GRADE.
3. INSTALL COPPER CLAD GROUND ROD AT END OF LIGHTING CIRCUITS.
4. UNDERGROUND STREET LIGHT WIRING NOT SHOWN. WIRING SHALL BE #6AWG RWU-90 INSTALLED IN 53MM HDPE CONDUIT.




## UNDERGROUND CABLE INSTALLATION DETAIL

N.T.S.

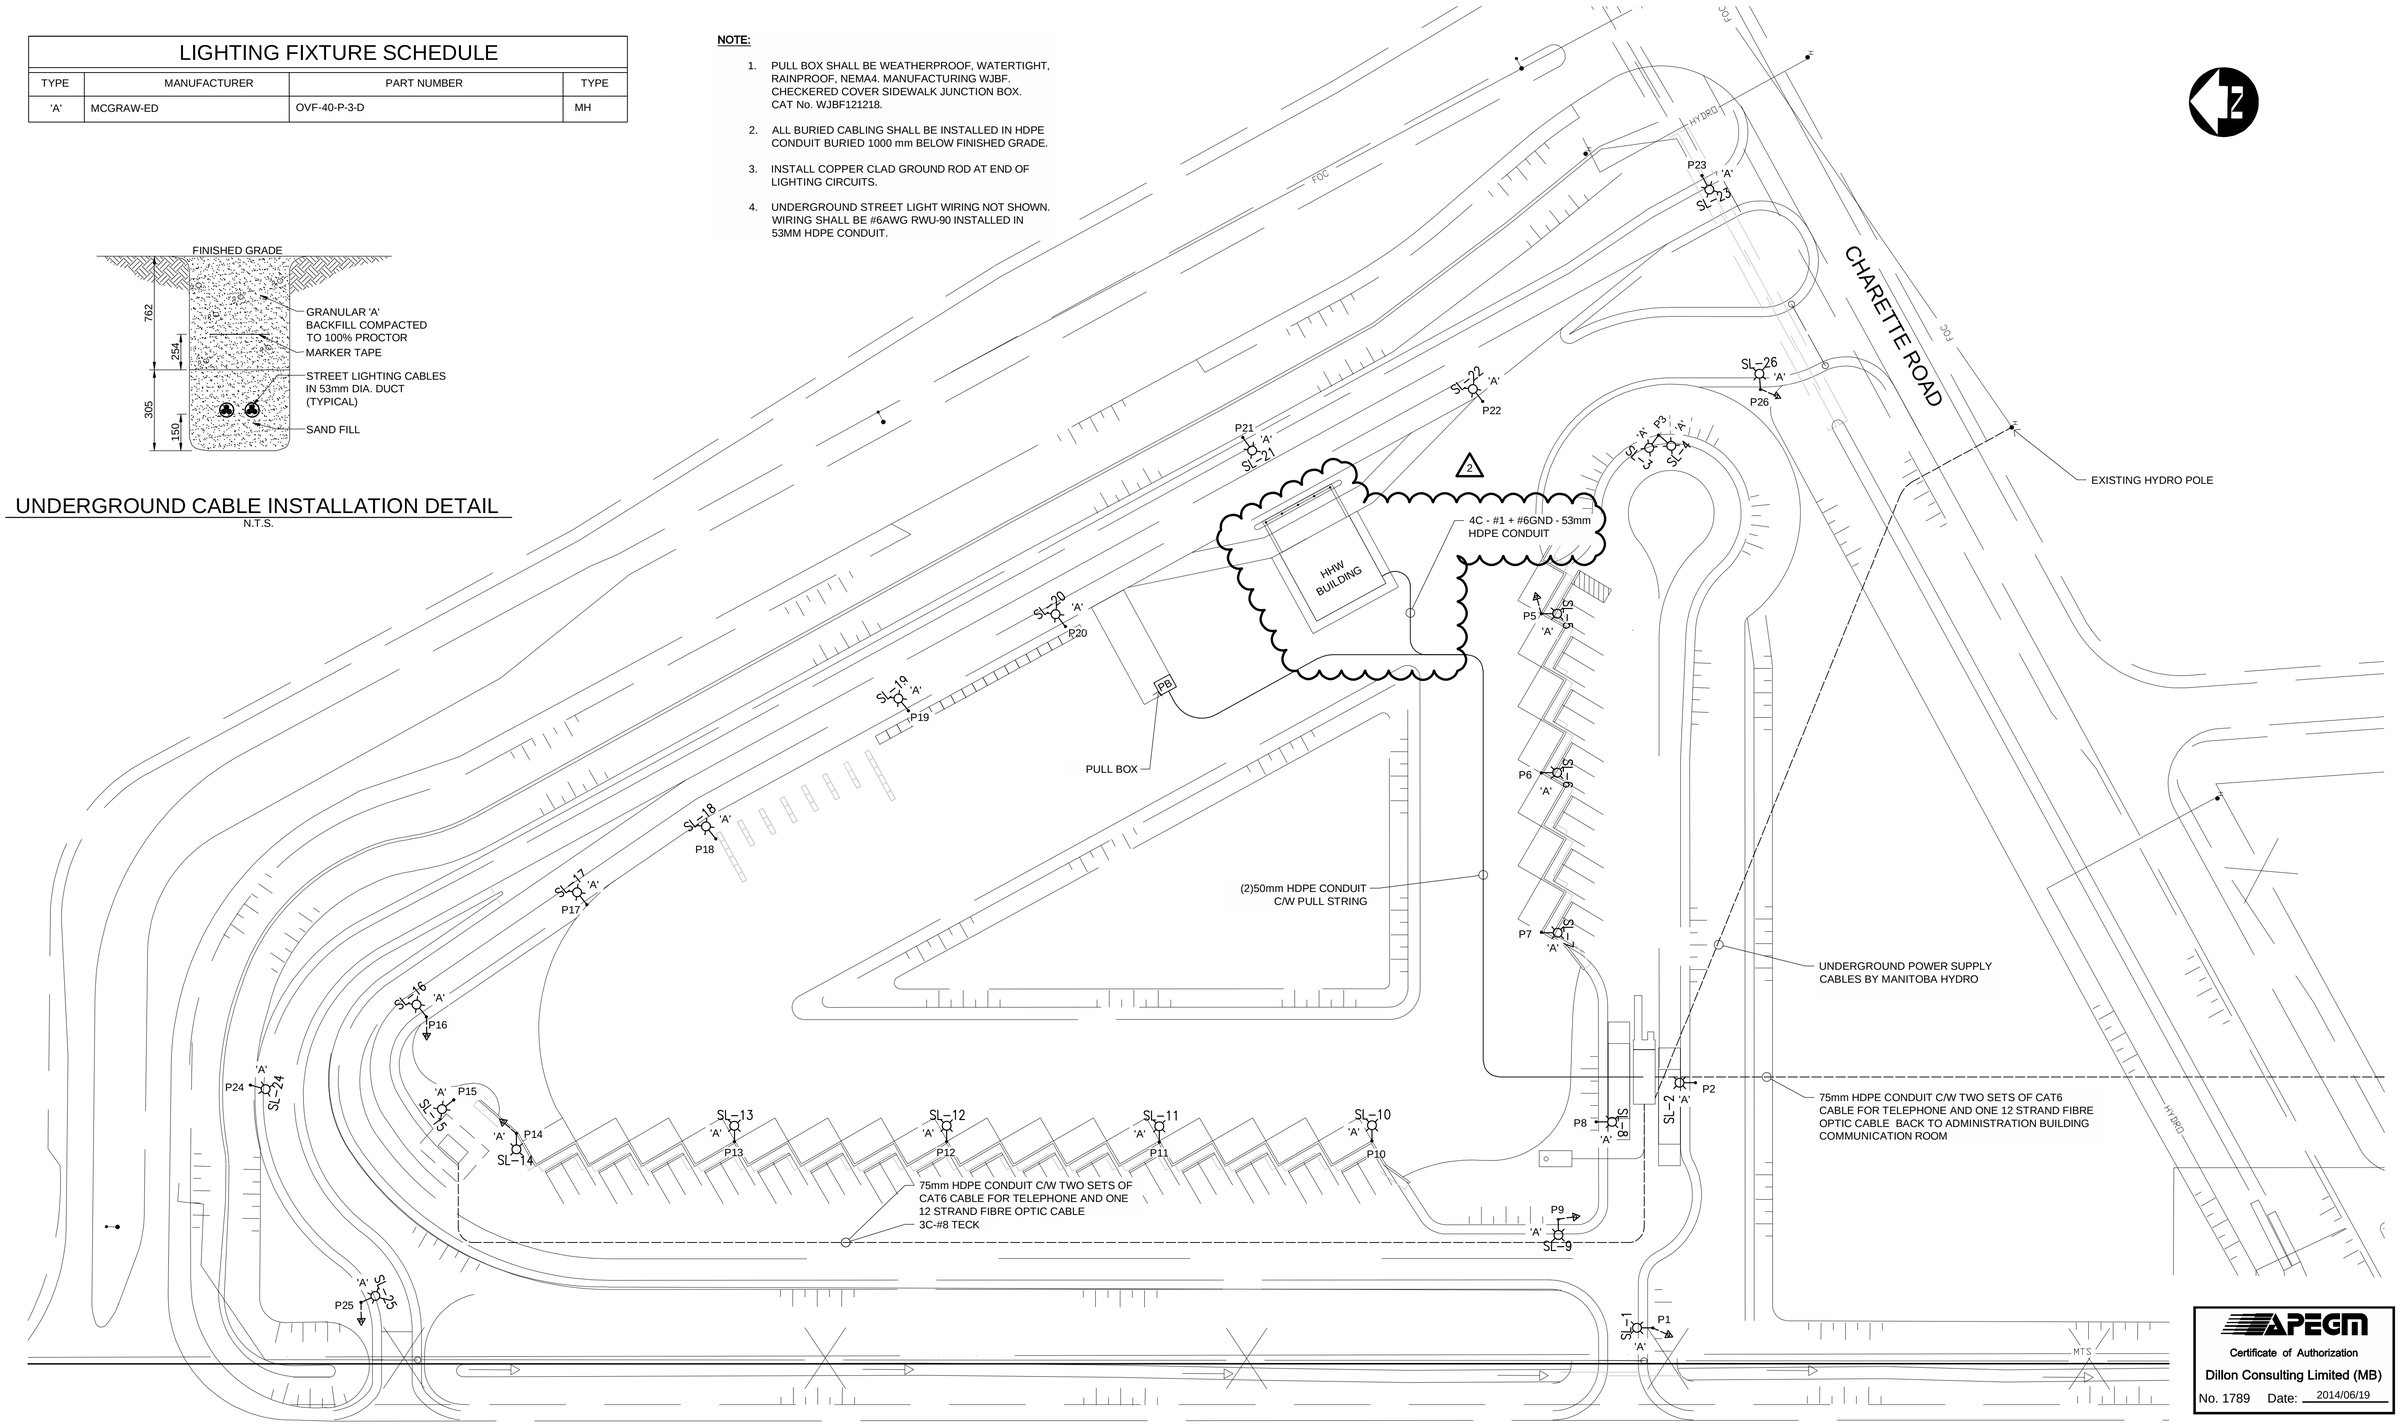


## SITE PLAN - LIGHTING LAYOUT

1:500

APEGM
Certificate of Authorization
Dillon Consulting Limited (MB)
No. 1789 Date: 2014/06/19

METRIC

WHOLE NUMBERS INDICATE MILLIMETRES
DECIMALIZED NUMBERS INDICATE METRES

| NO. | REVISIONS | DATE | BY |
|---|---|---|---|
| 2 | ISSUED FOR ADDENDUM #1 | 14/07/08 | ARR |
| 1 | ISSUED FOR TENDER | 14/06/19 | ARR |

B.M. ELEV.

DESIGNED BY JAD
DRAWN BY MS
CHECKED BY BM
APPROVED BY ARR
HOR. SCALE 1:500
VERTICAL
DATE JULY 2014

DILLON CONSULTING

RELEASED FOR CONSTRUCTION
DATE

ENGINEER'S SEAL
PROVINCE OF MANITOBA
ORIGINAL STAMPED BY
B.L. MOORE
2014/06/19
REGISTERED PROFESSIONAL ENGINEER

CONSULTANT PROJECT NUMBER
13-8224

THE CITY OF WINNIPEG
WATER AND WASTE DEPARTMENT

4R WINNIPEG DEPOT
BRADY ROAD RESOURCE MANAGEMENT FACILITY

SITE PLAN LIGHTING LAYOUT

CITY DRAWING NUMBER 1-0400A-E0006-001
SHEET 31 OF 35
CONSULTANT DRAWING NUMBER E6 (AD-1)

G:\CAD\DFS\138224\04-Electrical\01-Contract\138224-04-ELEC-CON.dwg