



Owner

City of Winnipeg  
 190 River Road, Winnipeg, MB


No.	Date	Revision Notes
1.	15.03.10	Issued for Coord
2.	15.04.10	Issued for 66% Review
3.	15.05.08	Issued for Construction
4.	15.06.18	Issued for Addendum 3

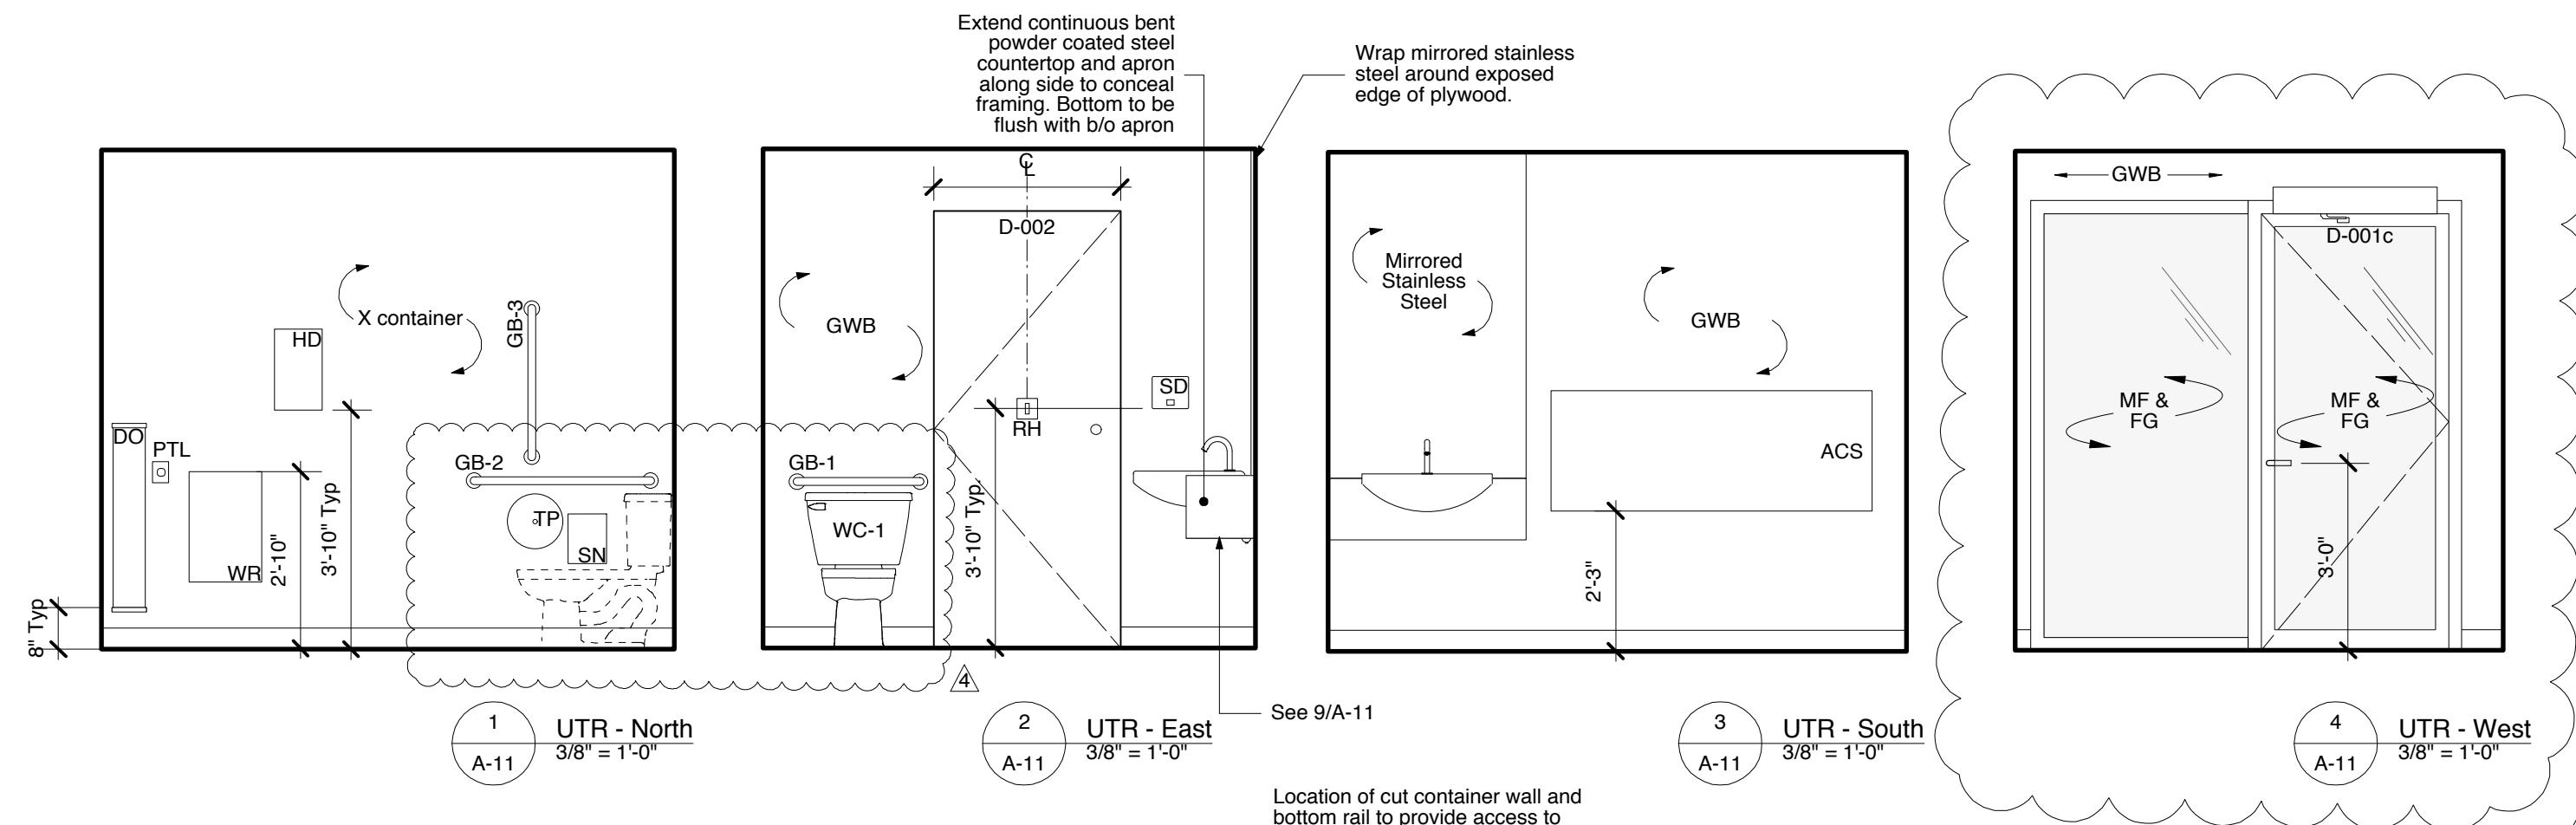

1 UTR - North 3/8" = 1'-0"  
 2 UTR - East 3/8" = 1'-0"  
 3 UTR - South 3/8" = 1'-0"  
 4 UTR - West 3/8" = 1'-0"

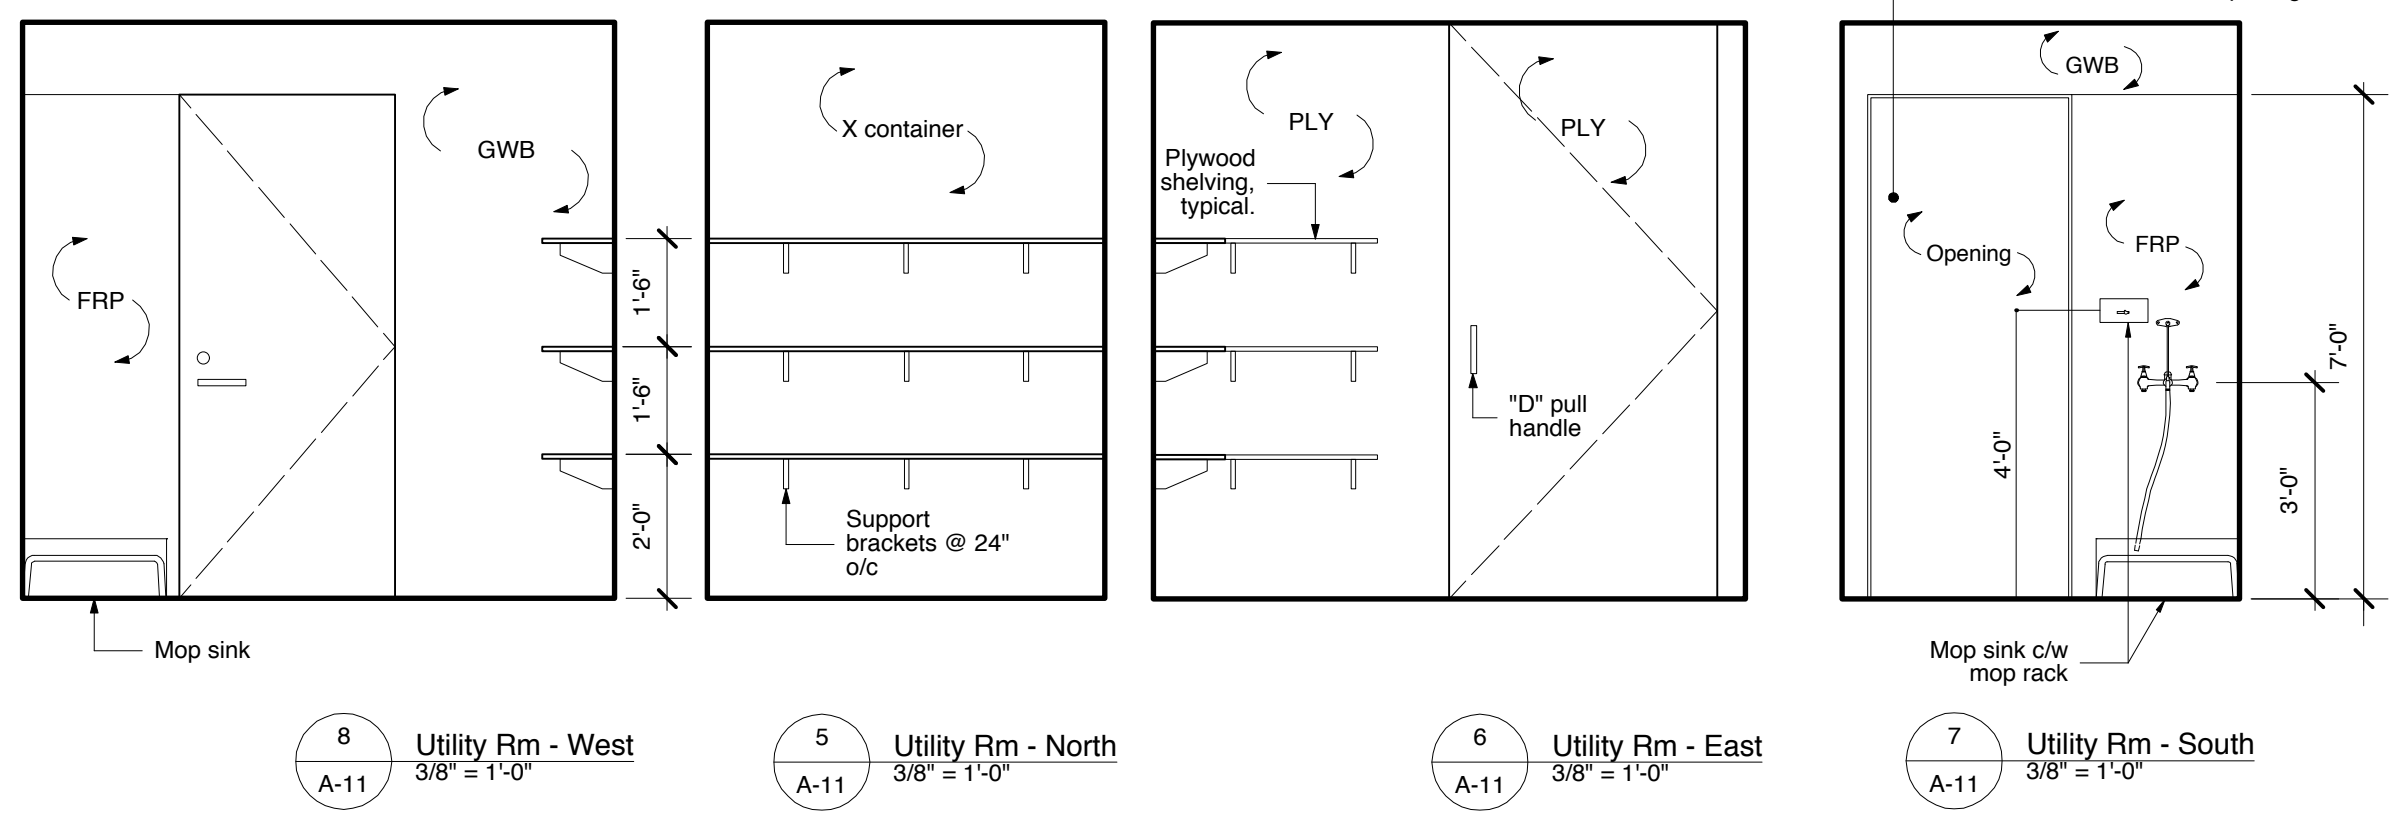

5 Utility Rm - North 3/8" = 1'-0"  
 6 Utility Rm - East 3/8" = 1'-0"  
 7 Utility Rm - South 3/8" = 1'-0"  
 8 Utility Rm - West 3/8" = 1'-0"

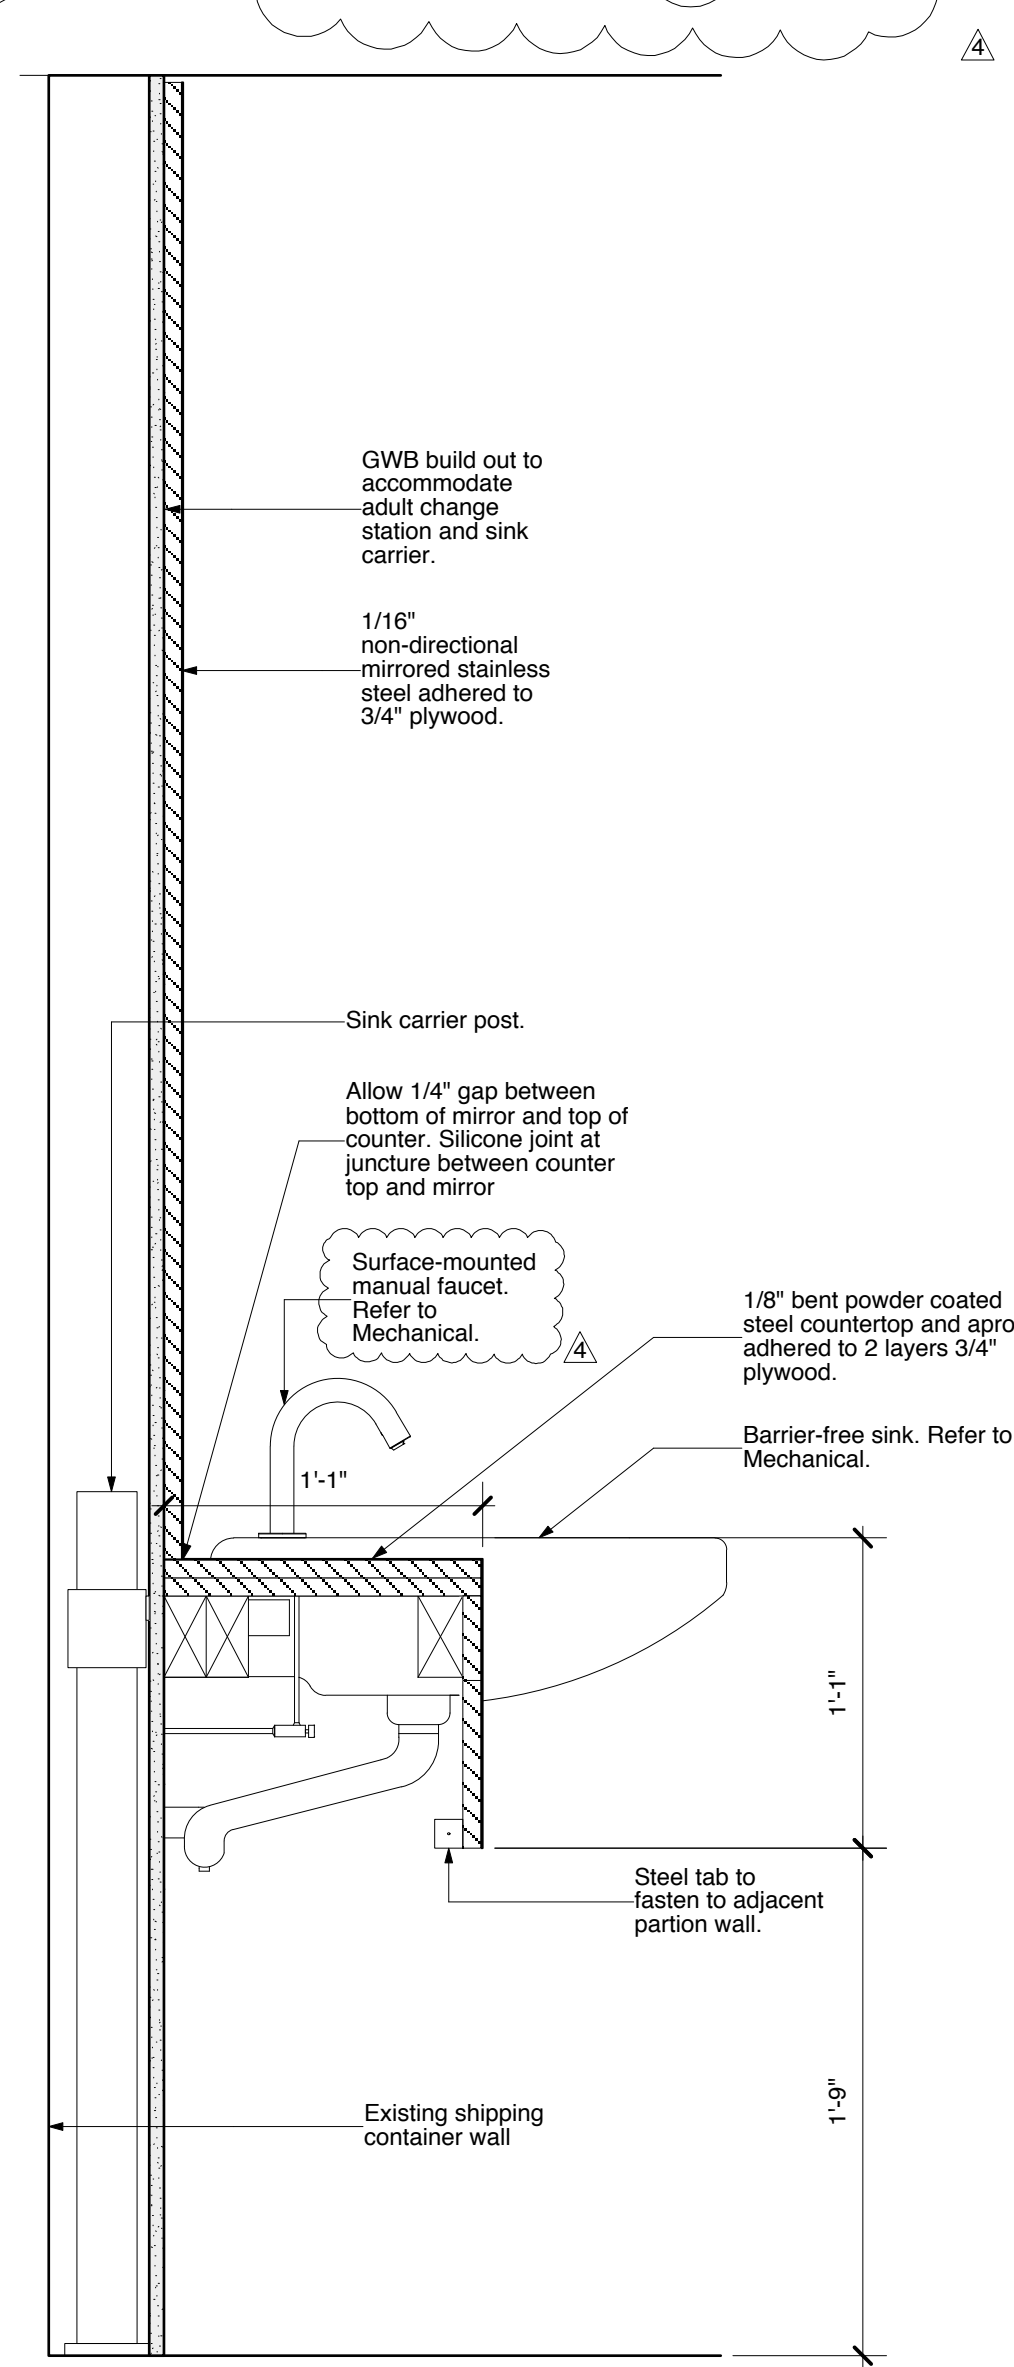

9 Detail @ UTR Sink 1-1/2" = 1'-0"



This drawing must not be scaled. The contractors shall verify all dimensions and other data on site prior to commencement of work. Discrepancies, errors, and omissions are to be reported to the Architect prior to proceeding with the Work.

Drawings and specifications as instruments of service are the property of the Architect; the copyright in the same being reserved to him.

No reproduction or revision to these drawings may be made without the permission of the Architect, and when made, must bear his name. All prints to be returned to the Architect upon request.

Project  
**St. Vital Park Washrooms**

Drawing  
**Interior Elevations**

Drawn By  
 MH  
 Scale  
 Reviewed By  
 PS  
 Drawing No.  
**A-11**

Date  
 May 2015  
 Project No.  
 1445  
 File No.  
 0