


EAST ELEVATION

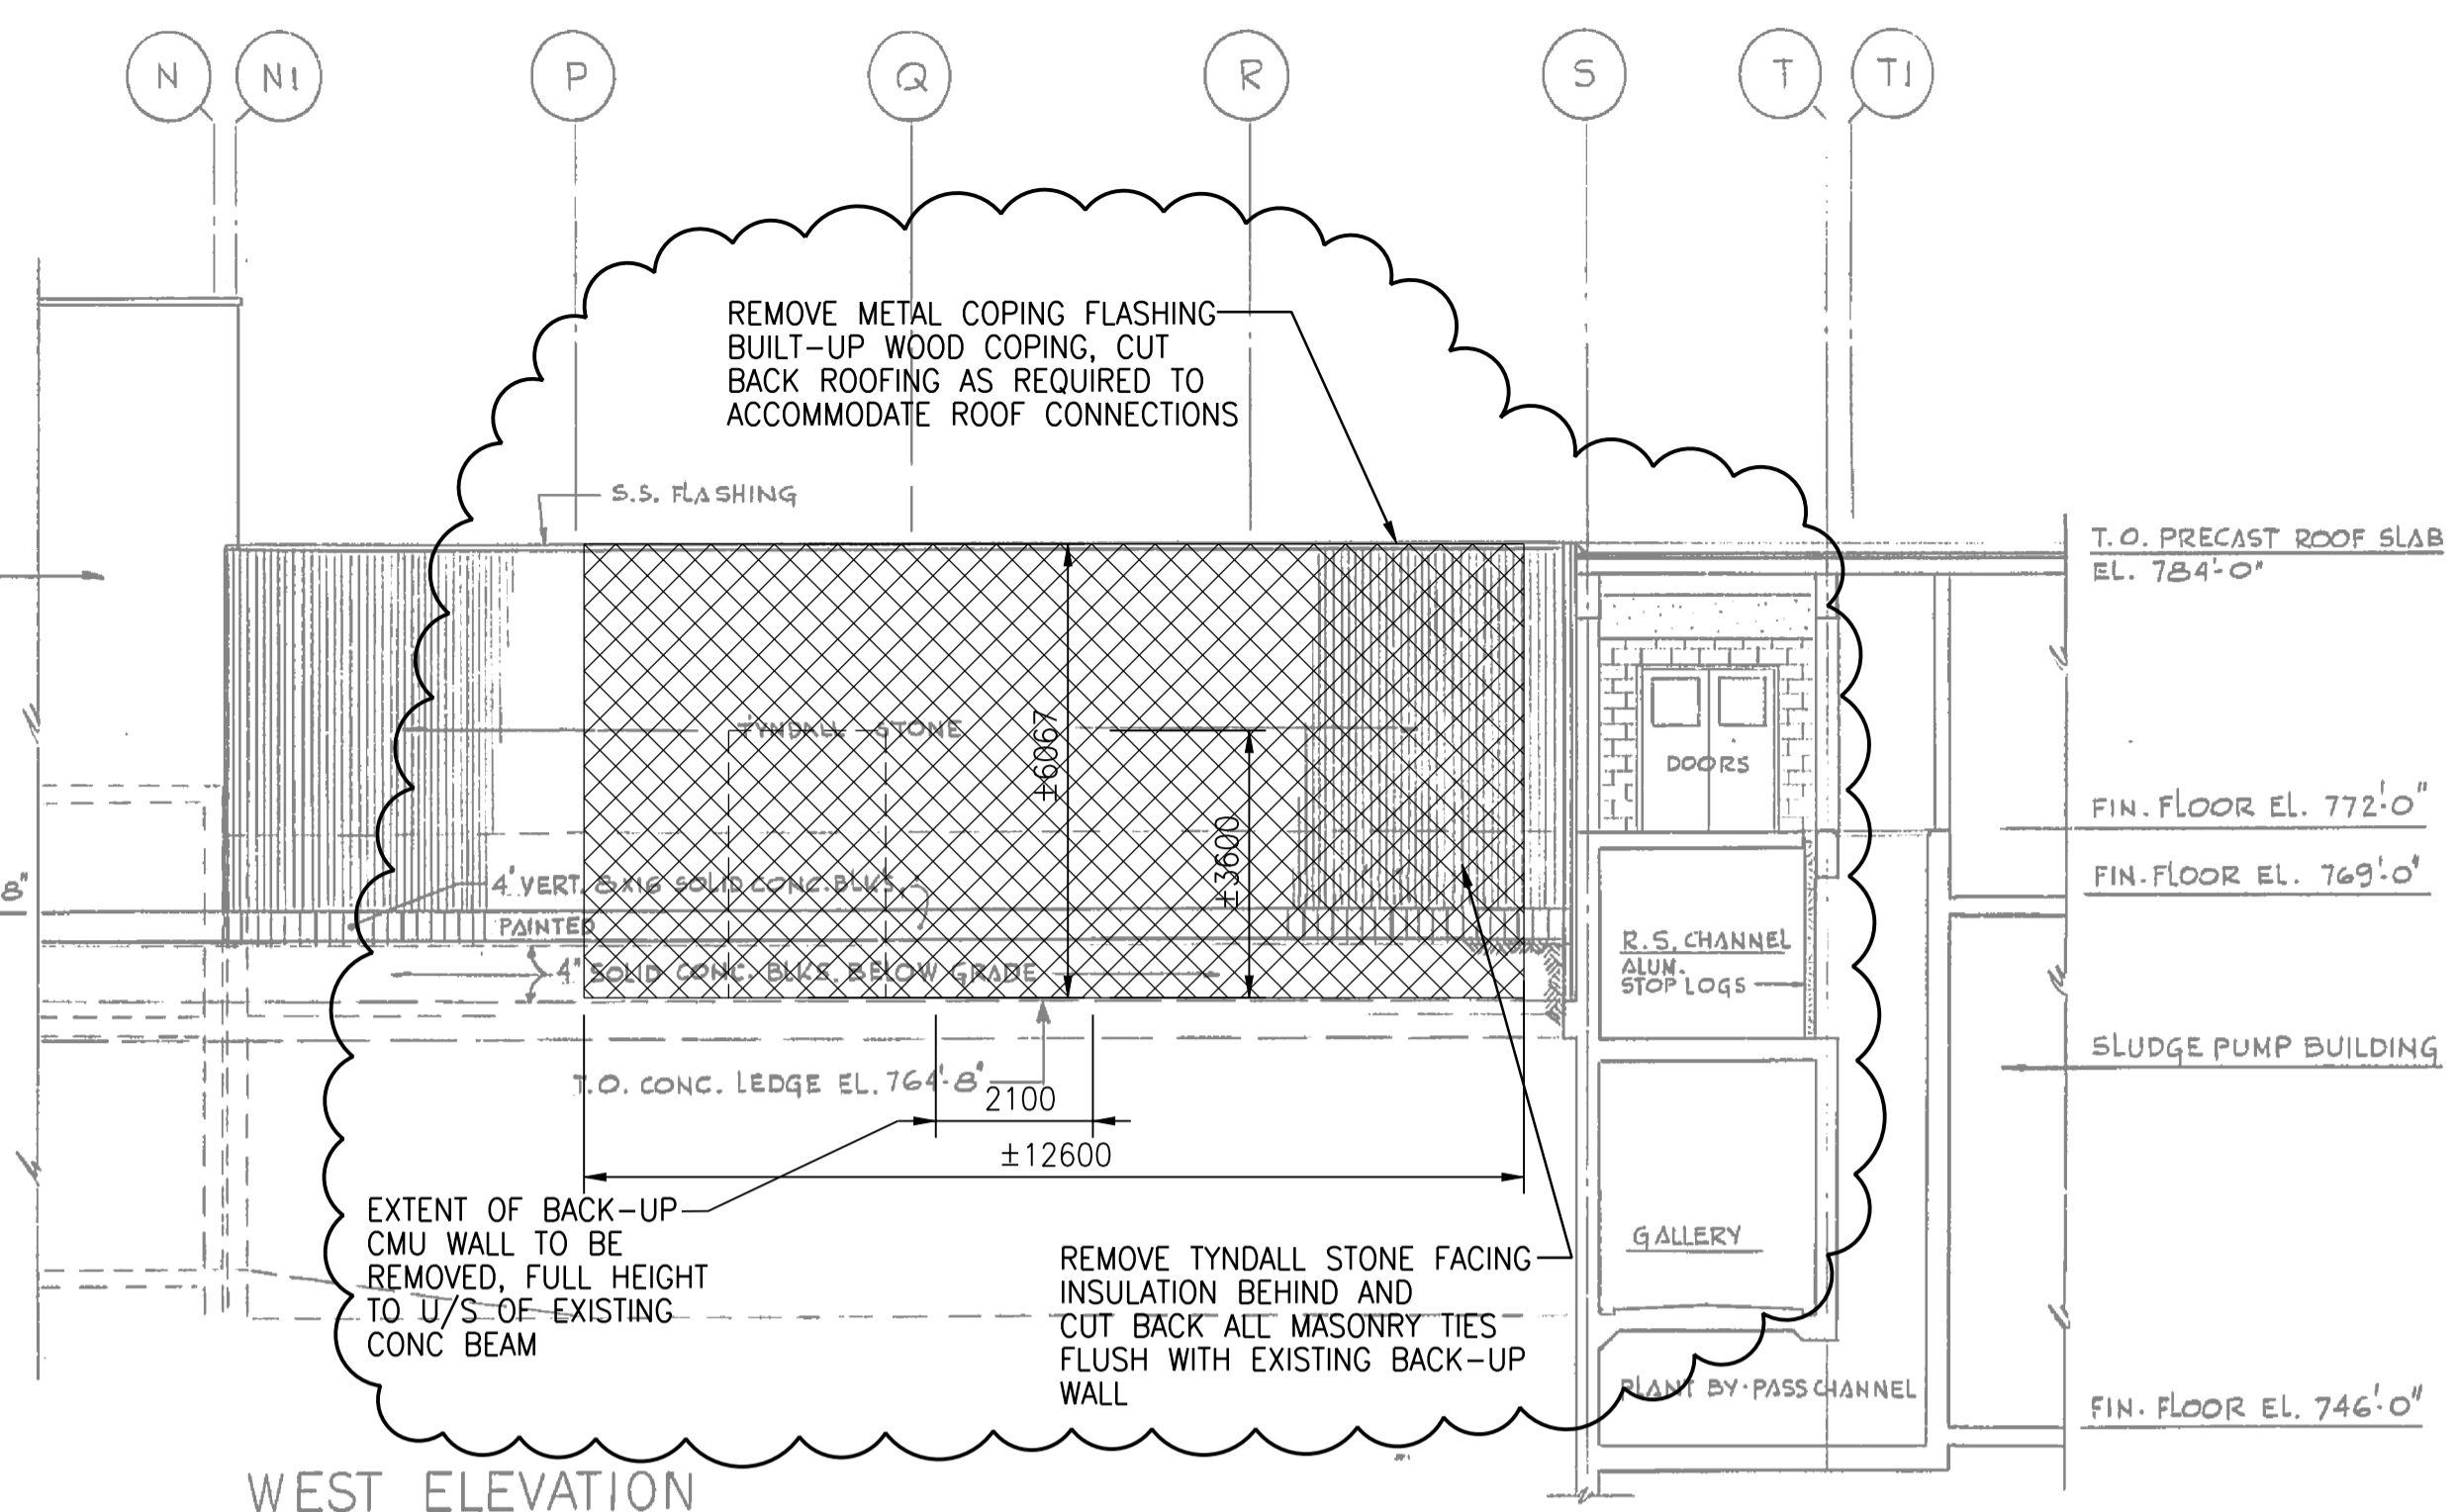

WEST ELEVATION

- NOTES:
- FOR NEW CONSTRUCTION SEE MECHANICAL HEADWORKS DRAWINGS.
 - REFER TO GENERAL DEMOLITION NOTES DRAWING 4-0102-DDTL-A002.

SEALING ARCHITECT OR ENGINEER ACCEPTS RESPONSIBILITY ONLY FOR AREAS IDENTIFIED BY CLOUDING ON THIS DRAWING.

NOTE: THIS DRAWING SUPERSEDES DRAWING SEP-24



CH2MHILL CANADA Architects Inc.		ENGINEER'S SEAL	
DESIGNED BY: R. ZAKKO	CHECKED BY: B. KOLIS-HUPA		
DRAWN BY: N. BOYCHUK	APPROVED BY: R. ZAKKO		
SCALE: 1:50	ISSUED FOR CONSTRUCTION BY: T. TURZAK		
DATE: 2015/08/13	DATE: 2015/08/13		
00 ISSUED FOR TENDER	08/2015	N.B. J.C.	CONSULTANT NO.: 474248
NO. REVISIONS	DATE	DESIGN CHECK	

THE CITY OF WINNIPEG
Winnipeg WATER AND WASTE DEPARTMENT

SOUTH END WATER POLLUTION CONTROL CENTRE
SEWPCC UPGRADING/EXPANSION PROJECT
BUILDING
GRIT BUILDING
ELEVATIONS

CITY DRAWING NUMBER: 1-0102-BGAD-G050 SHEET: 00 REV: A1 SIZE: A1