



PLAN SHOWING DIRECTION OF GALLERY DRAINAGE AND WEEPING TILE
1:350

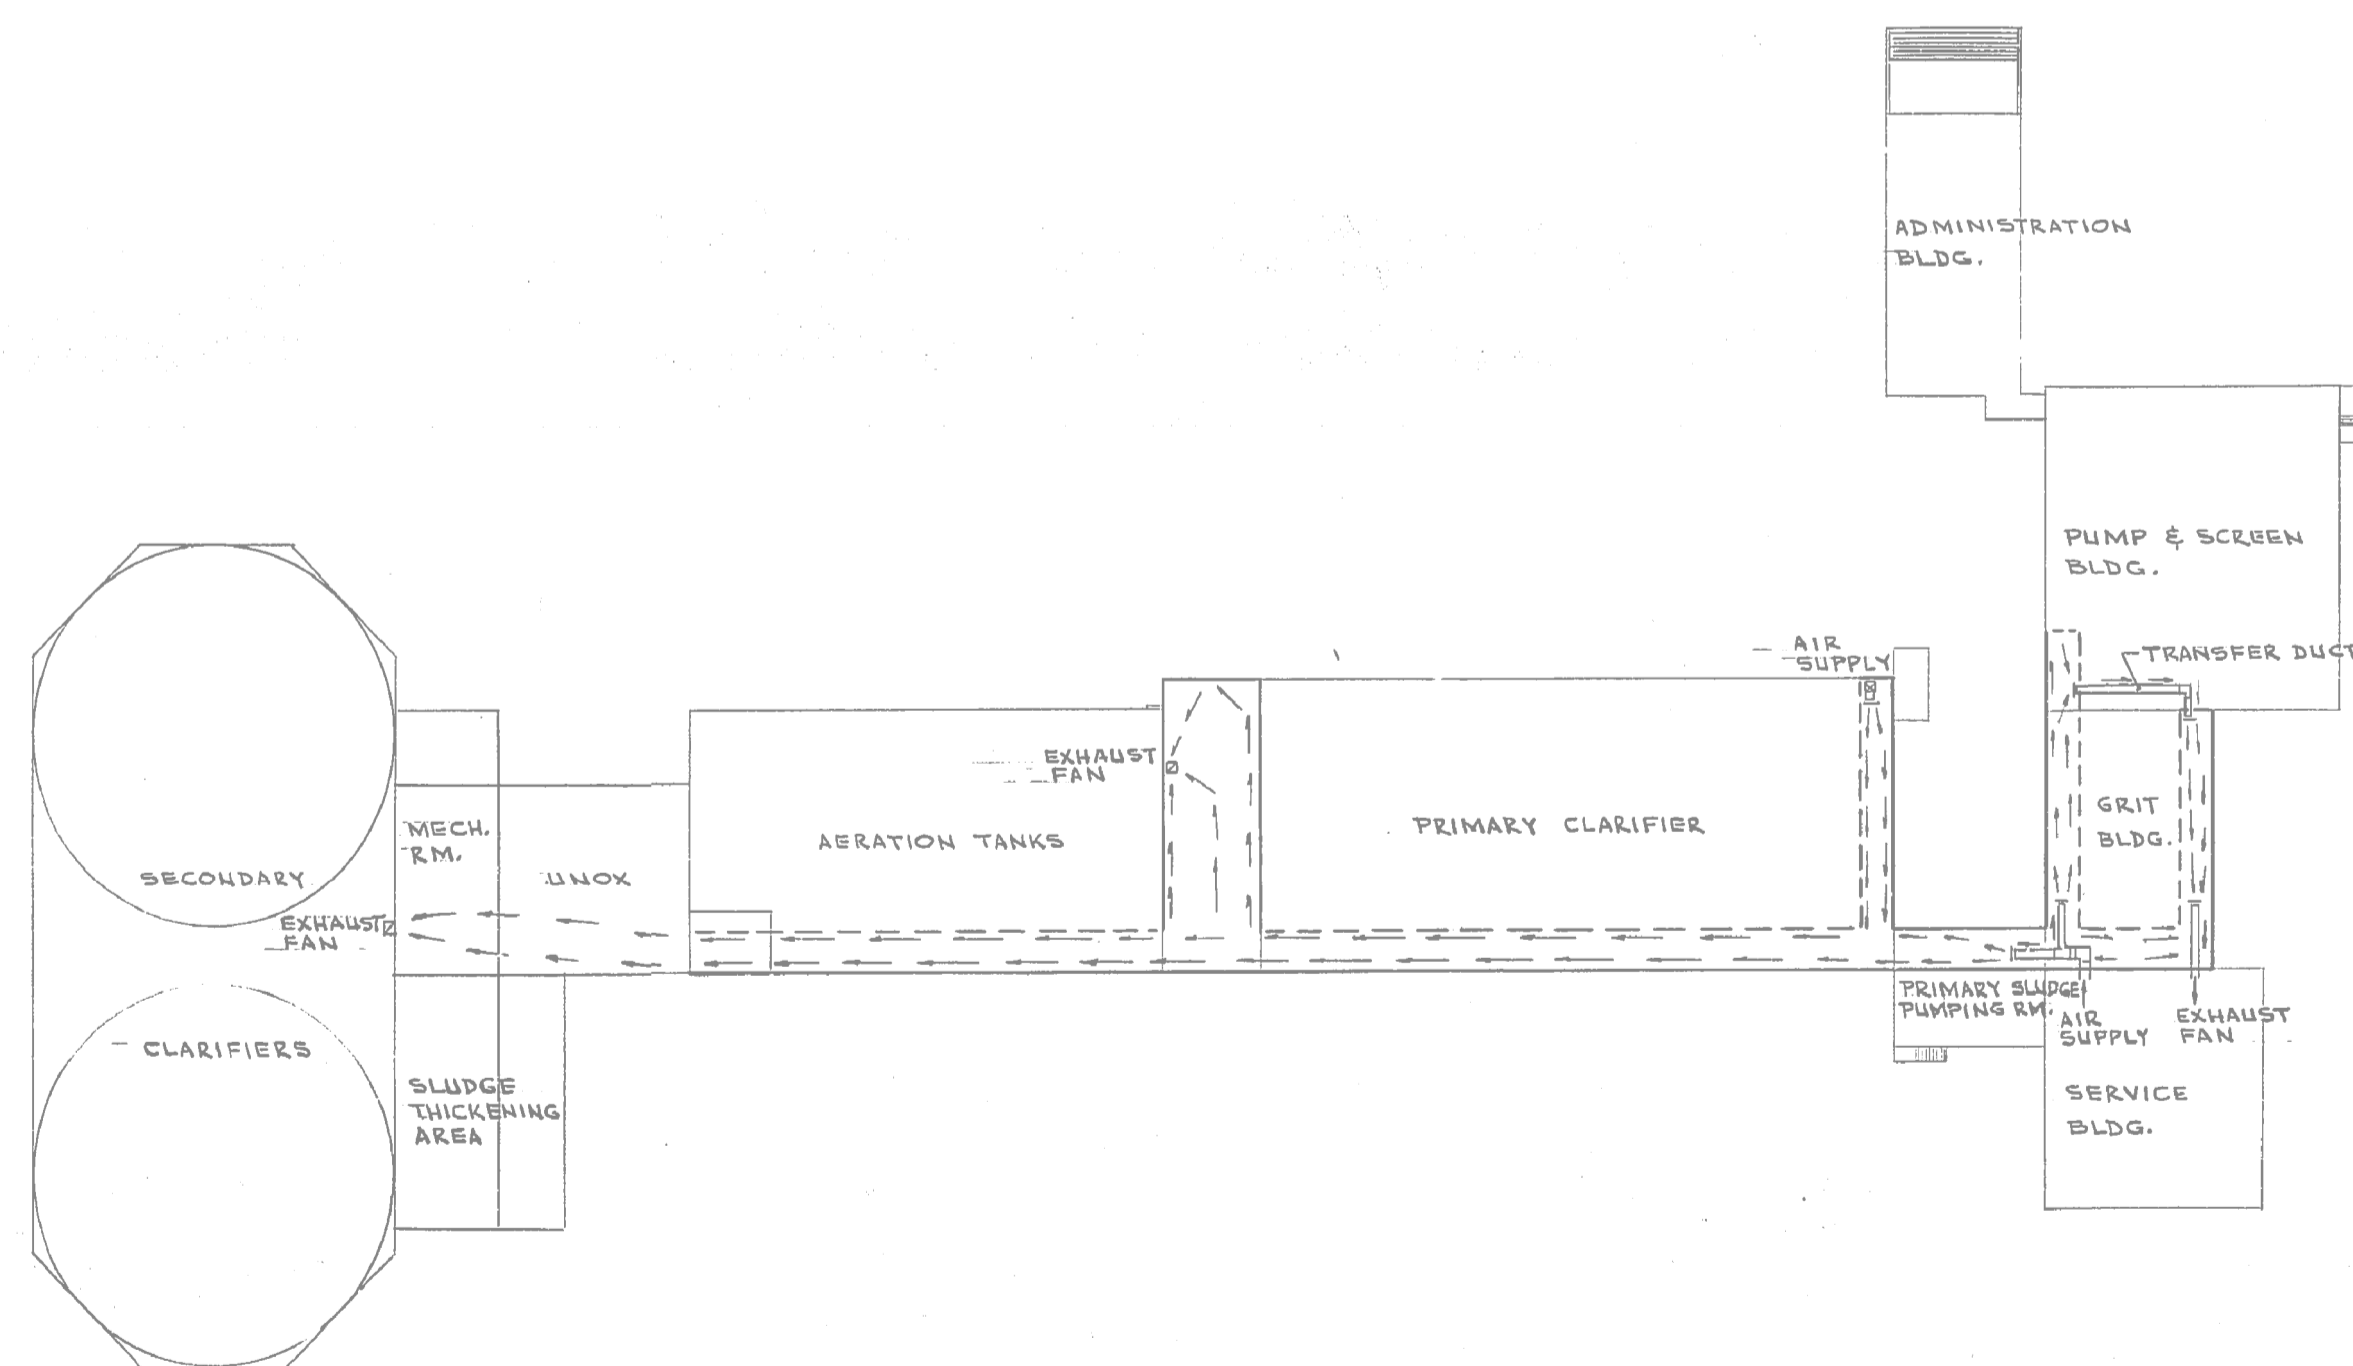

PLAN SHOWING DIRECTION OF GALLERY VENTILATION
1:350

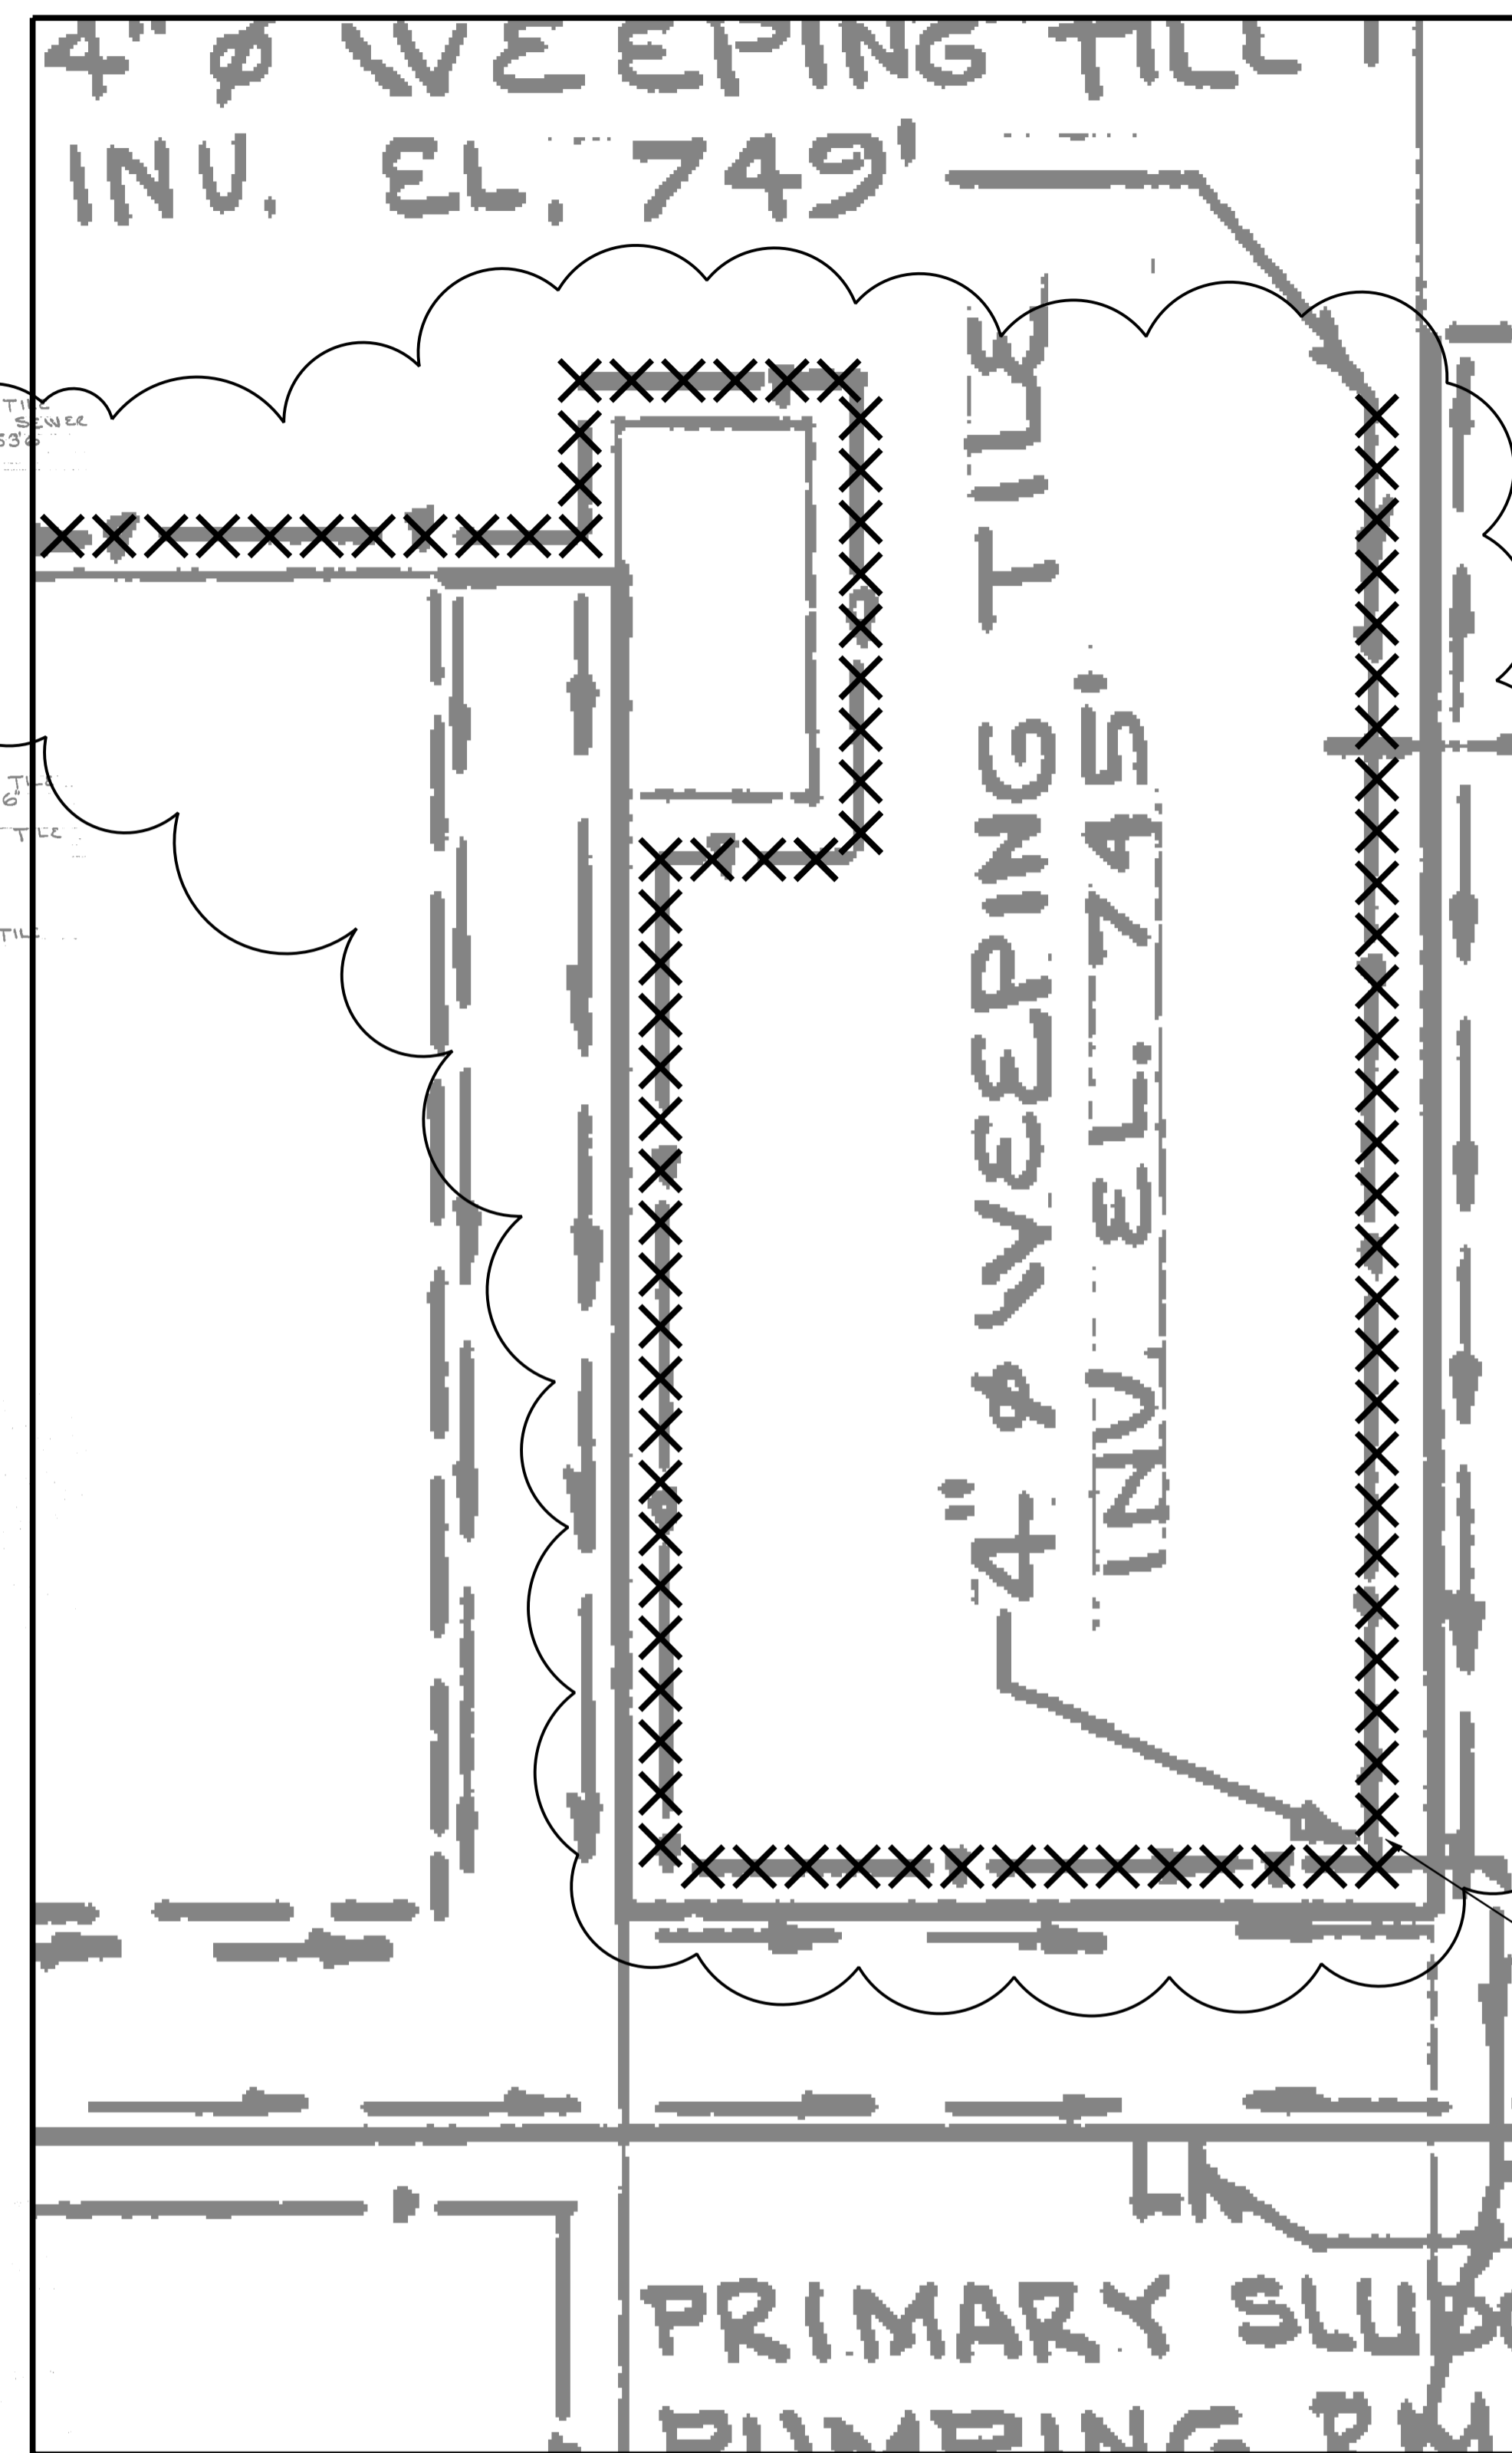

A DETAIL
1:50

LEGEND:
XXXX REMOVE WEEPING TILE

CUT AND CAP EXISTING WEEPING TILE



NO.	REVISIONS	DATE	DESIGN	CHECK
00	ISSUED FOR TENDER	08/2015	A.G. B.W.	

CH2MHILL.		ENGINEER'S SEAL	
SNC-LAVALIN		KCS GROUP CONSULTANTS	
DESIGNED BY: B. WILLIAMSON	CHECKED BY: J. CHENG		
DRAWN BY: A. GODSEY	APPROVED BY: J. CHENG		
SCALE: 1:100	ISSUED FOR CONSTRUCTION BY: T. TURZAK		
DATE: 2015/08/13	DATE: 2015/08/13	CONSULTANT NO.: 474248	

SEALING ARCHITECT OR ENGINEER ACCEPTS RESPONSIBILITY ONLY FOR AREAS IDENTIFIED BY CLOUDING ON THIS DRAWING.
NOTE: THIS DRAWING SUPERSEDES DRAWING SEP-8

THE CITY OF WINNIPEG
Winnipeg WATER AND WASTE DEPARTMENT
SOUTH END WATER POLLUTION CONTROL CENTRE
SEWPCC UPGRADING/EXPANSION PROJECT
CIVIL
EXISTING SITE PLAN
WEEPING TILE REMOVAL

CITY DRAWING NUMBER 4-0102-CGAD-K050	SHEET 00	REV. A1	SIZE A1
---	-------------	------------	------------