

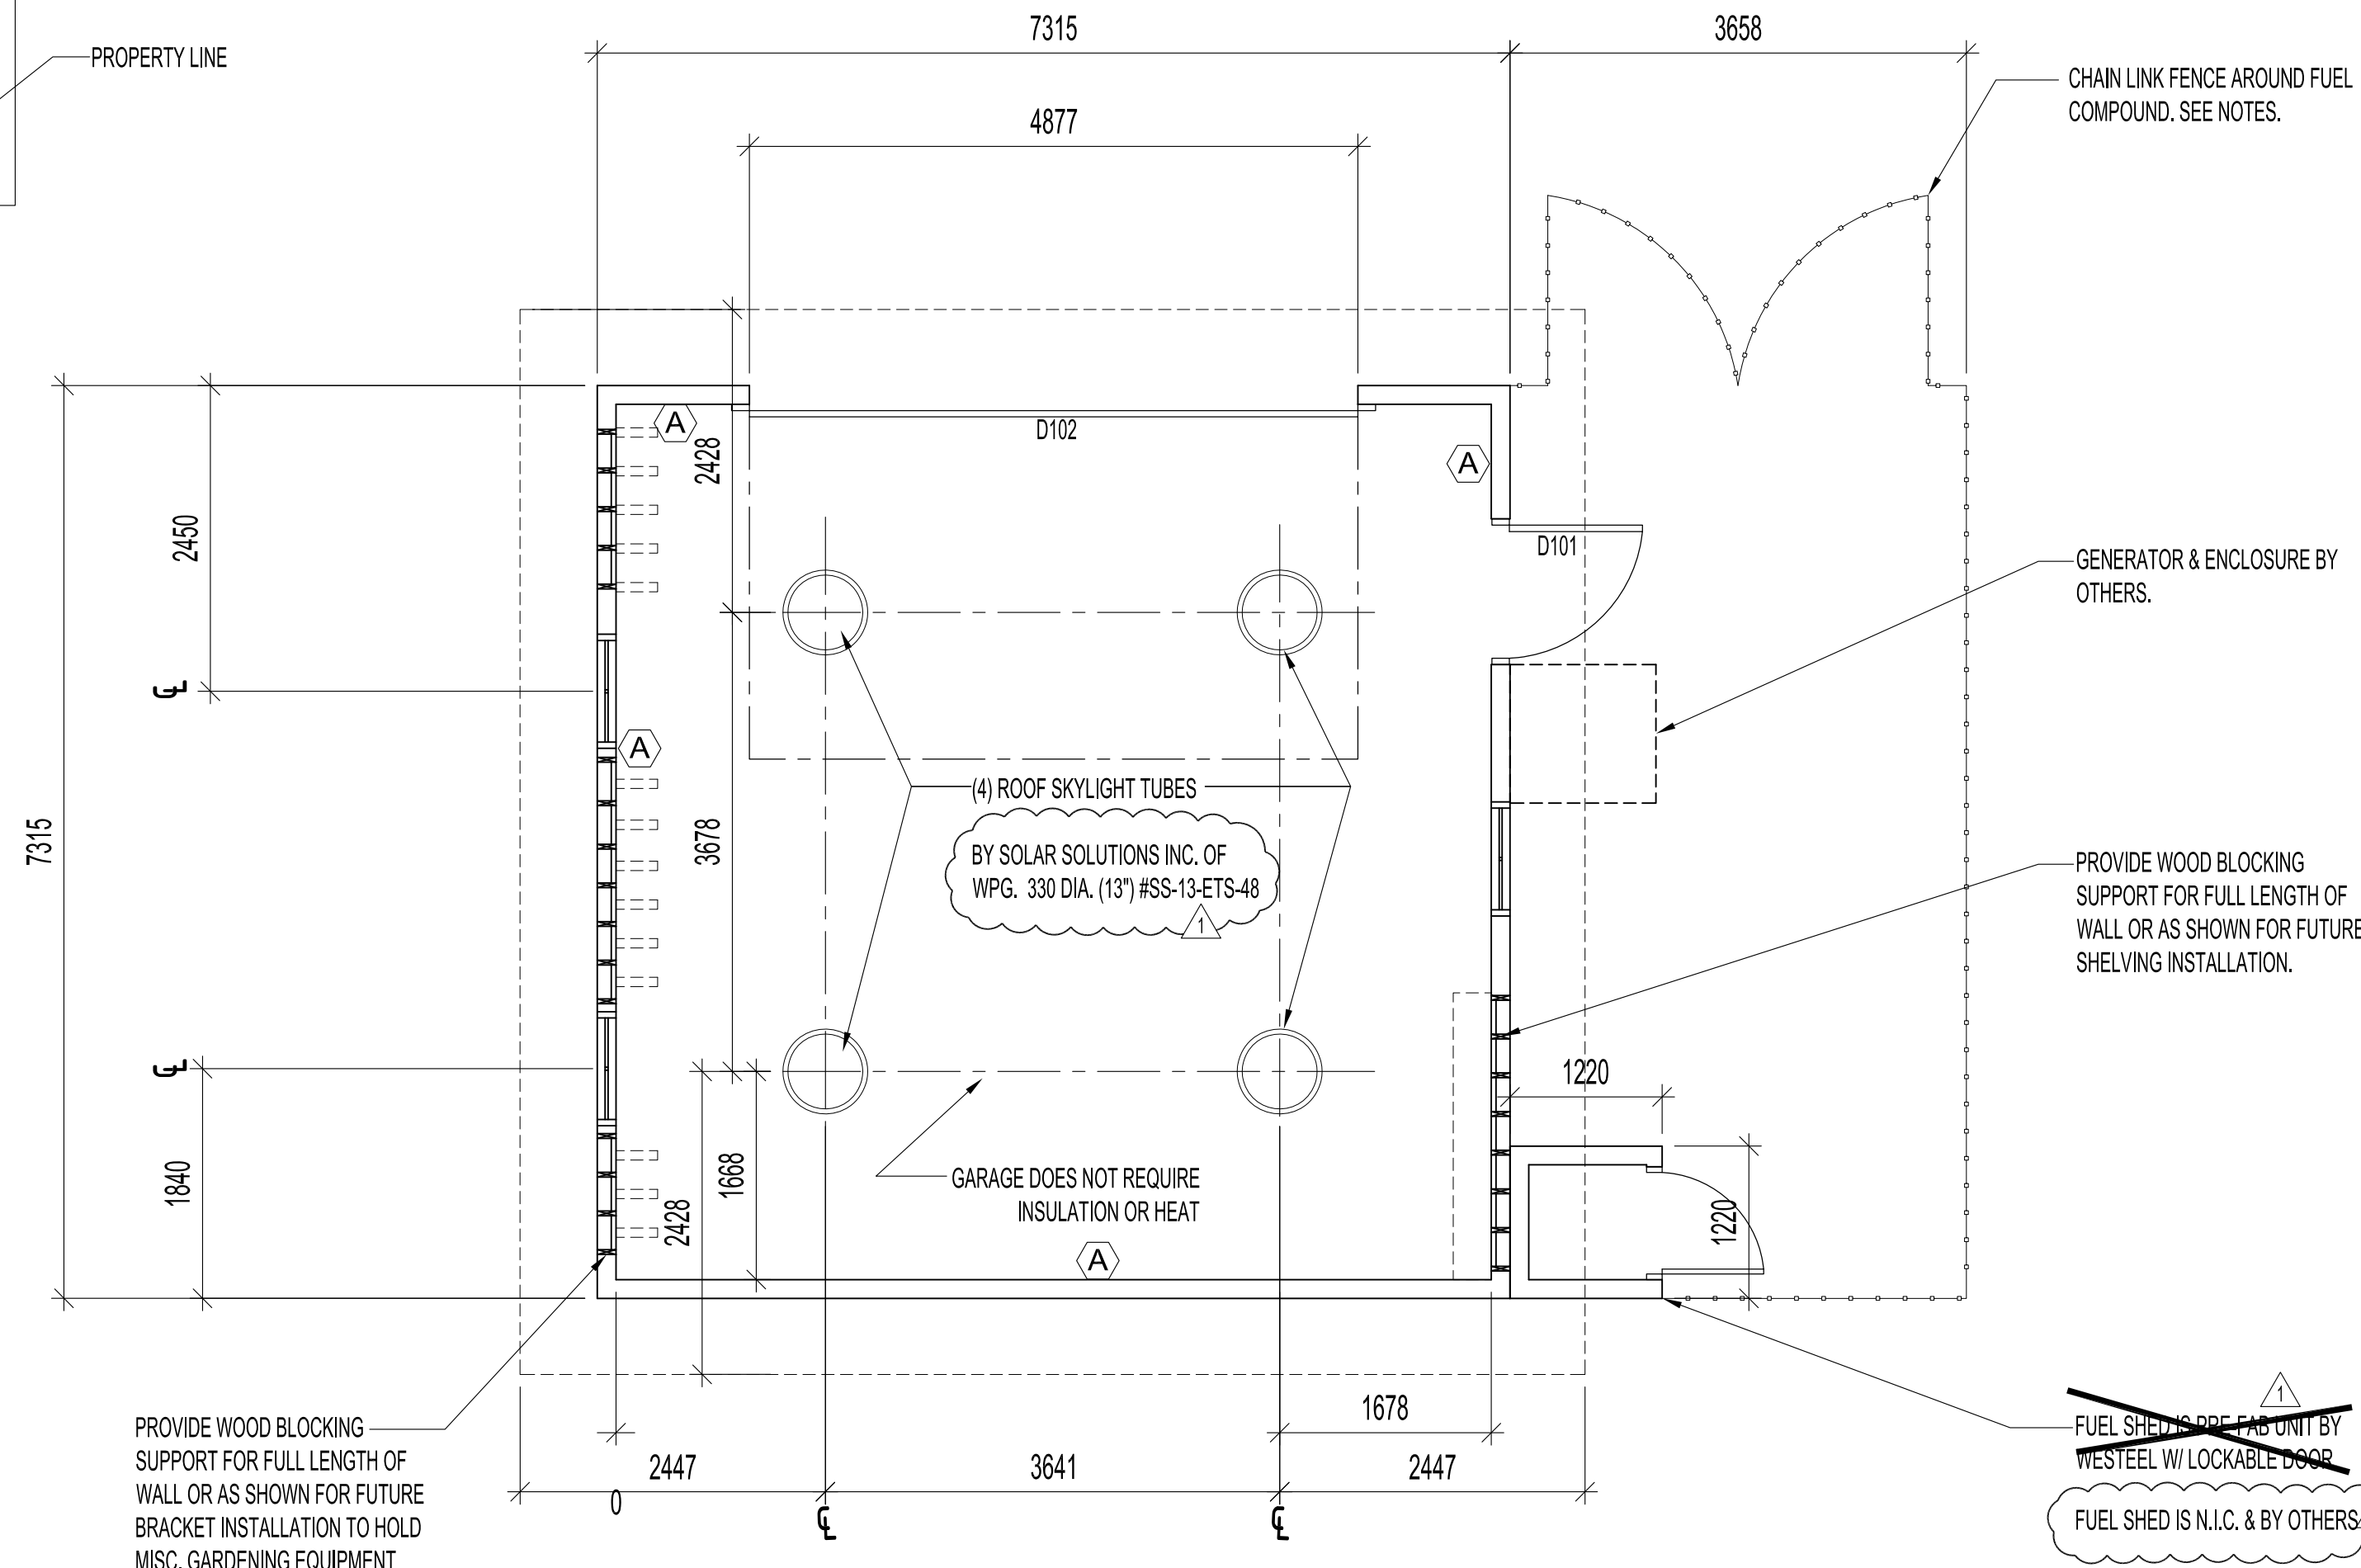


1 SITE PLAN - GARAGE LOCATION
A1 SCALE 1:200

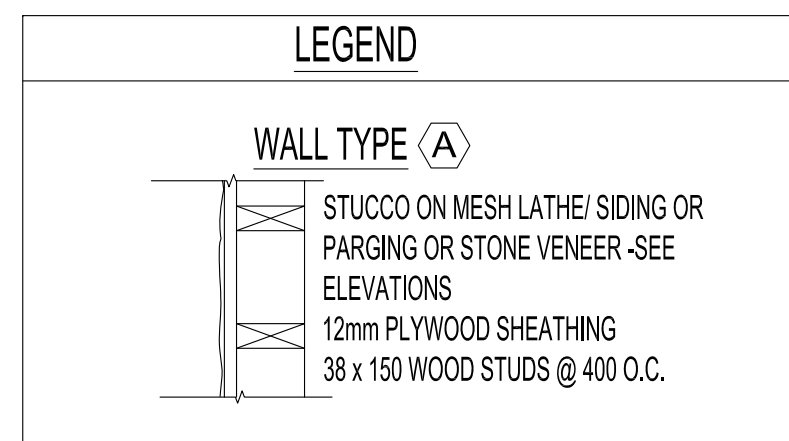

1 SHED & GARAGE PLAN
A1 SCALE 1:50

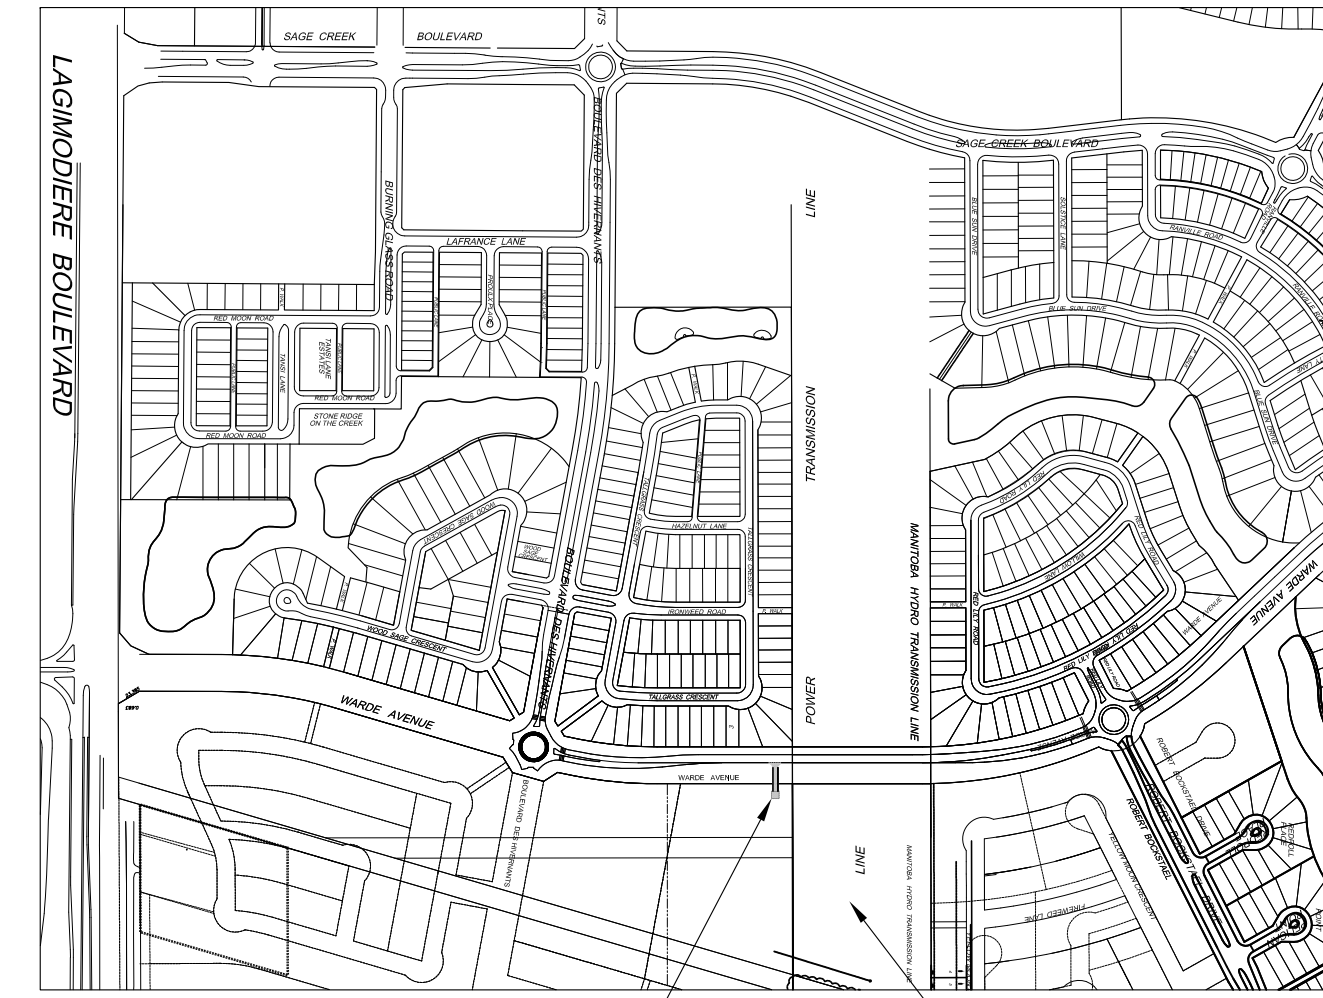

1 SITE PLAN - GARAGE LOCATION
SCALE 1:1000

NOTES:

CHAIN LINK FENCING

1830 HIGH CHAIN LINK FENCE W/ LOCKABLE GATES AROUND FUEL COMPOUND. CHAIN LINK FENCING TO HAVE BLACK VINYL COATING. INSTALLATION OF CHAIN LINK FENCING TO FOLLOW THE CITY OF WPG CONSTRUCTION STANDARDS WEBSITE FOR "CHAIN LINK FENCING" CW3550-R3

CULVERT

INSTALLATION OF CULVERT TO FOLLOW THE CITY OF WPG CONSTRUCTION STANDARDS WEBSITE FOR "INSTALLATION OF CULVERTS" CW3610-R4

CONCRETE APPROACH

INSTALLATION OF APPROACH TO FOLLOW THE CITY OF WPG CONSTRUCTION STANDARDS WEBSITE FOR "PRIVATE APPROACH ON REGIONAL STREETS (WITH DITCH DRAINAGE)" SD-234

SHOP DRAWINGS

PRE-ENGINEERED TRUSS SYSTEM

PROVIDE SHOP DRAWINGS FOR ROOF TRUSS SYSTEM.

1 -TYPE & BRAND OF SKYLIGHT TUBES ADDED MMK 2015.09.22
-FUEL SHED N.I.C. & BY OTHERS

ISSUED FOR CONSTRUCTION MMK 2015.07.24

No.	REVISION/DESCRIPTION	BY	DATE

DRAWN	CHECKED	DESIGNED	APPROVED
MMK			
DATE 2015.01.15	USER APPROVAL		

THE CITY OF WINNIPEG
PLANNING, PROPERTY AND
DEVELOPMENT DEPARTMENT
MUNICIPAL ACCOMMODATIONS DIVISION
3-65 GARRY STREET, R3C 4K4

PROJECT
PUBLIC WORKS
PARKS & OPEN SPACE DIVISION
NEW PARKS GARAGE
2050 WARDE AVENUE

SHEET TITLE
SITE & BUILDING PLANS

SCALE	PROJECT No:	SHEET No:
AS SHOWN	2014-128	A1R1