


NOTES:


- SEE DRAWING 1-0169L-S0004 FOR GENERAL NOTES.
- SEE DRAWING 1-0169L-S0005 FOR STRUCTURAL NOTES.

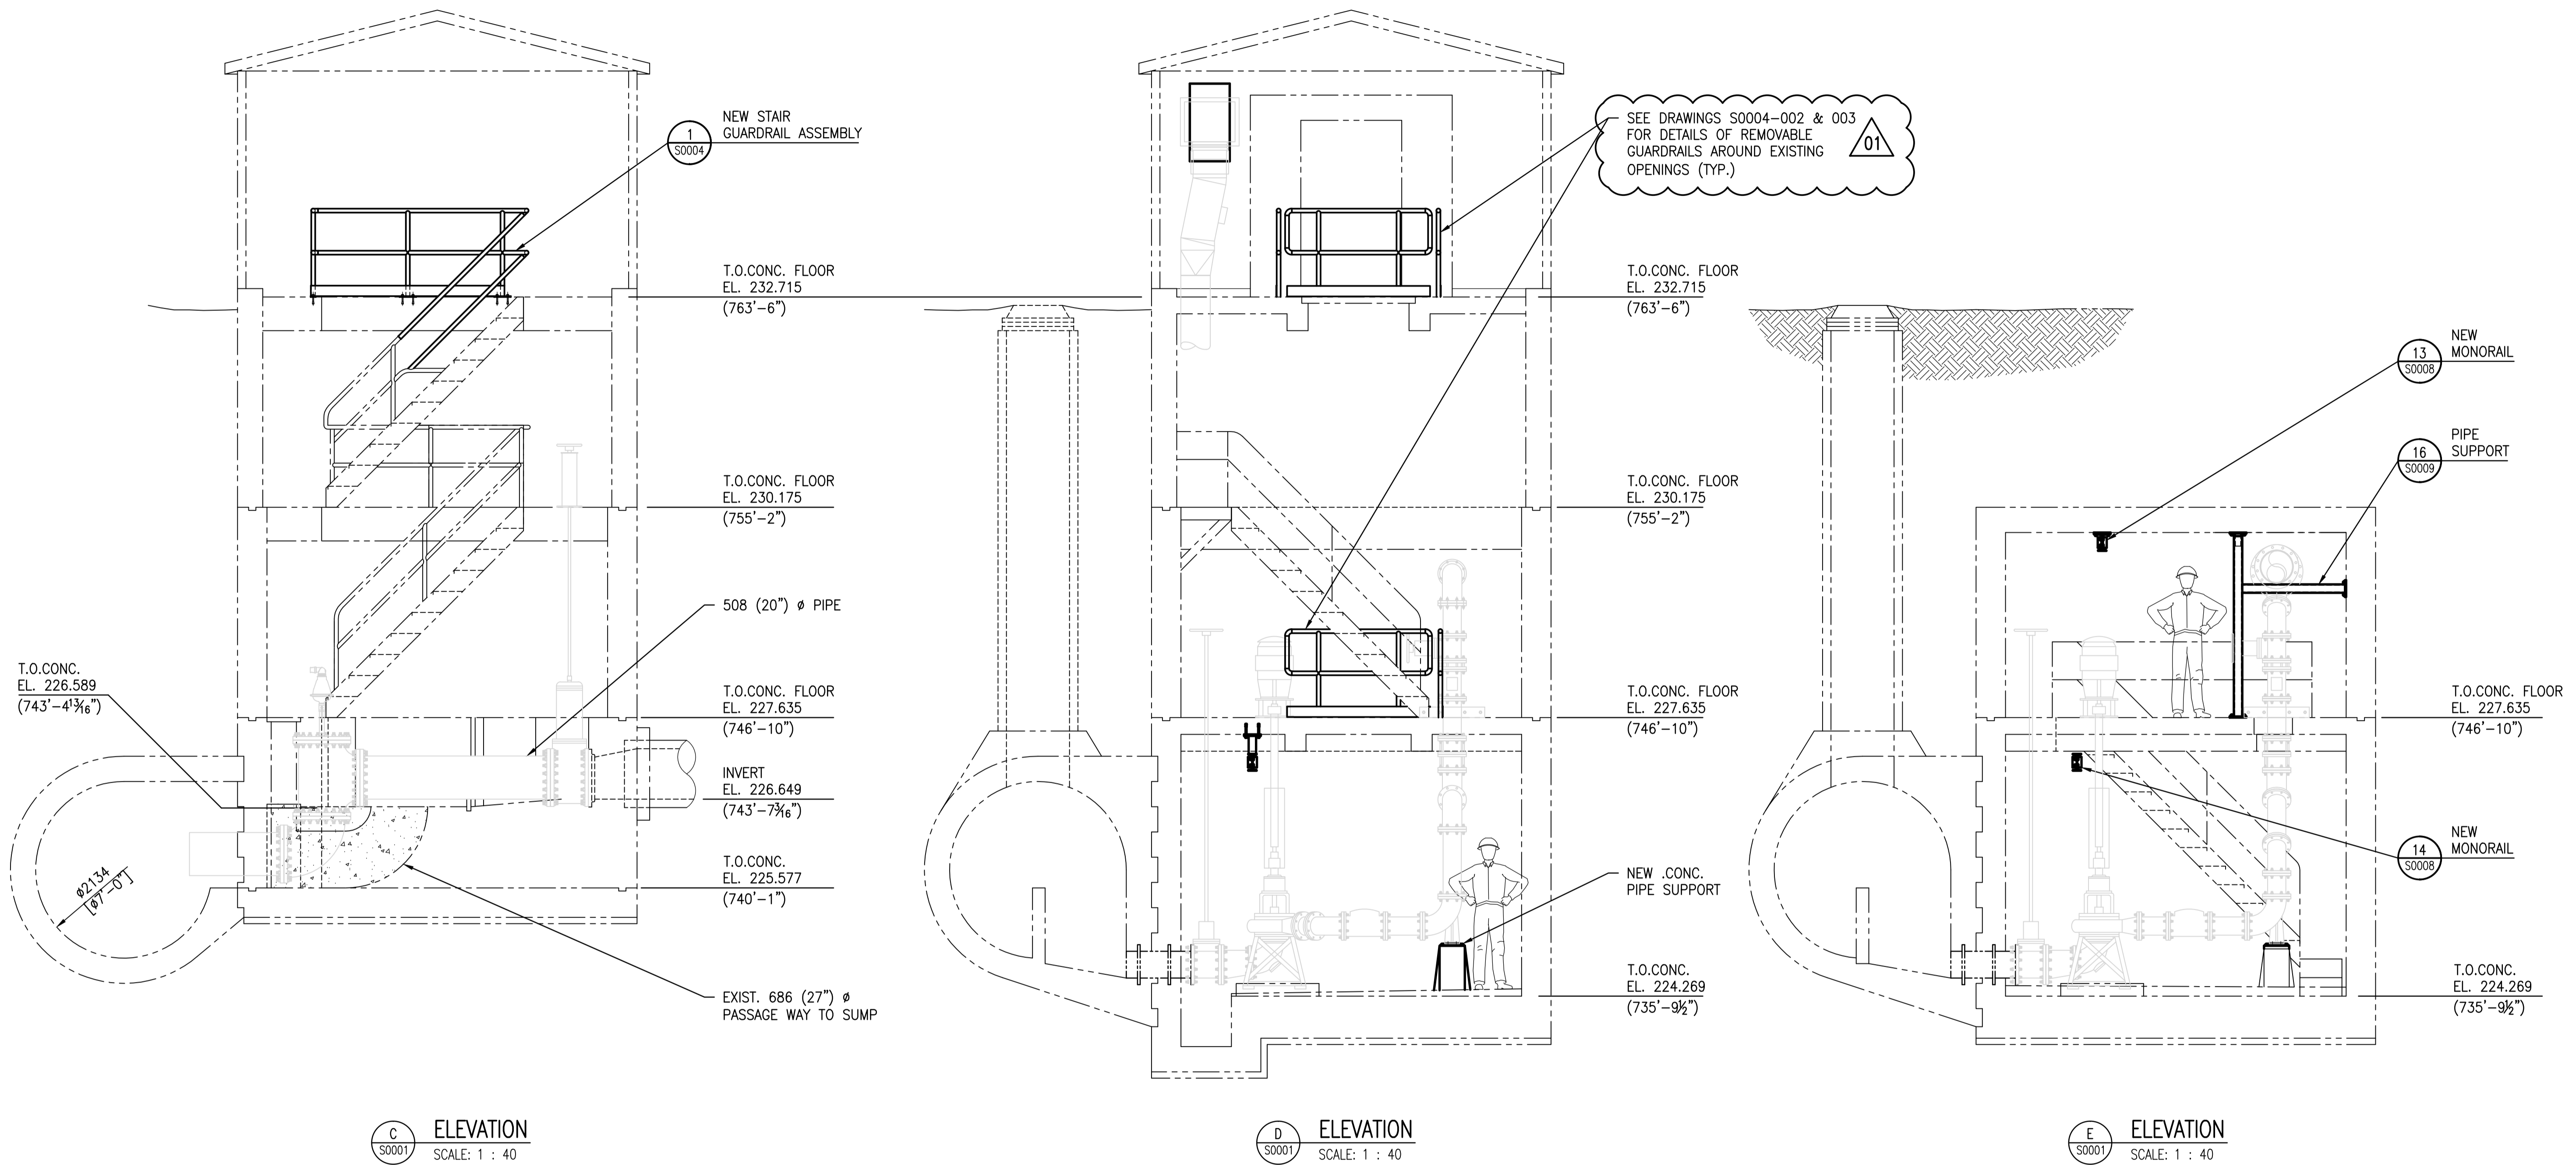

C ELEVATION
SCALE: 1 : 40

D ELEVATION
SCALE: 1 : 40

E ELEVATION
SCALE: 1 : 40

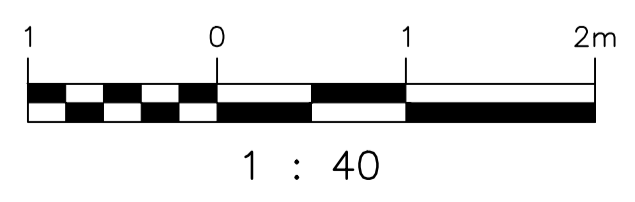

LAST SAVE: 2015/09/30 - 1:39pm
PATH: M:\29179\ENGL\25TR\DD - General DWG\1-0169L-S0003-001-01.dwg

DRAWING NUMBER	REFERENCE DRAWINGS
403-B	AINSLIE COMM. & PUMPING STATION - SUPERSTRUCTURE & DETAILS
403-A	AINSLIE COMM. & PUMPING STATION - REINFORCING DETAILS
403	AINSLIE COMM. & PUMPING STATION

NO.	REVISIONS	DATE	DESIGN	CHECK
01	ISSUED FOR ADDENDUM - GUARDRAILS ADDED	2015/09/28	K.K.	
00	ISSUED FOR TENDER	2015/09/17	K.K.	

 SNC-Lavalin Inc. 148 Nature Park Way Winnipeg, MB, Canada R3P 0X7 204-786-8080	
DESIGNED BY: K. KOTYK	CHECKED BY: D. COATES
DRAWN BY: B. DICKSON	APPROVED BY: I. PARKINSON
SCALE: 1:40	ISSUED FOR CONSTRUCTION BY:
DATE: 2015/06/22	DATE:
CONSULTANT NO.:	

ENGINEER'S SEAL
PRELIMINARY
NOT TO BE
USED FOR
CONSTRUCTION

THE CITY OF WINNIPEG
WATER AND WASTE DEPARTMENT

OLIVE WASTEWATER LIFT STATION
2015 UPGRADES
ELEVATIONS
STRUCTURAL MODIFICATIONS

CITY DRAWING NUMBER	SHEET	REV.	SIZE
1-0169L-S0003	001	01	A1