


GUARDRAIL (BY OWNER)  
 ② SEE KEYNOTES

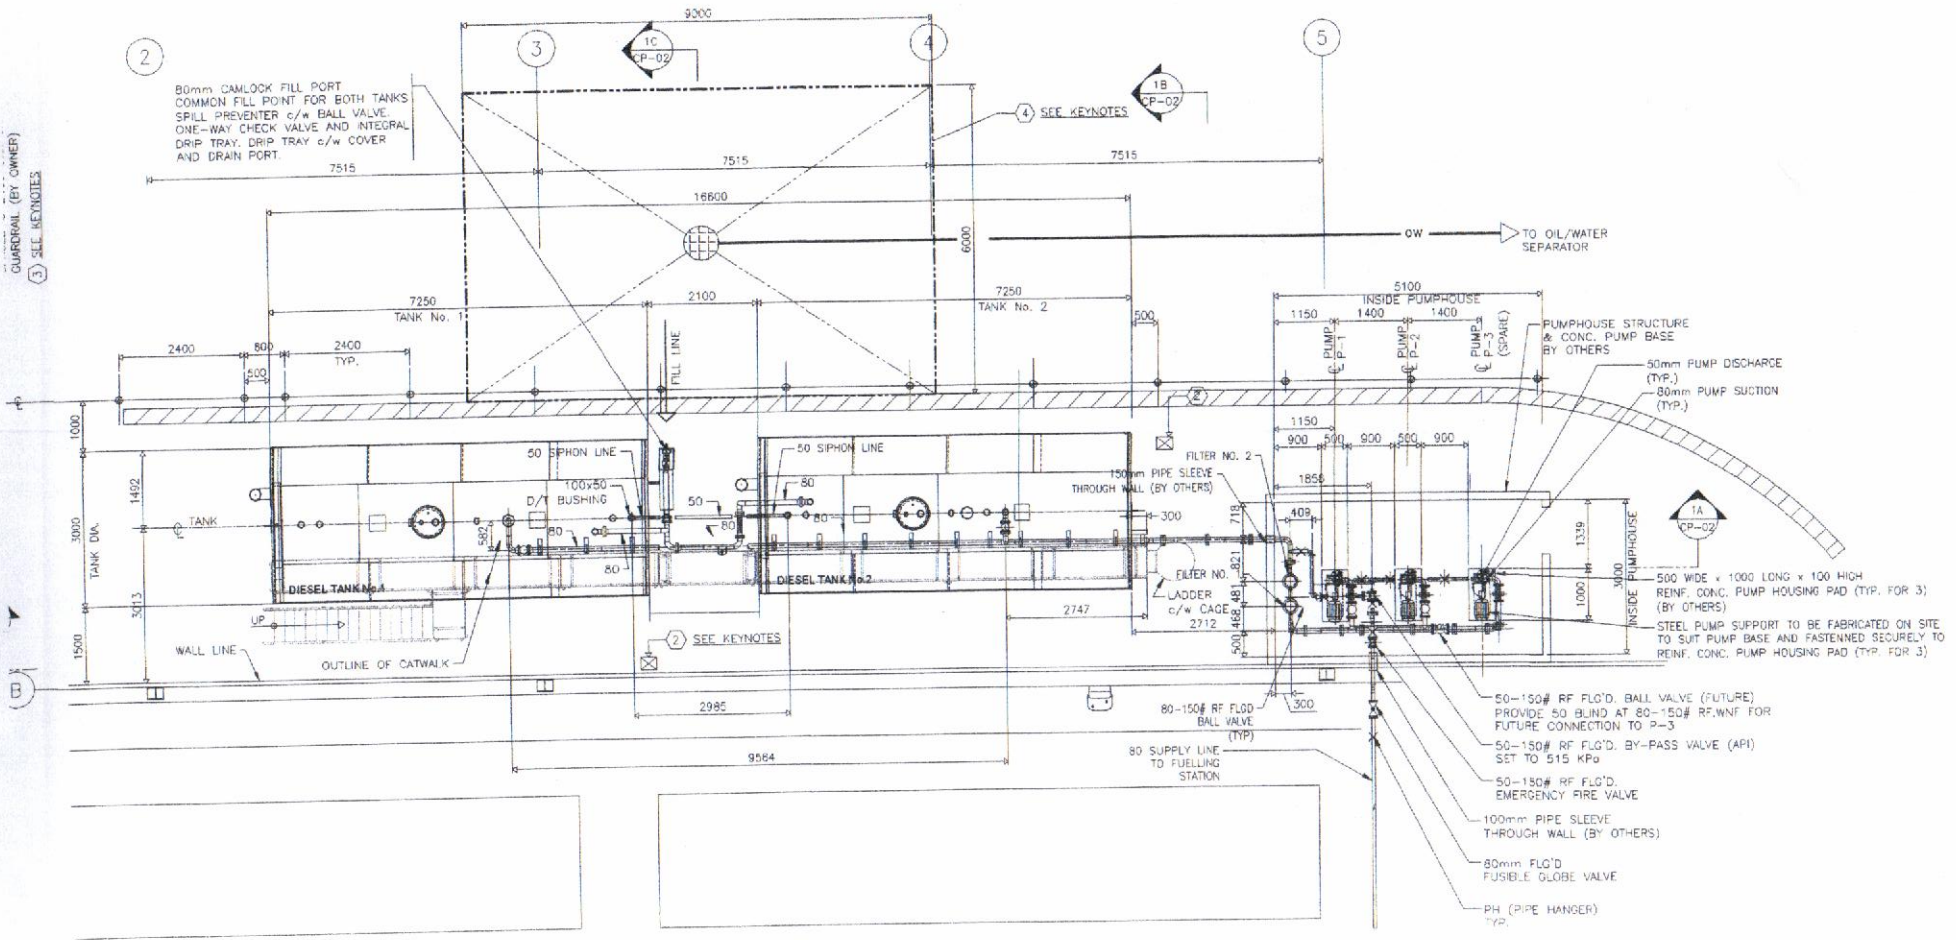

2 x 50,000 litre tanks &

PUMP HOUSE PIPING LAYOUT

WINNIPEG TRANSIT DEPARTMENT  
 RAPID TRANSIT GARAGE  
 #600 BRANDON AVENUE  
 WINNIPEG, MANITOBA

As. Built.