


NOTE:

- WELDED GATE FRAMES & GATE HARDWARE PER STANDARD CHAINLINK FENCE CONSTRUCTION.
- FACE GATES WITH 19x140 P.T. BOARDS.
- FINISH TO MATCH ENCLOSURE WALLS.

PLAN
1:50


1 GARBAGE BIN ENCLOSURE
L-401 AS NOTED

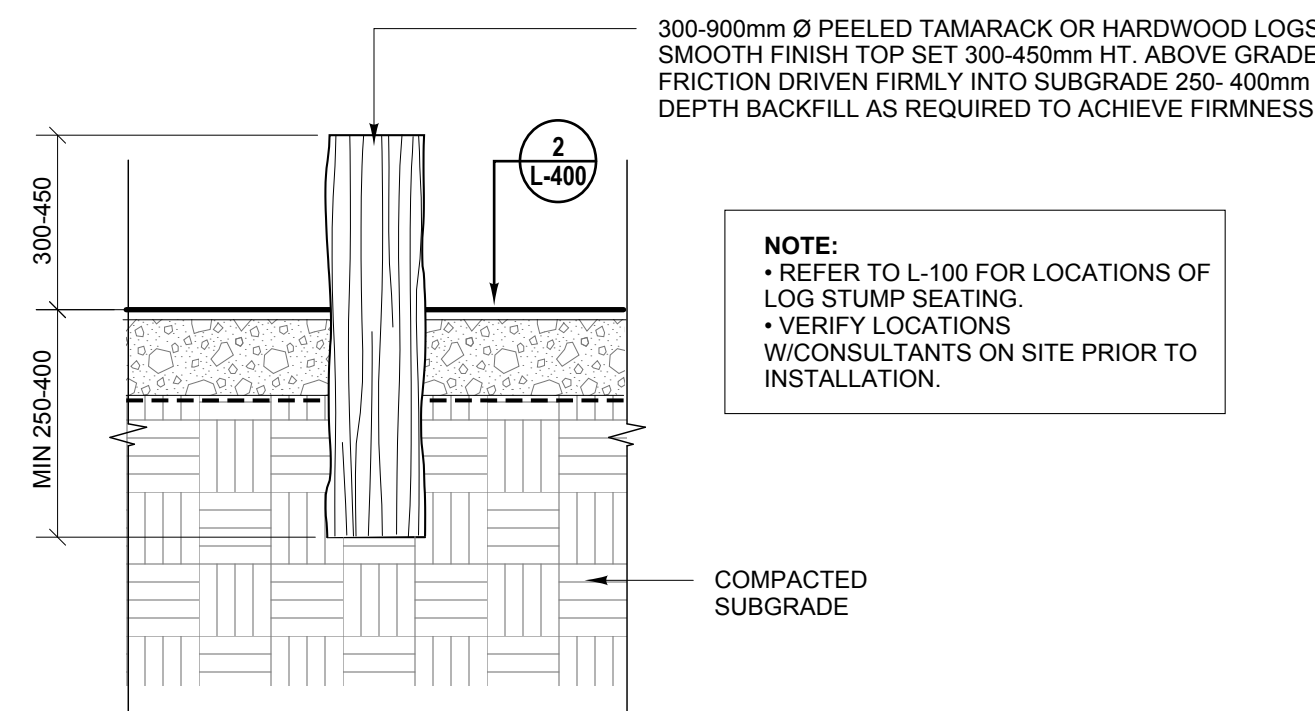

NOTE:


- REFER TO L-100 FOR LOCATIONS OF LOG STUMP SEATING.
- VERIFY LOCATIONS W/CONSULTANTS ON SITE PRIOR TO INSTALLATION.

4 LOG STUMP SEATING
L-401 1:15

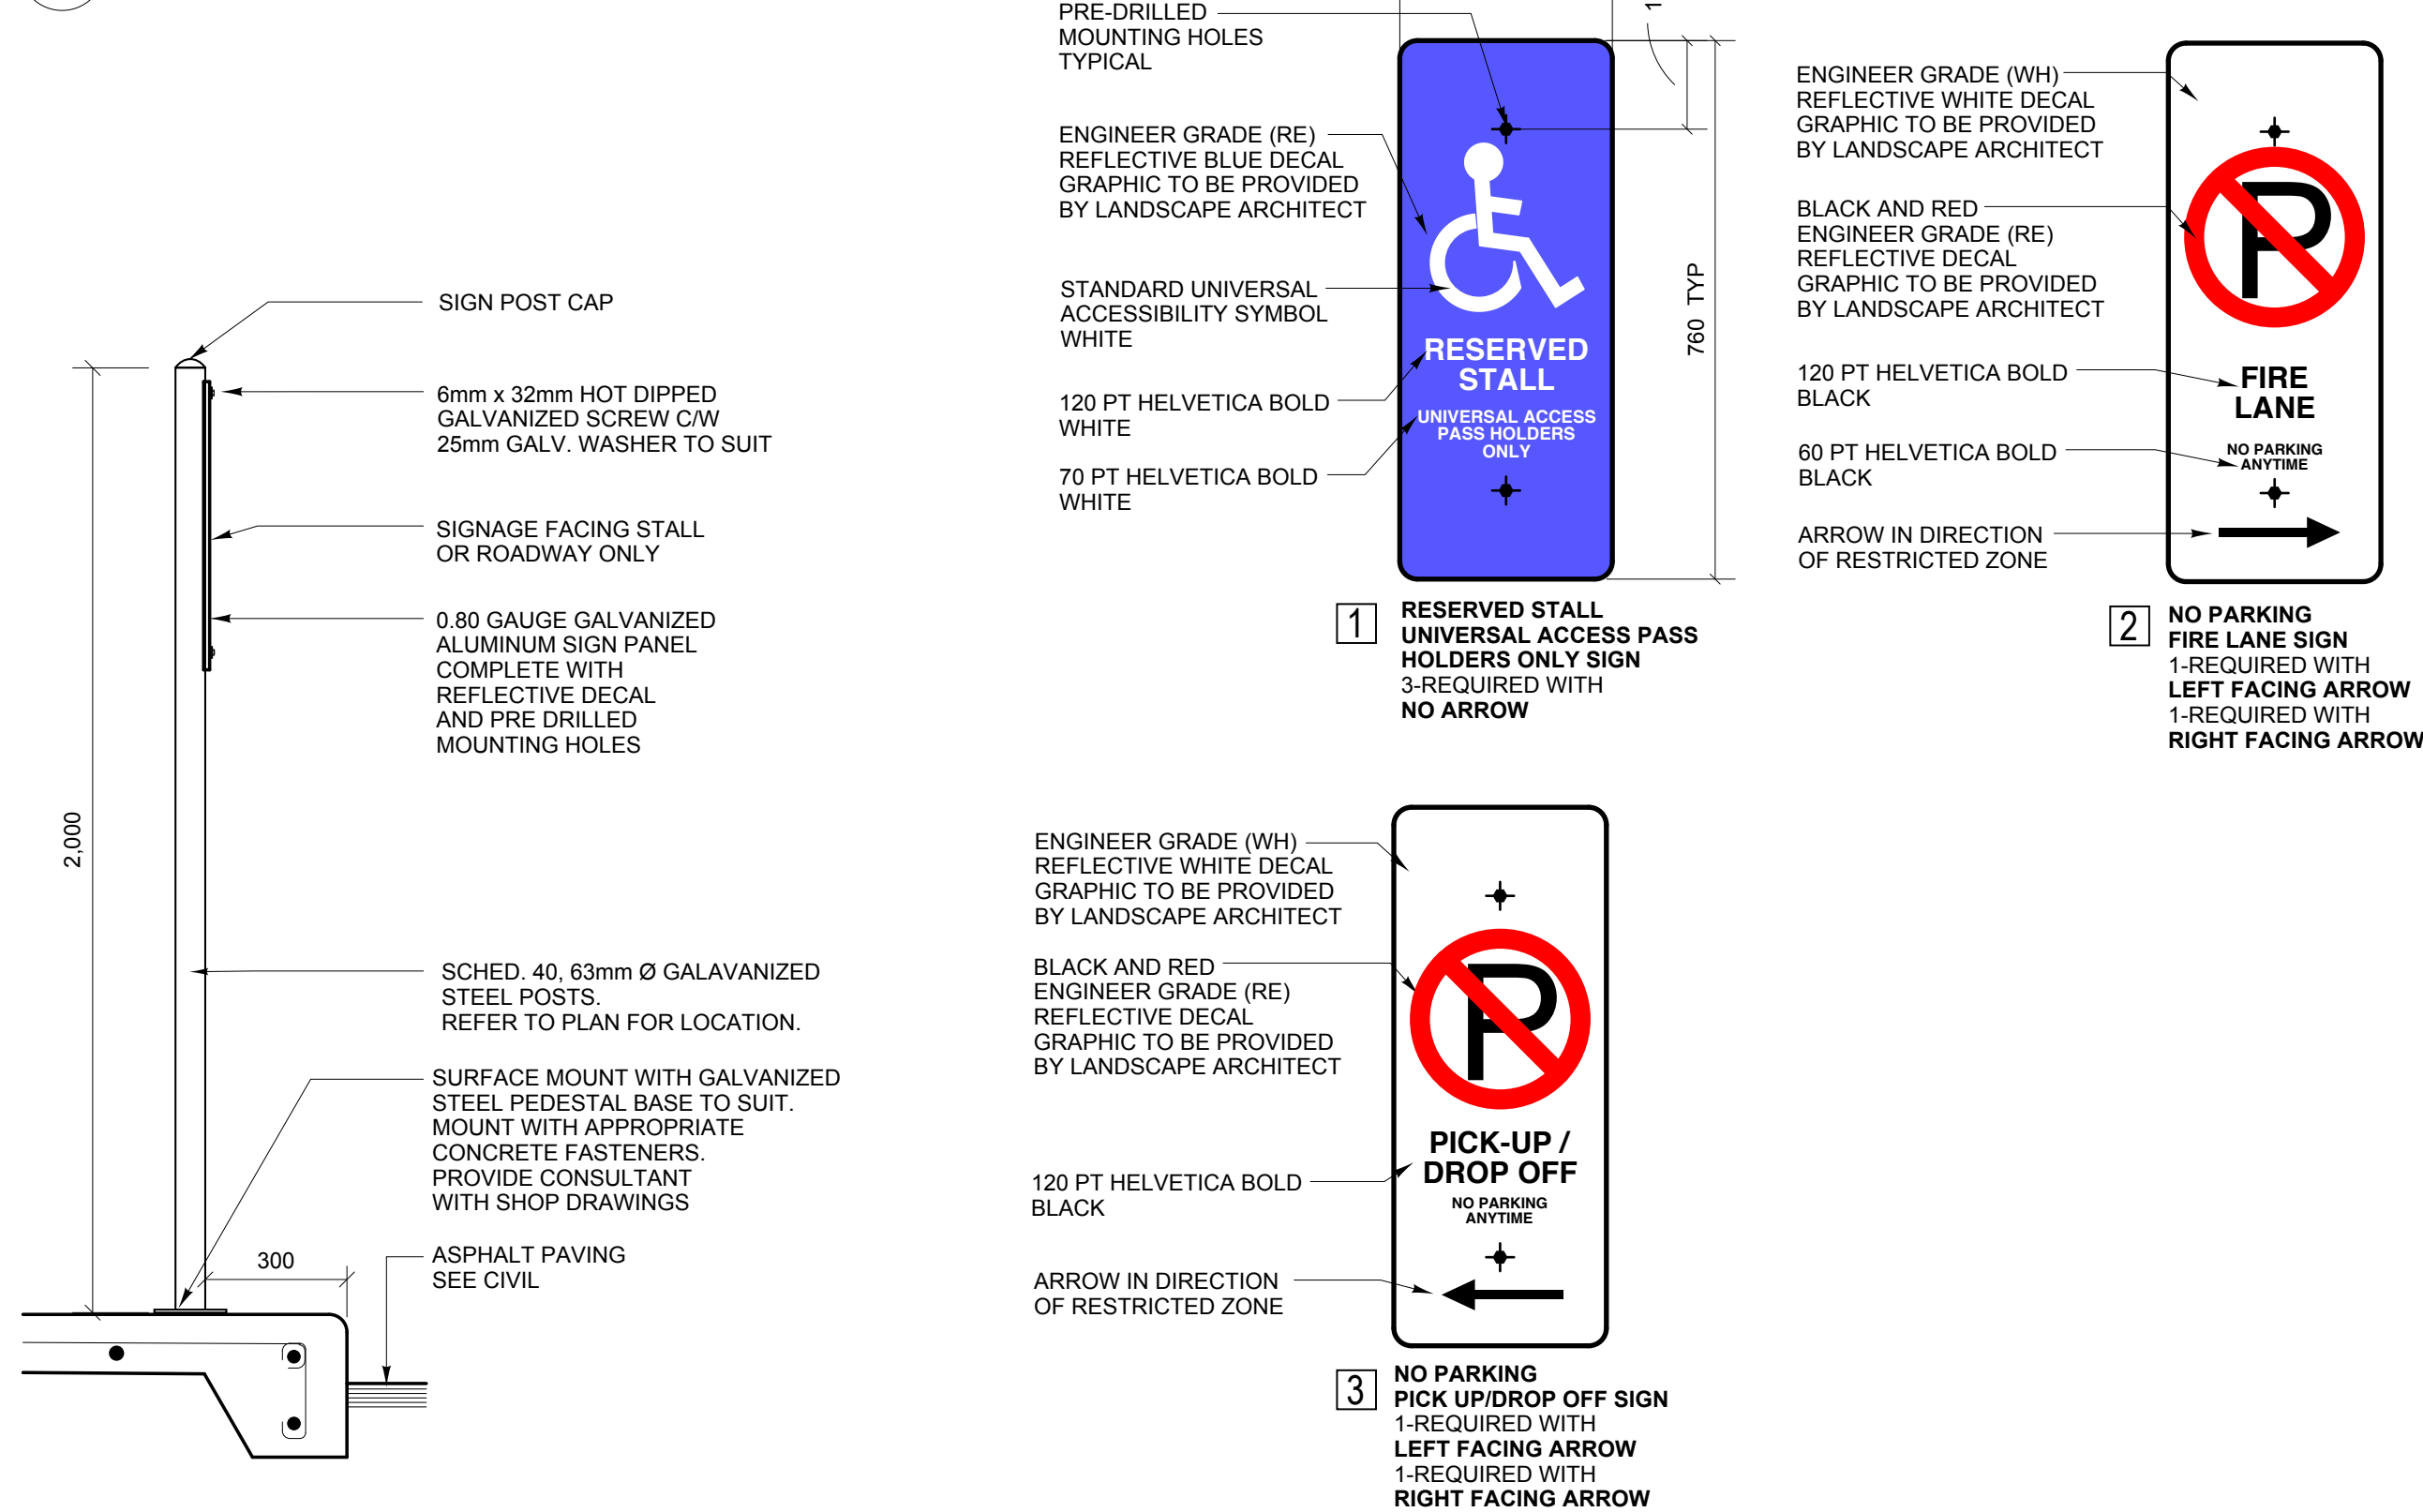


4 TYP. REGULATORY SIGNS SURFACE MOUNTED
L-401 1:15

5 TYP SIGN GRAPHICS
L-401 NTS

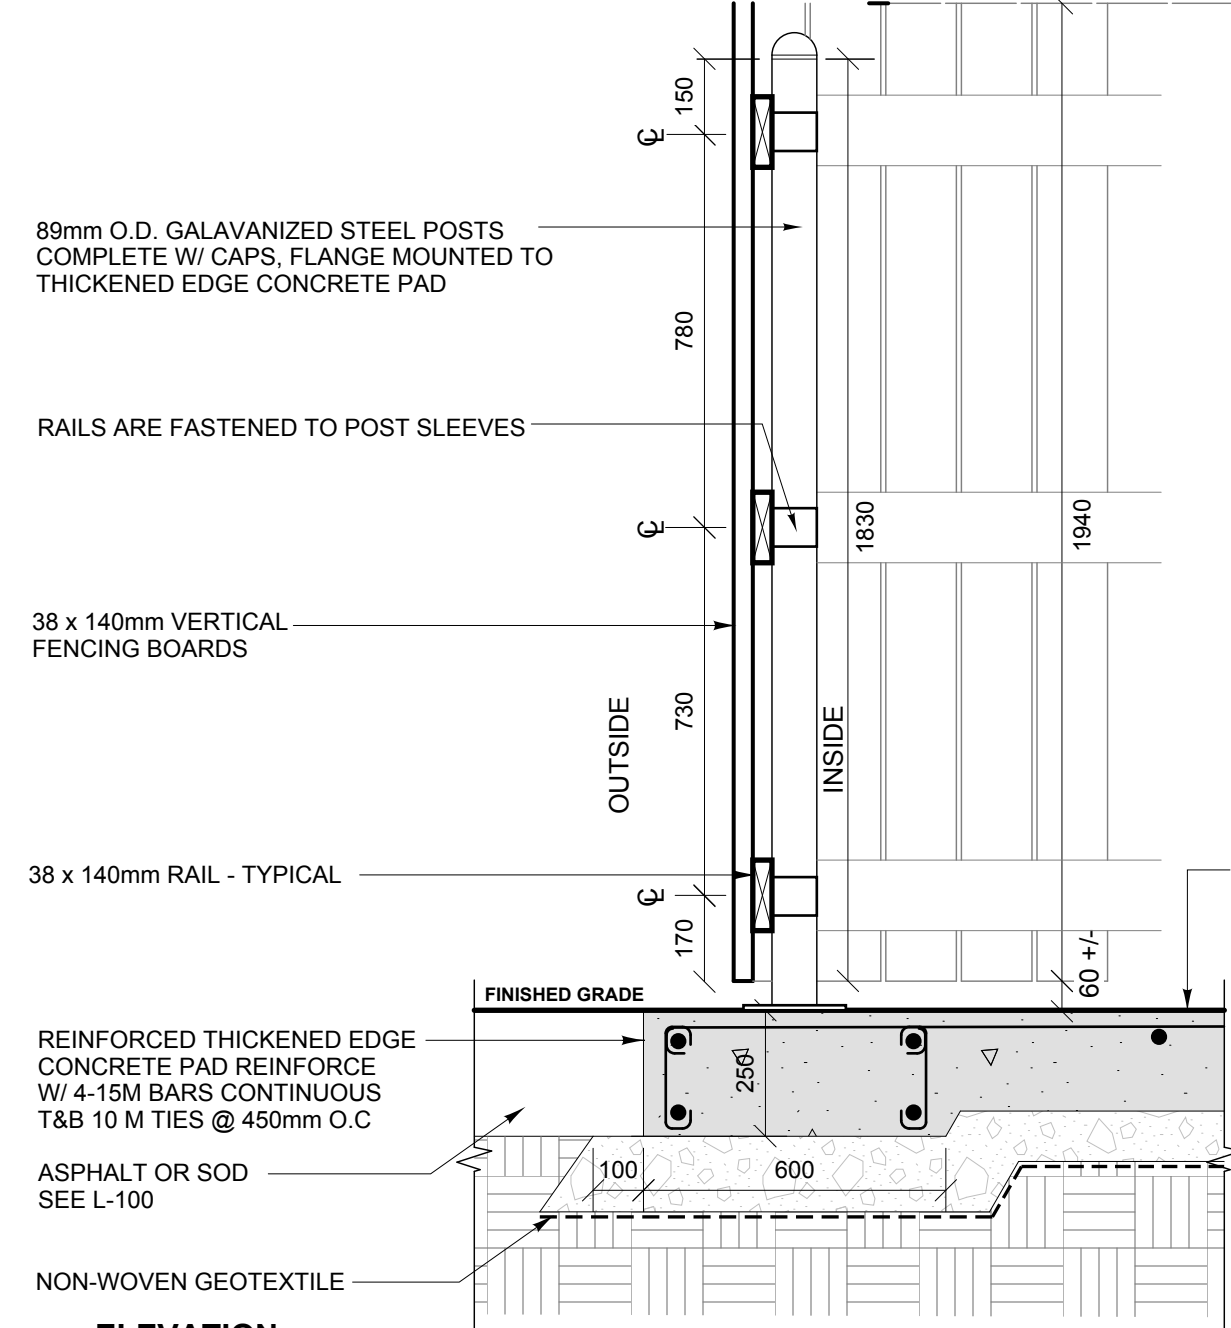

ELEVATION
1:15

2 STEEL BOLLARD
L-401 1:25

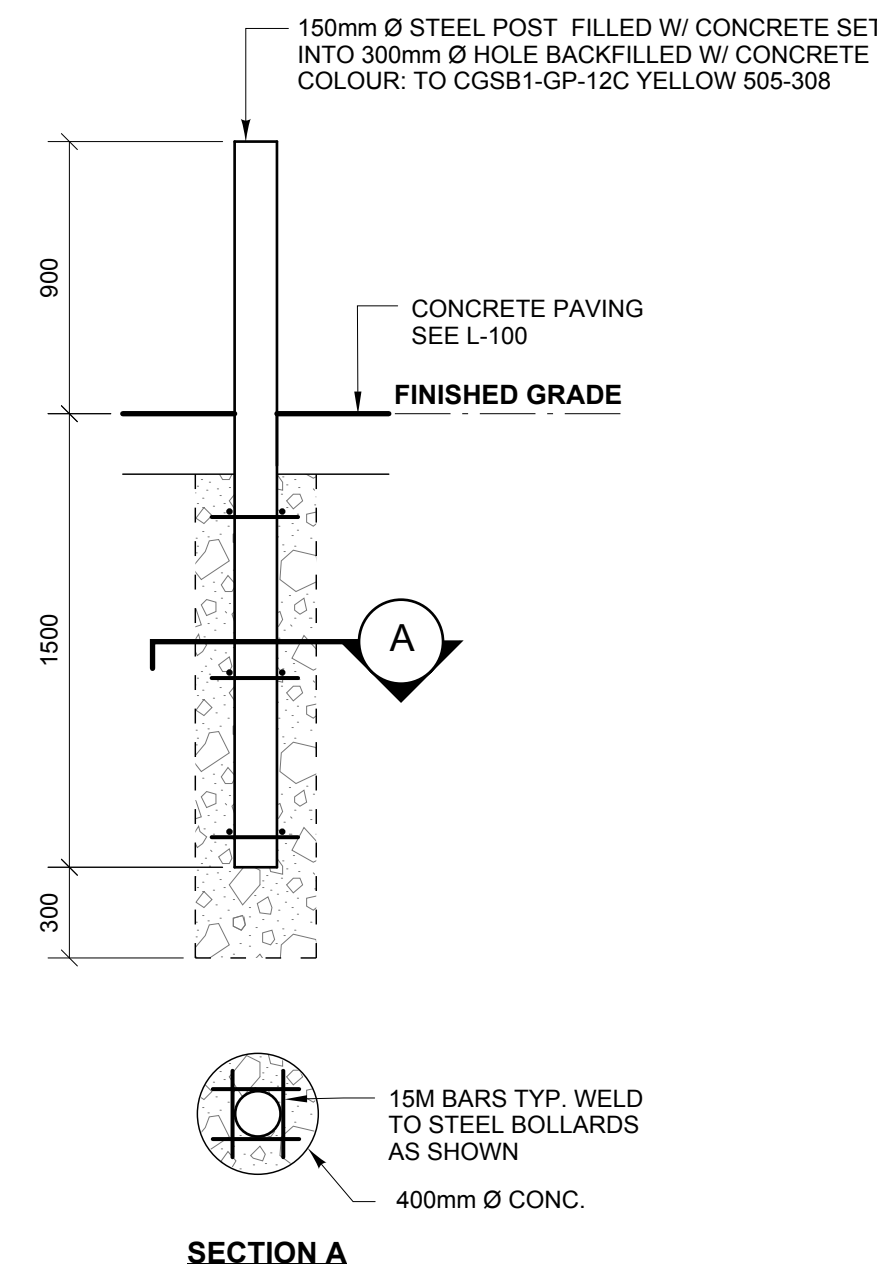

SECTION A


NOTES:

PIPE CURB


- PROVIDE ENGINEER SEALED SHOP DRAWINGS TO CONTRACT ADMINISTRATOR FOR APPROVAL AS SPECIFIED PRIOR TO COMMENCING RAILING & GUARDRAIL FABRICATION.
- ALL STEEL HSS MEMBERS TO BE 350W GRADE.
- ALL MECHANICAL FASTENERS TO BE HOT DIPPED AND GALVANIZED FOR EXTERIOR USE.

METAL FINISHING

- MEMBERS MAY BE SHOP PRIMED PRIOR TO ERECTION.
- AFTER ERECTION, DEBUR AND DEGREASE ALL CONNECTIONS AND WELDED AREAS AND PRIME ALL REMAINING UNPRIMED SURFACES W/ 2 COATS OF ALKYOIL-BASED EXTERIOR PRIMER.
- USING HIGH PRESSURE PAINT SPRAYING EQUIPMENT, APPLY 2 - 3mil. EVEN COATS OF SEMI-GLOSS ENAMEL. BLACK COLOUR.
- TOUCH UP ANY UNCOVERED OR DISTURBED SURFACES BY HAND.

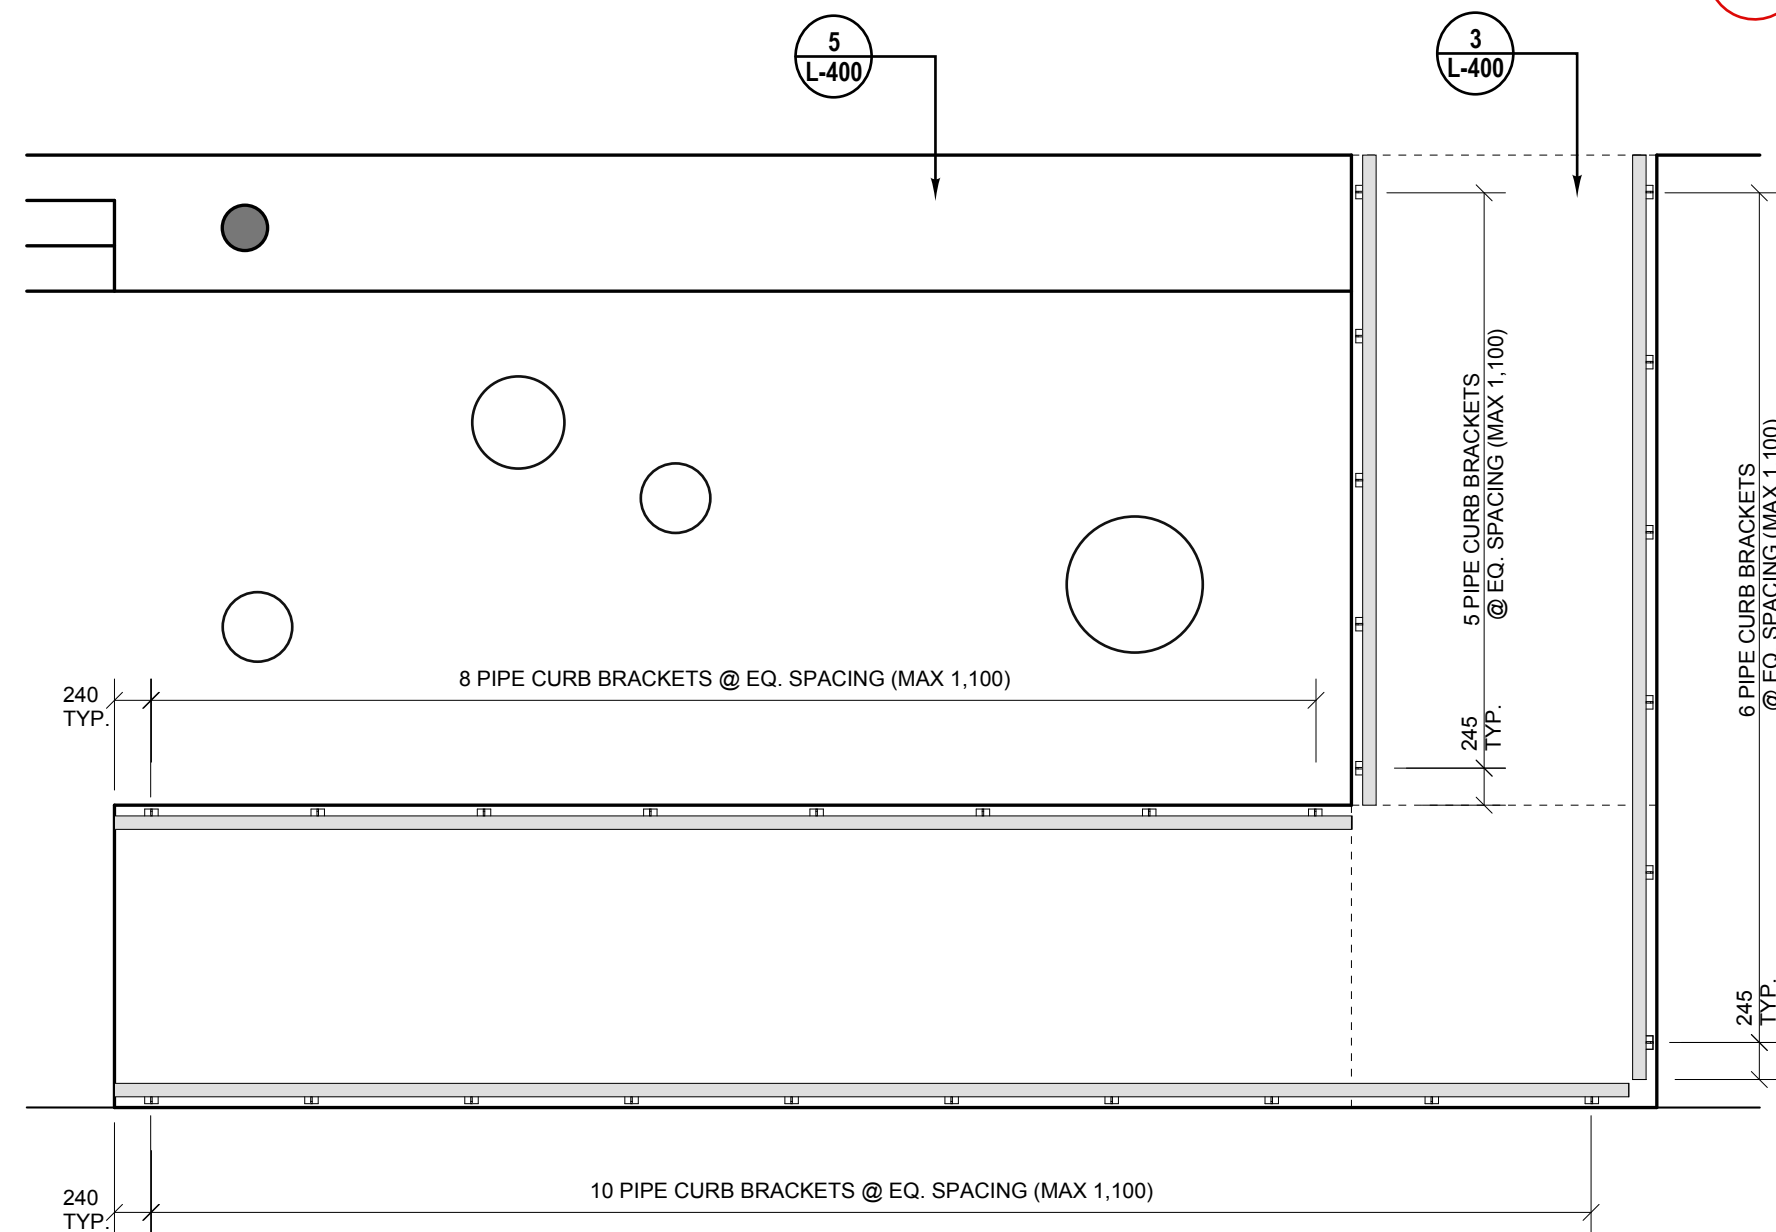


6 STEEL PIPE CURB
L-401 AS SHOWN

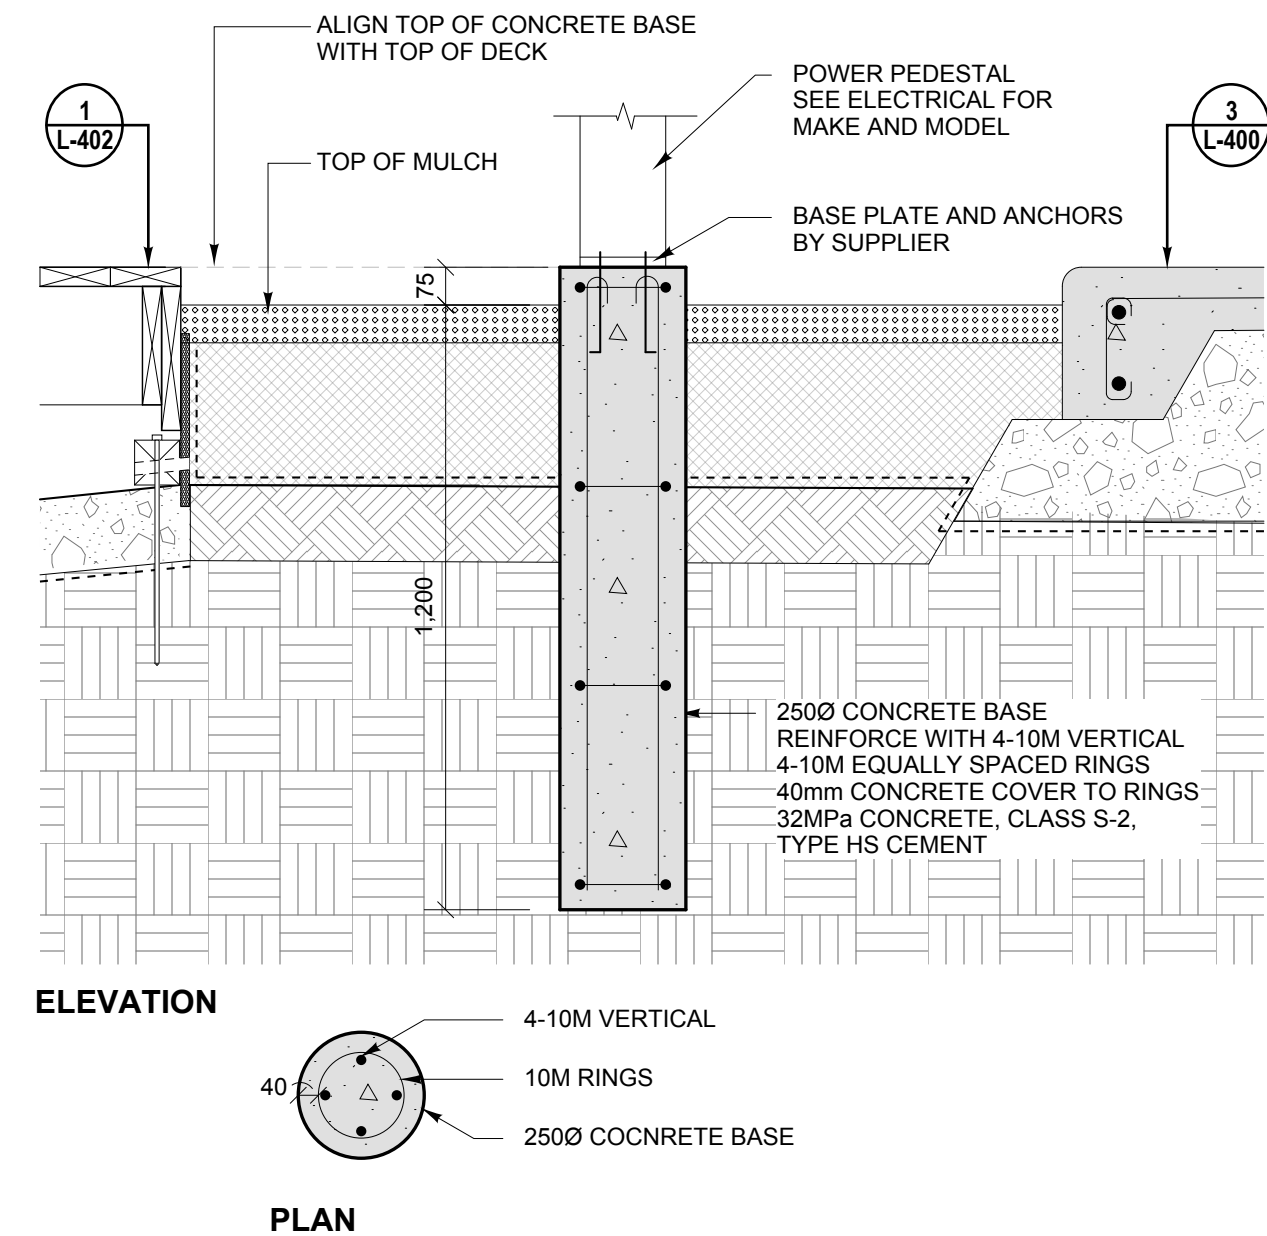


ELEVATION

PLAN

3 POWER PEDESTAL TYP.
L-401 1:15

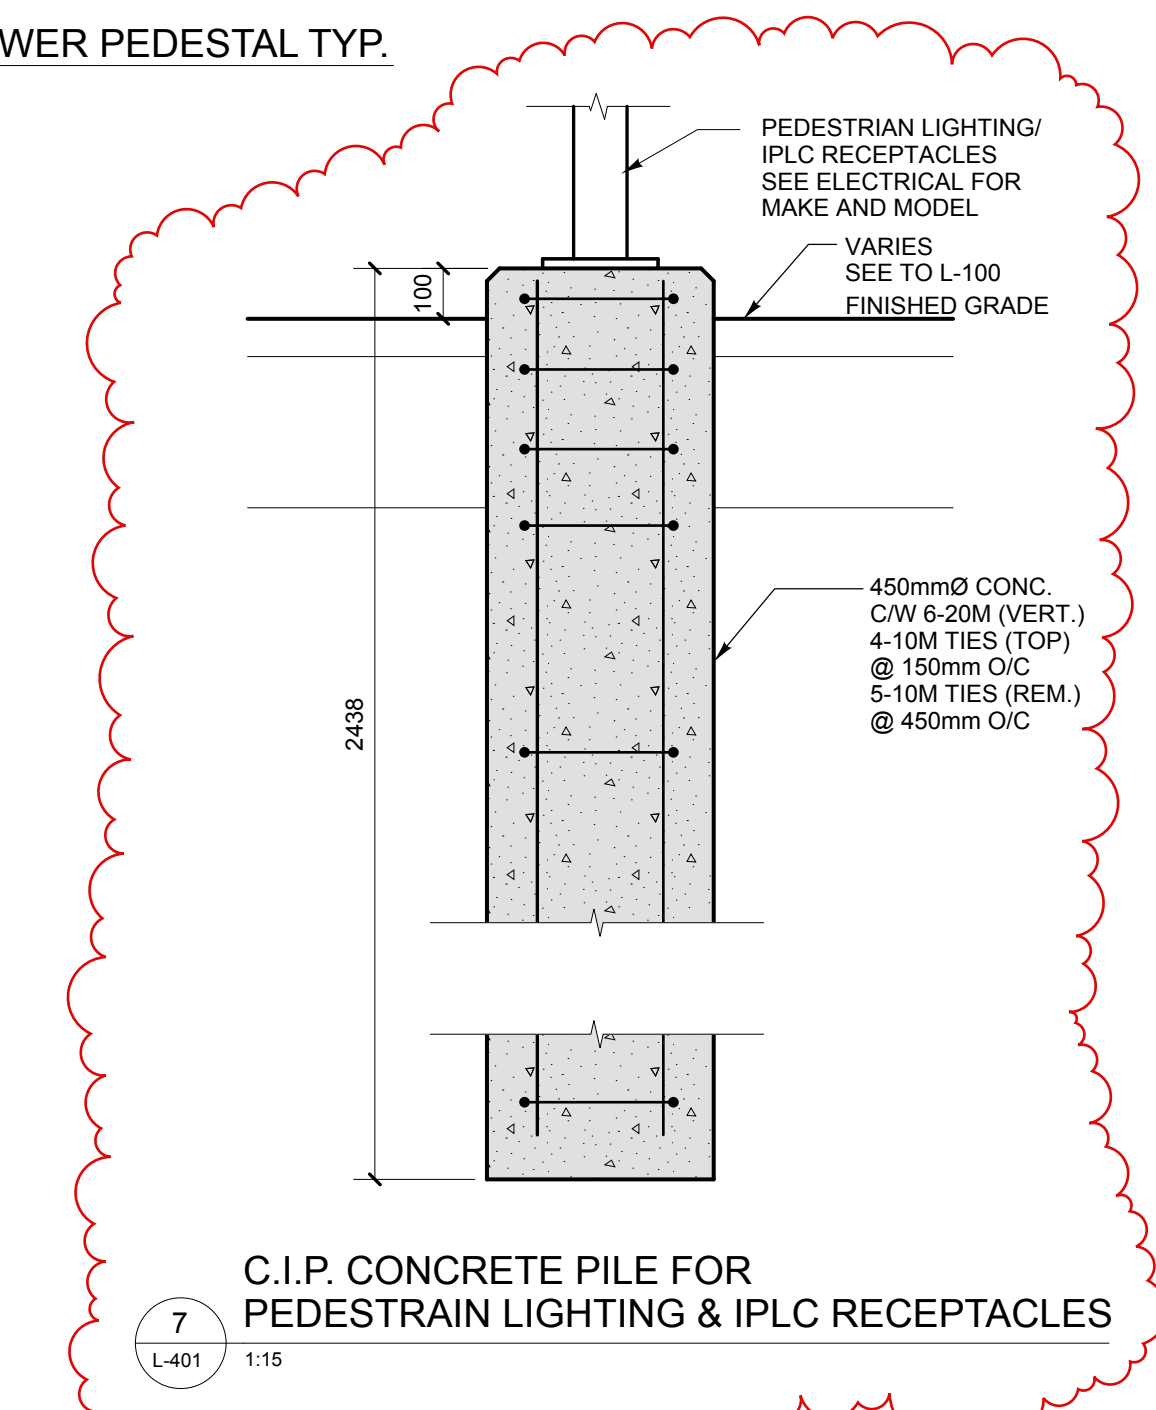

7 C.I.P. CONCRETE PILE FOR PEDESTRAIN LIGHTING & IPLC RECEPTACLES
L-401 1:15

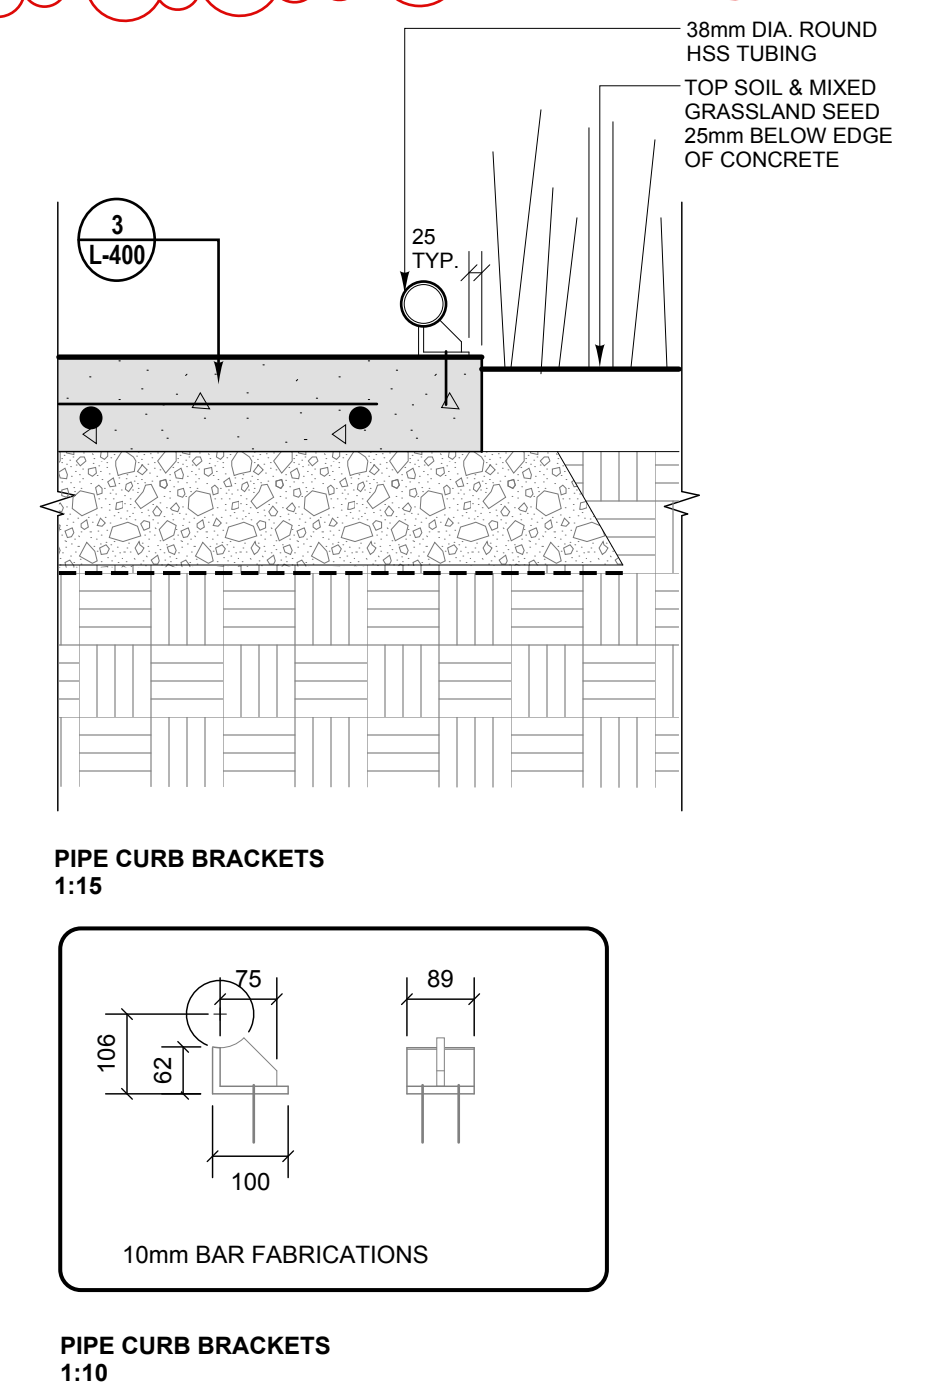


PIPE CURB BRACKETS
1:15

PIPE CURB BRACKETS
1:10

No.	DATE	REVISION / ISSUANCE
4	2017.03.14	Issued for Addenda No. 2
3	2017.03.10	Issued for Addenda No. 1
2	2017.02.17	Issued for Construction

No. DATE REVISION / ISSUANCE

Seal

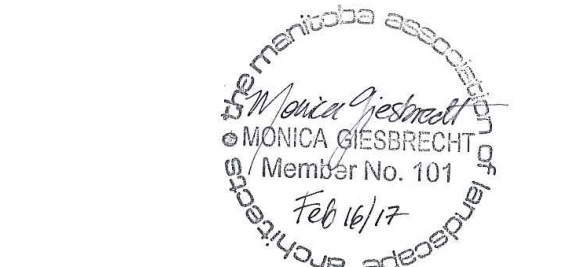

Architect

Cibinel
Architecture Ltd

560 ACADEMY ROAD WINNIPEG, MB R3L 0E3
T. 204.989.8910 F. 204.989.8920



TRANSCONA LIBRARY
1500 PLESSIS ROAD, WINNIPEG, MB

Sheet Title
SITE DETAILS - 2

Project No. Sheet

1487 **L-401**