


BOILER ROOM PLUMBING

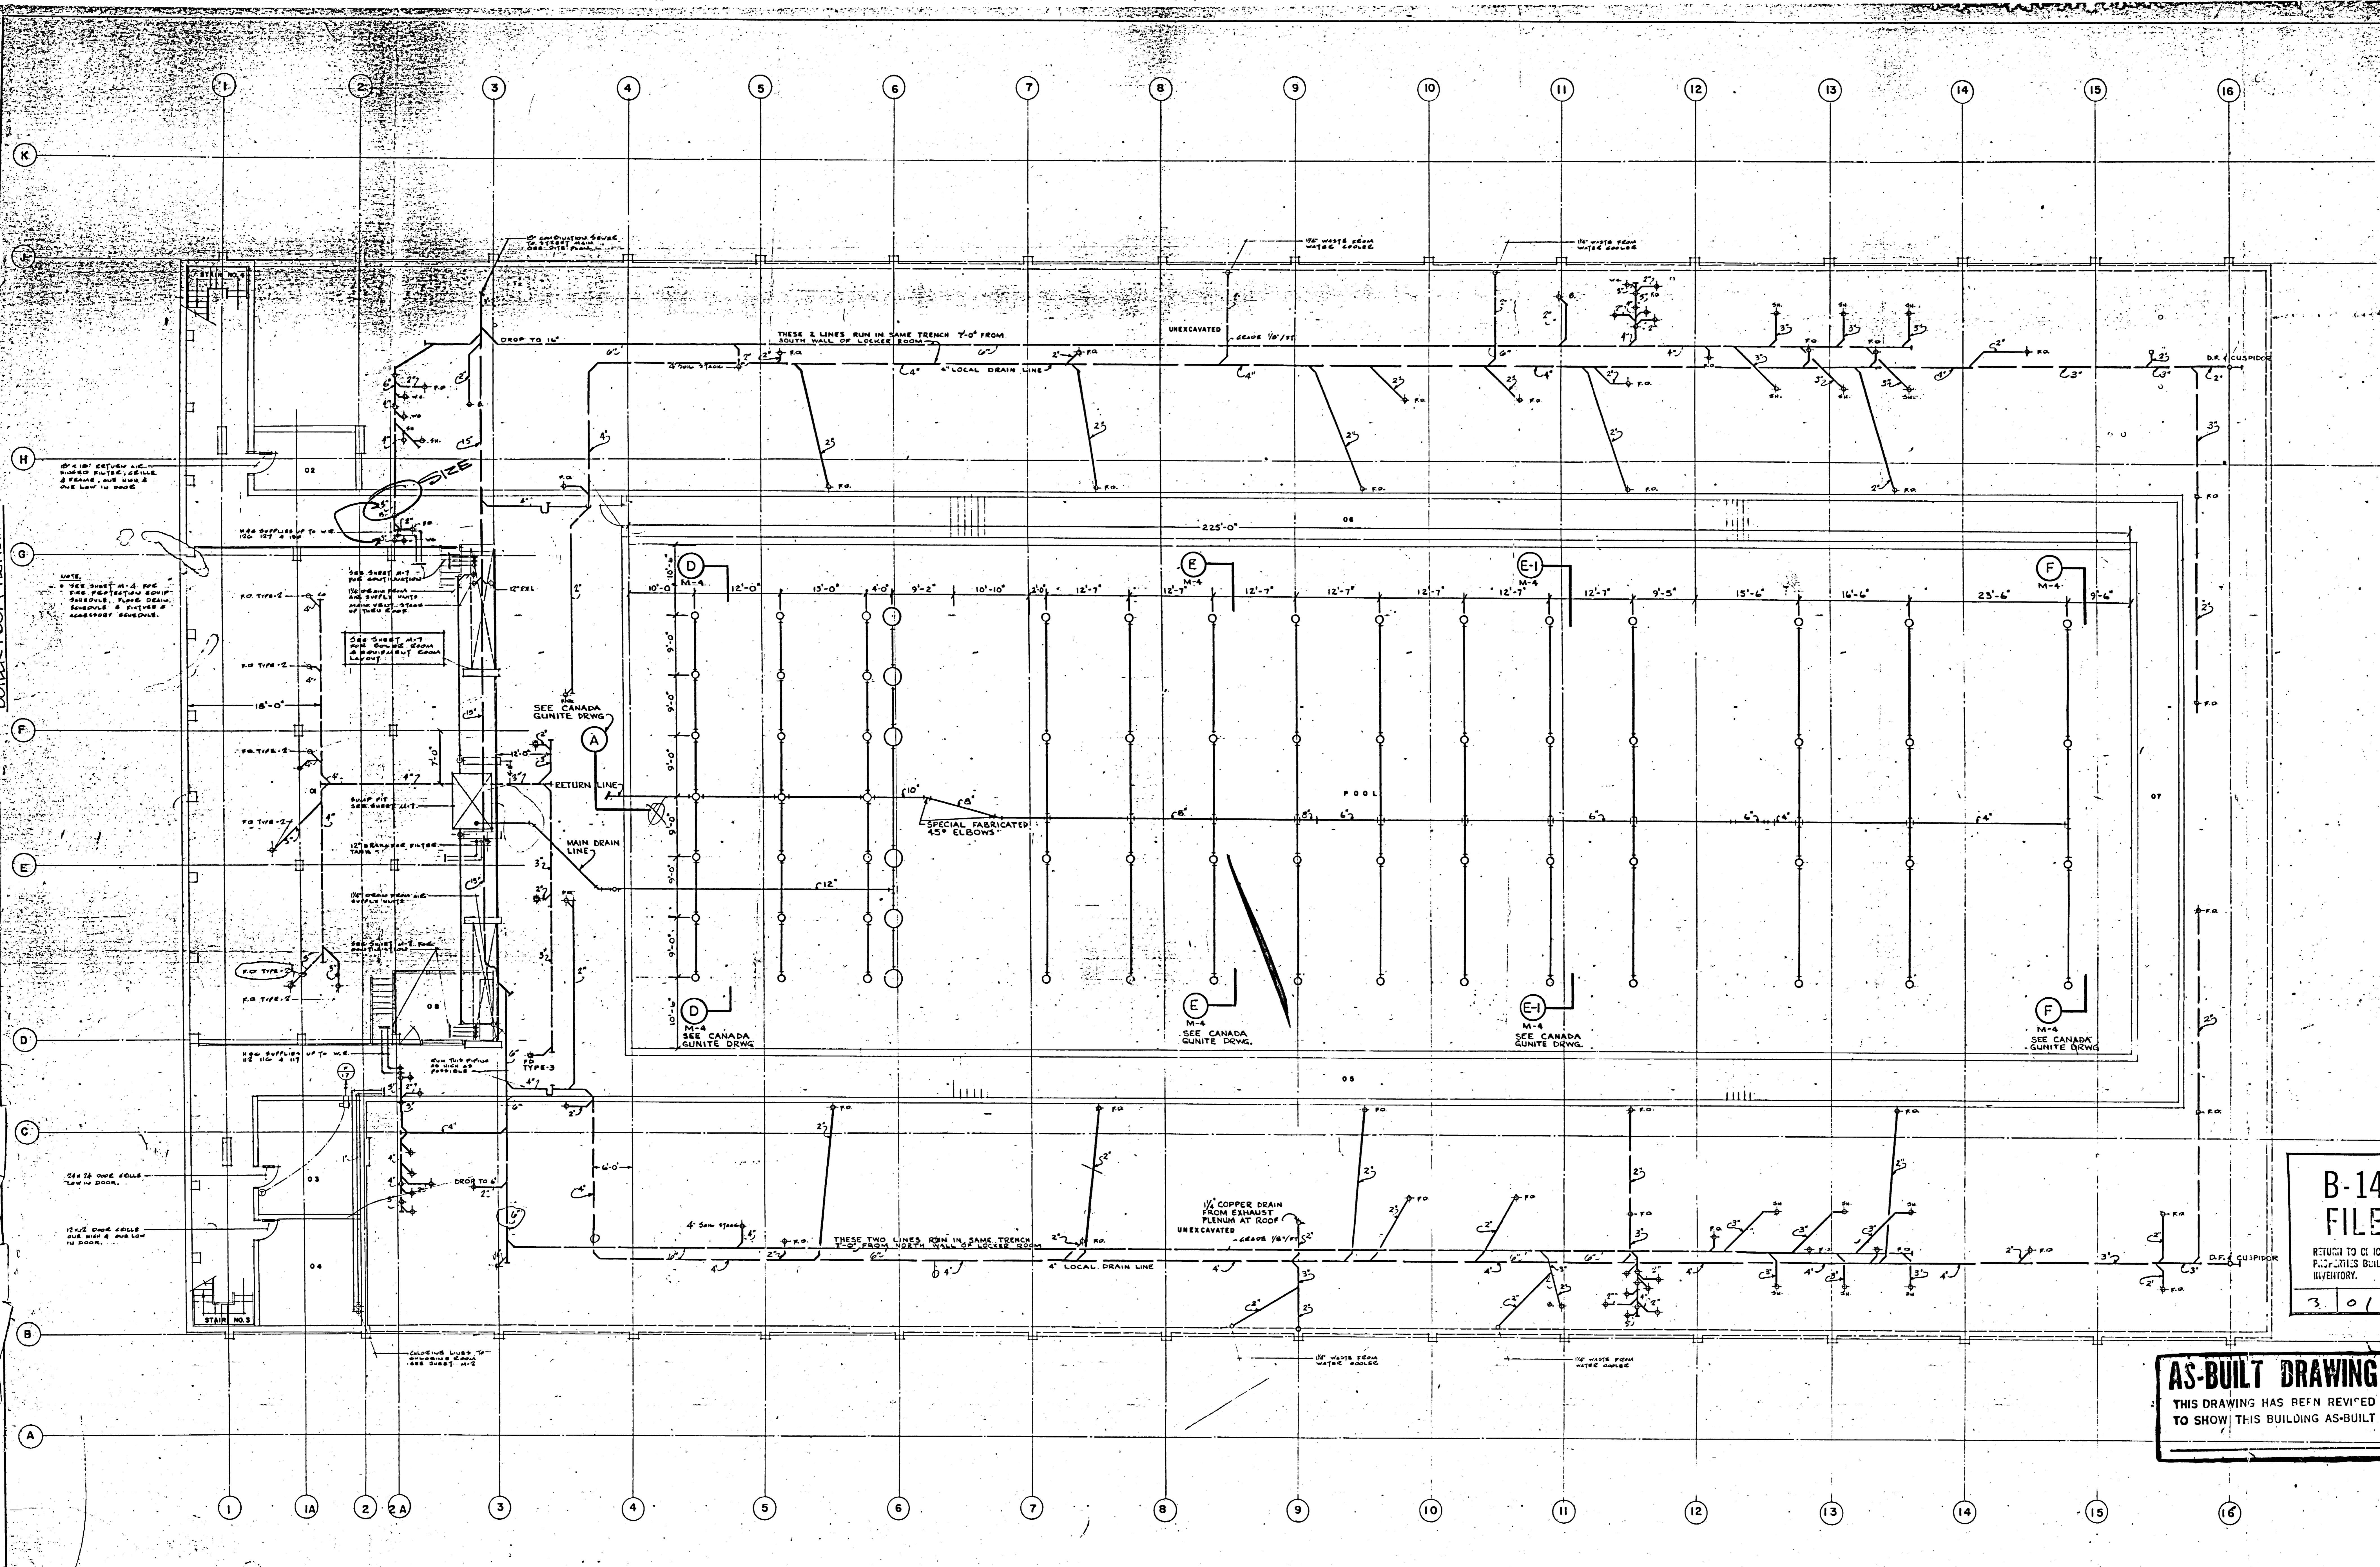

SYMBOLS

[Symbol]	COLD WATER
[Symbol]	HOT WATER
[Symbol]	RECIRCULATING WATER
[Symbol]	HOT WATER @ 180°
[Symbol]	SOIL & WASTE (ABOVE SLAB OR GRADE)
[Symbol]	SOIL & WASTE (BELOW SLAB OR GRADE)
[Symbol]	VENT LINE
[Symbol]	RAIN WATER (ABOVE SLAB OR GRADE)
[Symbol]	RAIN WATER (BELOW SLAB OR GRADE)
[Symbol]	FIRE LINE
[Symbol]	RAB LINE
[Symbol]	FORCED HOT WATER SUPPLY
[Symbol]	FORCED HOT WATER RETURN
[Symbol]	ANCHOR
[Symbol]	PUMP DISCHARGE
[Symbol]	EXPANSION JOINT
[Symbol]	CHECK VALVE
[Symbol]	RATE VALVE
[Symbol]	GLOBE VALVE
[Symbol]	SQUARE HEADED BALANCING COCK
[Symbol]	STRAINER
[Symbol]	UNION
[Symbol]	PRESSURE REDUCING VALVE
[Symbol]	CONTROL VALVE
[Symbol]	THREE-WAY VALVE
[Symbol]	CLEANOUT
[Symbol]	RISER (DOWN)
[Symbol]	RISER (UP)
[Symbol]	ANCHOR
[Symbol]	FLOOR DRAIN
[Symbol]	FIRE HOSE CABINET
[Symbol]	THERMOSTAT
[Symbol]	RELIEF VALVE
[Symbol]	AUTO AIR VENT
[Symbol]	PRESSURE GAUGE
[Symbol]	AQUASTAT
[Symbol]	AUTO BACK DRAFT DAMPER
[Symbol]	MOTORIZED DAMPERS
[Symbol]	FIRE DAMPERS
[Symbol]	DOOR GRILLE
[Symbol]	SUPPLY REGISTER
[Symbol]	RETURN REGISTER

REVISIONS

NO.	REF.	DESCRIPTION	DATE	BY

DRAWN BY
T.K.C. RB

CHECKED BY
[Signature]

DATE

PROVINCE OF MANITOBA
REGISTERED ENGINEER
G. H. CURRIE

PROVINCE OF MANITOBA
REGISTERED ARCHITECTS
SMITH CARTER SEARLE

SMITH CARTER SEARLE ASSOCIATES
ARCHITECTS AND CONSULTING ENGINEERS
WINNIPEG BRANDON PORT ARTHUR TORONTO

B-14 FILE

RETURN TO C-10
PROPERTY BUILDING
INVENTORY

3 0 1 6

AS-BUILT DRAWING

THIS DRAWING HAS BEEN REVISED
TO SHOW THIS BUILDING AS-BUILT



PAN-AMERICAN GAMES
SWIMMING FACILITY
WINNIPEG, MANITOBA

BOILER ROOM LEVEL
PLUMBING LAYOUT

SCALE
1/8" = 1'-0"

FILE NUMBER
65080

SHEET NUMBER
M-1