


25. DISCIPLIN BAL
 00000
 001-2A
 PROJECT NO.
 P.A.S. INC. LTD.
 CONSULTING

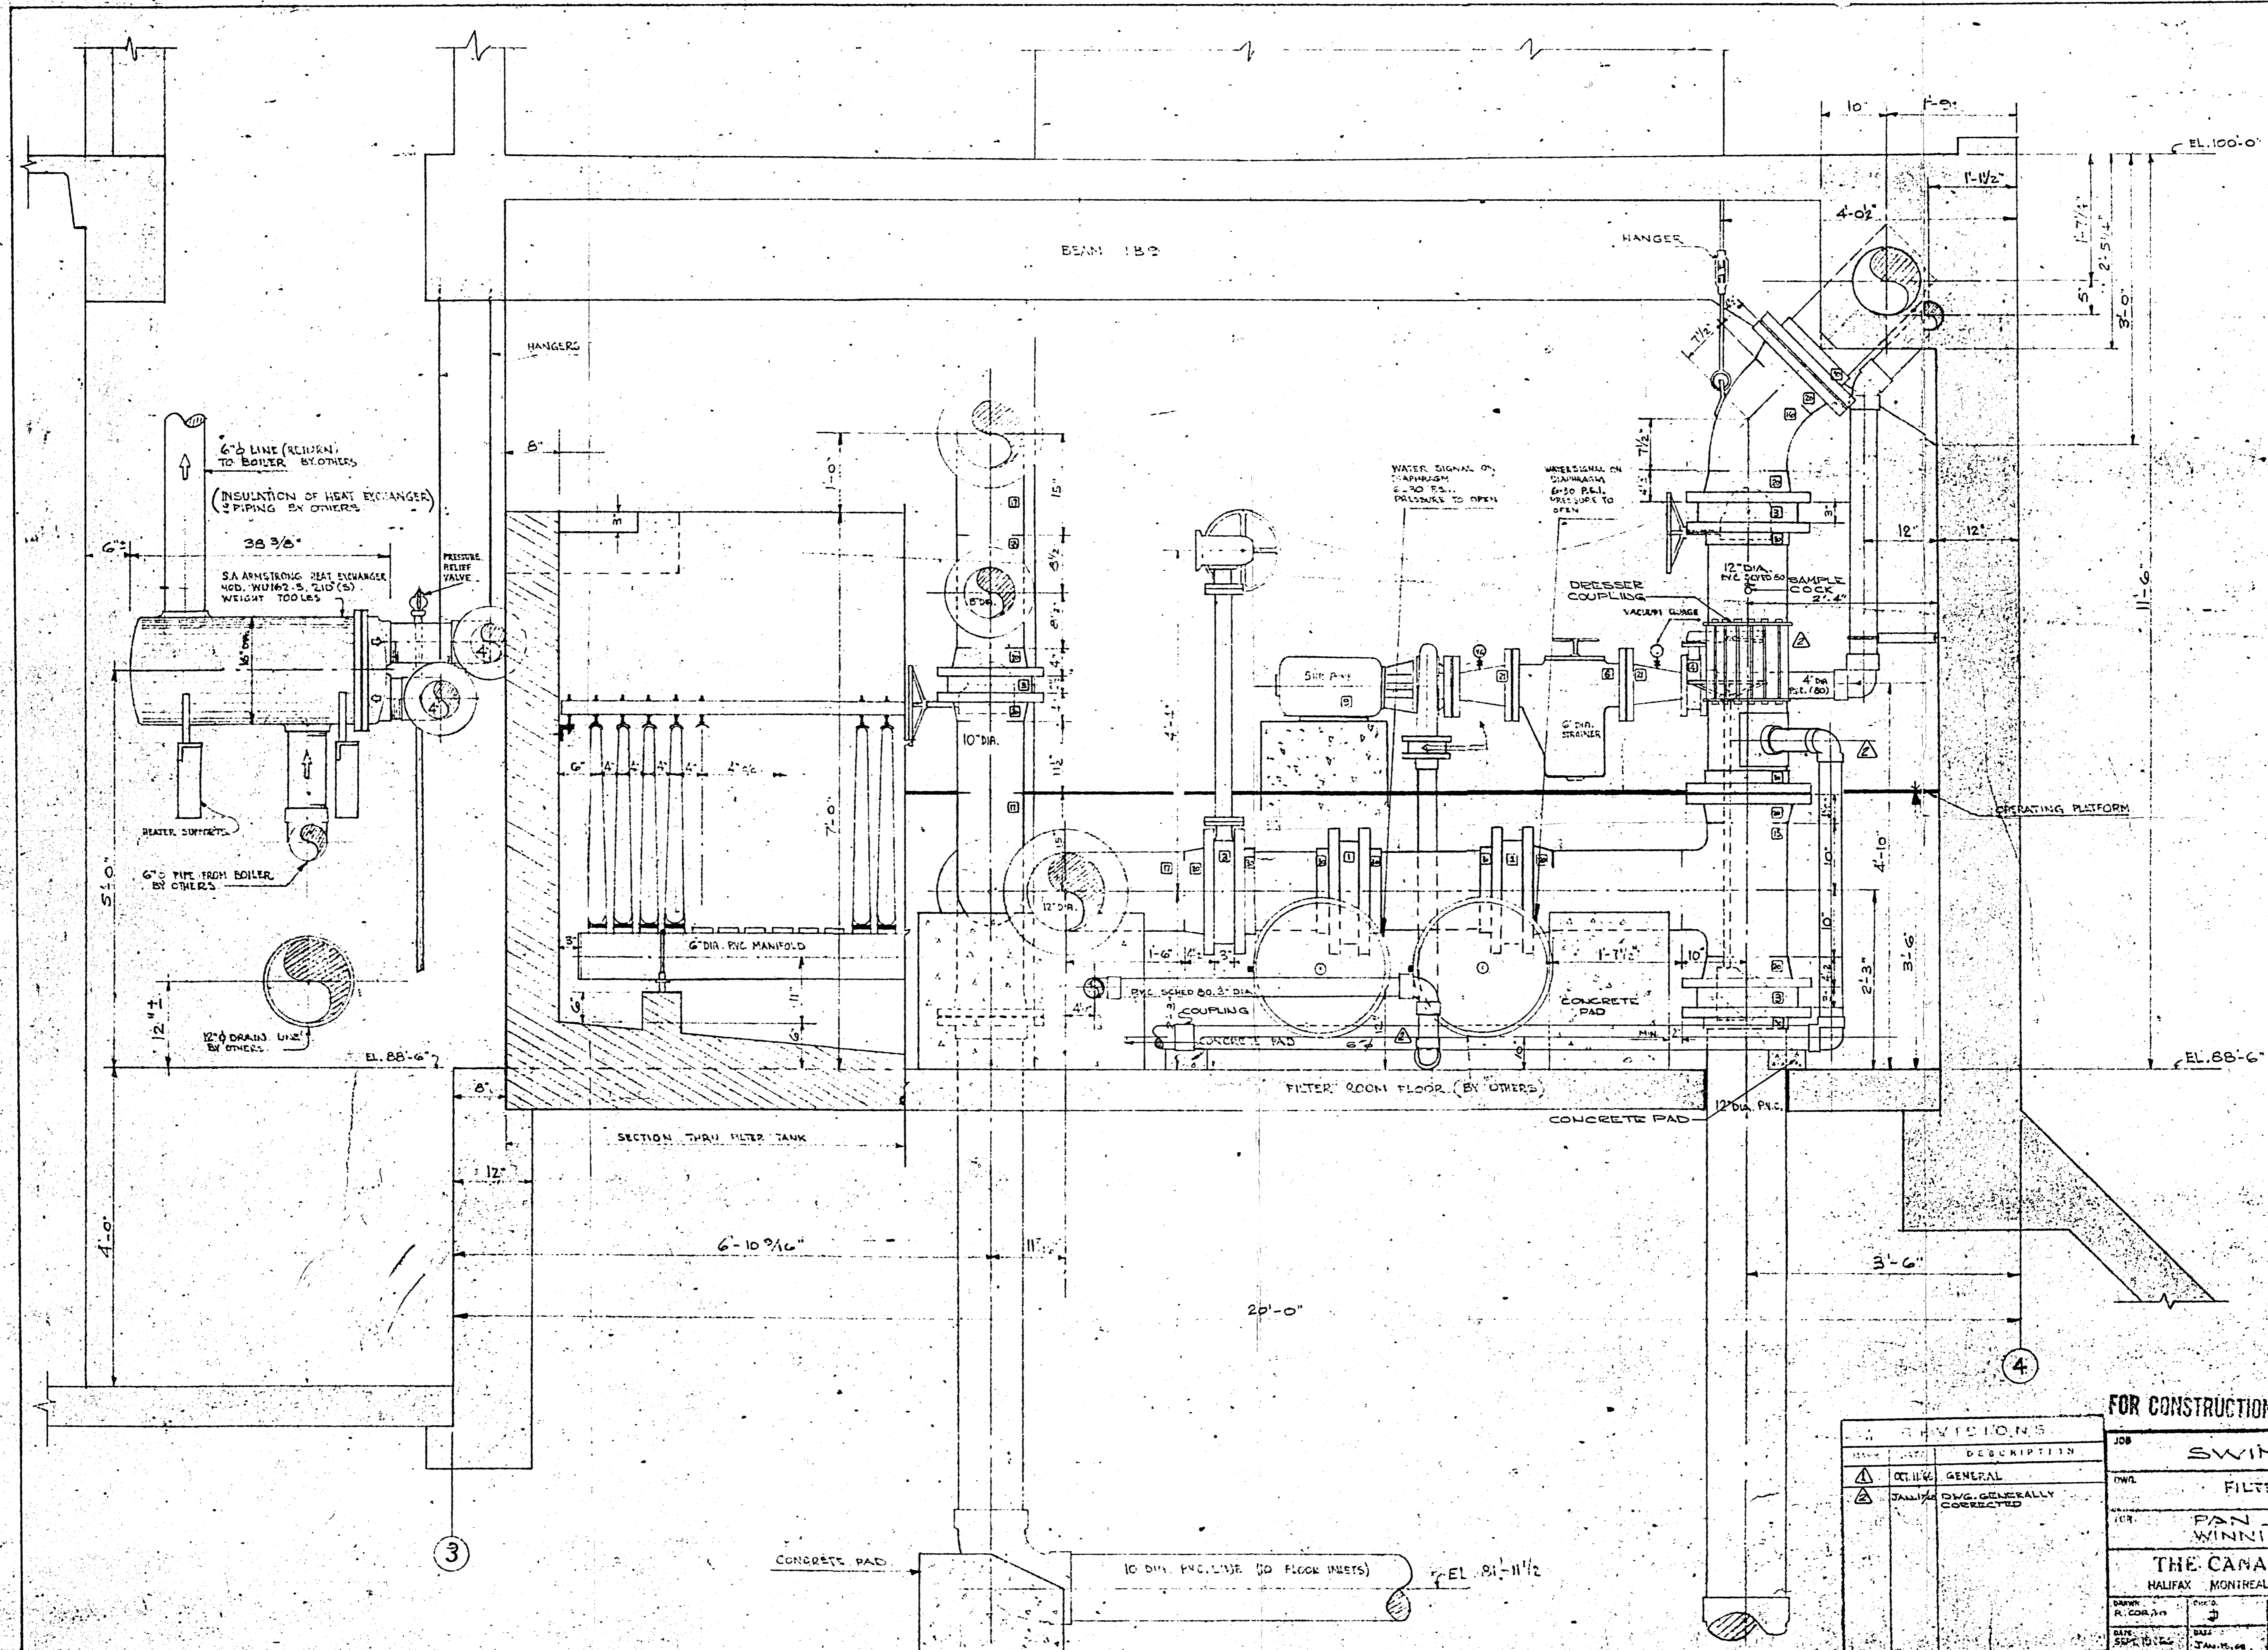

| LEGEND | |
|----------|--|
| REF. NO. | DESCRIPTION |
| 1 | KEYSTONE VALVE, DIAG. ACTUATOR, 1/2" PRESSURE ON DIAPHR. |
| 2 | KEYSTONE VALVE, DIAG. ACTUATOR, WATER PRESSURE ON DIAPHR. |
| 3 | KEYSTONE VALVE, GATE STOPCOCK, 1/2" DIA. |
| 4 | KEYSTONE VALVE, FIG. 100, WITH GRIPPER HANDLE |
| 5 | KEYSTONE VALVE, SWING CHECK, FIG. 250 |
| 6 | HAYWARD FIG. 50, 1/2" DIA. # 340 |
| 7 | |
| 8 | |
| 9 | WILCOX P.M. SPINACE PUMP (RETRORAM) MOD. 10, 1/2" DIA. # 340 |
| 10 | |
| 11 | |
| 12 | |
| 13 | |
| 14 | |
| 15 | GENMILL STRAIGHT TEE, STD. FIG. 1761 |
| 16 | LONG PLE. 45° L. STD. FIG. 1771 |
| 17 | LONG PLE. 90° L. STD. FIG. 1701 |
| 18 | RED. TEE, STD. FIG. 1765 |
| 19 | |
| 20 | WEL. NICH. 150° PLE. FIG. 1811 |
| 21 | CL. FIG. 125, STD. FIG. 1765 |
| 22 | |
| 23 | |
| 24 | |
| 25 | |
| 26 | |
| 27 | |
| 28 | |
| 29 | |
| 30 | PVC SOCKET FLANGES |

| REVISIONS | |
|-----------|--------------------------|
| NO. | DESCRIPTION |
| 1 | GENERAL |
| 2 | DWG. GENERALLY CORRECTED |

FOR CONSTRUCTION

JOB: SWIMMING POOL
 ROOM: FILTER ROOM
 FIRM: FAN - AMERICAN WINNIPEG - MAN.
 THE CANADA GUNITE CO. LTD.
 HALIFAX MONTREAL BURLINGTON WINNIPEG CALGARY

| | | | |
|--------------------|----------------------|-------------------|--------------------|
| DRAWN: R. COLEMAN | CHECKED: J. H. BROWN | SCALE: 1" = 1'-0" | DATE: JAN 15, 1964 |
| DATE: JAN 15, 1964 | DATE: JAN 15, 1964 | 239 | M-24 |