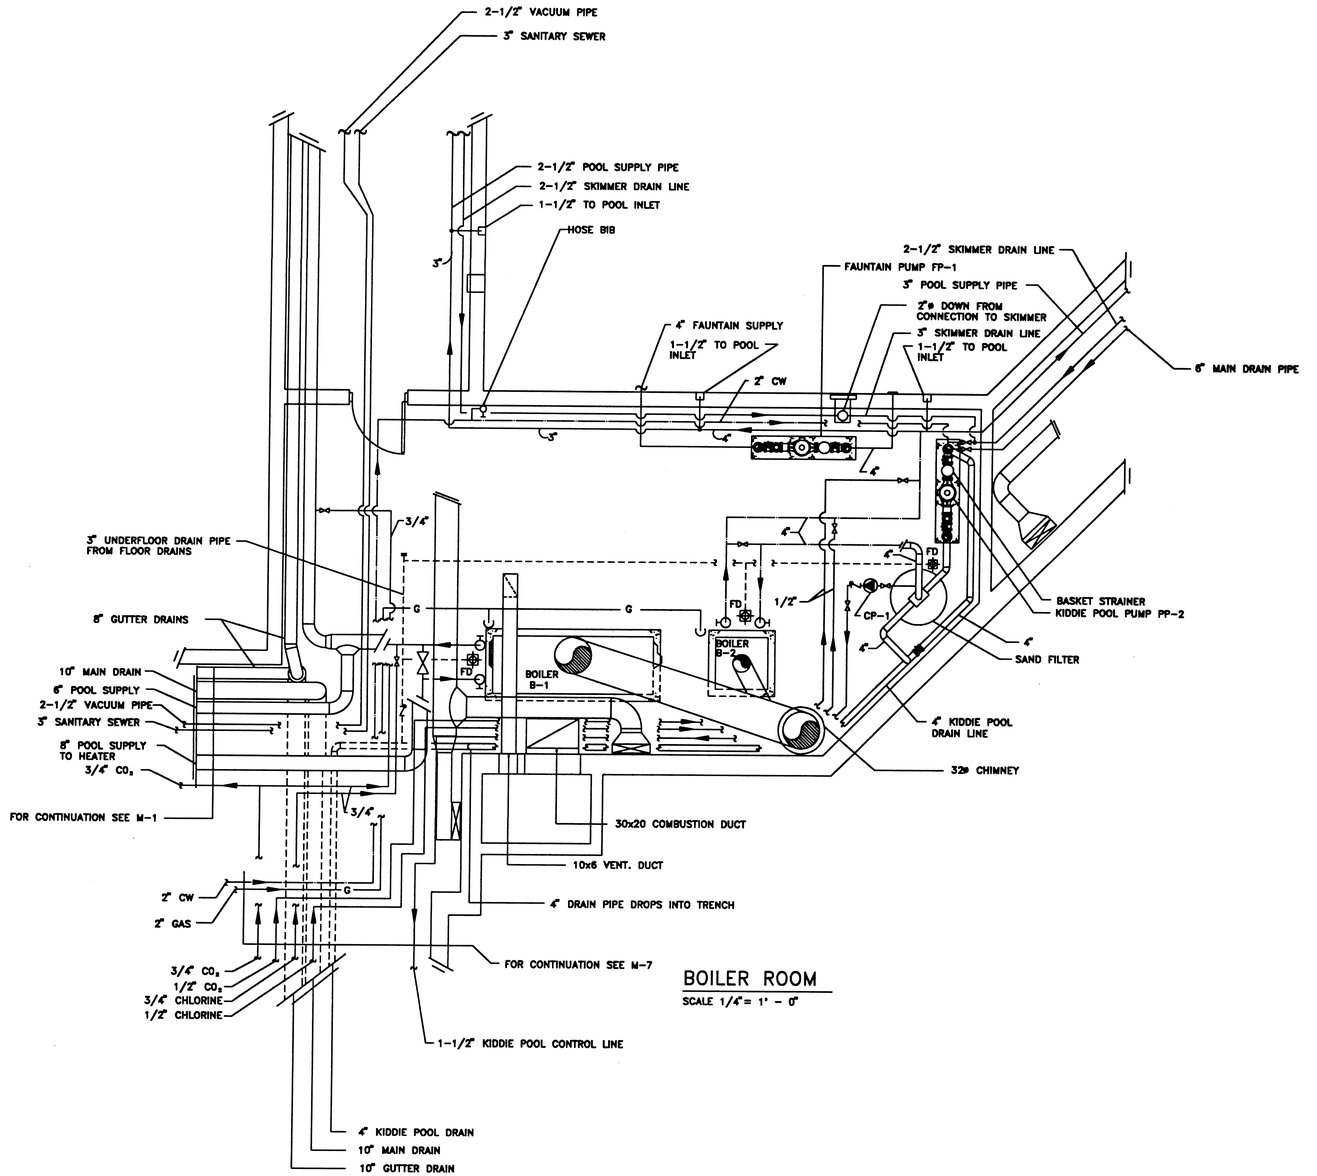

BOILER ROOM

SCALE 1/4"= 1' - 0"

MECH.

AS BUILT

SWIM MANITOBA

PAN AM POOL ADDITION

SEG ENGINEERING INC.

FARACI ENGINEERING LTD.

JOB #	83011
DATE	JULY,23 1983
DRAWN BY	M.L.
CHKD BY	E.J.F.

SHEET TITLE: BOILER ROOM AND MECHANICAL DETAILS

SCALE AS NOTED

CAD FILE A83L7M5

SHT No. M-5.1