


SEATING LEVEL MECHANICAL PRESS BOX

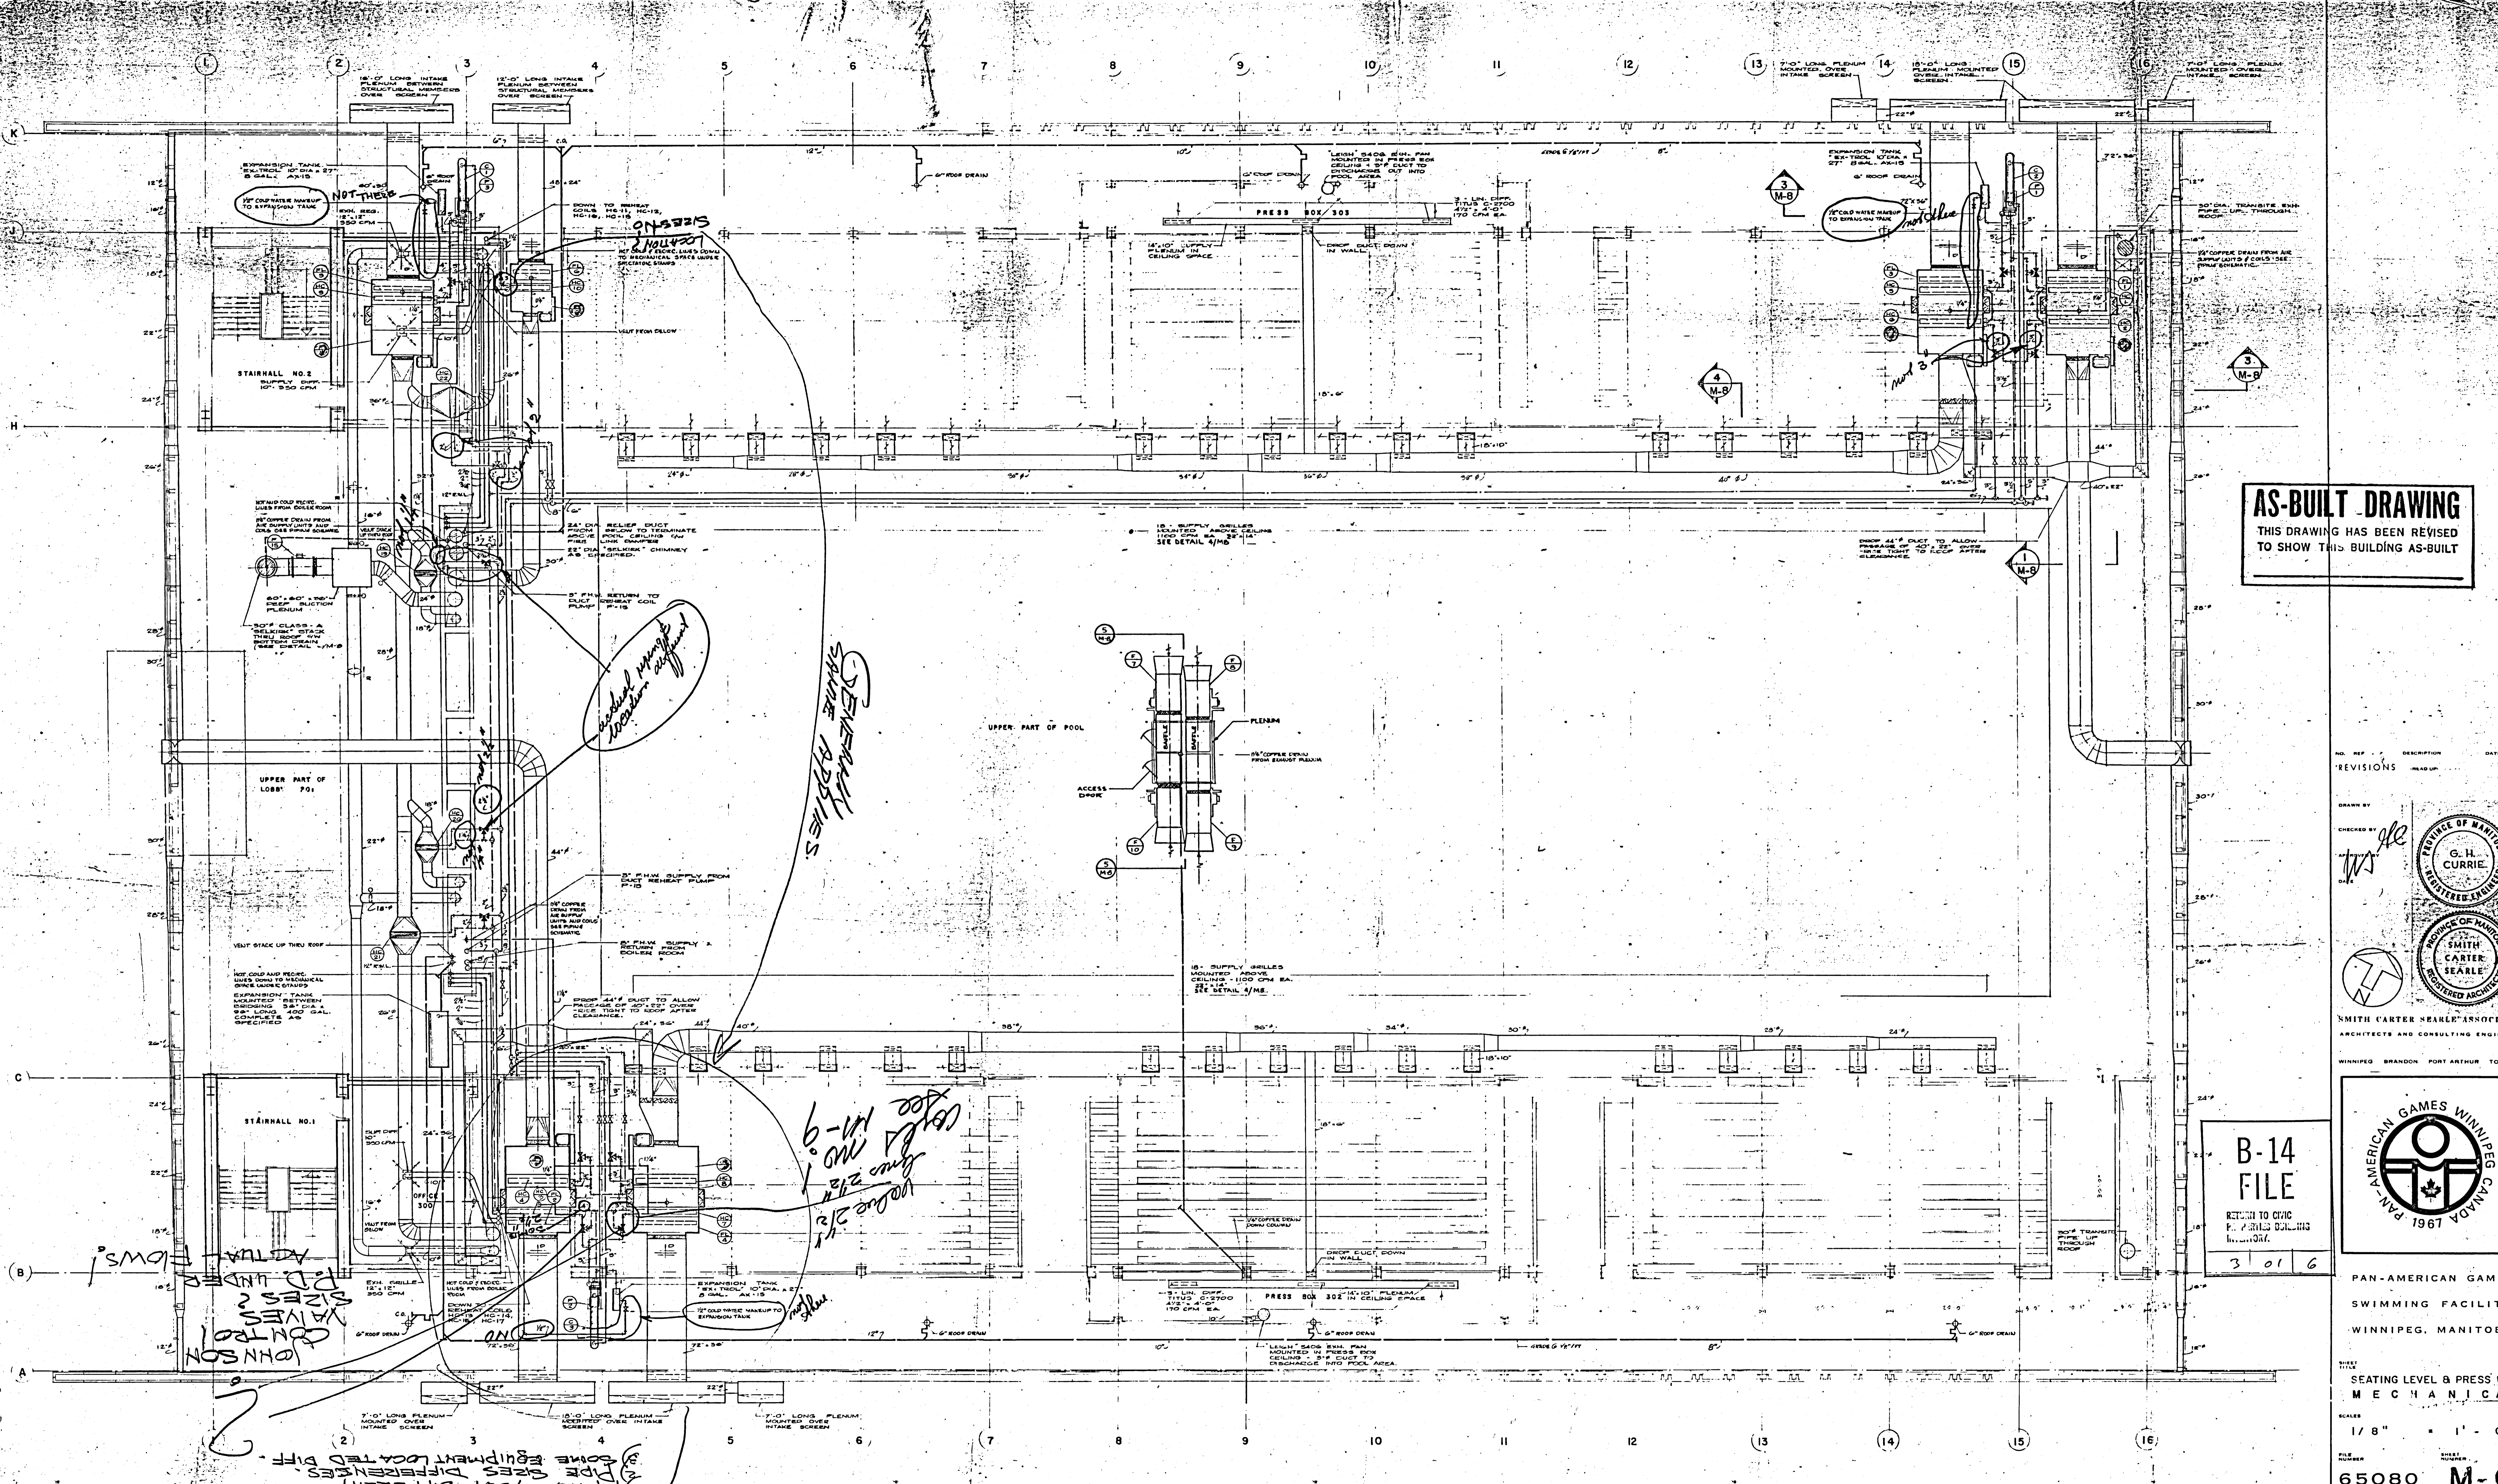

AS-BUILT DRAWING
THIS DRAWING HAS BEEN REVISED
TO SHOW THIS BUILDING AS-BUILT

NO.	REV.	DESCRIPTION	DATE
1		REVISIONS	

DRAWN BY: *[Signature]*
 CHECKED BY: *[Signature]*
 DATE:

PROVINCE OF MANITOBA REGISTERED ENGINEER
G. H. CURRIE
 PROVINCE OF MANITOBA REGISTERED ARCHITECT
SMITH CARTER SEARLE
 ARCHITECTS AND CONSULTING ENGINEERS
 WINNIPEG BRANDON PORT ARTHUR TORONTO

B-14 FILE
RETURN TO CIVIC
ENGINEERING DEPT.
WINNIPEG, MANITOBA
3 01 6



PAN-AMERICAN GAMES
SWIMMING FACILITY
WINNIPEG, MANITOBA

SHEET NUMBER
**SEATING LEVEL & PRESS BOX
MECHANICAL**
SCALE
1/8" = 1'-0"
FILE NUMBER
65080 M-6