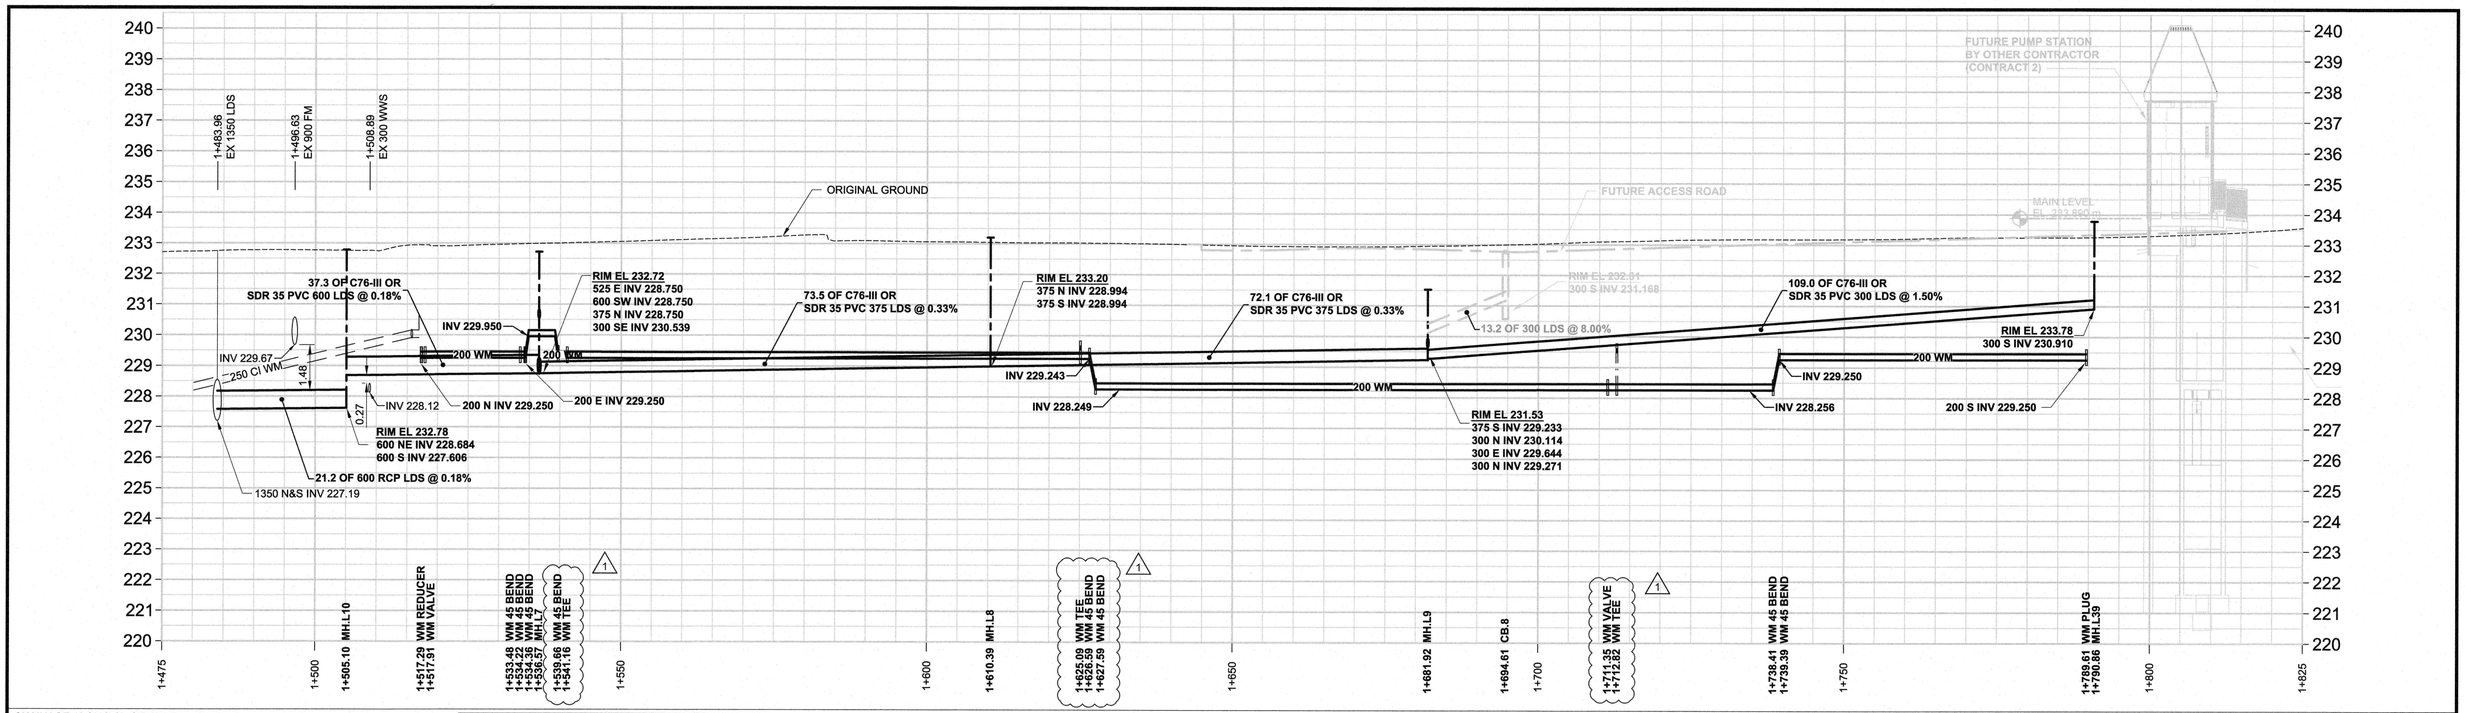

CHAINAGE ALONG CL OF WAVERLEY AVE

STRUCTURE LOCATION TABLE						
STRUCTURE NAME	NORTHING	EASTING	BASE DIAM.	BASE HT.	TRANSITION SLAB	STUB DIAM. C/W PLUG
CB.5	5523245.173	630918.311	SD-025CB	N/A	N/A	N/A
MH.L6	5523250.330	630918.551	1200	1200	N/A	N/A
MH.L7	5523243.752	630873.244	1500	1200	1500 x 1200	300
MH.L8	5523317.250	630875.042	1200	1200	N/A	N/A
MH.L9	5523389.064	630868.659	1200	1200	N/A	300/300
MH.L10	5523213.476	630851.459	1500	2400	1500 x 1200	N/A
MH.L39	5523498.091	630868.213	1200	1200	N/A	NOTE-LDS MANHOLE

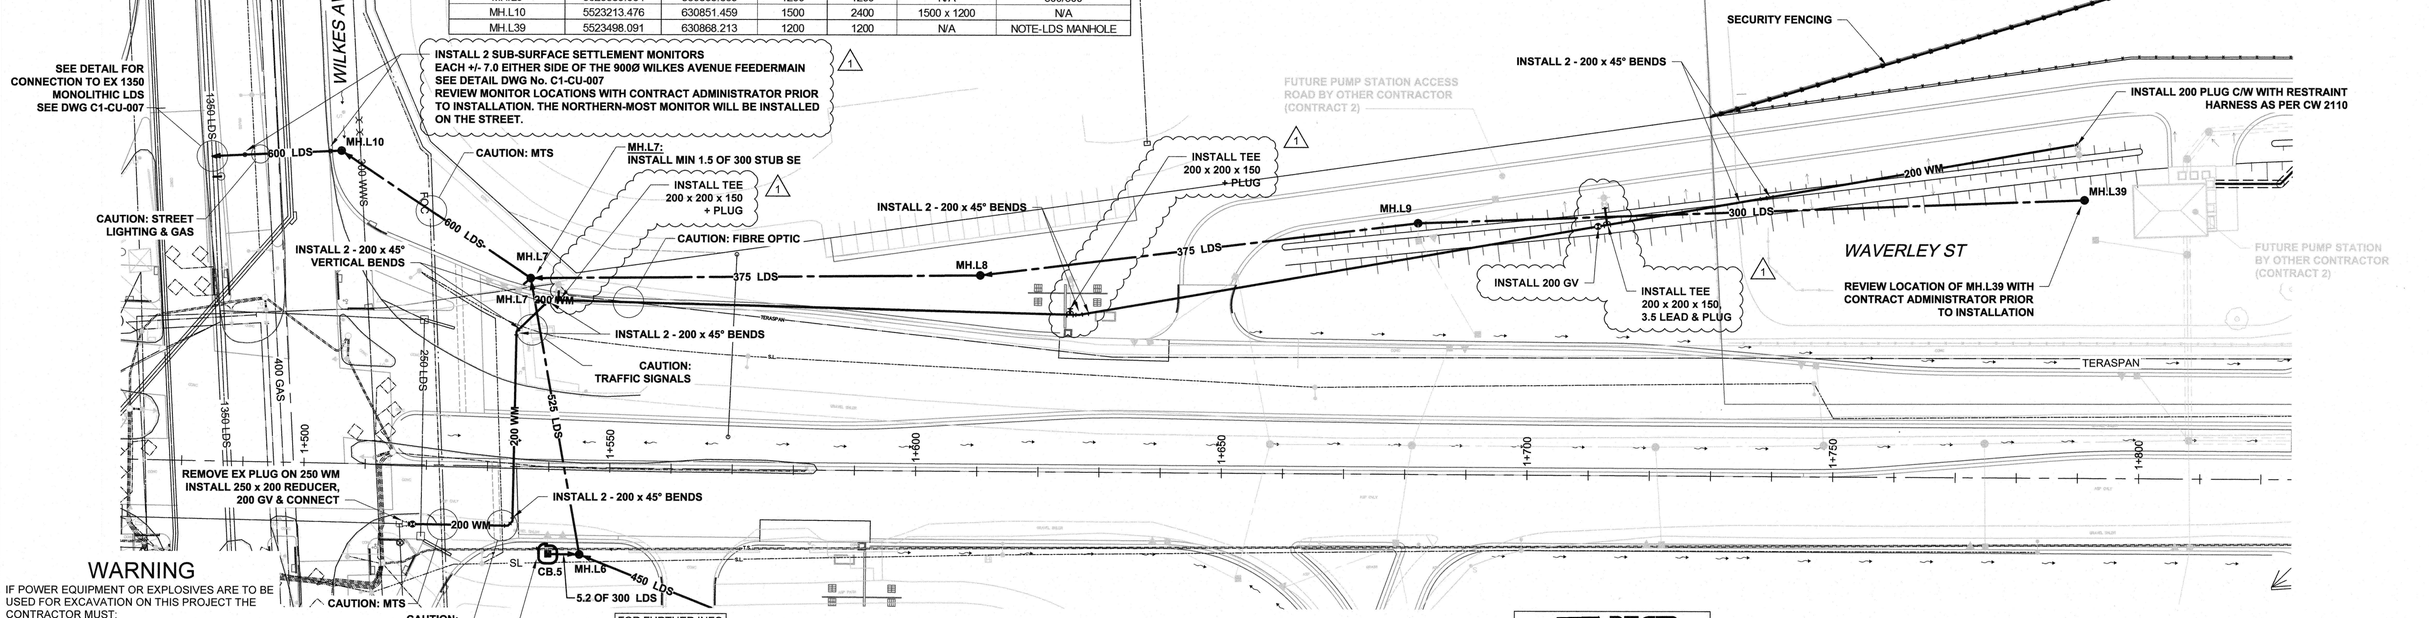

WARNING

IF POWER EQUIPMENT OR EXPLOSIVES ARE TO BE USED FOR EXCAVATION ON THIS PROJECT THE CONTRACTOR MUST:

1. NOTIFY THE GAS COMPANY OF THE PROPOSED LOCATION OF EXCAVATION.
2. TAKE PRECAUTION TO AVOID DAMAGE TO GAS COMPANY INSTALLATIONS SEE PROVINCIAL REGULATION 210/72 FOR DETAILS.
3. OBTAIN EXCAVATION PERMITS PRIOR TO CONSTRUCTION.

EXISTING	LEGEND - PLAN	NEW	EXISTING	LEGEND - PLAN	NEW	EXISTING	LEGEND - PROFILE	NEW
150 WM	WATER MAIN	150 WM		PIPE ABANDONMENTS		150 WM	WATER MAIN	150 WM
⊹	HYDRANT	⊹	⊹	SURVEY BAR		⊹	HYDRANT	⊹
⊗	VALVE	⊗	♂	CURB STOP	♂	⊗	VALVE	⊗
300 LDS	LAND DRAINAGE SEWER	300 LDS		REDUCER		300 LDS	LAND DRAINAGE SEWER	300 LDS
250 WWS	WASTE WATER SEWER	250 WWS		COUPLING		250 WWS	WASTE WATER SEWER	250 WWS
	SEWER SERVICE PIPE	SSP		ANODE			PAVEMENT CROWN	
	DRAINAGE CONNECTION PIPE			HYDRO			N/W PROPERTY LINE	
○	MANHOLE	●		MTS			S/E PROPERTY LINE	
□	CATCH BASIN	■		GAS			N/W GUTTER	
△	CURB INLET	▲	⊹	TESTHOLE			S/E GUTTER	
	CULVERT			LAMP STANDARD				

UNDERGROUND STRUCTURES

SUPV. U/G STRUCTURES DATE

LOCATION OF UNDERGROUND STRUCTURES AS SHOWN ARE BASED ON THE BEST INFORMATION AVAILABLE, BUT NO GUARANTEE IS GIVEN THAT ALL EXISTING UTILITIES ARE SHOWN OR THAT THE GIVEN LOCATIONS ARE EXACT. CONFIRMATION OF EXISTENCE AND EXACT LOCATION OF ALL SERVICES MUST BE OBTAINED FROM THE INDIVIDUAL UTILITIES BEFORE PROCEEDING WITH CONSTRUCTION.

NO.	REVISIONS	DATE	BY
1	ISSUED FOR ADDENDUM 2	16/10/26	MRP
0	ISSUED FOR TENDER	16/10/17	WJd

B.M. ELEV.

PEGM Certificate of Authorization AECOM Canada Ltd. No. 4671 Date: 04 27 2016

METRIC
WHOLE NUMBERS INDICATE MILLIMETRES
DECIMALIZED NUMBERS INDICATE METRES

AECOM

DESIGNED BY	MRP	CHECKED BY	
DRAWN BY	KLC	APPROVED BY	
HOR. SCALE	1:500	RELEASED FOR CONSTRUCTION	
VERTICAL	1:100		
DATE	-	DATE	-

ENGINEER'S SEAL: PROVINCE OF MANITOBA M.P.A. GAUDREAU Member 32167 REGISTERED PROFESSIONAL ENGINEER

CONSULTANT PROJECT NUMBER 60321148

Winnipeg

THE CITY OF WINNIPEG
PUBLIC WORKS DEPARTMENT

WAVERLEY STREET UNDERPASS AT CN MILE 3.89 RIVERS SUB
CONTRACT 1: PRELIMINARY UNDERGROUND WORKS AND SECURITY FENCING

CITY DRAWING NUMBER U239-2016-C1-CU-005

SHEET 7 OF 9

WAVERLEY STREET - PLAN/PROFILE
PUMPING STATION ACCESS ROAD
LDS

CONSULTANT DRAWING NUMBER C1-CU-005

P:\60321148\300-Work\9100-DD CAD\200-SHEETS\Municipal\163353-C1-CON-CU-Waverley-001.dwg