



P:\60321148\900-CAD\90-CAD\99-SUPPORT\PROJECT\_TITLE\_BLOCKS\Title\_Block\_for\_Pump\_Station\_works\1633853-XTB-C1-CU.dwg

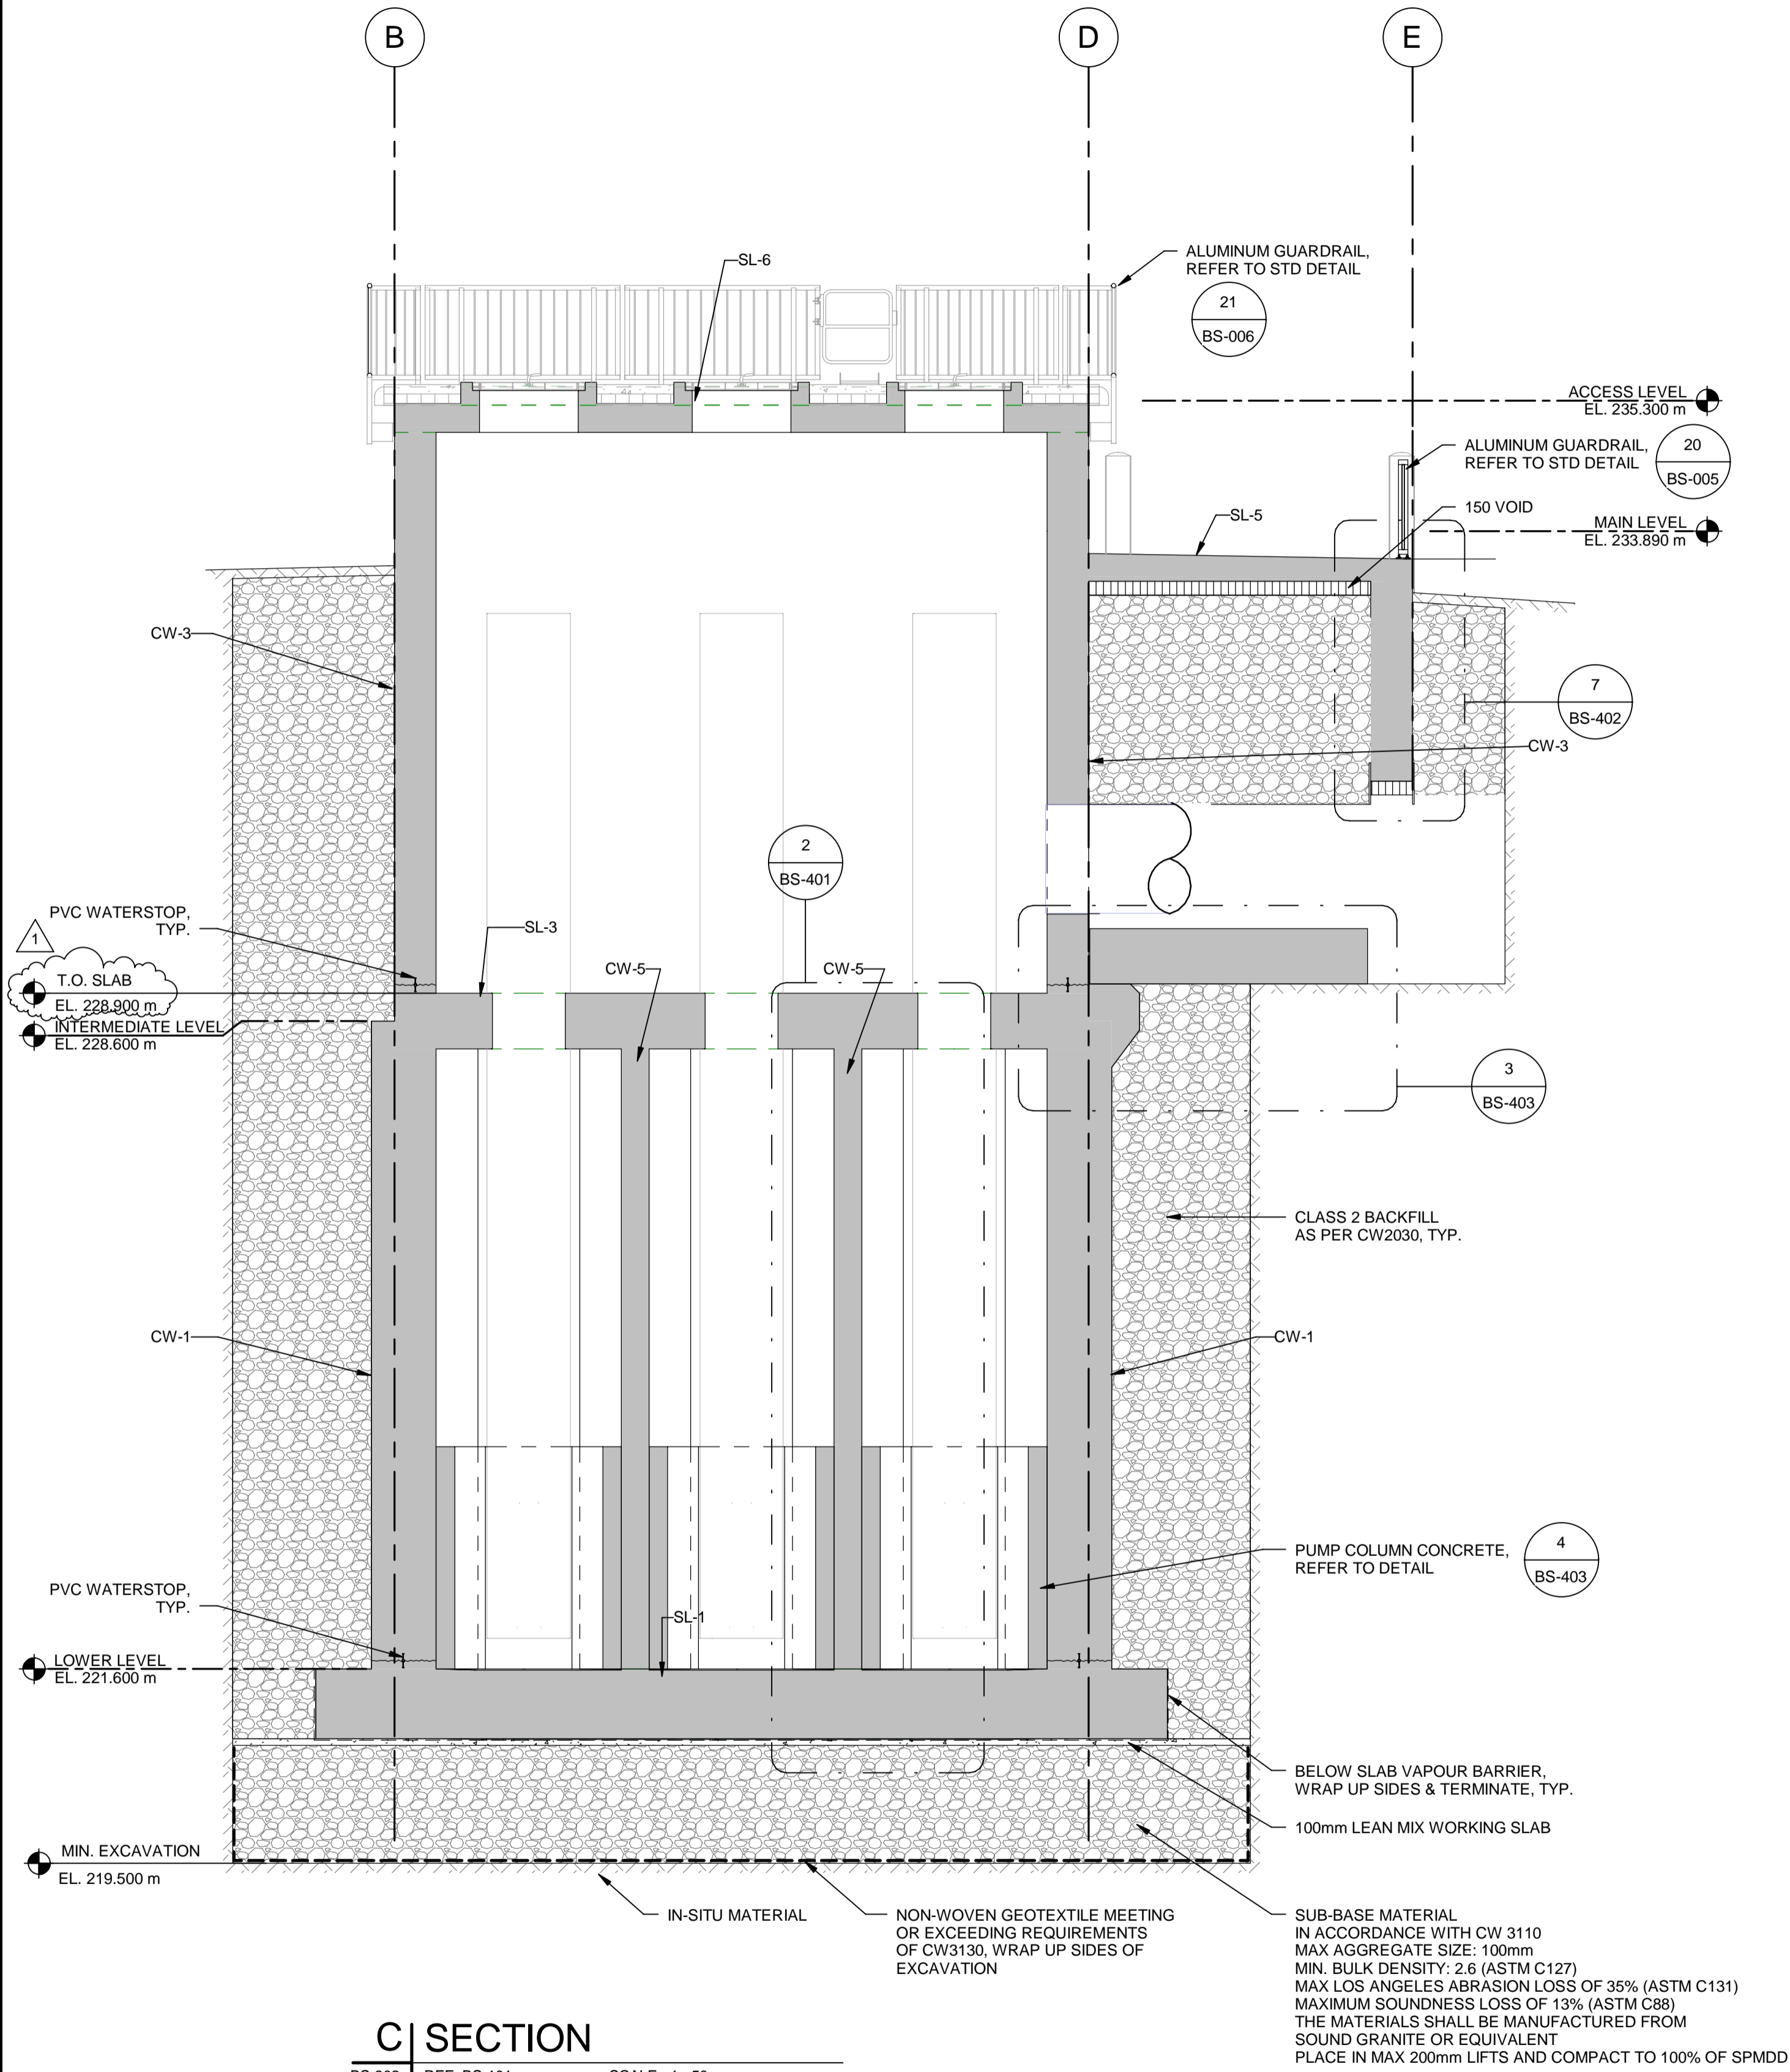

**C | SECTION**  
 BS-302 REF: BS-101 SCALE: 1 : 50

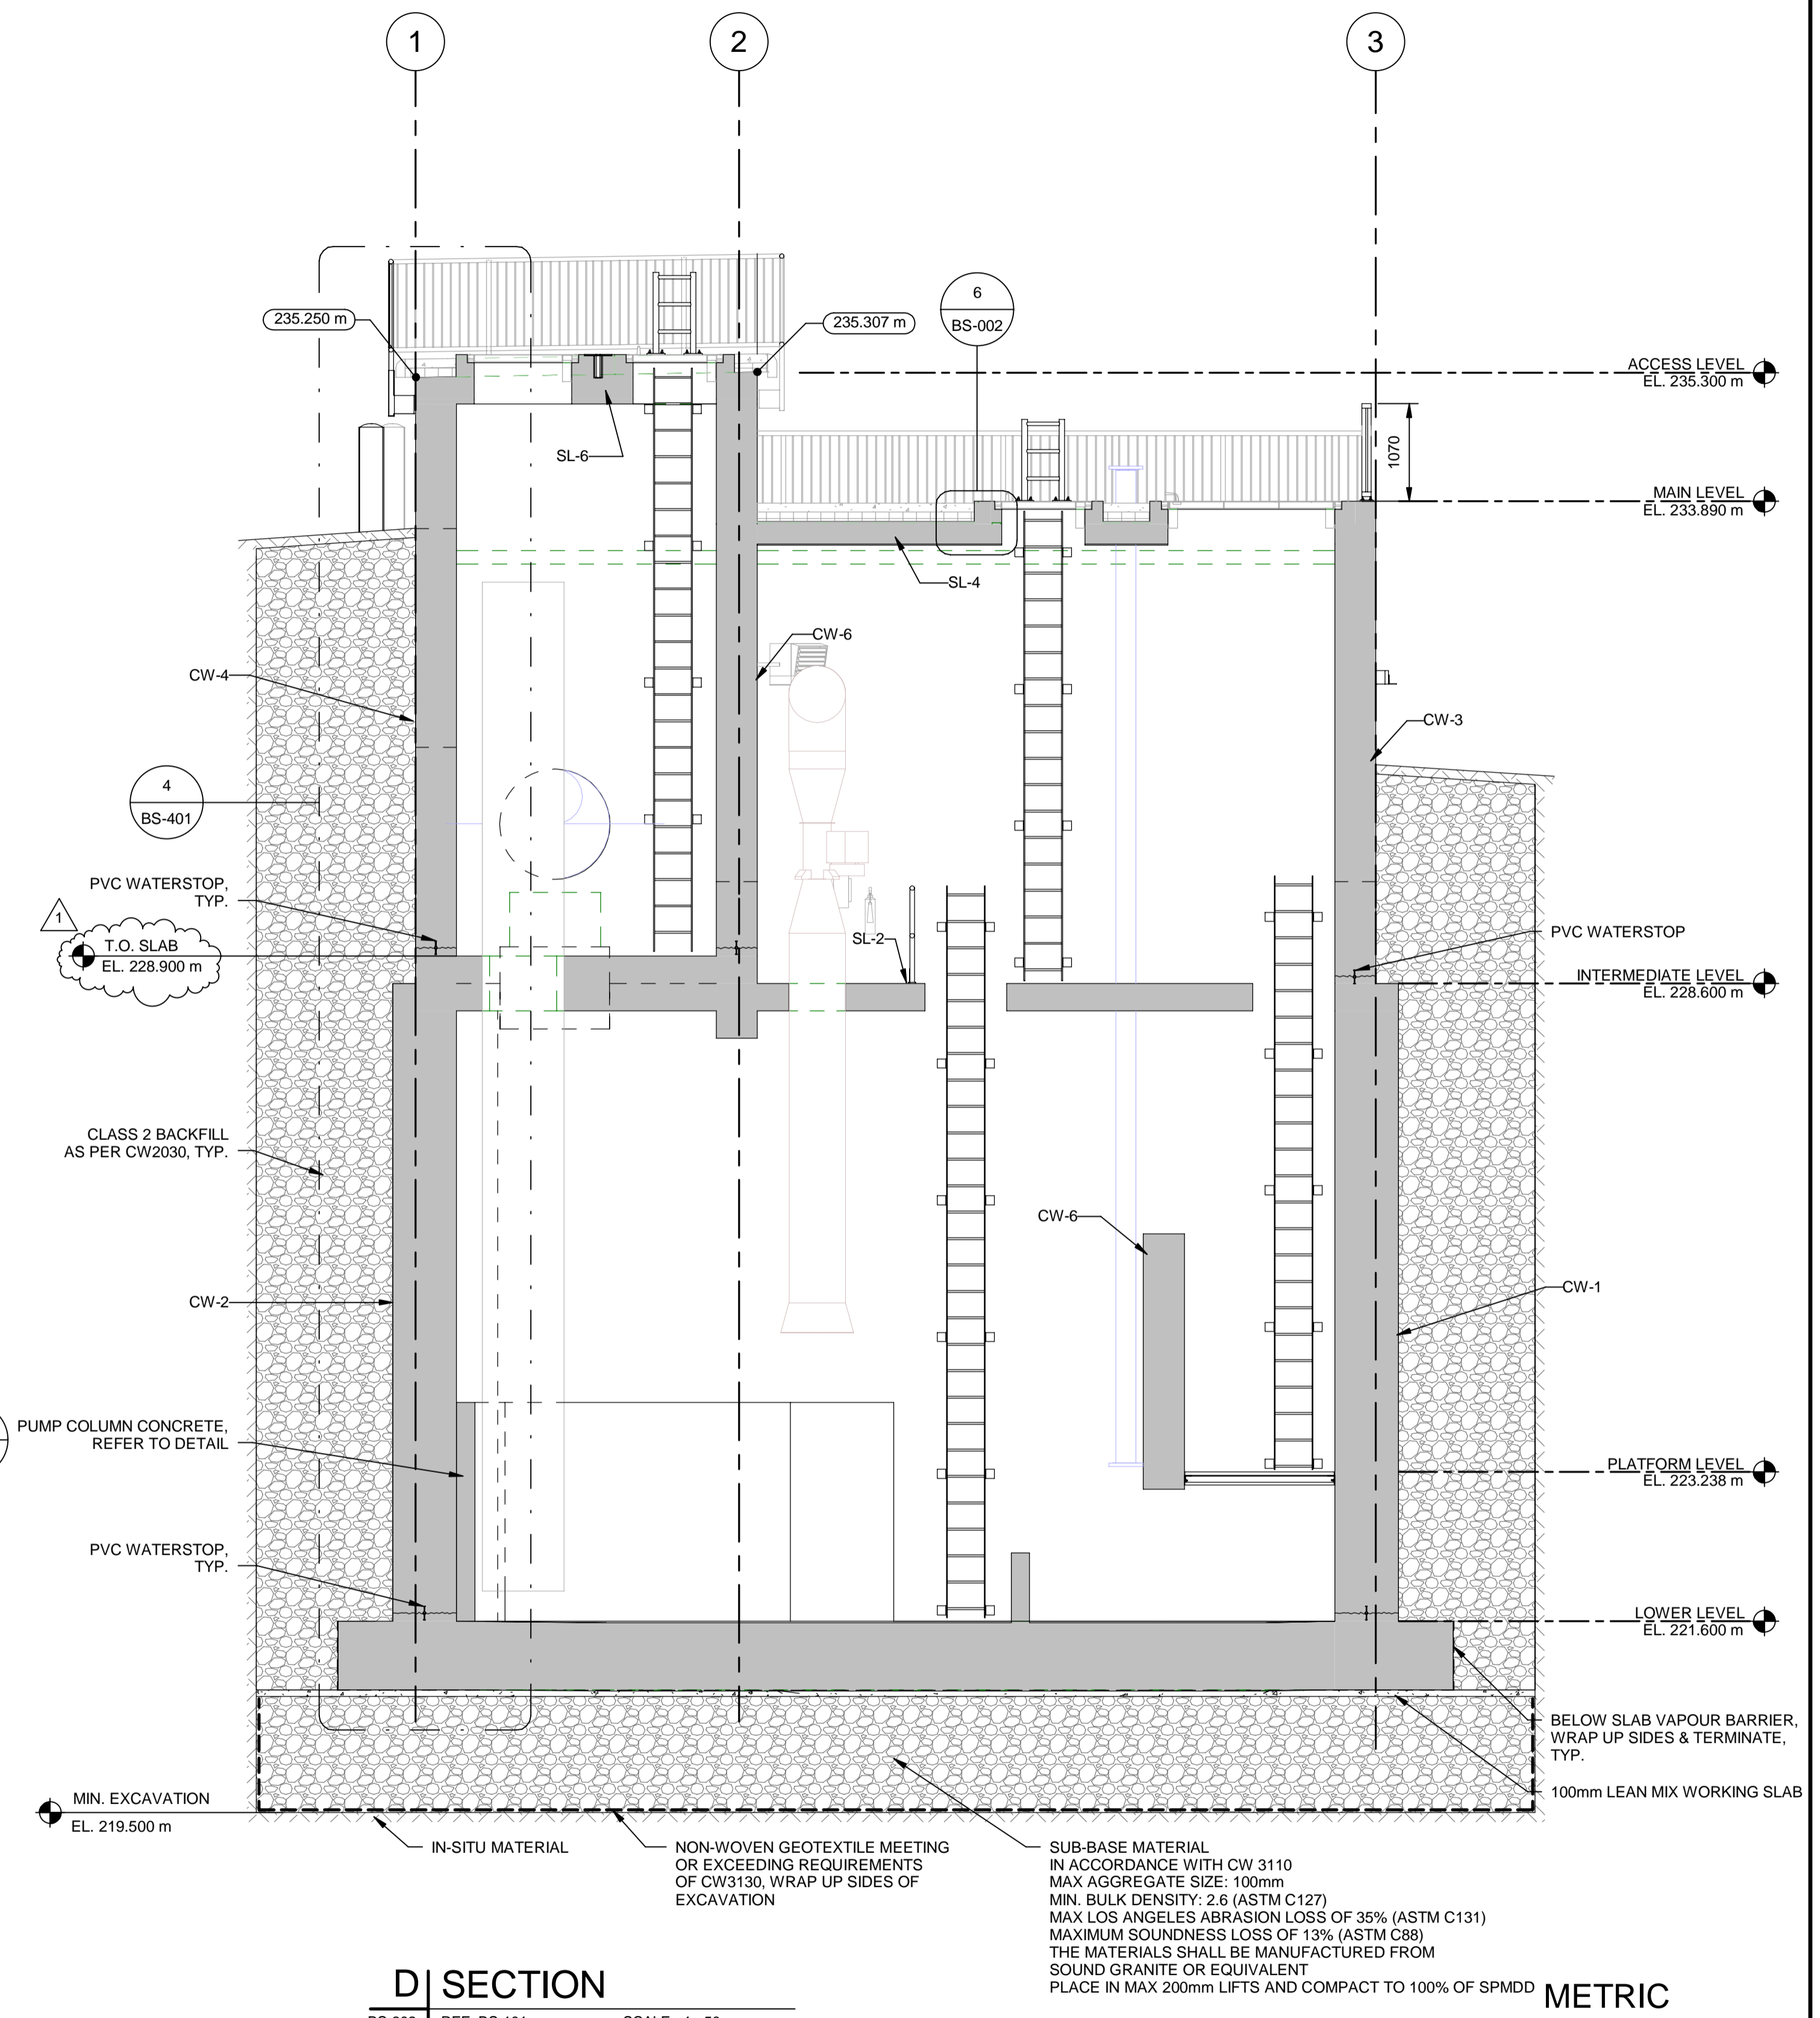

**D | SECTION**  
 BS-302 REF: BS-101 SCALE: 1 : 50



UNDERGROUND STRUCTURES			
SUPP. U/G STRUCTURES	DATE	B.M. ELEV.	

NO.	REVISIONS	DATE	BY	DATE
1	ISSUED FOR ADDENDUM 4	17/02/22	KK	
0	ISSUED FOR TENDER	17/01/09	KK	

<b>AECOM</b>	
DESIGNED BY KK/JT	CHECKED BY SBB
DRAWN BY KK	APPROVED BY AN
HOR. SCALE AS SHOWN	RELEASED FOR CONSTRUCTION
DATE 06/01/2016	DATE 09/06/2016

ENGINEER'S SEAL  
 PROVINCE OF MANITOBA  
**J.A. THOMPSON**  
 Member  
 30632  
 REGISTERED PROFESSIONAL ENGINEER

**THE CITY OF WINNIPEG**  
 PUBLIC WORKS DEPARTMENT

Waverley Street Underpass at CN Mile 3.89 Rivers Sub  
 Contract 2: Underpass Structure, Railworks,  
 Roadworks, Land Drainage Sewer, Pumping Station  
 and Landscaping Works

CITY DRAWING NUMBER  
 U-239-2016-C2-BS-302

SHEET 13 OF 16

CONSULTANT DRAWING NUMBER  
 C2-BS-302

PUMPING STATION  
 SECTIONS

**METRIC**  
 WHOLE NUMBERS INDICATE MILLIMETRES  
 DECIMALIZED NUMBERS INDICATE METRES