




E SECTION
SCALE: 1:15
TYPICAL AT ABUTMENTS

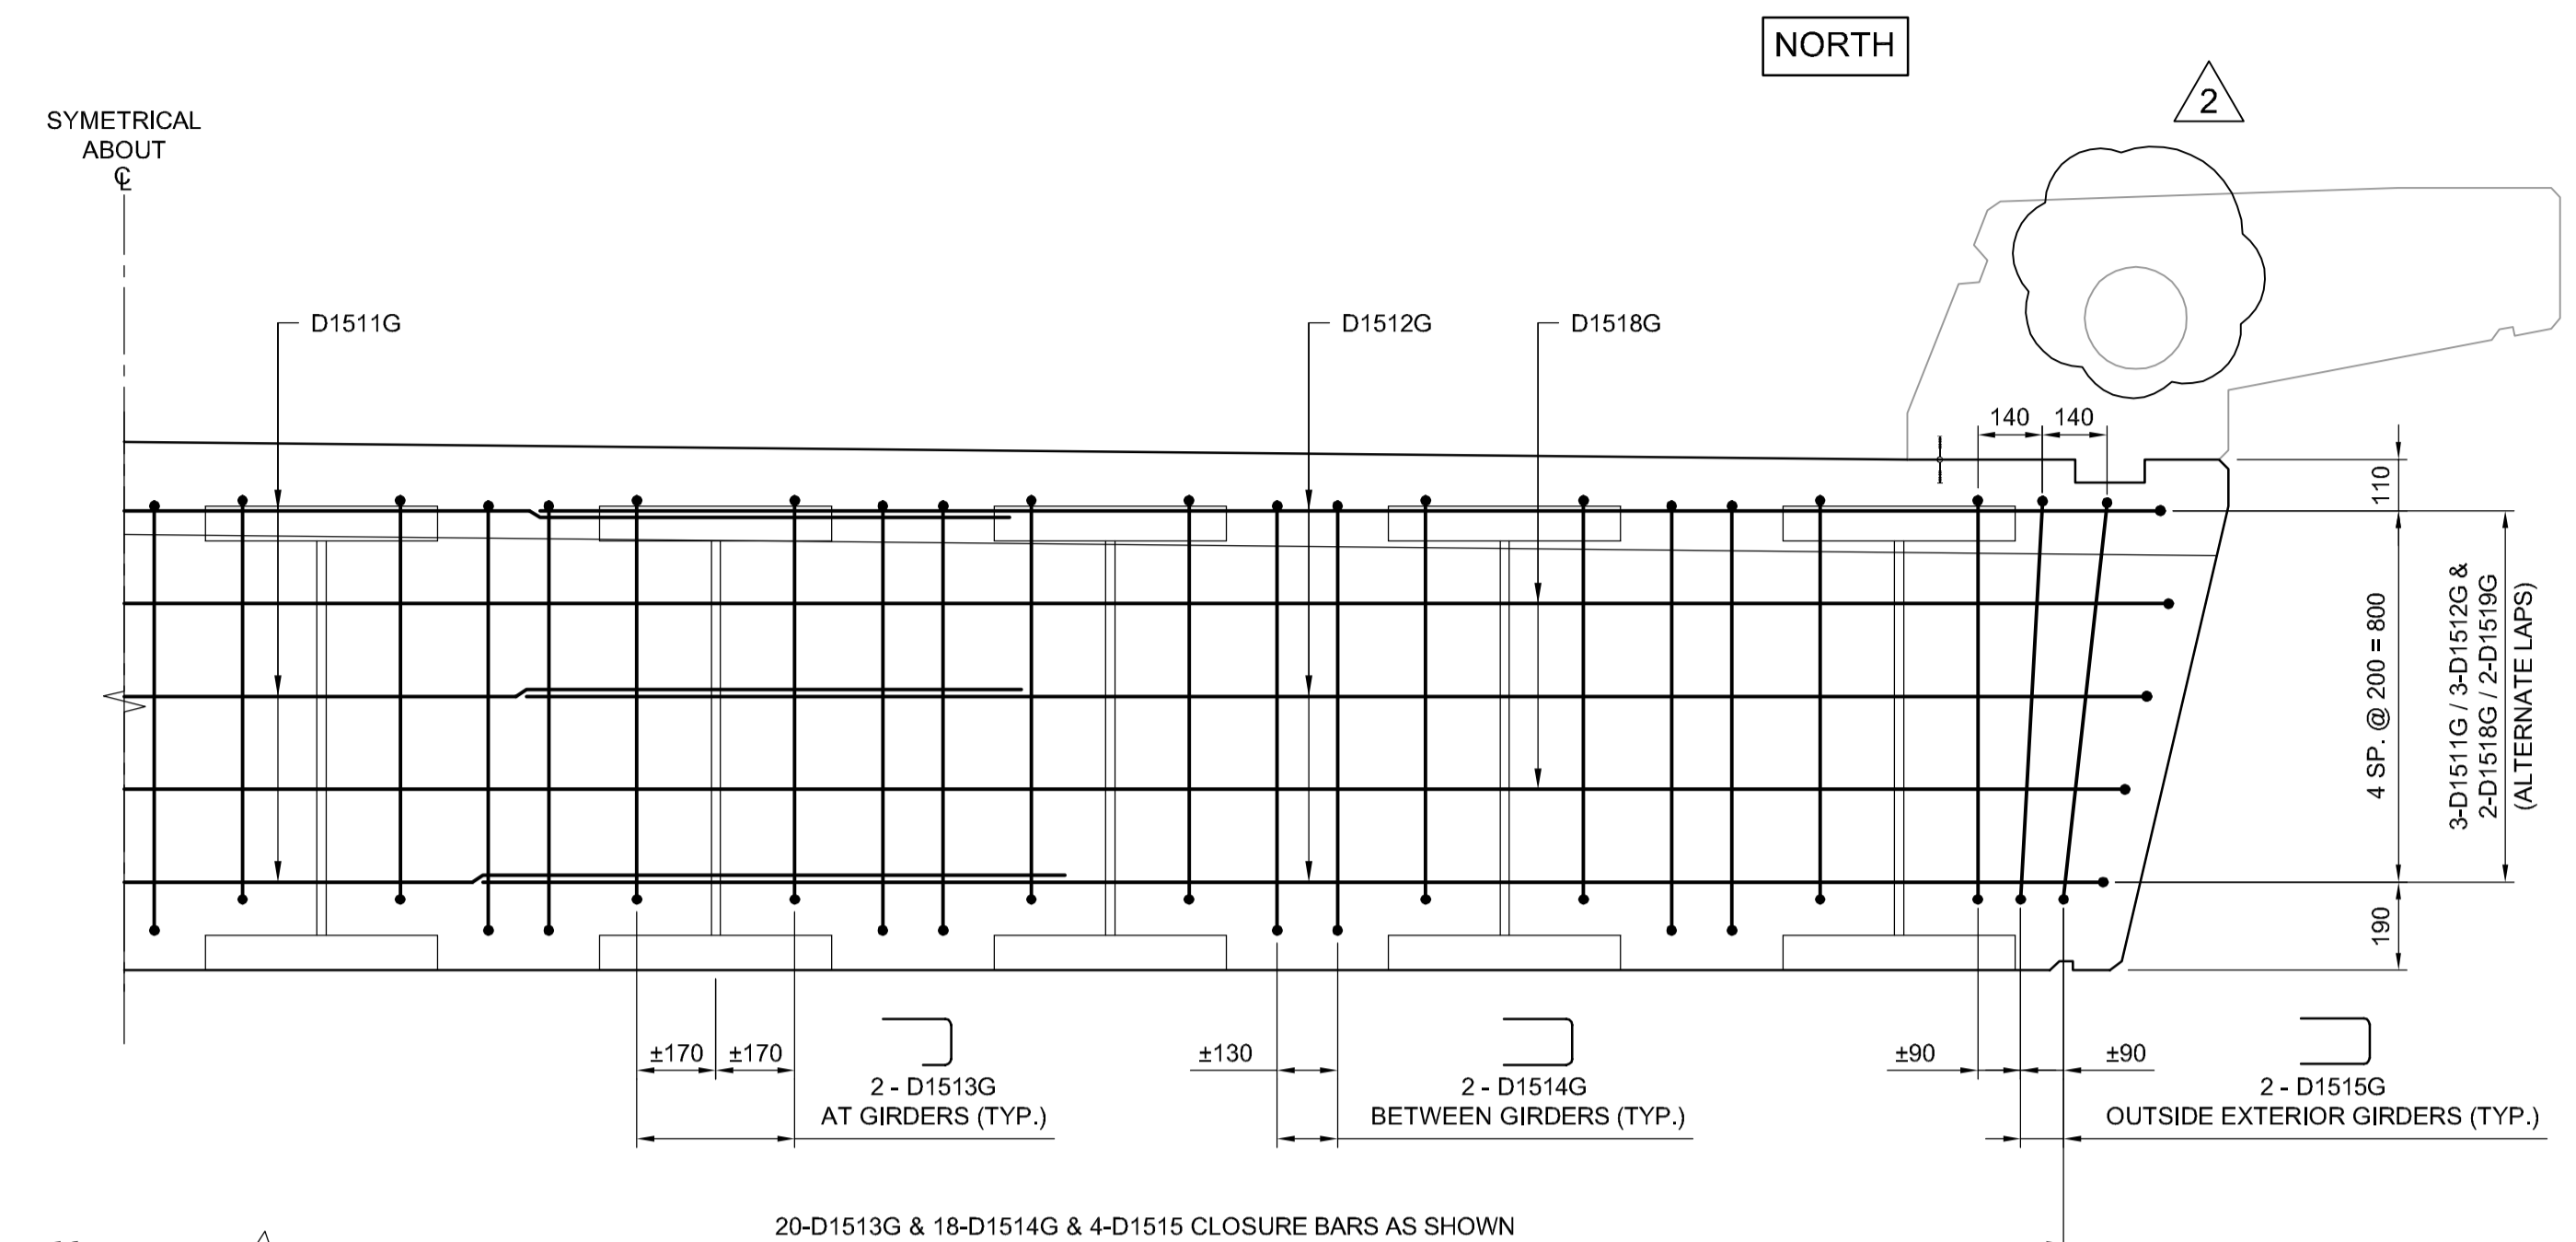

F SECTION
SCALE: 1:15
TYPICAL AT PIERS

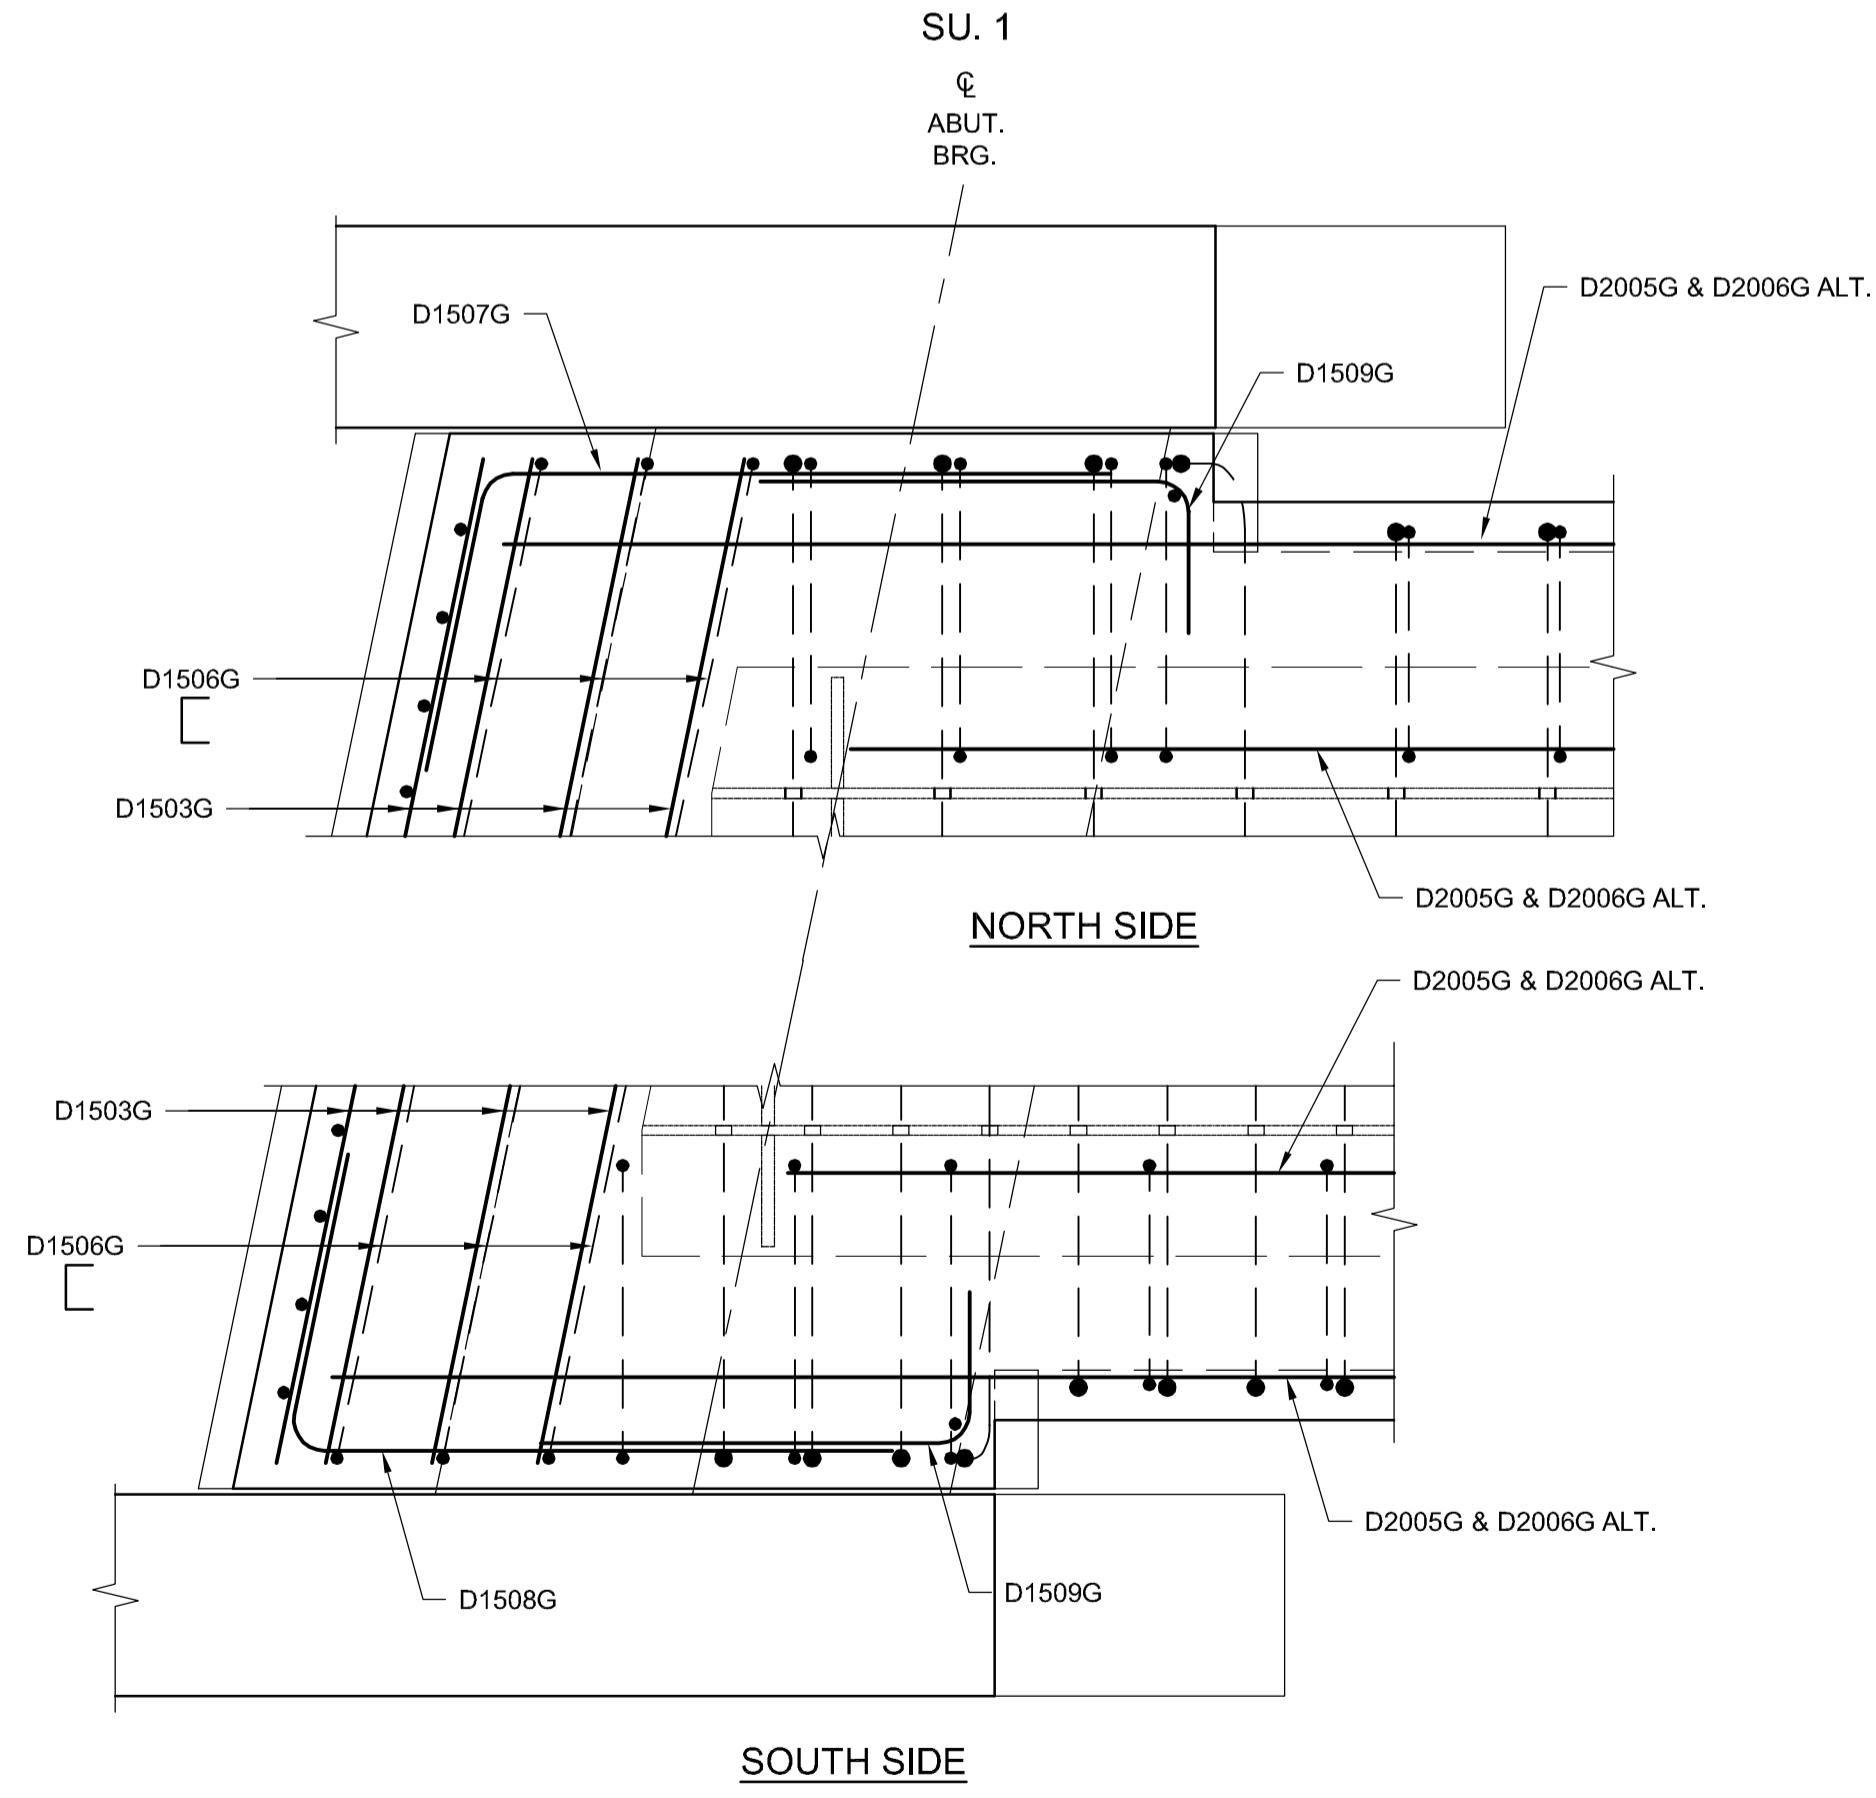

G SECTION
SCALE: 1:15
SU.1 SHOWN, SU.4 SIMILAR

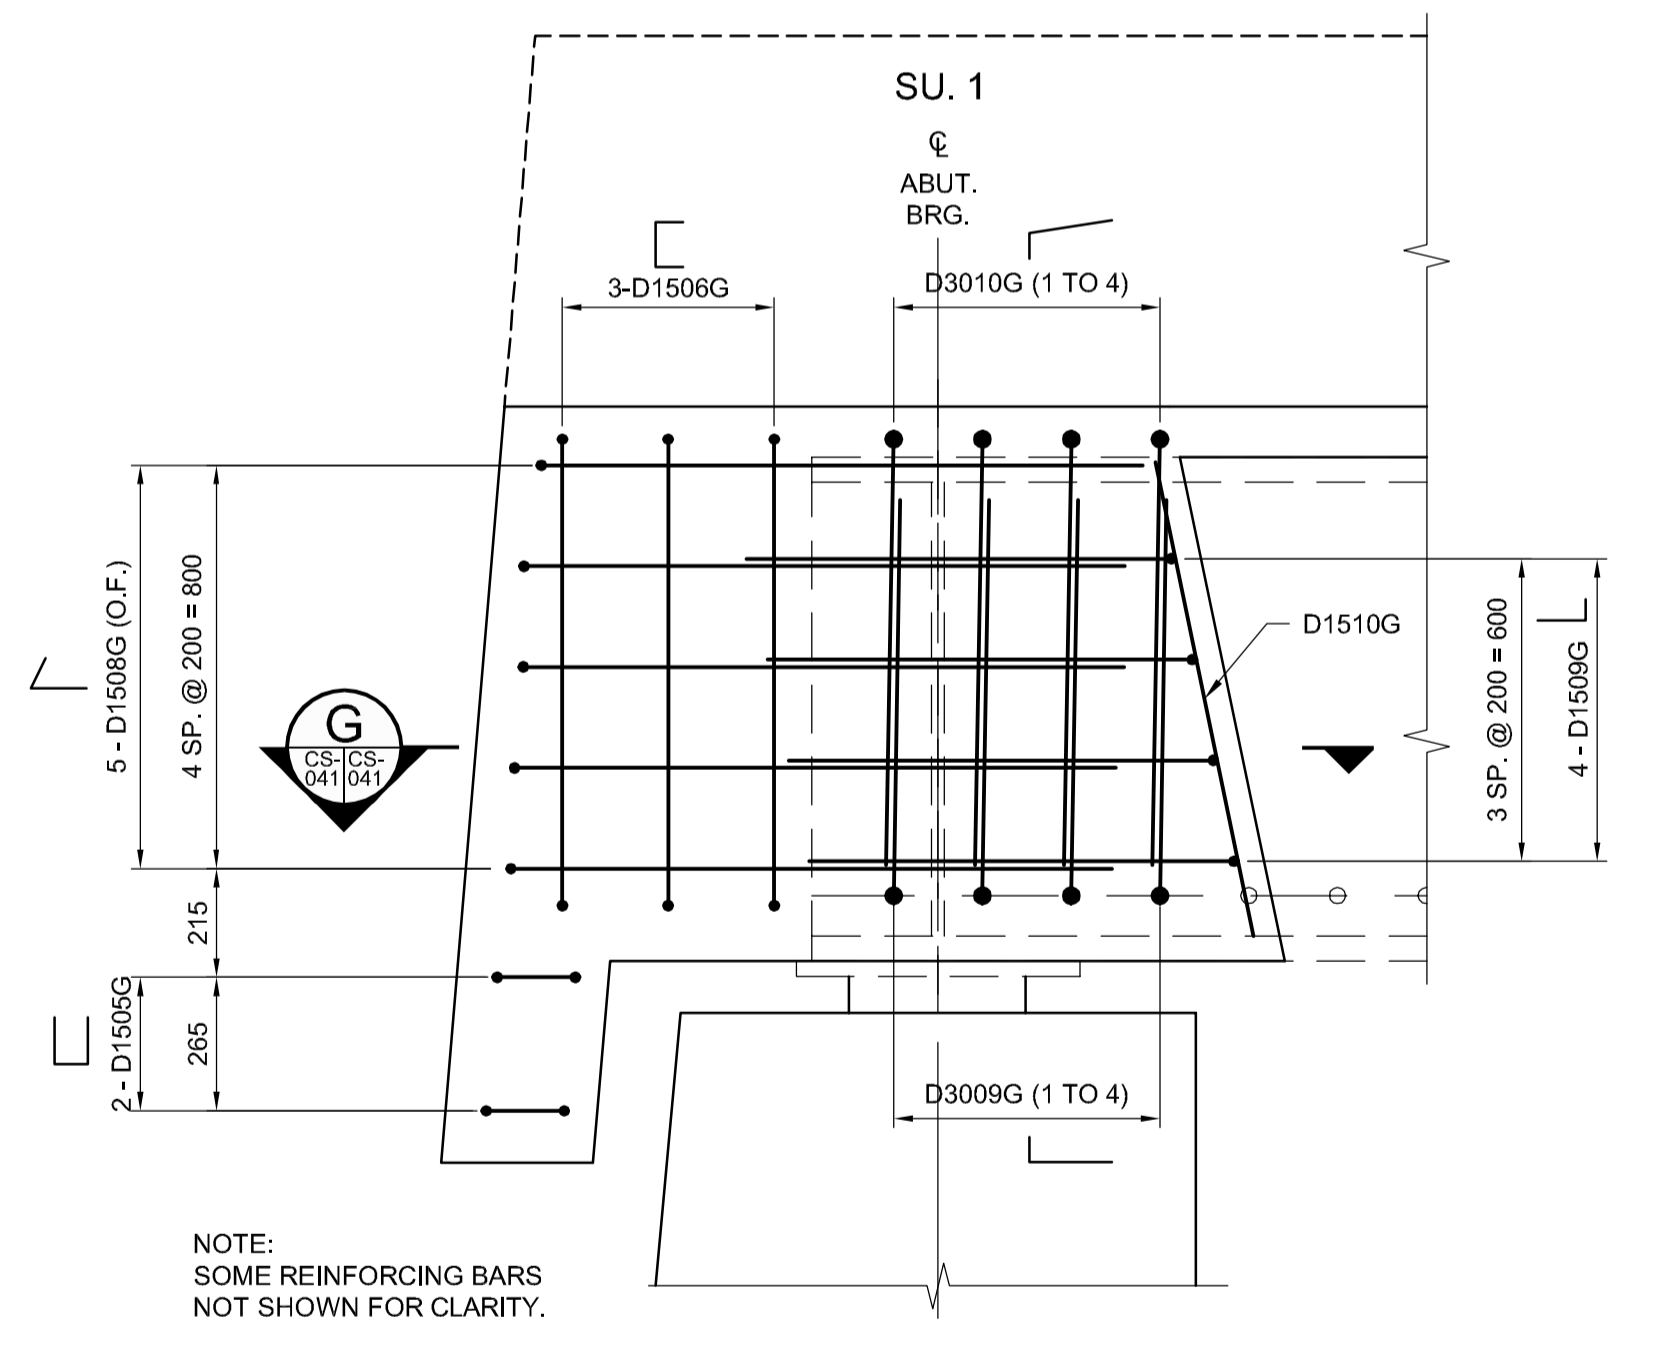

G ELEVATION
SCALE: 1:15
DECK END DIAPHRAGM - SOUTH ELEVATION
TYPICAL AT ABUTMENTS

ALL REINFORCING CHANGED TO GALVANIZED REINFORCING STEEL

- NOTES:**
- FOR REINFORCING STEEL NOTES REFER TO SHEET C2-CS-001.
 - REINFORCING STEEL WITH MARKS ENDING WITH "G" SHALL BE GALVANIZED REINFORCING.
 - FOR CONCRETE CLEAR COVER TO REINFORCEMENT REFER TO SHEET C2-CS-001.

G:\CAD\163353\Technical Workspace\Engineering\Drawings and Figures\Structures\Contract\163353-C2-CON-CS-DECK SLAB REINFORCING 5.dwg

APEGM
Certificate of Authorization
Dillon Consulting Limited (MB)
No. 1789 Date: 2017/01/09

| | | | |
|----------------|-------------------|---------------------------|-----|
| DESIGNED BY | RE | CHECKED BY | SSR |
| DRAWN BY | CGC | APPROVED BY | DBW |
| HOR. SCALE | AS SHOWN | RELEASED FOR CONSTRUCTION | |
| VERTICAL SCALE | AS SHOWN | | |
| NO. | REVISIONS | DATE | BY |
| 2 | ADDENDUM #5 | 17/03/01 | RE |
| 1 | ADDENDUM #1 | 17/01/25 | RE |
| 0 | ISSUED FOR TENDER | 17/01/09 | RE |

ENGINEER'S SEAL
PROVINCE OF MANITOBA
R.B. ERIC
Member 22665
REGISTERED PROFESSIONAL ENGINEER
CONSULTANT PROJECT NUMBER
16-3353

THE CITY OF WINNIPEG
PUBLIC WORKS DEPARTMENT
Waverley Street Underpass at CN Mile 3.89 Rivers Sub
Contract 2: Underpass Structure, Railworks,
Roadworks, Land Drainage Sewer, Pumping Station
and Landscaping Works
CITY DRAWING NUMBER
U-239-2016-C2-CS-041
SHEET 041 OF 085
CONSULTANT DRAWING NUMBER
C2-CS-041