

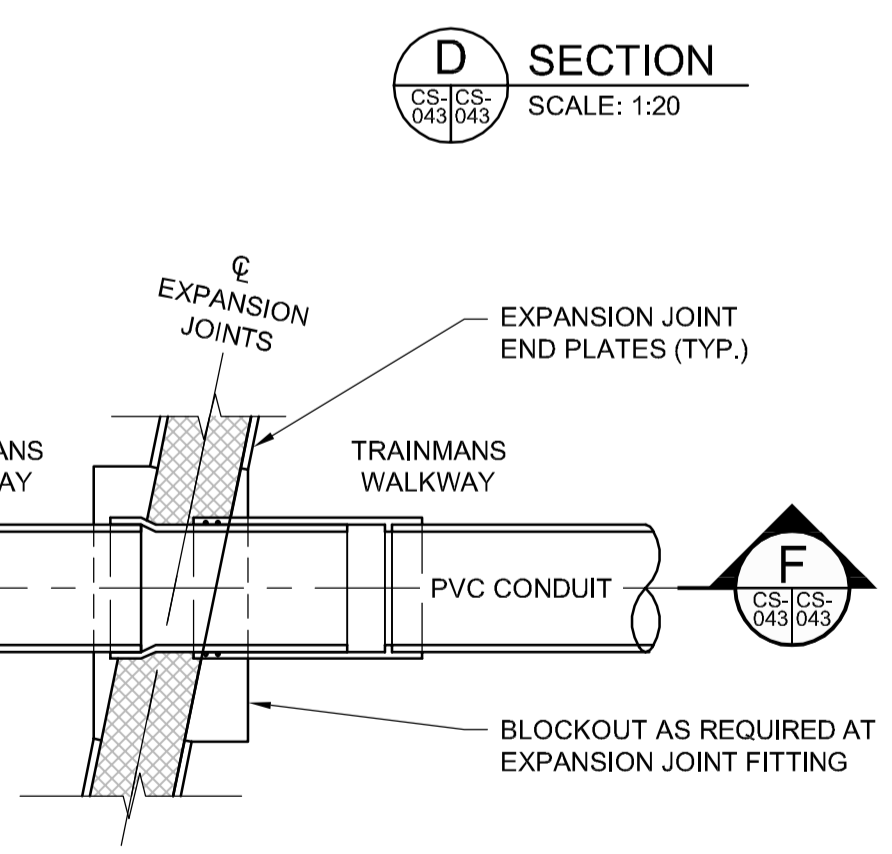
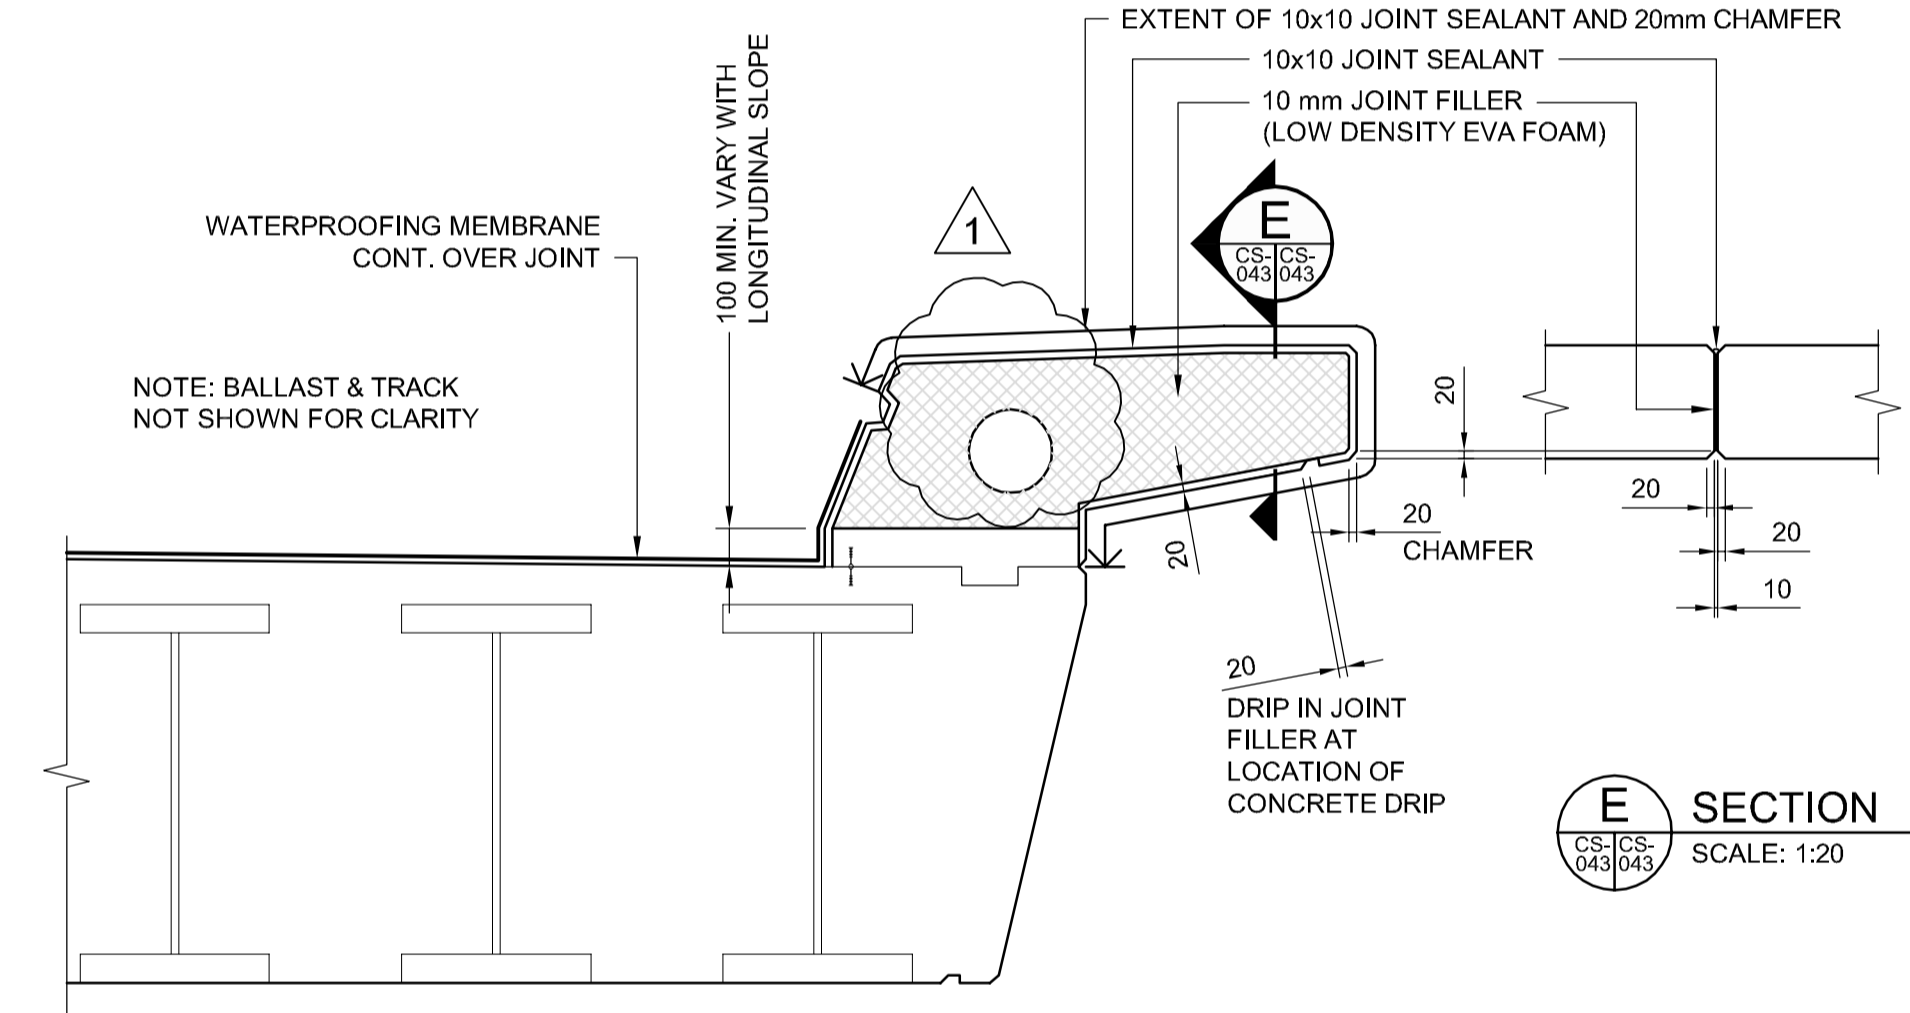
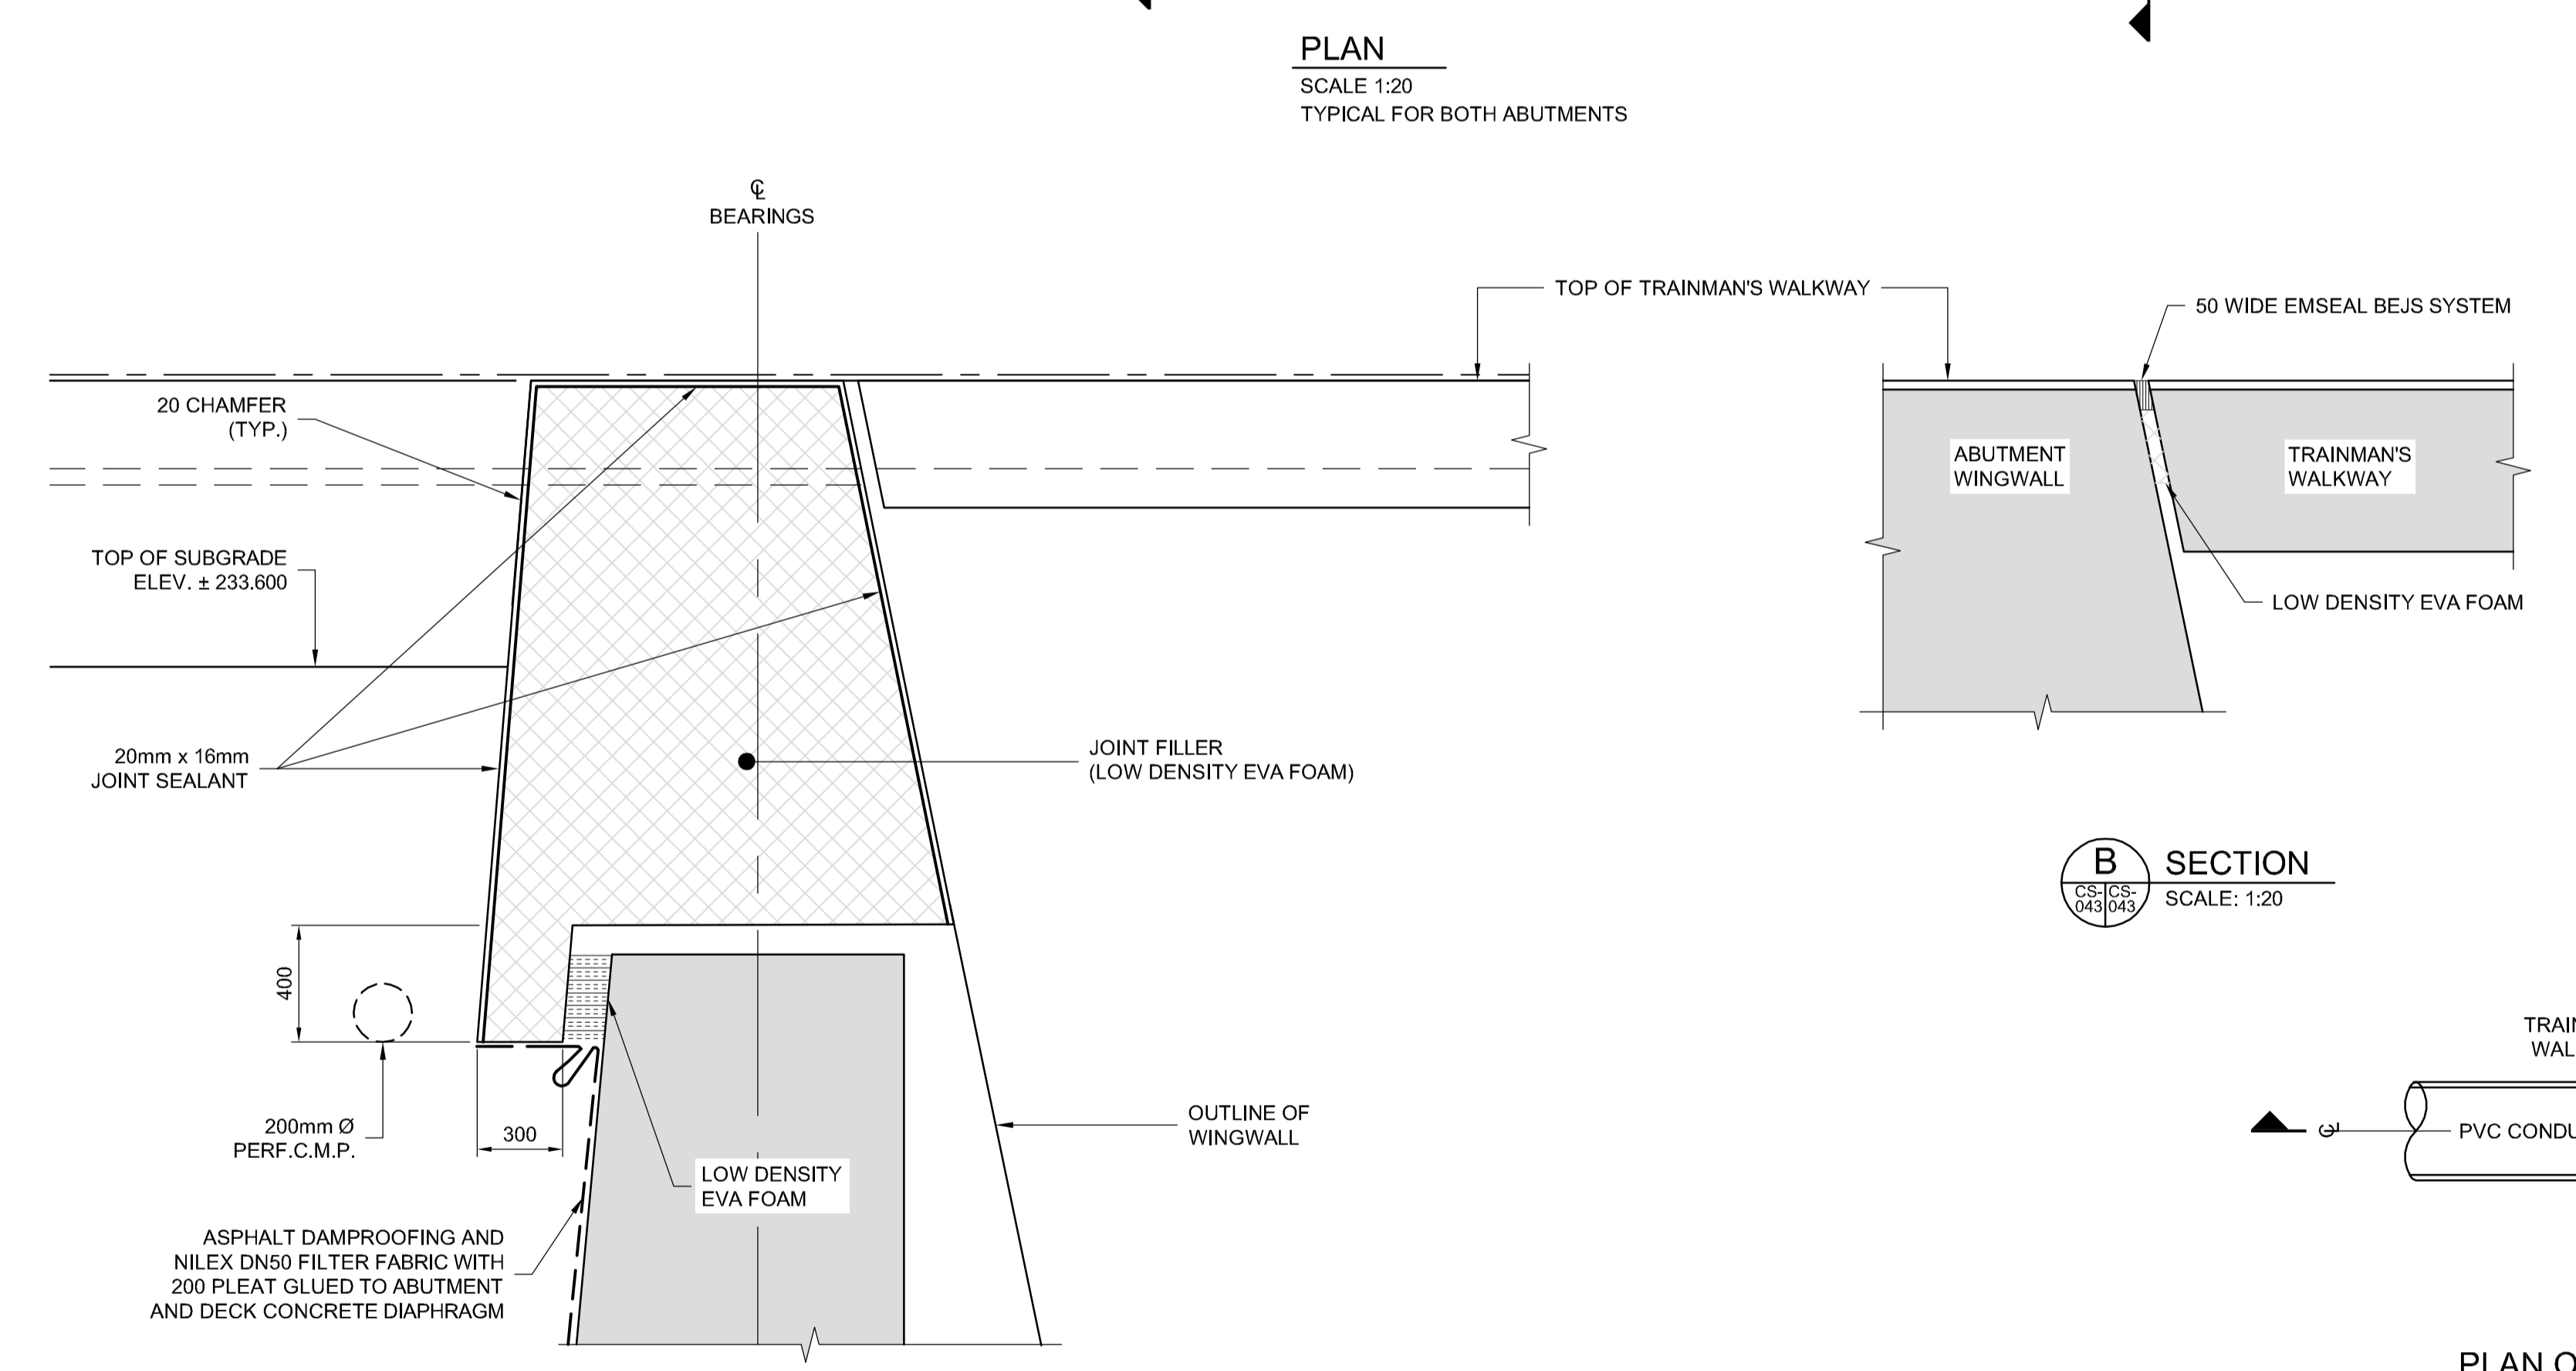


- NOTES:**
1. ALL JOINTS SHALL BE SEALED WITH TWO PARTS POLYSULFIDE JOINT SEALANT
 2. JOINT FILLER SHALL BE 15mm LOW DENSITY EVA FOAM, UNLESS NOTED
 3. POLYETHYLENE STRIP BOND BREAKER SHALL BE PLACED BETWEEN JOINT SEALANT AND EVA FOAM.

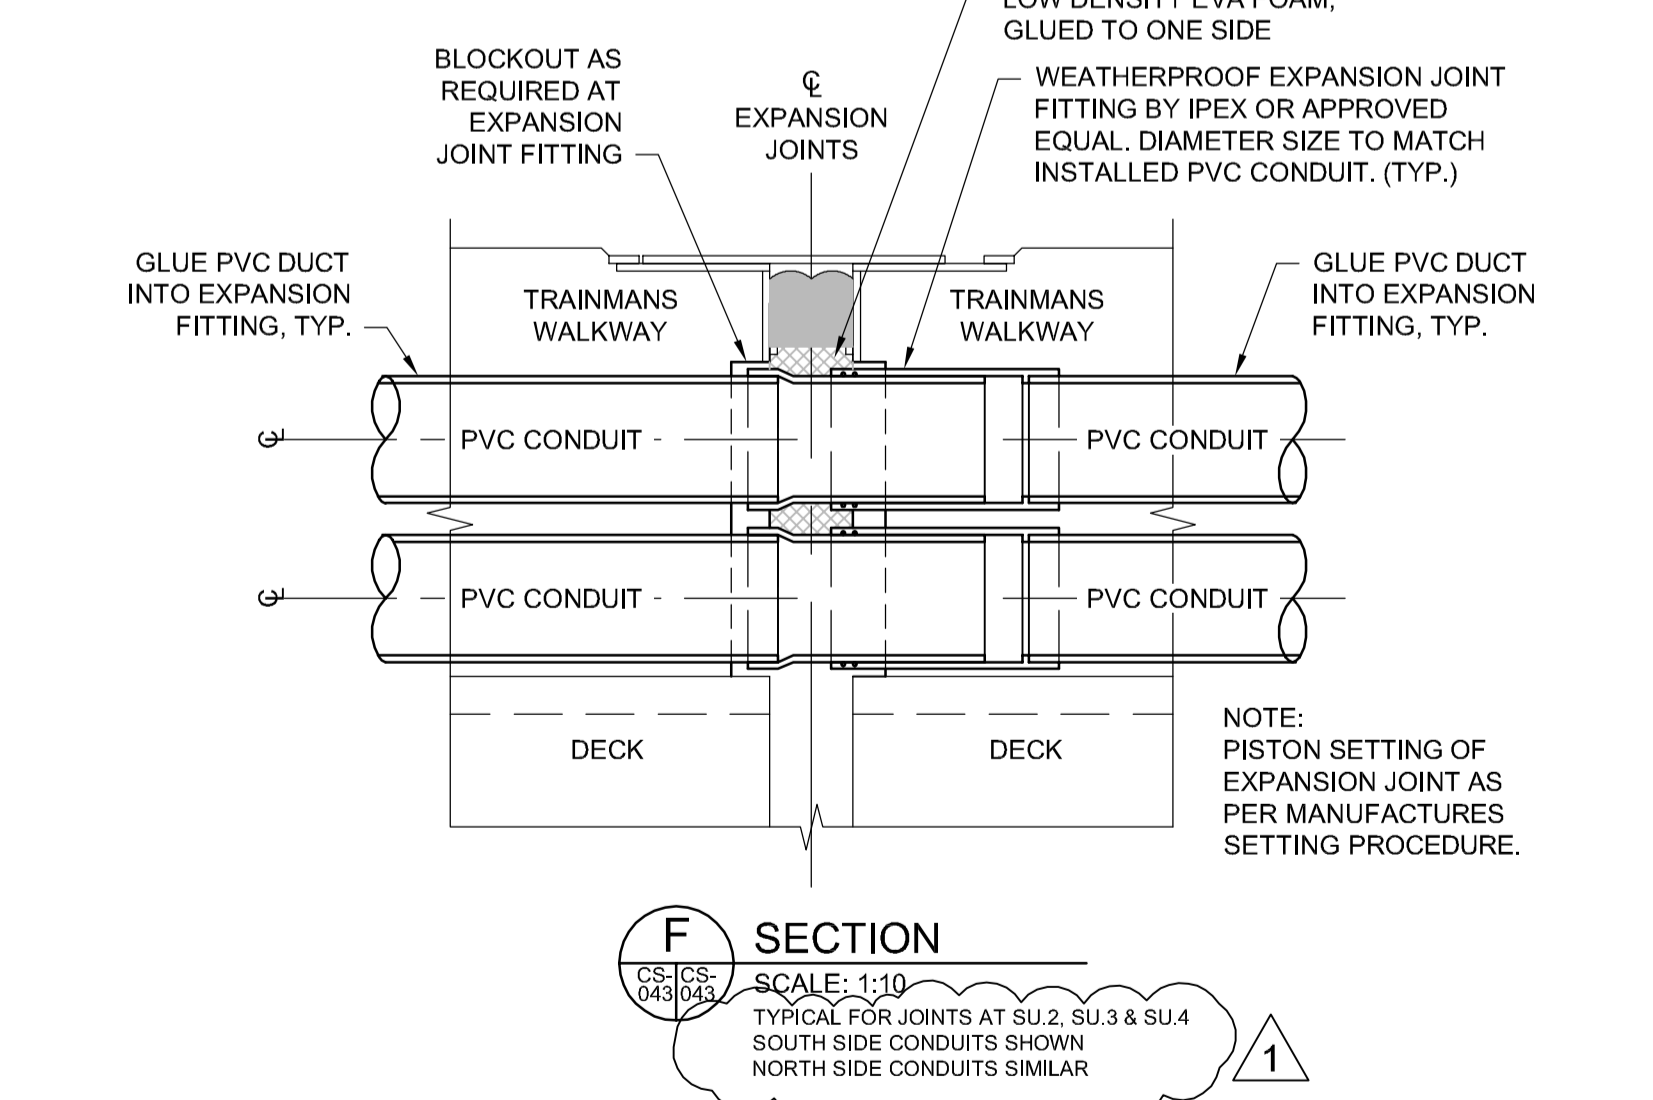

BILL OF MISCELLANEOUS METAL FOR TRAINMAN'S WALKWAY				
MARK	No.	DESCRIPTION	SIZE	MASS PER UNIT
"AU1"	70	PRE-SET ANCHOR UNIT - GALVANIZED	NCA ANCHOR FOR RAILING TYPE DGR-1 (MODIFIED AS SHOWN) C/W MACHINE BOLTS A307, 19 Ø x 70 LONG, PROVIDE NYLON BUSHING FOR 19 Ø BOLTS, 8-PLASTIC CAP PLUGS, PLATE, LOCK WASHERS AND PLYWOOD SETTING TEMPLATE - AS DETAILED	8.165
TOTAL MASS				571.55 kg

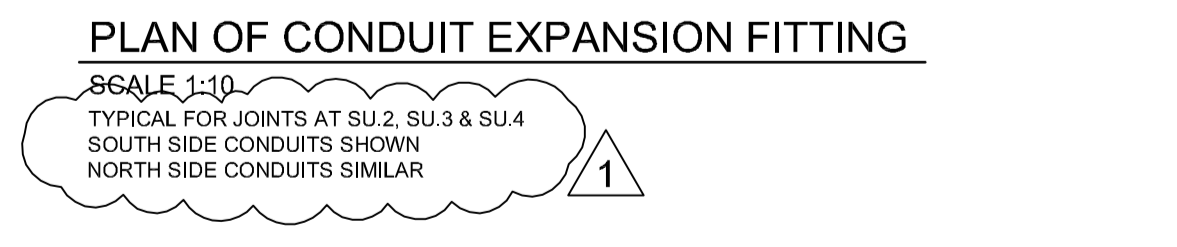

G:\CAD\163353\Technical\Workspace\Engineering\Drawings and Figures\Structures\163353-C2-CON-CS-TRAINMAN WALKWAY DETAILS.dwg



NO.	REVISIONS	DATE	BY	DATE
1	ADDENDUM #5	17/03/01	RE	
0	ISSUED FOR TENDER	17/01/09	RE	

	DESIGNED BY: RE DRAWN BY: CO HOR. SCALE: AS SHOWN VERTICAL: AS SHOWN	CHECKED BY: SSR APPROVED BY: DBW RELEASED FOR CONSTRUCTION	ENGINEER'S SEAL 	
	WAYERLEY STREET UNDERPASS AT CN MILE 3.89 RIVERS SUB CONTRACT 2: UNDERPASS STRUCTURE, RAILWORKS, ROADWORKS, LAND DRAINAGE SEWER, PUMPING STATION AND LANDSCAPING WORKS			CITY DRAWING NUMBER: U-239-2016-C2-CS-043 SHEET: 043 OF 085 CONSULTANT DRAWING NUMBER: C2-CS-043