


- NOTES:
1. ELECTRICAL CONTRACTOR SHALL PROVIDE TYPEWRITTEN, UPDATED PANELBOARD SCHEDULES FOR ALL EXISTING PANELBOARD DIRECTORIES AS REQUIRED.
 2. ELECTRICAL ITEMS SHOWN DOTTED ARE EXISTING AND SHALL REMAIN OR BE RELOCATED AS NOTED. EXTEND WIRING FOR ALL RELOCATED ITEMS.
 3. PAINT ALL JUNCTION BOXES TO MATCH EXISTING COLOUR CODING OF BUILDING SYSTEMS.
 4. WIRE AND CONNECT NEW TYPE A, B & G LUMINAIRES TO EXISTING CIRCUIT AND CONTROL. CONFIRM EXISTING ON SITE.

1 NEW MAIN FLOOR LIGHTING PLAN
3/16" = 1'-0"

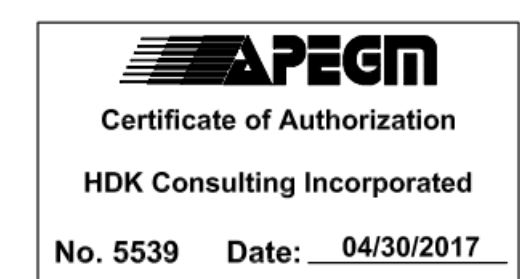

bridgmancollaborative
 Architecture
 678 MAIN STREET WINNIPEG, MB R3B 1E4
 204 488 3857 tel. 204 488 0216 fax. www.bridgmancollaborative.ca

HDK CONSULTING INCORPORATED
 www.hdkconsulting.com
 hdk@hdkconsulting.com

Winnipeg
 THE CITY OF WINNIPEG PLANNING, PROPERTY AND DEVELOPMENT DEPARTMENT
 MUNICIPAL ACCOMMODATIONS DIVISION
 4TH FLOOR - 185 KING STREET
 R3B 1J1

Project:
 St. Vital Library

8 Fernor Ave. Winnipeg Manitoba
 Project Number: 16054
 Bid Opportunity Number: 788-2016

Drawing Title:
 NEW MAIN FLOOR LIGHTING PLAN

#	Issue/Revision	Date
1	ISSUED FOR CONSTRUCTION	SEPT 09, 2016
2	ADDENDUM #1	OCT 31, 2016
3	ADDENDUM #2	DEC 05, 2016

Sheet No: E-9

This drawing is property of the Architect and cannot be reproduced or used without the consent of the Architect. The contractor is responsible for checking and verifying all levels and dimensions and shall report all discrepancies to the Architect and obtain clarification prior to commencing work.