

NOTE:
 1. REPAIR ALL DAMAGE TO EXISTING DURING DEMOLITION WORK TO MATCH EXISTING

SEALING ARCHITECT OR ENGINEER ACCEPTS RESPONSIBILITY ONLY FOR AREAS IDENTIFIED BY CLOUDING ON THIS DRAWING.
 NOTE: THIS DRAWING SUPERSEDES DRAWING SEP-51




NO.	REVISIONS	DATE	DESIGN	CHECK
03	ISSUED FOR ADDENDUM 7 - 976-2016	2017/07/20	JBC	
02	ISSUED FOR CONSTRUCTION - 976-2016	2017/04/05	R.B. J.C.	
01	ISSUED FOR CONSTRUCTION	10/2015	N.B. J.C.	
00	ISSUED FOR TENDER	08/2015	N.B. J.C.	

CH2MHILL CANADA
 Architects Inc.

DESIGNED BY: R. ZAKKO
 CHECKED BY: W. YU
 DRAWN BY: R. BATHAN
 APPROVED BY: H.T. FRIEHAMMER

SCALE: 1:50
 DATE: 2017/04/05
 ISSUED FOR CONSTRUCTION BY: J. SHUMKA
 DATE: 2017/04/05

CONSULTANT NO.: 474248

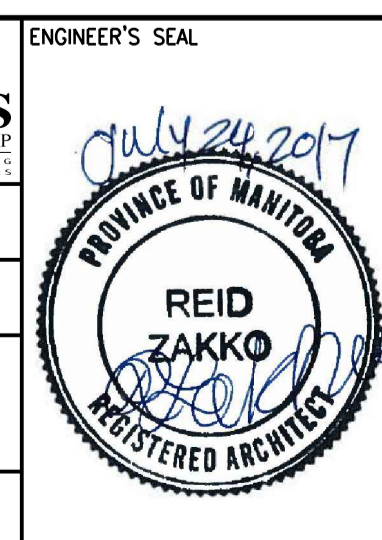

THE CITY OF WINNIPEG
 WATER AND WASTE DEPARTMENT

SOUTH END WATER POLLUTION CONTROL CENTRE
 SEWPCC UPGRADING/EXPANSION PROJECT
 BUILDING
 PRIMARY CLARIFICATION BUILDING
 EXISTING FLOOR PLAN EL 752'-00"

CITY DRAWING NUMBER: 1-0102-BGAD-PD50
 SHEET: 001
 REV: 03
 SIZE: A1