



DRYWELL MECHANICAL ROOM **08** PHOTO
MGAD-G604

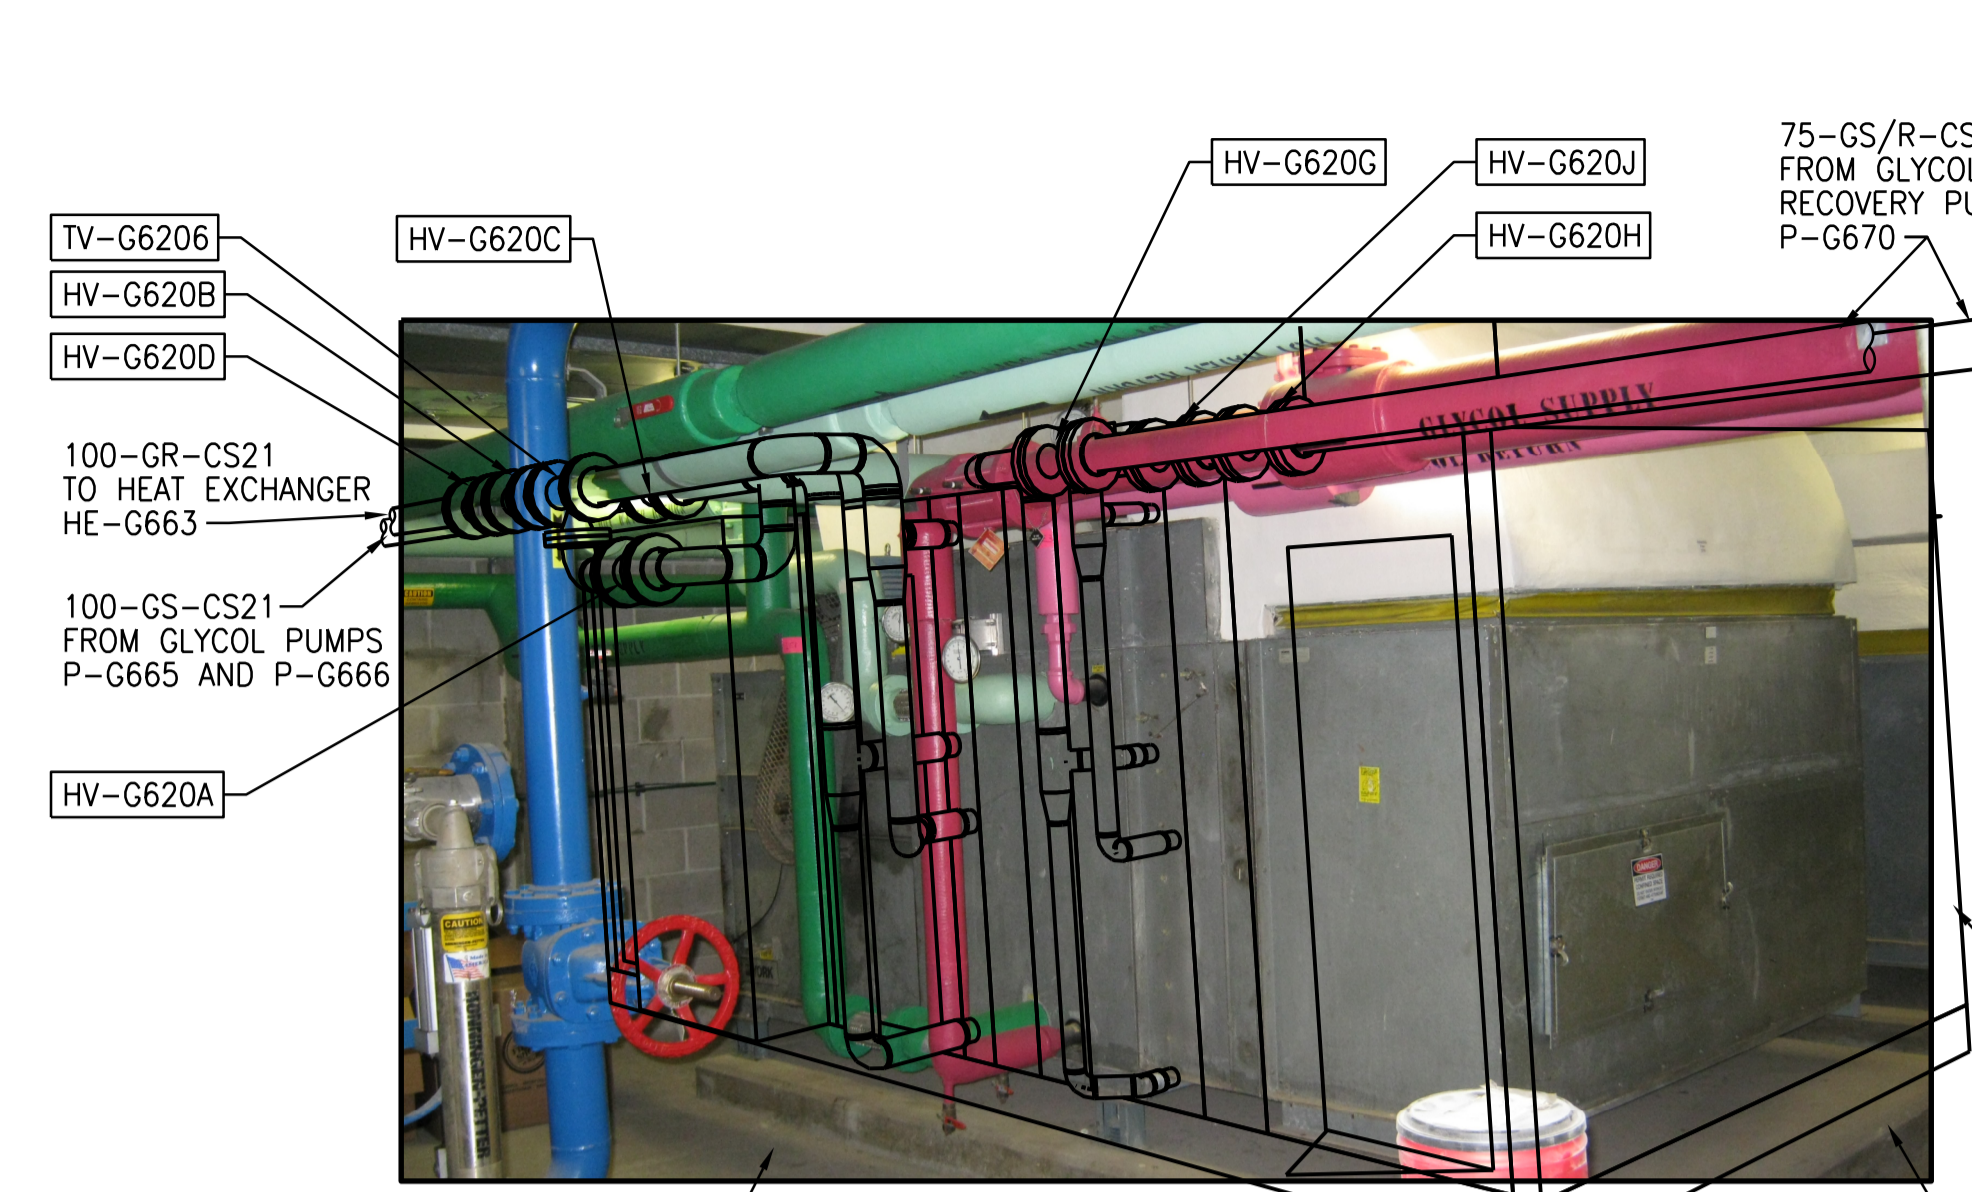

DRYWELL MECHANICAL ROOM **09** PHOTO
MGAD-G604

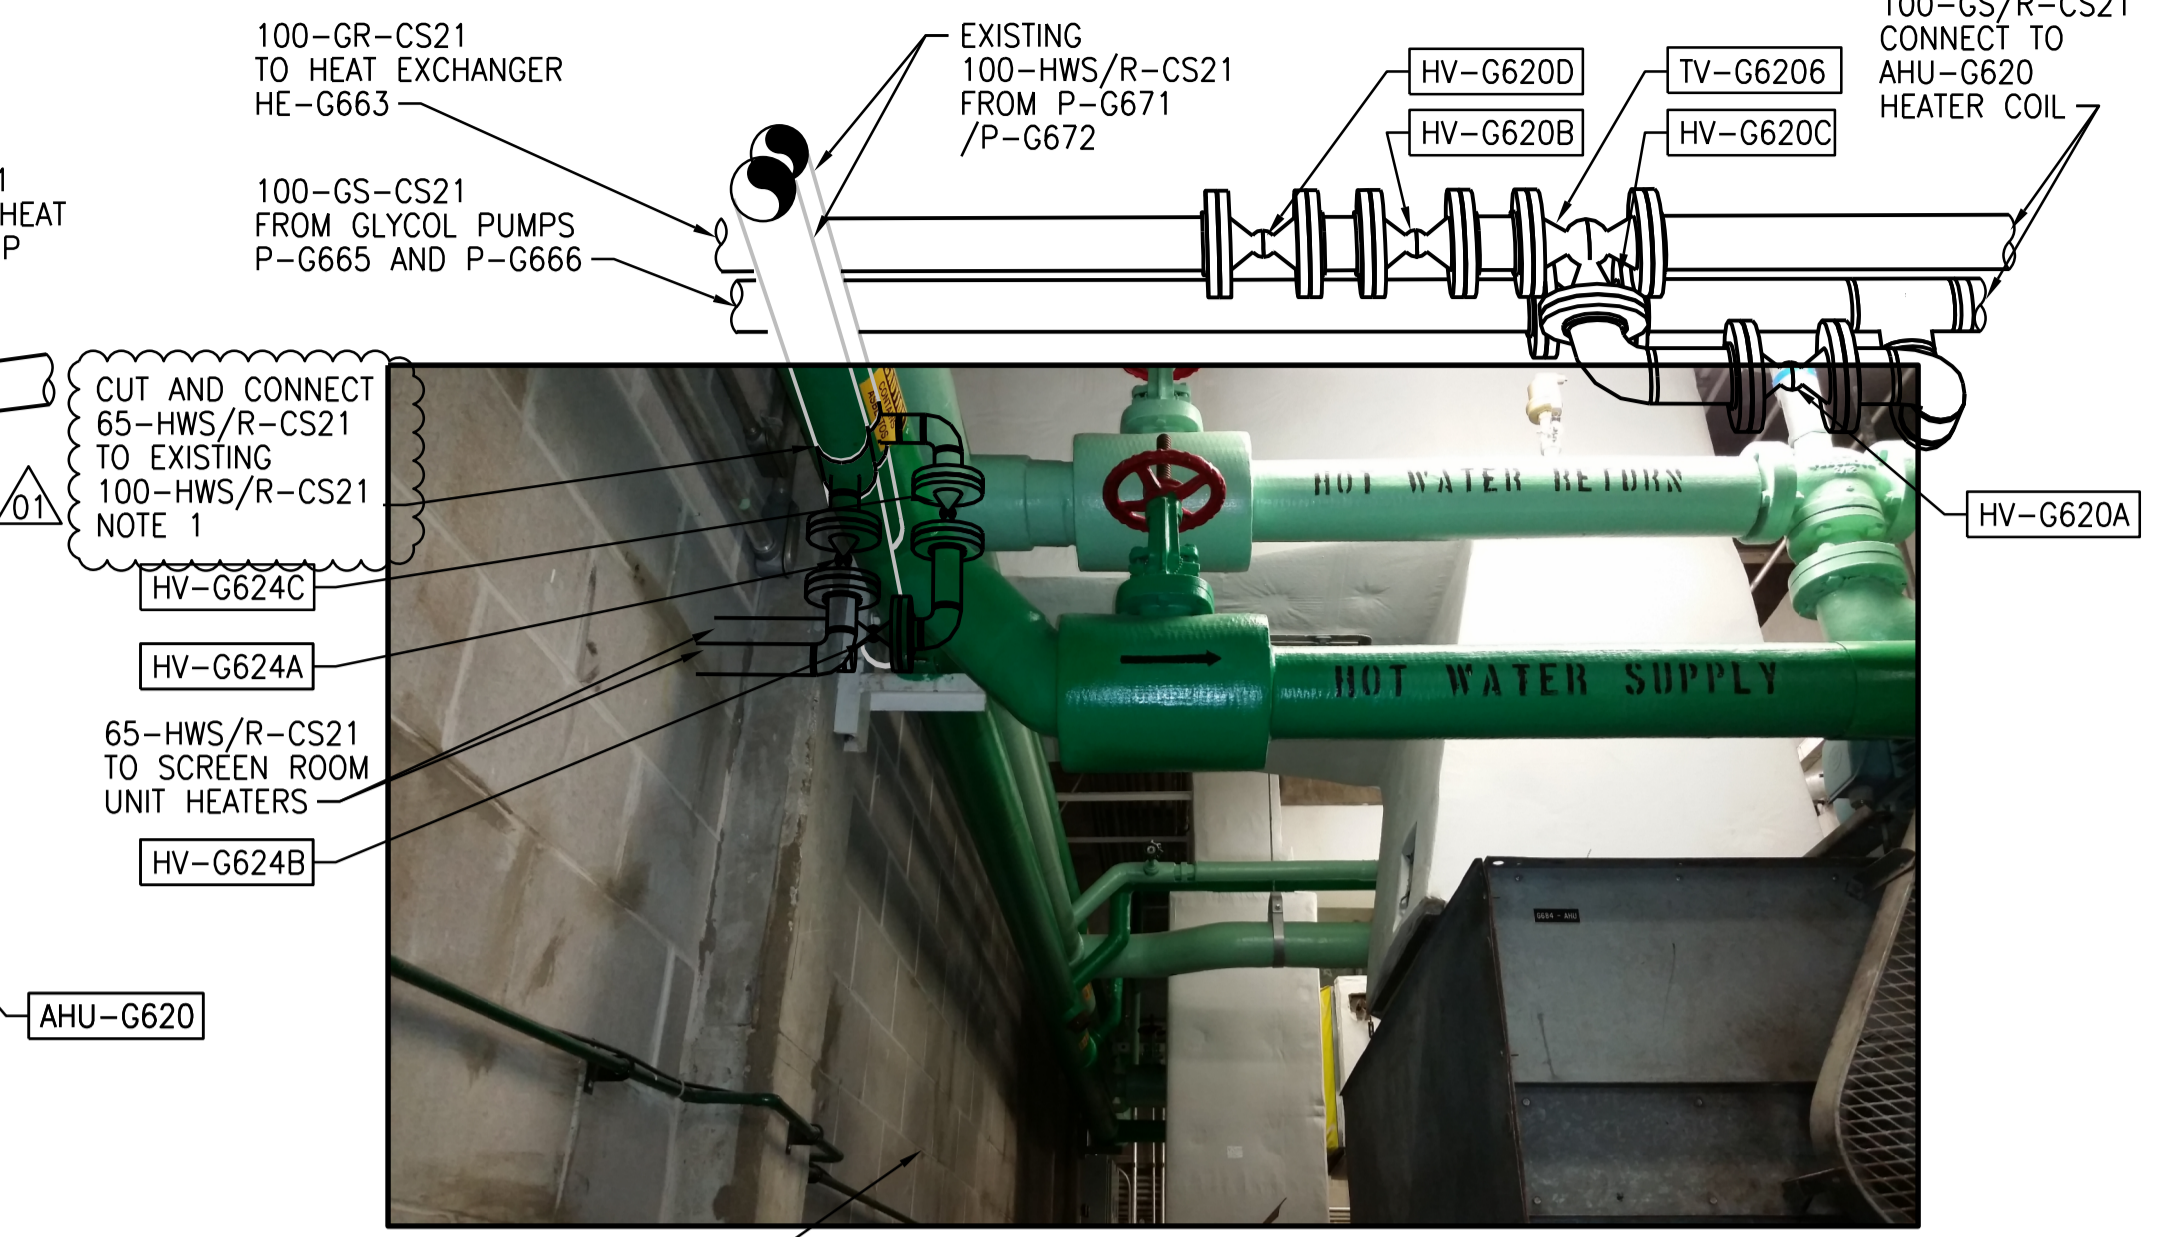

DRYWELL MECHANICAL ROOM **10** PHOTO
MGAD-G604



SERVICE BUILDING MECHANICAL ROOM **11** PHOTO
MGAD-G605

NOTES:

1. CONFIRMED ASBESTOS CONTAINING MATERIAL IN HEATING WATER FITTINGS INSULATION. REFER TO ASBESTOS ABATEMENT SPECIFICATIONS FOR ABATEMENT PROCEDURES.
2. CONFIRMED ASBESTOS CONTAINING MATERIAL DUCTWORK INSULATION. REFER TO ASBESTOS ABATEMENT SPECIFICATIONS FOR ABATEMENT PROCEDURES.

APEGM
Certificate of Authorization
CH2M HILL Canada Ltd.
No. 1441

NO.	REVISIONS	DATE	DESIGN	CHECK
01	ISSUED FOR ADDENDUM 7 - 976-2016	2017/07/20	JBC	
00	ISSUED FOR CONSTRUCTION - 976-2016	2017/04/05	K.F.	J.C.

CH2MHILL		KCS GROUP	
DESIGNED BY: R. BLACKWOOD	CHECKED BY: T. TRAN	APPROVED BY: H.T. FREIHAMMER	ISSUED FOR CONSTRUCTION BY: J. SHUMKA
DRAWN BY: K. FONG	SCALE: NTS	DATE: 2017/04/05	DATE: 2017/04/05
CONSULTANT NO.: 474248			

ENGINEER'S SEAL
July 24, 2017
PROVINCE OF MANITOBA
R.P.C. BLACKWOOD
Member
40579
REGISTERED PROFESSIONAL ENGINEER

THE CITY OF WINNIPEG
Winnipeg WATER AND WASTE DEPARTMENT

SOUTH END WATER POLLUTION CONTROL CENTRE
SEWPCC UPGRADING/EXPANSION PROJECT
MECHANICAL
GRIT AND SCREENINGS BUILDING
HVAC - PHOTOS (2)

CITY DRAWING NUMBER: 1-0102-MGAD-G610 SHEET: 01 REV: 01 SIZE: A1