

REMOVE EXISTING 150-STM/LPS AND 38-COND LINES AND ALL ASSOCIATED CONNECTIONS THROUGHOUT GALLERY 3 AND REST OF BUILDING. SEE DEMOLITION PHOTO 1.

NOTE 2.

NOTE: WHERE CONCRETE ENCASED PIPING CROSSES A BLDG. EXPANSION JOINT, PIPE SHALL BE WRAPPED USING 1/2\"/>


SECTION 9
M522/524



1 DEMOLITION PHOTO
NTS

NOTES:

- REFER TO GENERAL DEMOLITION NOTES DRAWING 1-0102-DAAA-AD01.
- CONFIRMED ASBESTOS CONTAINING MATERIALS IN HIGH AND LOW PRESSURE STEAM FITTINGS INSULATION. REFER TO ASBESTOS ABATEMENT SPECIFICATIONS FOR ABATEMENT PROCEDURES.

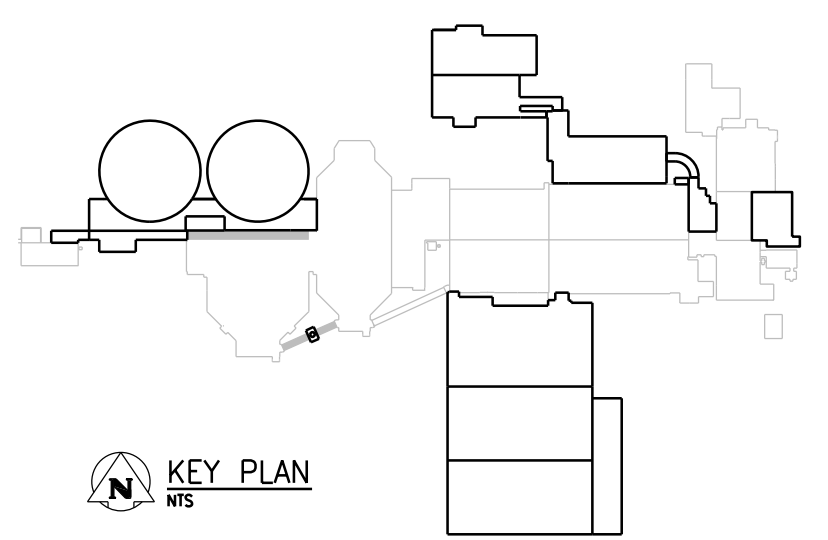

APEGM
Certificate of Authorization
CH2M HILL Canada Ltd.
No. 1441

NO.	REVISIONS	DATE	DESIGN	CHECK
01	ISSUED FOR ADDENDUM 7 -976-2016	2017/07/20	JBC	
00	ISSUED FOR CONSTRUCTION - 976-2016	2016/12/16	B.C.	J.C.

CH2MHILL		KCS GROUP	
SNC-LAVALIN			
DESIGNED BY: X.X.	CHECKED BY: F. ABSI	ENGINEER'S SEAL	
DRAWN BY: B. COOPER	APPROVED BY: H.T. FREIHAMMER		
SCALE: NTS	ISSUED FOR CONSTRUCTION BY: J. SHUMKA		
DATE: 2017/04/05	DATE: 2017/04/05		
CONSULTANT NO.: 474248			

SEALING ARCHITECT OR ENGINEER ACCEPTS RESPONSIBILITY ONLY FOR AREAS IDENTIFIED BY CLOUDING ON THIS DRAWING.		
NOTE: THIS DRAWING SUPERSEDES DRAWING SEP-81		
THE CITY OF WINNIPEG WATER AND WASTE DEPARTMENT		
SOUTH END WATER POLLUTION CONTROL CENTRE SEWPCC UPGRADING/EXPANSION PROJECT PROCESS UNOX & SLUDGE THICKENING SECONDARY PUMP GALLERY - SECTIONS		
CITY DRAWING NUMBER 1-0102-PGAD-SD51	SHEET 001	REV. 01
		SIZE A1