


E SECTION
1:50

BGAD-G022
BGAD-G023
BGAD-G024


NOTES:

- FOR PIPE/DUCT PENETRATIONS SEE DETAILS 1,2,3,4 BDTL-A003
- PATTERN/HATCHING OF WATER/LIQUID IS FOR CLARIFICATION PURPOSES ONLY TO INDICATE AND DIFFERENTIATE WATER/LIQUID CONTAINING STRUCTURES FROM REMAINDER OF BUILDING AREAS. IT DOES NOT REPRESENT ACTUAL LEVEL, VOLUME OR EXTENT OF WATER/LIQUID IN THESE AREAS. REFER TO PROCESS MECHANICAL FOR SUCH REQUIREMENTS.
- DENOTES EXTENT OF FIRE RATED SEPARATION
--- HR ---
- DENOTES EXTENT OF FIRE WALL
--- HR ---

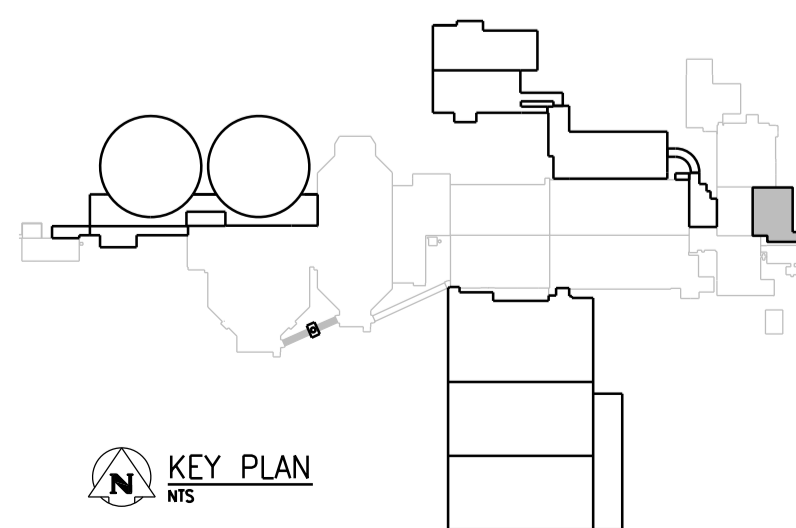

| NO. | REVISIONS | DATE | DESIGN | CHECK |
|-----|------------------------------------|------------|--------|-------|
| 01 | ISSUED FOR ADDENDUM 8 - 976-2016 | 2017/07/24 | R.B. | J.C. |
| 00 | ISSUED FOR CONSTRUCTION - 976-2016 | 2017/04/05 | J.L. | J.C. |

| | |
|---|--|
| CH2MHILL CANADA Architects Inc. | |
| DESIGNED BY: R. ZAKKO | CHECKED BY: B. KOLIS-HUPA |
| DRAWN BY: J. LIN | APPROVED BY: H.T. FRIEHAMMER |
| SCALE: 1:50 | ISSUED FOR CONSTRUCTION BY: J. SHUMKA DATE: 2017/04/05 |
| DATE: 2017/04/05 | |
| CONSULTANT NO.: 474248 | |

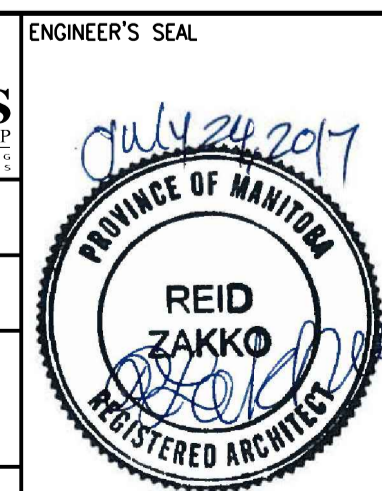

THE CITY OF WINNIPEG
Winnipeg WATER AND WASTE DEPARTMENT

SOUTH END WATER POLLUTION CONTROL CENTRE
SEWPCC UPGRADING/EXPANSION PROJECT
BUILDING
GRIT AND SCREENINGS BUILDING
SECTION E

| | | | |
|--|---------------------|-------------------|-------------------|
| CITY DRAWING NUMBER 1-0102-BGAD-G032 | SHEET 001 | REV. 01 | SIZE A1 |
|--|---------------------|-------------------|-------------------|