


F SECTION
1:50

BGAD-G022
BGAD-G023
BGAD-G024


NOTES:

- FOR PIPE/DUCT PENETRATIONS SEE DETAILS 1,2,3,4 BDTL-A003
- PATTERN/HATCHING OF WATER/LIQUID IS FOR CLARIFICATION PURPOSES ONLY TO INDICATE AND DIFFERENTIATE WATER/LIQUID CONTAINING STRUCTURES FROM REMAINDER OF BUILDING AREAS. IT DOES NOT REPRESENT ACTUAL LEVEL, VOLUME OR EXTENT OF WATER/LIQUID IN THESE AREAS. REFER TO PROCESS MECHANICAL FOR SUCH REQUIREMENTS.
- DENOTES EXTENT OF FIRE RATED SEPARATION HR
- DENOTES EXTENT OF FIRE WALL HR

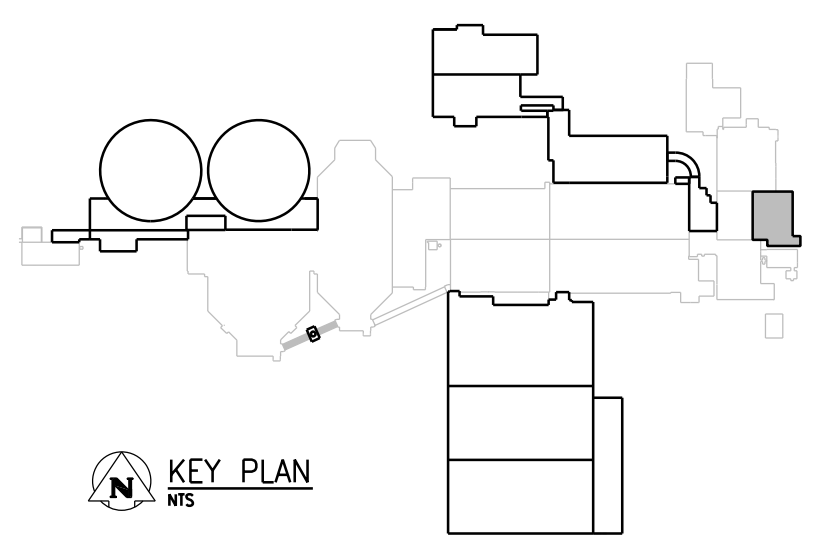

NO.	REVISIONS	DATE	DESIGN	CHECK
01	ISSUED FOR ADDENDUM 8 - 976-2016	2014/07/24	R.B.	J.C.
00	ISSUED FOR CONSTRUCTION - 976-2016	2017/04/05	J.L.	J.C.

CH2MHILL CANADA Architects Inc.	
DESIGNED BY: R. ZAKKO	CHECKED BY: B. KOLIS-HUPA
DRAWN BY: J. LIN	APPROVED BY: H.T. FRIEHAMMER
SCALE: 1:50	ISSUED FOR CONSTRUCTION BY: J. SHUMKA
DATE: 2017/04/05	DATE: 2017/04/05
CONSULTANT NO.: 474248	

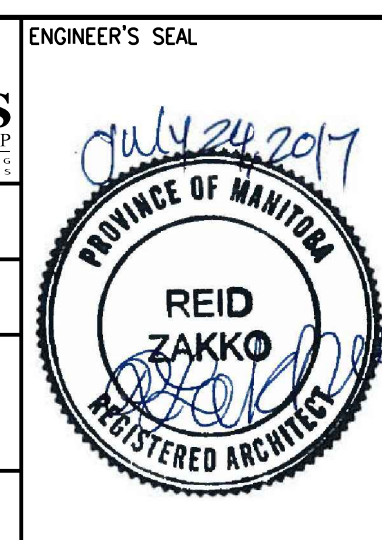

THE CITY OF WINNIPEG
Winnipeg WATER AND WASTE DEPARTMENT

SOUTH END WATER POLLUTION CONTROL CENTRE
SEWPC UPGRADING/EXPANSION PROJECT
BUILDING
GRIT AND SCREENINGS BUILDING
SECTION F

CITY DRAWING NUMBER: 1-0102-BGAD-G033 | SHEET: 001 | REV: 01 | SIZE: A1