N

Supply and Install 912 mm (36") high Timber Fencing (13LM)

Supply and Install Additional Gabion Wall c/w Limestone Rip-Rap Fill (6 LM)

Pick Up and Install Composite Backed Bench as per SCD-121-A

Supply and Install Topsoil and Sod Throughout (2320 SM)

Supply and Install 184mm x 184mm PT Wood Bollards (31)

Supply and Install Barkman Roman Pisa Retaining Wall (30 SM)

Supply and Install Additional Custom Concrete and Cedar Bench (4.5 LM)

Supply and Install Chained Vehicle Access Gate as per SCD-105-G

Supply and Install Custom Concrete and Cedar Benches 1 (11.1 LM)

Supply and Install CIP Concrete Curbs (150mm Depth w/ Varying Width) (19 SM)

Supply and Install Limestone Boulders for Seating (10)

Pick up and Install Steel Firepits as per SCD 155 (2)

Pick Up and Install Picnic Table

Pick Up and Install Double-Sided Park Sign as per SCD-153

Pick Up and Install Metal Slat Waste Receptacle as per SCD-119 (3)

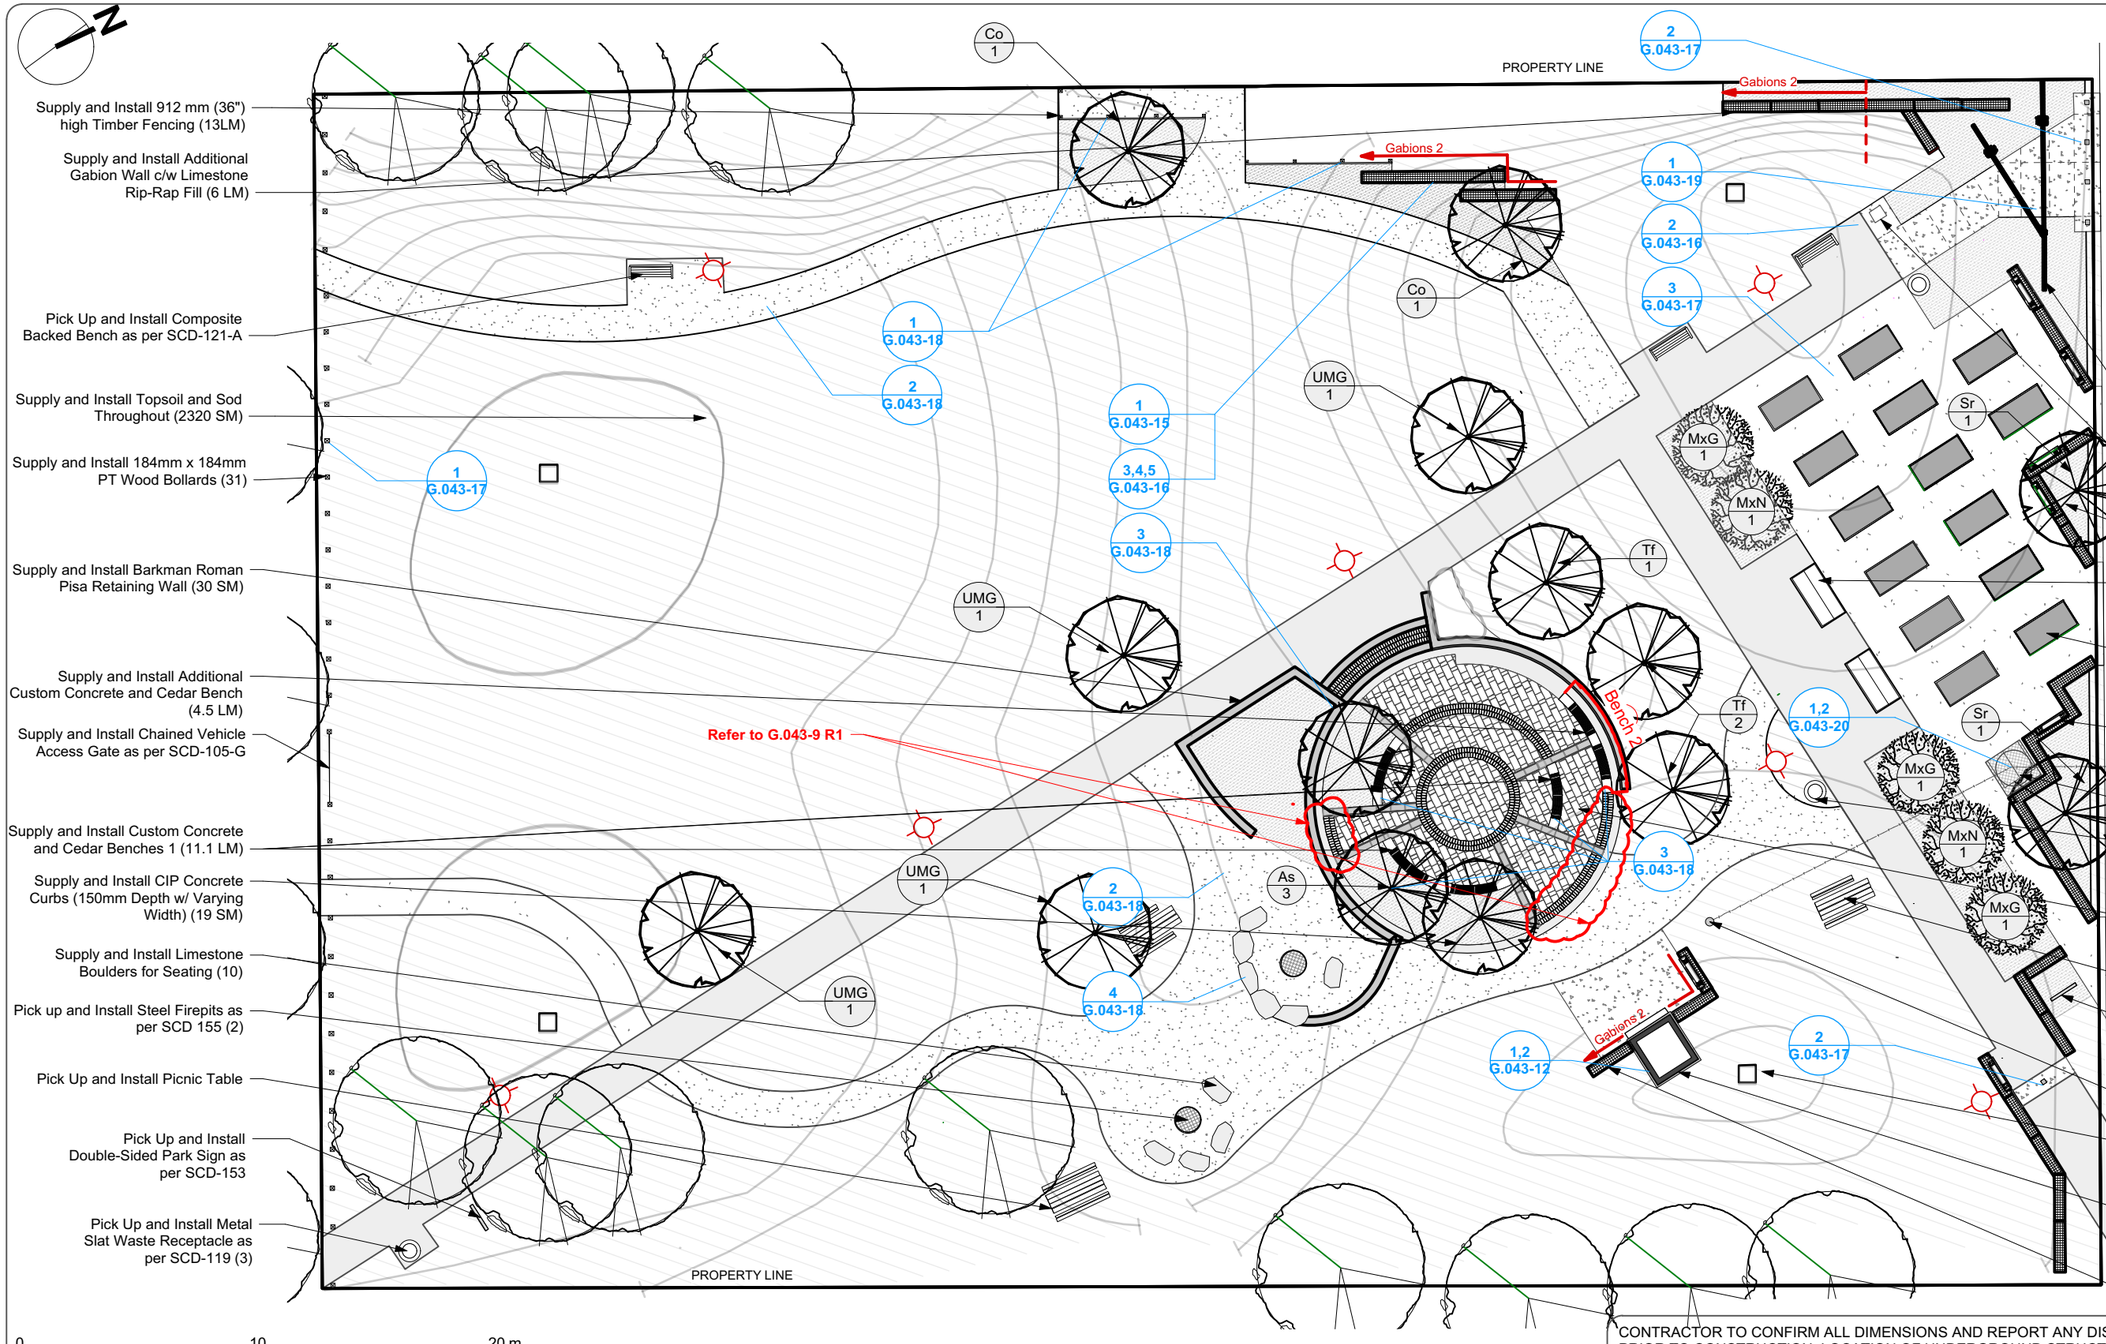

0 10 20 m

LEGEND

- Supply and Install Asphalt Path as per SCD 648 (257 SM)
- Supply and Install Compacted Gravel Path w/ Black Granite Top Coat (345 SM)
- Supply and Install 125mm (5") CIP Concrete (48 SM)
- Supply and Install Compacted Gravel b/w Planter Boxes (176 SM)
- Supply and Install Wood Chip Mulch (112 SM)
- Supply and Install Light Posts and Luminaires c/w Electrical Service, Trenching and Cabling

Supply and Install Painted Galvanized Steel and Cedar Entry Feature

Supply and Install Painted Galvanized Stand for Dedication Plaque - (Plaque by Others) (1)

Supply and Install Planting Beds (36 CM)

Pick Up and Install Accessible Raised Multi-Level Cedar Garden Beds as per SCD-653A plus Supply and Install Planting Soil

Pick Up and Install Raised Cedar Garden Beds as per SCD-654A plus Supply and Install Planting Soil

Supply and Install Gabion Baskets c/w Limestone Rip-Rap Fill and Seating as per Details (51 LM + 6 Bench Units)

Supply and Install New Summer Water Service as per CW3530, Details and SD241B

Pick Up and Install Metal Slat Waste Receptacle as per SCD-119

Supply and Install Paving Stone Seating Area (83 SM)

Pick Up and Install Accessible Composite Picnic Table

Reinstall Double-Sided Park Sign as per SCD-153

Supply and Install Ground Hydrant and Hose Bib Connection at Community Oven (1)

Supply and Install Catch Basin (4)

Supply and Install New Community Oven

Supply and Install Additional Gabion Wall c/w Limestone Rip-Rap Fill and Seating as per Details (6 LM + 1 Bench Unit)

CONTRACTOR TO CONFIRM ALL DIMENSIONS AND REPORT ANY DISCREPANCIES TO CONTRACT ADMINISTRATOR PRIOR TO CONSTRUCTION. LOCATION OF UNDERGROUND STRUCTURES AS SHOWN ARE BASED ON THE BEST INFORMATION AVAILABLE BUT NO GUARANTEE IS GIVEN THAT ALL EXISTING UTILITIES ARE SHOWN OR THAT THE GIVEN LOCATIONS ARE EXACT. CONFIRMATION OF EXISTENCE AND EXACT LOCATION OF ALL SERVICES MUST BE OBTAINED FROM THE INDIVIDUAL UTILITIES BEFORE PROCEEDING WITH CONSTRUCTION.

Winnipeg

THE CITY OF WINNIPEG
Planning, Property and Development Department
Planning and Land Use Division
Unit 15 - 30 Fort Street, Winnipeg, MB, (R3C 4X5)

DESIGNED BY	IL/IM	CHECKED BY	
DRAWN BY	IL/IM	APPROVED BY	
HORIZ. SCALE / VERT. SCALE	1:300		
DATE	April 2018		

MANAGER, PARK AND OPEN SPACES — DATE

MANAGER, PLANNING AND LAND USE DIVISION — DATE

DRAWING TITLE

Gord Dong Park

REDEVELOPMENT

Materials Plan

SITE ADDRESS 348 Pacific Avenue

DRAWING NO.

G.043-3 R1

BID OPPORTUNITY NO.

54-2018