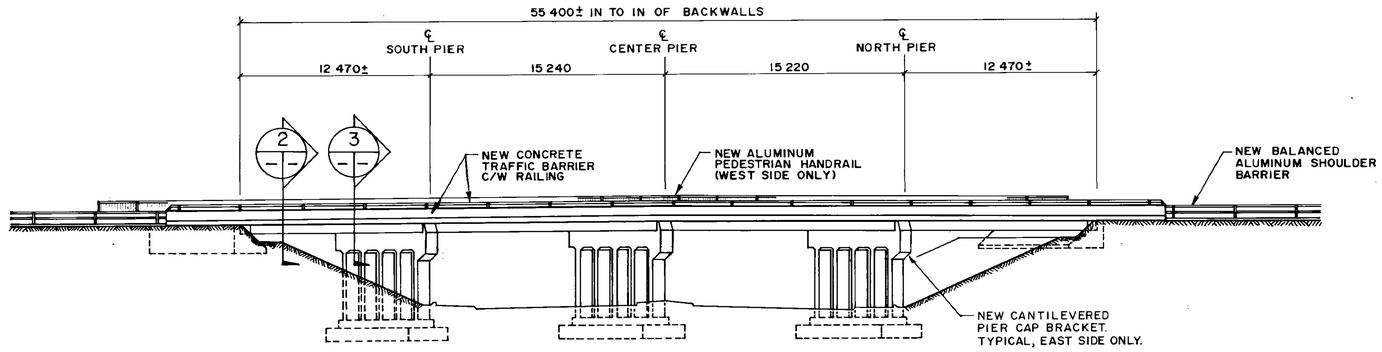

1 GENERAL ELEVATION AFTER REHABILITATION

1 : 200 (LOOKING WEST)

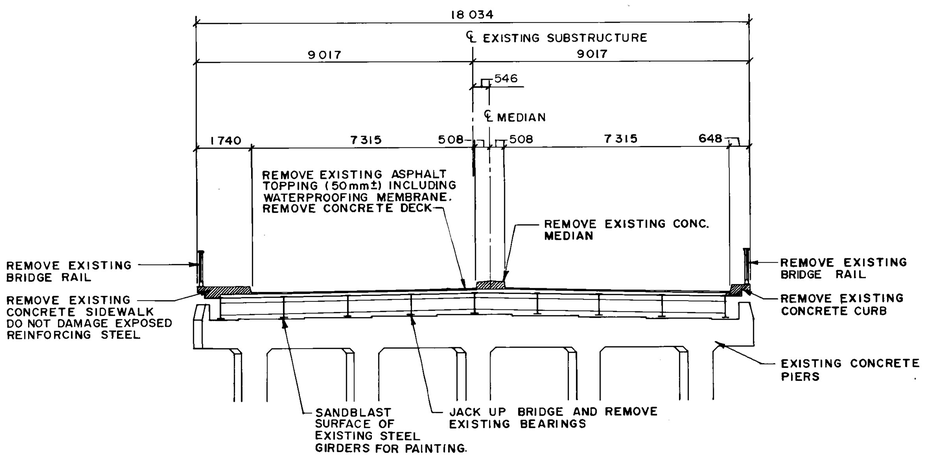

2 TYPICAL CROSS SECTION – DEMOLITION WORKS

1 : 100 (LOOKING NORTH)

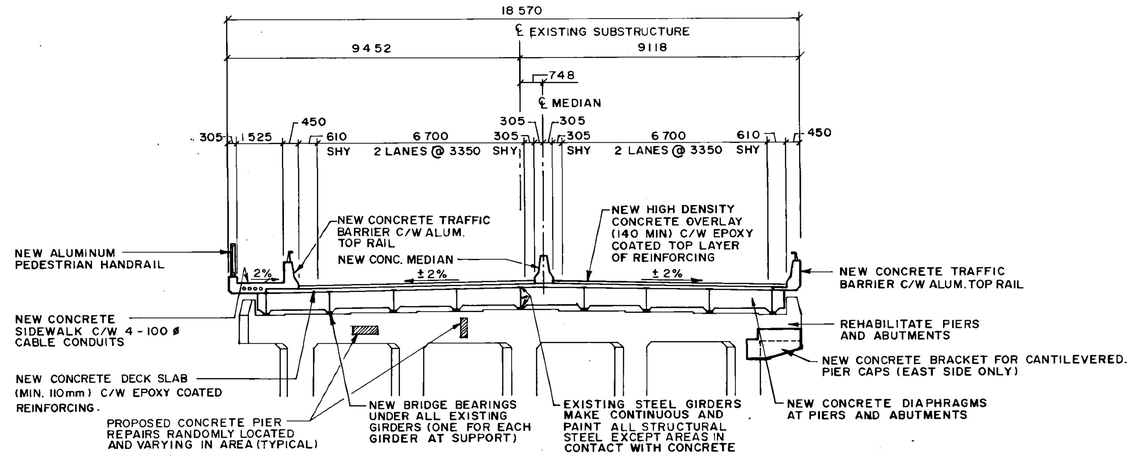

3 TYPICAL CROSS SECTION – NEW WORKS

1 : 100 (LOOKING NORTH)

B-5903-6

AS-BUILT
DATE 91.02.26 BY
CHECKED BY

LOCATION APPROVED
UNDERGROUND STRUCTURES
N/A
SUPV. U/G STRUCTURES COMMITTEE — DATE

NOTE:
LOCATION OF UNDERGROUND STRUCTURES AS SHOWN ARE BASED ON THE BEST INFORMATION AVAILABLE BUT NO GUARANTEE IS GIVEN THAT ALL EXISTING UTILITIES ARE SHOWN OR THAT THE GIVEN LOCATIONS ARE EXACT. CONFIRMATION OF EXISTENCE AND EXACT LOCATION OF ALL SERVICES MUST BE OBTAINED FROM THE INDIVIDUAL UTILITIES BEFORE PROCEEDING WITH CONSTRUCTION

B.M.
ELEV.

NO	REVISIONS	DATE	BY
1	REVISED AS CONSTRUCTED	901214	FPC

WARDROP ENGINEERING INC.

DESIGNED BY	JC & FPC	CHECKED BY	
DRAWN BY	LG	APPROVED BY	
HOR SCALE / VERTICAL	AS NOTED	AUTHORIZED BY / DATE	V. NAUMOV/STREETS & BRIDGES ENGINEER
DATE	JAN. 15, 1990	ACCEPTED BY / DATE	S.R. SMITH/BRIDGE ENGINEER

ENGINEER'S SEAL: PROVINCE OF MANITOBA — C. D. STEWART — 90/02/20 — REGISTERED ENGINEER

CONSULTANT DRAWING NO. 890007-02-00

THE CITY OF WINNIPEG
WORKS AND OPERATIONS DIVISION
STREETS AND TRANSPORTATION DEPARTMENT

EMPRESS STREET OVERPASS
STRUCTURE REHABILITATION, STRENGTHENING AND RELATED WORKS
GENERAL ELEVATION AND CROSS SECTIONS

CITY DRAWING NUMBER
B100-90-06A