ASBESTOS INVENTORY CONTROL



Planning, Property and Development Department Municipal Accommodations Division 4th Floor - 185 King Street • Winnipeg, MB • R3B 1J1

Building Name:	Roland Michener Indoor Arena	Inspection Date:	November 7, 2017
Building Code:	AR-07	Inspected By:	A Brodbeck N Richardson
Building Address:	1121 Wabasha Street	Construction Date:	1967

		Drawing	Material Condition	
Material Location	Material Description	Label		
	Drywall Compound throughout contains asbestos	DC		
Main Floor				
Gymnasium	12x12 Floor Tile	F12	Good	
	Drywall Compound	DC	Good	
Foyer	12x12 Floor Tile	F12	Removed	
	Drywall Compound - Ceiling	DC		
Office	12x12 Floor Tile	F12	Removed	
	Drywall Compound	DC		
Lobby	12x12 Floor Tile	F12	Removed	
Canteen Storage	12x12 Floor Tile - Located under cabinets	F12	Removed	
Canteen	12x12 Floor Tile - Located under cabinets	F12	Good	
	Drywall Compound	DC		
Storage Room	12x12 Floor Tile	F12	Good	
	Drywall Compound			
Women's Washroom	12x12 Floor Tile	F12	Removed	
	Drywall Compound - Ceiling	DC		
Men's Washroom	12x12 Floor Tile	F12	Removed	
	Drywall Compound - Ceiling	DC		
Block Wall between lobby and ice surface	Vermiculite	VE	Good	
Exterior block walls	Randomly inspected & appeared to be empty (Do not contain vermiculite insulation)			
Ice Shed				
Exterior block walls	Vermiculite	VE	Good	
Ice Shed (Southwest section)	Asphalt Plank Floor	APF	Good	


Status M/Y %	3 2 3 2 3 2 3
TESTED 3	2 3 2 3
TESTED 3	3
	3
	3
	3 2 3
	3
TESTED 0	
TESTED 0	2
	2
TESTED Oct'12 5	

		Drawing	Material	Testing	Date	Test	Est.
Material Location	Material Description	Label	Condition	Status	M/Y	%	%
] [
Basement							
Storage Room 1	12x12 Floor Tile	F12	Good				2
Storage Room 2	12x12 Floor Tile	F12	Good] [2
Dance Studio	12x12 Floor Tile	F12	Fair	TESTED	Mar'10	2	
	Drywall Compound - Columns	DC	Good				2
West Corridor	Pipe Fitting Insulation	PF	Good	TESTED	Mar'10	60	
North Corridor	Pipe Fitting Insulation	PF	Good	TESTED	Mar'10	40	
North/West/ East Corridor/ Dressing Rooms 1, 2, 3, 4	Asphalt Plank Floor (1 x 2 planks) (4 samples)			TESTED	Aug'15		0
East Corridor	Pipe Fitting Insulation	PF	Good				40-60
Referee's Room	Pipe Fitting Insulation	PF	Good	1			
	Asphalt Plank Floor (some 1 x 2 planks)			1			0
	Asphalt Plank Floor	APF	Good	1			5
Dressing Room 1	Pipe Fitting Insulation	PF	Good	1			50
1 2,3 4 Washrooms	Pipe Fitting Insulation	PF	Good	1			50
	Asphalt Plank Floor	APF	Good	1		3	
Dressing Room 4	Pipe Fitting Insulation	PF	Good	TESTED	Mar'10	50	
	Asphalt Plank Floor (1 x 2 planks)			TESTED	Jul'13	0	
	Pipe Trap Insulation			TESTED	Mar'10	0	
Dressing Room 3	Pipe Fitting Insulation	PF	Good				50
Water Meter Room	Pipe Elbow Insulation	PF	Removed				
Plant Room	Tank insulation is foam (not asbestos materials)						
	Pipe insulation is fiberglass or black foam			TESTED		0	
	Duct Insulation is fiber glass						
Hot Water / Boiler Room	Tank Insulation	TI		TESTED	Sep'10	0	
	Pipe insulation is fiberglass or black foam						
				11	I		

NOTES:

- 1. Asbestos inspections and inventory updates are conducted annually.
- 2. There may be asbestos containing materials present that were not located during asbestos inspections.
- 3. Floor tile and sheet flooring installed before 1990 may contain asbestos and must be treated as an asbestos containing material.
- 4. Vermiculite insulation may contain pockets of asbestos. All vermiculite insulation must be treated as an asbestos containing material.
- 5. For asbestos related inquiries, call Central Control at 986-2382

AR-07

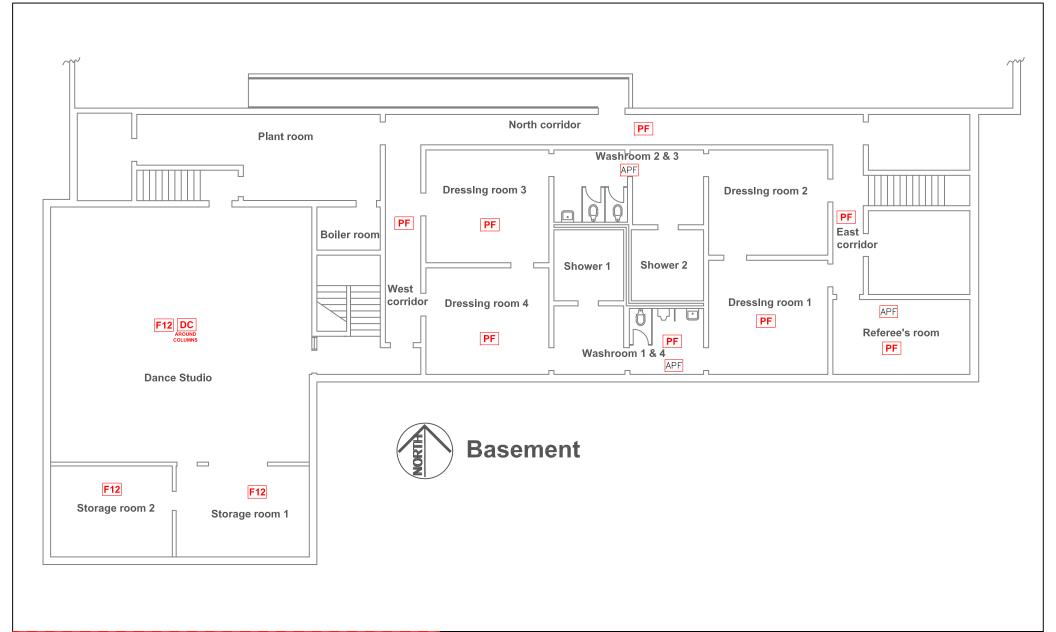



GENERAL LABELS

??

ABOVE

UNDER

WALL DETAIL

CEILING FLOORING

??=

AF:ASBESTOS FABRIC APF: ASPHALT PLANK FLOOR **BR:BOILER REFRACTORY** CA:CAULKING

C12: 12X12 CEILING TILE C24: 24X24 CEILING TILE C48: 24X48 CEILING TILE DC:DRYWALL COMPOUND

DI:DUCT INSULATION

FS:SHEET FLOORING F9: 9X9 FLOOR TILE F12: 12X12 FLOOR TILE HB:HARDBOARD MA:MASTIC PF:PIPE FITTING INSULATION PI:PIPE INSULATION PL:PLASTER RD:ROOF DRAIN

SC:STIPPLE CEILING SO:SPRAY ON ST:STUCCO **TI:TANK INSULATION** TP:TRANSITE PIPE **VE:VERMICULITE**

1. THERE MAY BE ASBESTOS CONTAINING MATERIALS PRESENT THAT WERE NOT LOCATED DURING BUILDING INSPECTIONS 2. REFER TO THE ASBESTOS INVENTORY SURVEY SHEET FOR MORE INFORMATION

3. DO NOT DISTURB ASBESTOS. FOR HANDLING PROCEDURES CALL CENTRAL CONTROL AT 986-2382

ASBESTOS LOCATIONS

BUILDING:

AR-07 Roland Michener Arena 1121 Wabasha St Winnipeg, Manitoba


REVISED BY: DATE: SCALE: SHEET# N.T.S. A.B. July 11, 2013



CITY OF WINNIPEG

PLANNING, PROPERTY & DEVELOPMENT DEPARTMENT MUNICIPAL ACCOMMODATIONS DIVISION 4th FLOOR - 185 KING STREET WINNIPEG, MANITOBA R3B 1J1

PHONE: (204) 986-7266 FAX: (204) 986-7311

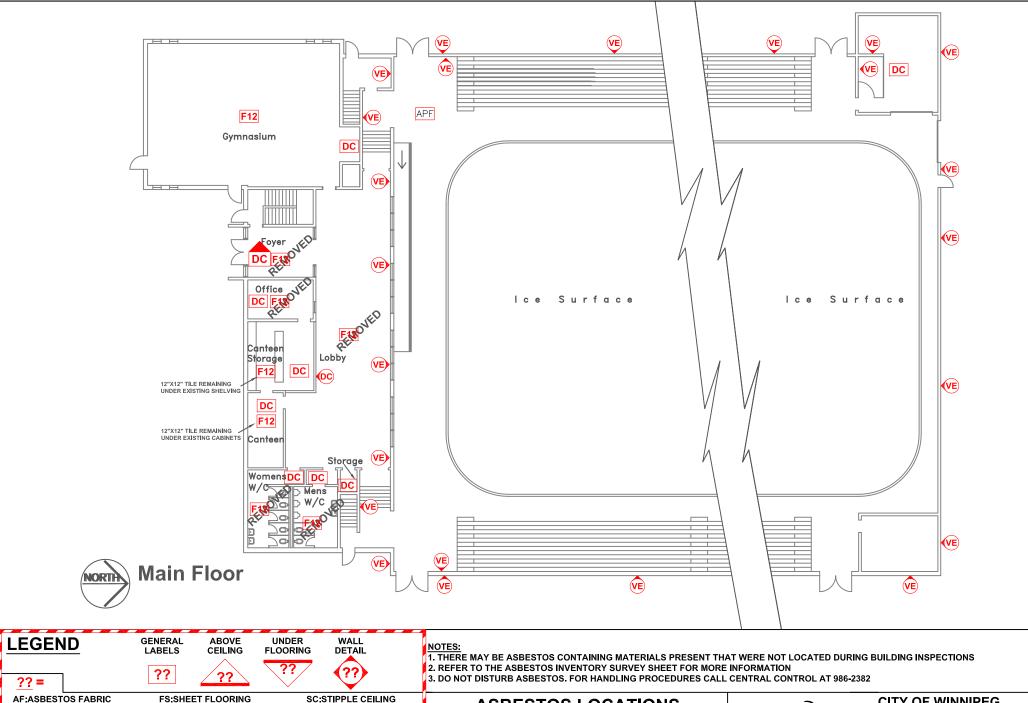

AF: ASBESTOS FABRIC APF: ASPHALT PLANK FLOOR **BR:BOILER REFRACTORY** CA:CAULKING

C12: 12X12 CEILING TILE C24: 24X24 CEILING TILE C48: 24X48 CEILING TILE DC:DRYWALL COMPOUND

ASBESTOS LOCATIONS

BUILDING: AR-07 Roland Michener Arena 1121 Wabasha St

Winnipeg, Manitoba DATE: SCALE: SHEET #: N.T.S. AB July 11, 2013



CITY OF WINNIPEG

PLANNING, PROPERTY & DEVELOMAENT DEPARTMENT MUNICIPAL ACCOMMODATIONS DIVISION 4th FLOOR - 185 KING STREET WINNIPEG, MANITOBA R3B 1J1

PHONE: (204) 986-7266 FAX: (204) 986-7311

DI:DUCT INSULATION RD:ROOF DRAIN

F9: 9X9 FLOOR TILE F12: 12X12 FLOOR TILE HB:HARDBOARD MA:MASTIC PF:PIPE FITTING INSULATION PI:PIPE INSULATION PL:PLASTER

SO:SPRAY ON

TI:TANK INSULATION

TP:TRANSITE PIPE

VE:VERMICULITE

ST:STUCCO

REVISED BY: