

1095-2019 ADDENDUM 1

SUPPLY AND DELIVERY OF BUS OPERATOR JACKETS

URGENT

PLEASE FORWARD THIS DOCUMENT TO WHOEVER IS IN POSSESSION OF THE TENDER

ISSUED: November 21, 2019 BY: Ron Martin TELEPHONE NO. 204 986-6864

THIS ADDENDUM SHALL BE INCORPORATED INTO THE TENDER AND SHALL FORM A PART OF THE CONTRACT DOCUMENTS

Please note the following and attached changes, corrections, additions, deletions, information and/or instructions in connection with the Tender, and be governed accordingly. Failure to acknowledge receipt of this Addendum in Paragraph 8 of Form A: Bid may render your Bid non-responsive.


PART D – SUPPLEMENTAL CONDITIONS

Revise:	D11.1.1 to read:	Goods shall be delivered within one hundred twenty (120) Calendar Day(s) of the placing of an order.
Revise:	D 11.2 to read:	Initial start-up delivery shall be one hundred (120) Business Day(s) from the date of award.

PART E – SPECIFICATIONS

Revise : E2.3 to read: All **sewn-on** reflective tape and Transit logo shall be silver in color.

Revise: On Drawing E2.4(a) to read: 1" sewn-on reflective tape and 2" sewn-on reflective tape.

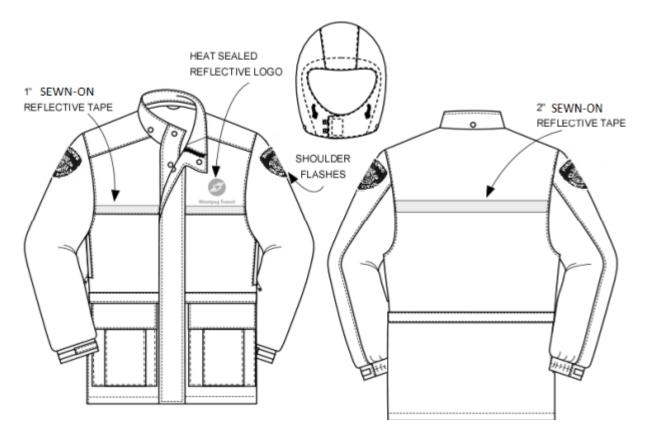


Tender No.1095-2019 Addendum 1 Page 2 of 3

Revise: E2.4.1 (ii) to read: **Sewn-on** reflective tape on front and back yokes and centre hood;

Revise: On Drawing E2.4.1 (b) to read:

1" Sewn-on reflective tape and 2" Sewn-on reflective tape.

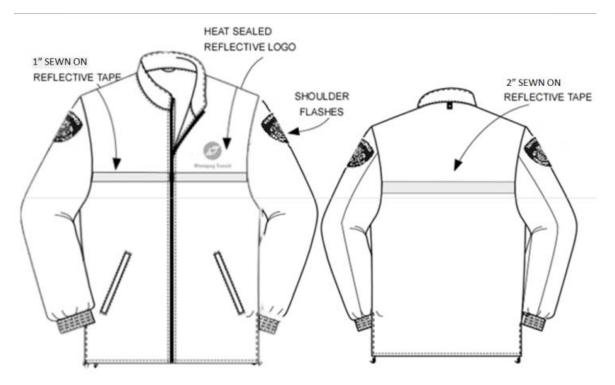

Revise: E2.4.2 (iv) to read: Sewn-on reflective on the front and back yokes;Revise: On Drawing E2.5 (a) to read: 1" Sewn-on reflective tape and 2" Sewn-on reflective tape.



Page 3 of 3	
Revise: E2.5.1(ii) to read:	Sewn-on reflective on the front and back yokes;
Revise E5.1(b)(ii) to read:	Sewn-on reflective tape 2" across back yoke set about 5 $\frac{3}{4}$ " above underarm point, and 1" wide at front yokes set $\frac{1}{2}$ " above seam;
Revise E9.1(b) to read:	There shall be a front yoke with a sewn- on 1" reflective tape set ½" above the yoke seam and a Winnipeg Transit heat sealed label will be set on the left front yoke 2" above the seam line;

Tender No.1095-2019 Addendum 1