


1 PSB - BUILDING SECTION
A23 NOT TO SCALE

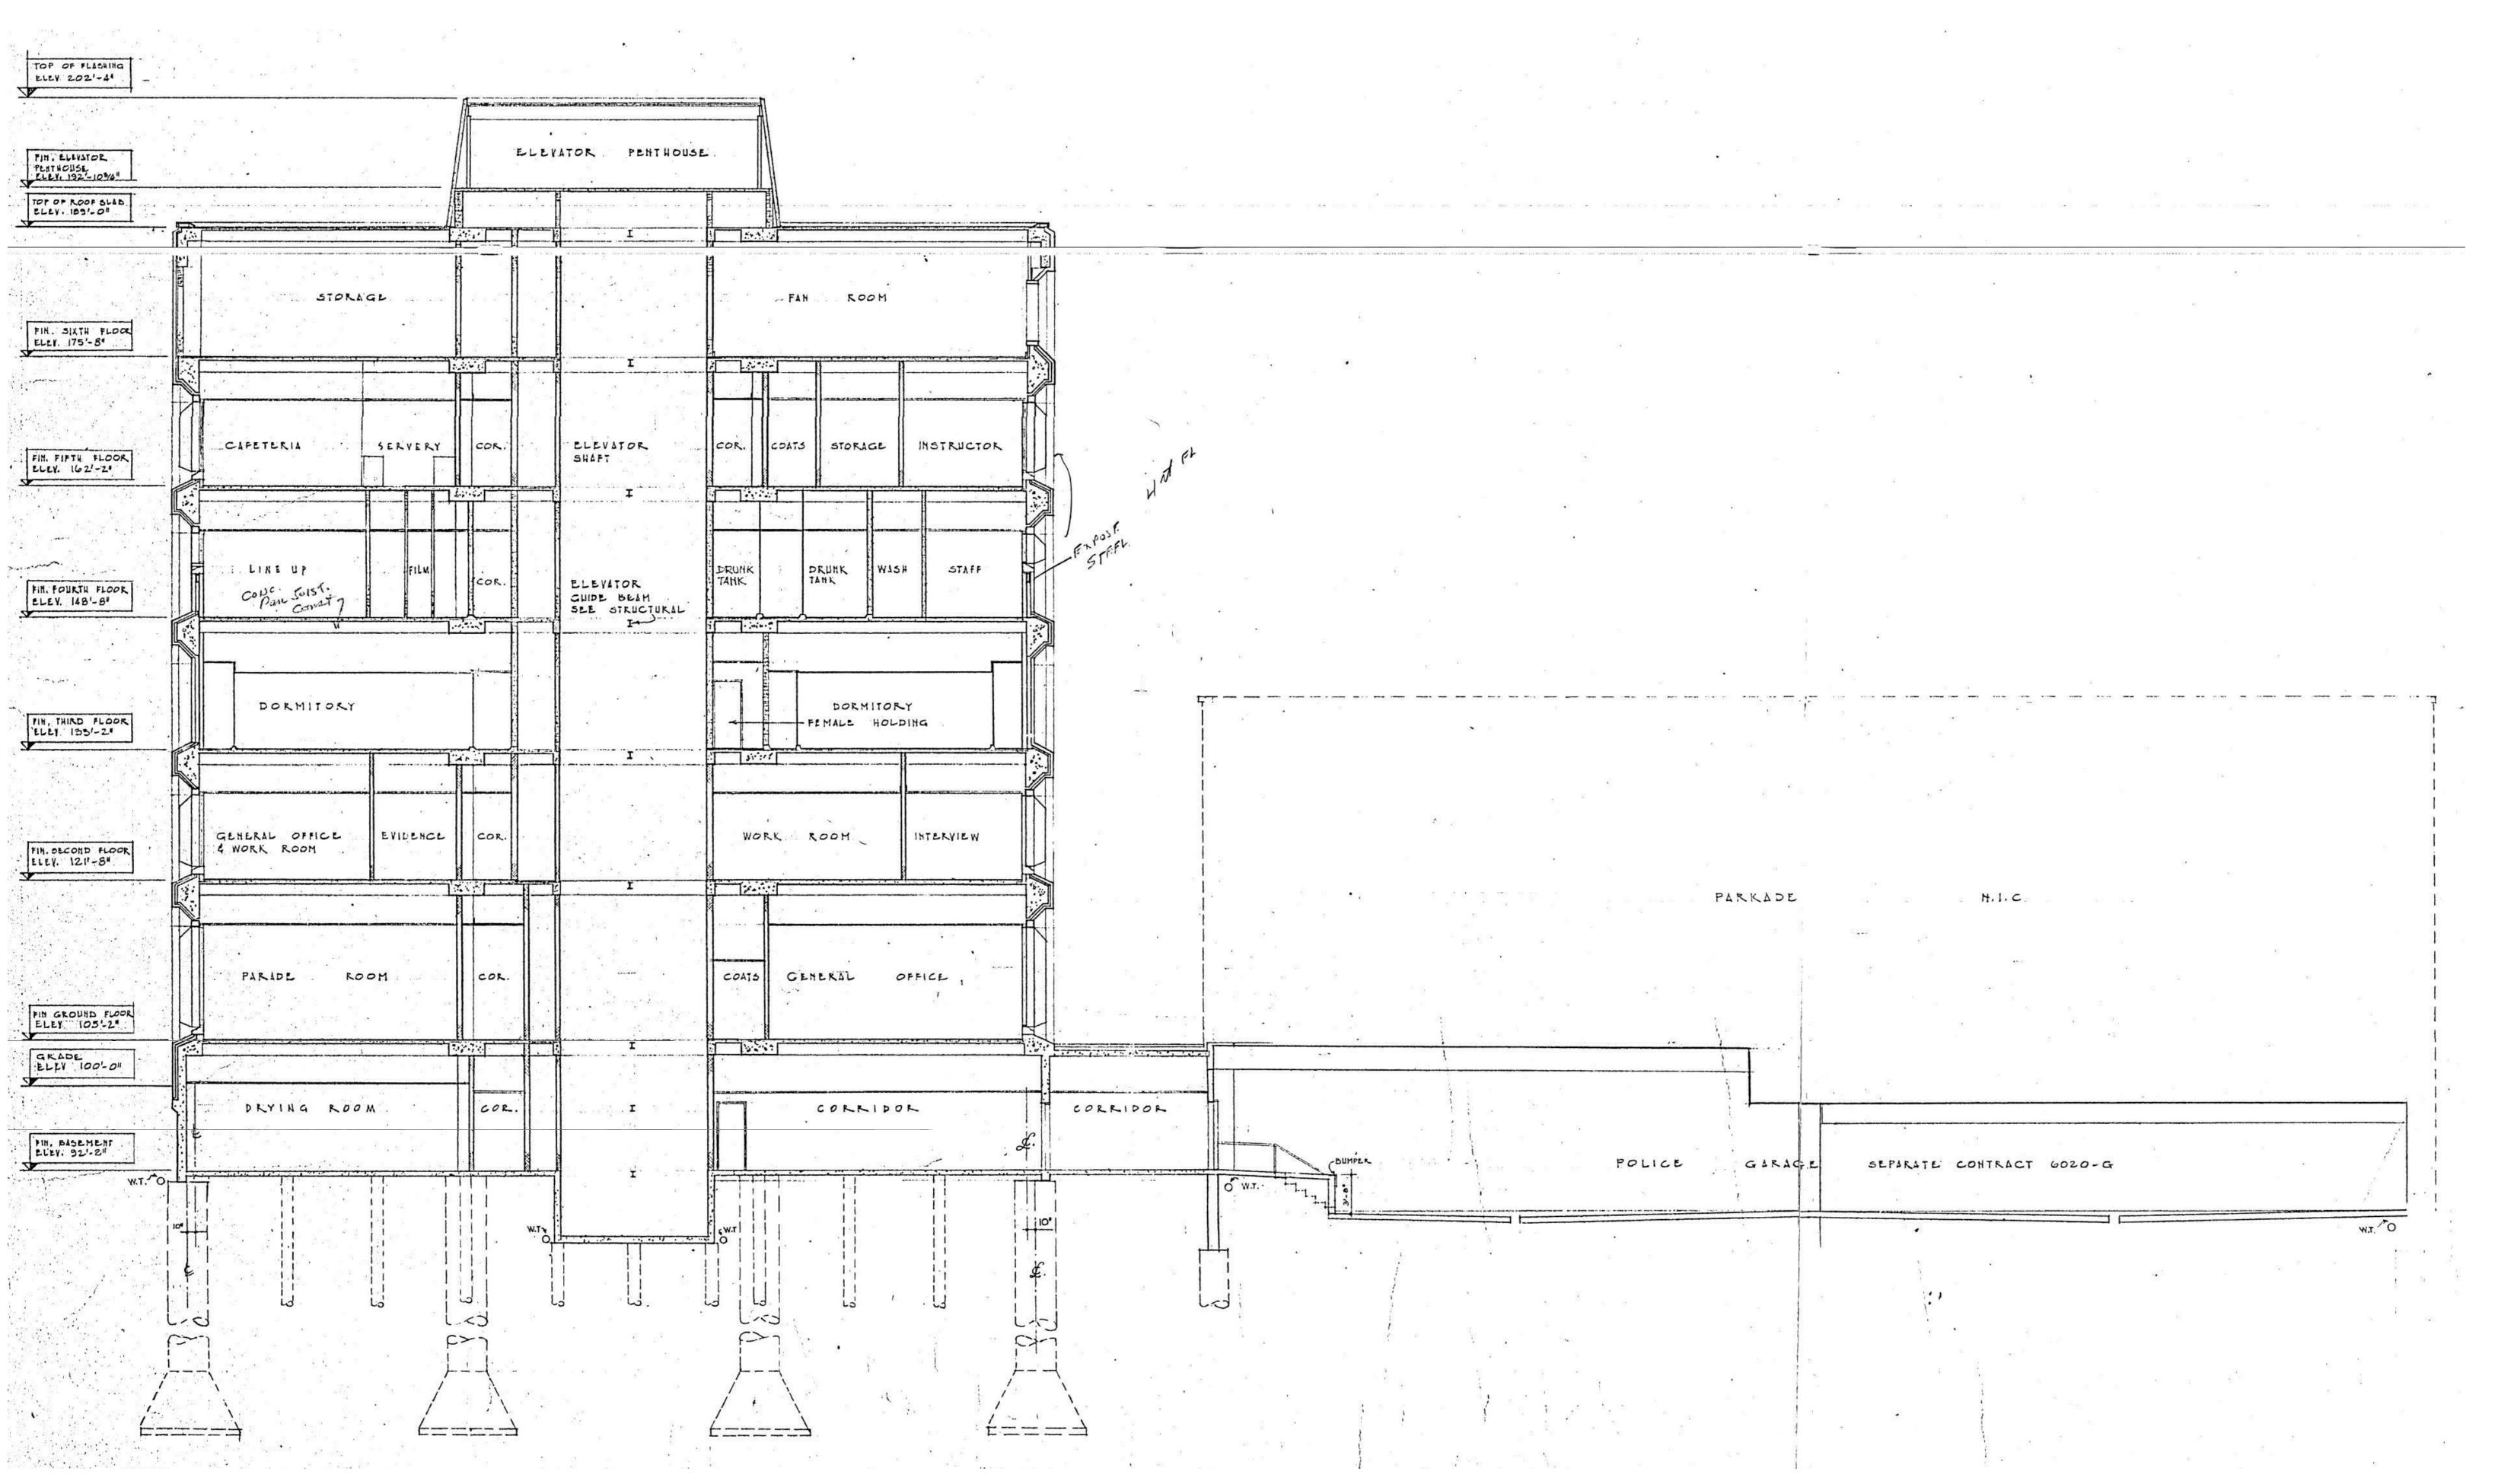

FOR REFERENCE ONLY

Client Provided Drawing.

Not for permits, pricing or other official purposes. This document has not been completed or checked and is for general

information or comment only.

ORIGINAL STAMPED BY: FIRST, LAST, XXXX DATE: YEAR.MM.DD

No. REVISION/DESCRIPTION BY DA

MT MV Designer JO
DRAWN CHECKED DESIGNED APPROVED

DRAWN CHECKED DESIGNED APPROVED

DATE 2019.04.29 USER APPROVAL

Winnipeg

THE CITY OF WINNIPEG
PLANNING, PROPERTY AND
DEVELOPMENT DEPARTMENT
MUNICIPAL ACCOMMODATIONS DIVISION
3-65 GARRY STREET, R3C 4K4

Readying the Lands at 151 & 171 Princess Street for Redevelopment Opportunity

TENDER NO. 230–2019B

151 - 171 Princess Street, Winnipeg, Manitoba

SHEET TITLE

PSB - BUILDING SECTION (FOR REFERENCE

SCALE PROJECT No: SHEET N

AS SHOWN 2016-117

ONLY)

DRAWING SHEET SIZE: A0 (1189mm x 841mm) PLOT 1:1