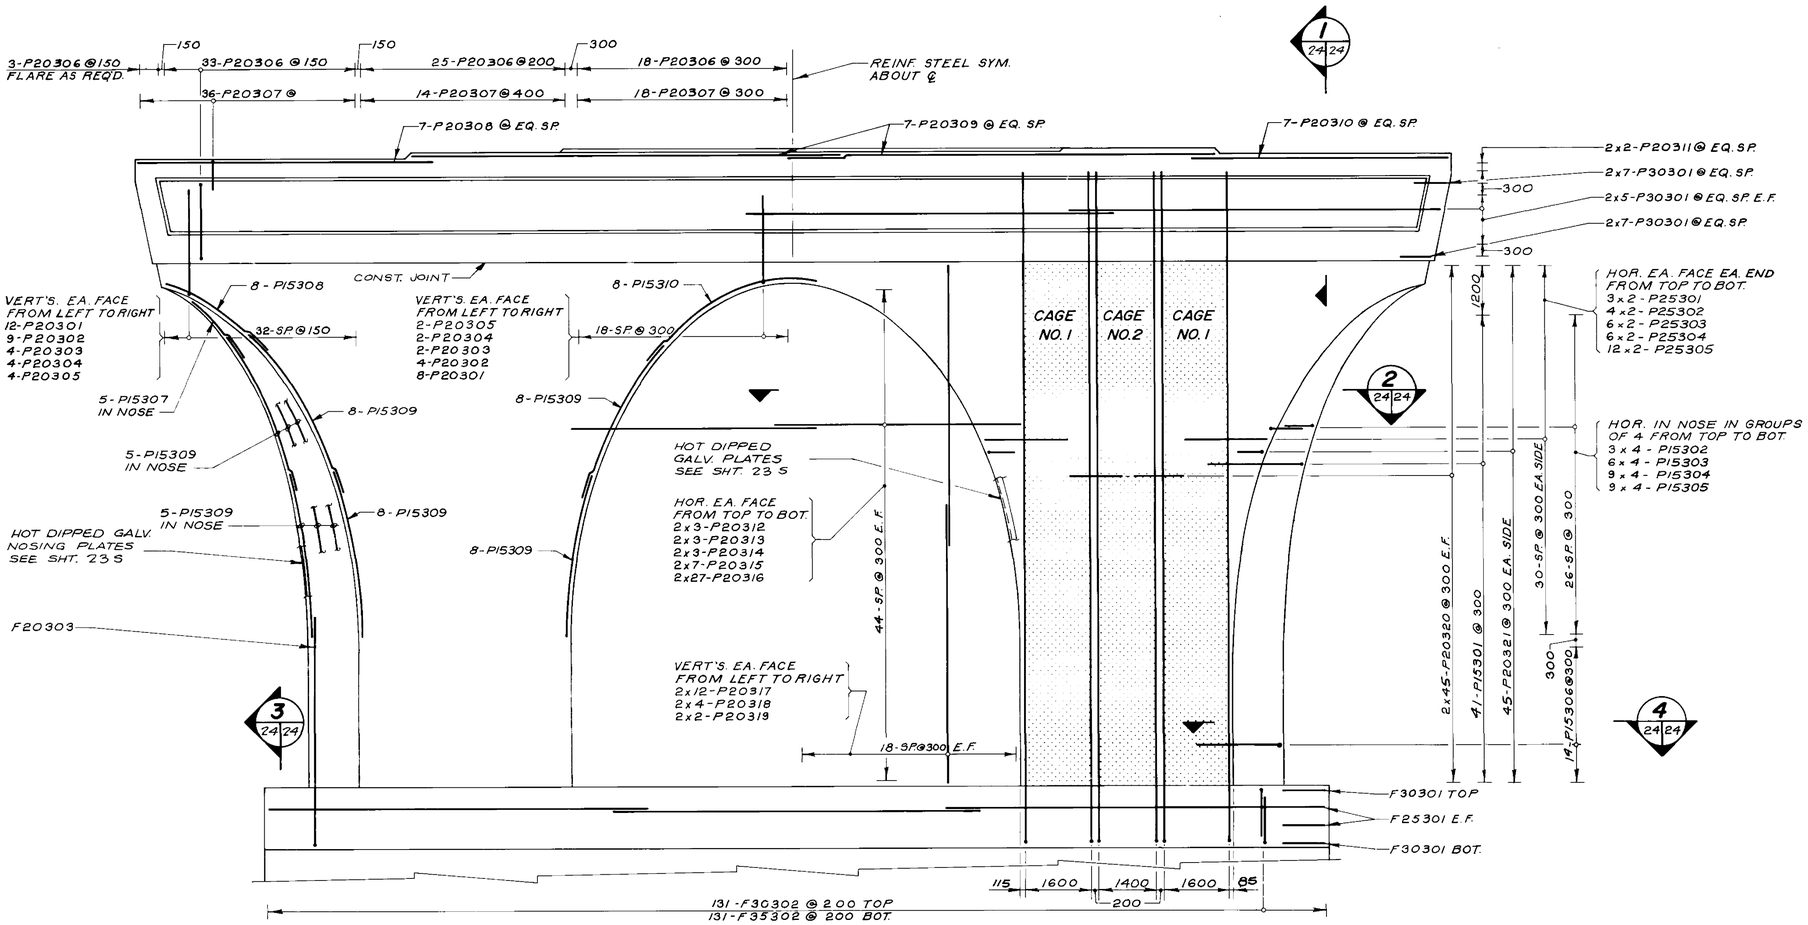

EAST SIDE ELEVATION
1:75

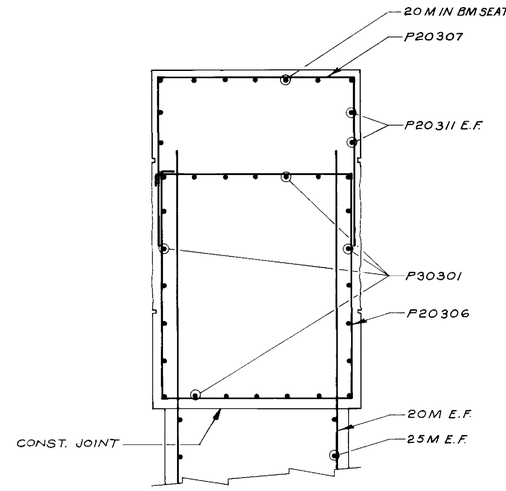

SECTION 1
1:25

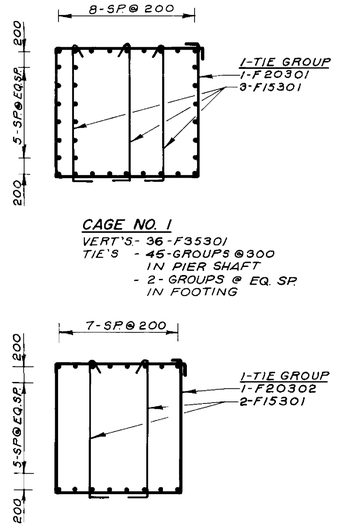

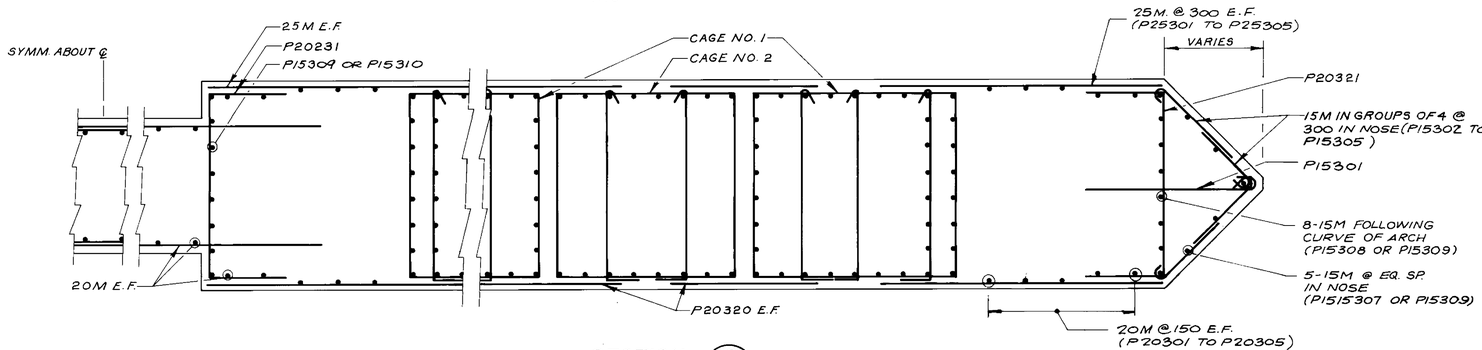

SECTION 2
1:25

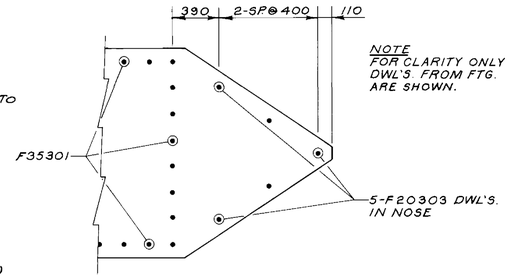

SECTION 4
1:25

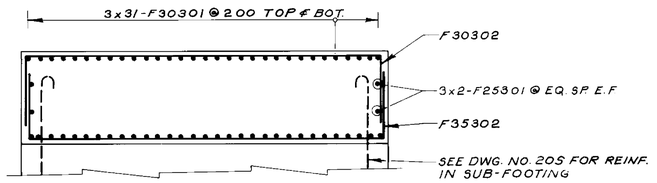

SECTION 3
1:50

RECORD DRAWING
90.11.23
APPROVED BY — DATE

LOCATION APPROVED
UNDERGROUND STRUCTURES
Y.A.
STRUCTURES COMMITTEE — DATE

NOTE
THE LOCATIONS OF UTILITIES SHOWN ARE BASED ON THE BEST INFORMATION AVAILABLE BUT NO GUARANTEE IS GIVEN THAT ALL EXISTING UTILITIES ARE SHOWN OR THAT THE SHOWN LOCATIONS ARE EXACT. THE CONTRACTOR SHALL VERIFY THE LOCATIONS OF ALL UTILITIES BEFORE COMMENCING ANY EXCAVATION AND SHALL BE RESPONSIBLE FOR THE PROTECTION OF ALL UTILITIES DURING CONSTRUCTION.

NO.	REVISIONS	DATE	BY
1	BRIDGE RAISED TO INCREASE NAVIGATION CLEARANCE.	28/04/89	

B.M.
E.L.

DILLON
Consulting Engineers • Planners
Environmental Scientists

DES'GNED BY	D.S.	CHECKED BY	S.S.R.
DRAWN BY	C.R.B.	APPROVED BY	
HOR. SCALE / VERTICAL	AS SHOWN	AUTHORIZED BY	1989-09-07 DATE
DATE	MAR. 1989	STREETS & BRIDGE ENGINEER ACCEPTED BY	DATE
		BRIDGE ENGINEER	89 09 07 DATE

ENGINEER — PROVINCE OF MANITOBA — 24/2/89 — S. S. RIHAL — REGISTERED ENGINEER
CONSULTANT DRAWING NO.

THE CITY OF WINNIPEG
WORKS AND OPERATIONS DIVISION
STREETS & TRANSPORTATION DEPARTMENT

KILDONAN CORRIDOR BRIDGE
STEEL GIRDER ALTERNATIVE
RIVER PIER SU-4
SHEET 2 OF 2

CITY DRAWING NUMBER: B216-89-24S
SHEET — OF
B-5828-26

M.M.D 1572-04