


SITE CONTEXT PLAN



NET CLIMBER TO BE REMOVED

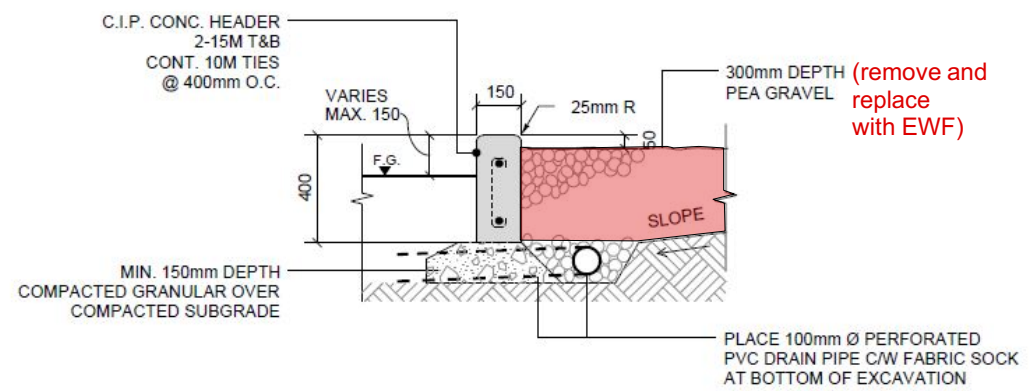

DETAIL: SAFETY SURFACING TO BE REMOVED

CONTRACTOR TO CONFIRM ALL DIMENSIONS AND REPORT ANY DISCREPANCIES TO CONTRACT ADMINISTRATOR PRIOR TO CONSTRUCTION. LOCATION OF UNDERGROUND STRUCTURES AS SHOWN ARE BASED ON THE BEST INFORMATION AVAILABLE BUT NO GUARANTEE IS GIVEN THAT ALL EXISTING UTILITIES ARE SHOWN OR THAT THE GIVEN LOCATIONS ARE EXACT. CONFIRMATION OF EXISTENCE AND EXACT LOCATION OF ALL SERVICES MUST BE OBTAINED FROM THE INDIVIDUAL UTILITIES BEFORE PROCEEDING WITH CONSTRUCTION.

DESIGNED BY IL CHECKED BY

DRAWN BY IL APPROVED BY

HORIZ. SCALE NTS
 VERT. SCALE

DATE JUNE 2020

MANAGER, PARK AND OPEN SPACES DATE

MANAGER, URBAN DESIGN DIVISION DATE

DRAWING TITLE
Vimy Ridge Memorial Park Play Equipment
Existing Conditions & Removals

SITE ADDRESS
821 Preston Avenue

DRAWING NO.
V.8-1

BID OPPORTUNITY NO.
525-2020