


**GROUND FLOOR PLAN**  
 3/32" = 1'-0"  
 TOP OF MAIN FLOOR ELEVATION = 100'-0"

- EXISTING DESIGN LIVE LOAD = 100 P.S.F.
- COORDINATE ALL EXISTING MECH/ELECT SERVICES WITH REPAIR WORK
- REFER TO S5.1 FOR CONCRETE REPAIR DETAILS
- CONCRETE REPAIR AREAS WILL BE ON-SITE IDENTIFIED BY THE CONTRACT ADMINISTRATOR IN THE PRESENCE OF AND WITH THE ASSISTANCE OF THE CONTRACTOR.
- THE CONTRACTOR IS RESPONSIBLE FOR CONFIRMATION OF SHORING REQUIREMENTS WITH THE CONTRACT ADMINISTRATOR PRIOR TO COMMENCEMENT OF DEMOLITION.

- LEGEND**
- DENOTES EXISTING 16"Ø CONCRETE PILE AND 30"x30"x6" DEEP DROP PANEL
  - DENOTES APPROX EXTENT OF SOFFIT CONCRETE REPAIR ALONG UNDERSIDE OF FLOOR
  - ▨ DENOTES TOP SURFACE REPAIR

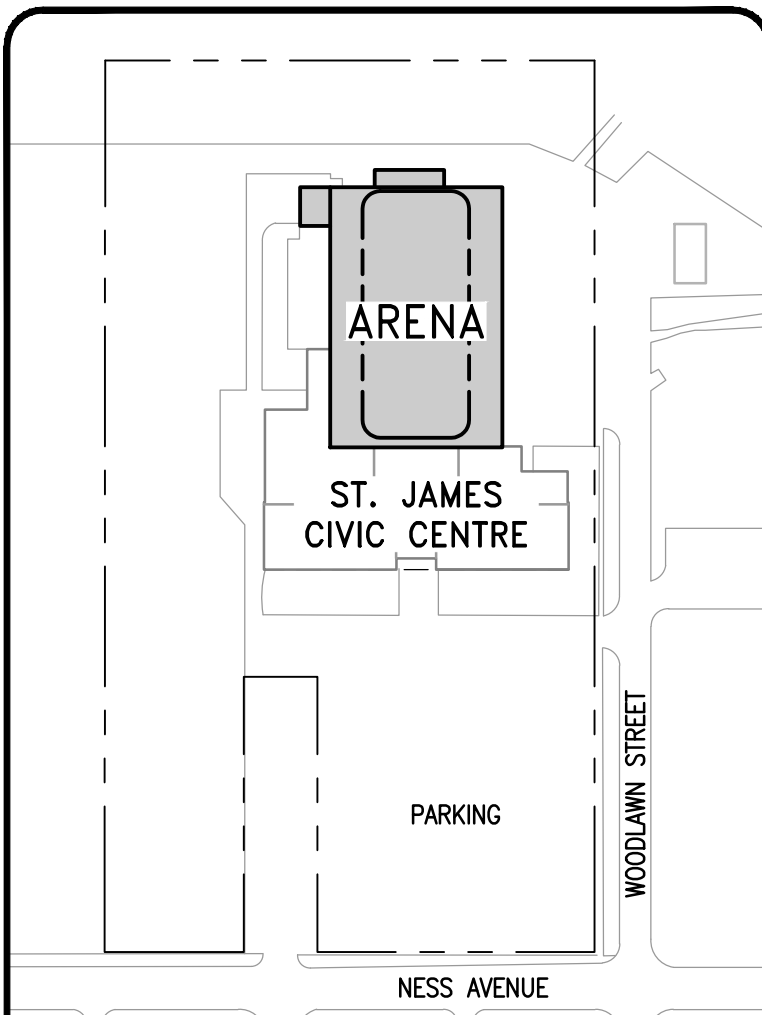

**KEY PLAN**  
NTS

The General Contractor shall check & verify all dimensions and report any errors or omissions to the designers.

No.	Date	Issue/Revision	By
1	2020-11-20	ISSUED FOR CONSTRUCTION	DJM
0	2020-10-30	ISSUED FOR CONSTRUCTION	DJM

**ENGINEERS GEOSCIENTISTS MANITOBA**  
 Certificate of Authorization  
 Crosier Kilgour & Partners Ltd.  
 No. 235



Consultant

300-275 Carlton Street  
 Winnipeg, Manitoba R3C 5R6  
 T 204-943-7501  
 F 204-943-7507

**Crosier Kilgour & Partners Ltd.**  
 CONSULTING STRUCTURAL ENGINEERS

Project  
**ST. JAMES CIVIC CENTRE**  
 ARENA CRAWLSPACE RESTORATION

2055 NESS AVENUE  
 WINNIPEG, MANITOBA

Sheet Title  
**GROUND FLOOR PLAN**

File	2020-0197	Date	2020-11-20
Design	DJM	Drawn	LOL

Revision	Sheet No.
<b>1</b>	<b>S2.2</b>