



1 BUILDING SECTION  
SCALE: 1:50

NOTE:  
 1. DEMOLISH EXISTING HAND & GUARD RAILS, RETAIN EXISTING LANDING AND STAIRS, GRATING AND MISC. METALS.  
 2. PROVIDE NEW GALVANIZED STEEL HAND & GUARD RAILS AND PAINT.  
 3. PROVIDE NEW 125mm (5") GALVANIZED KICK PLATE BAR AND PAINT.

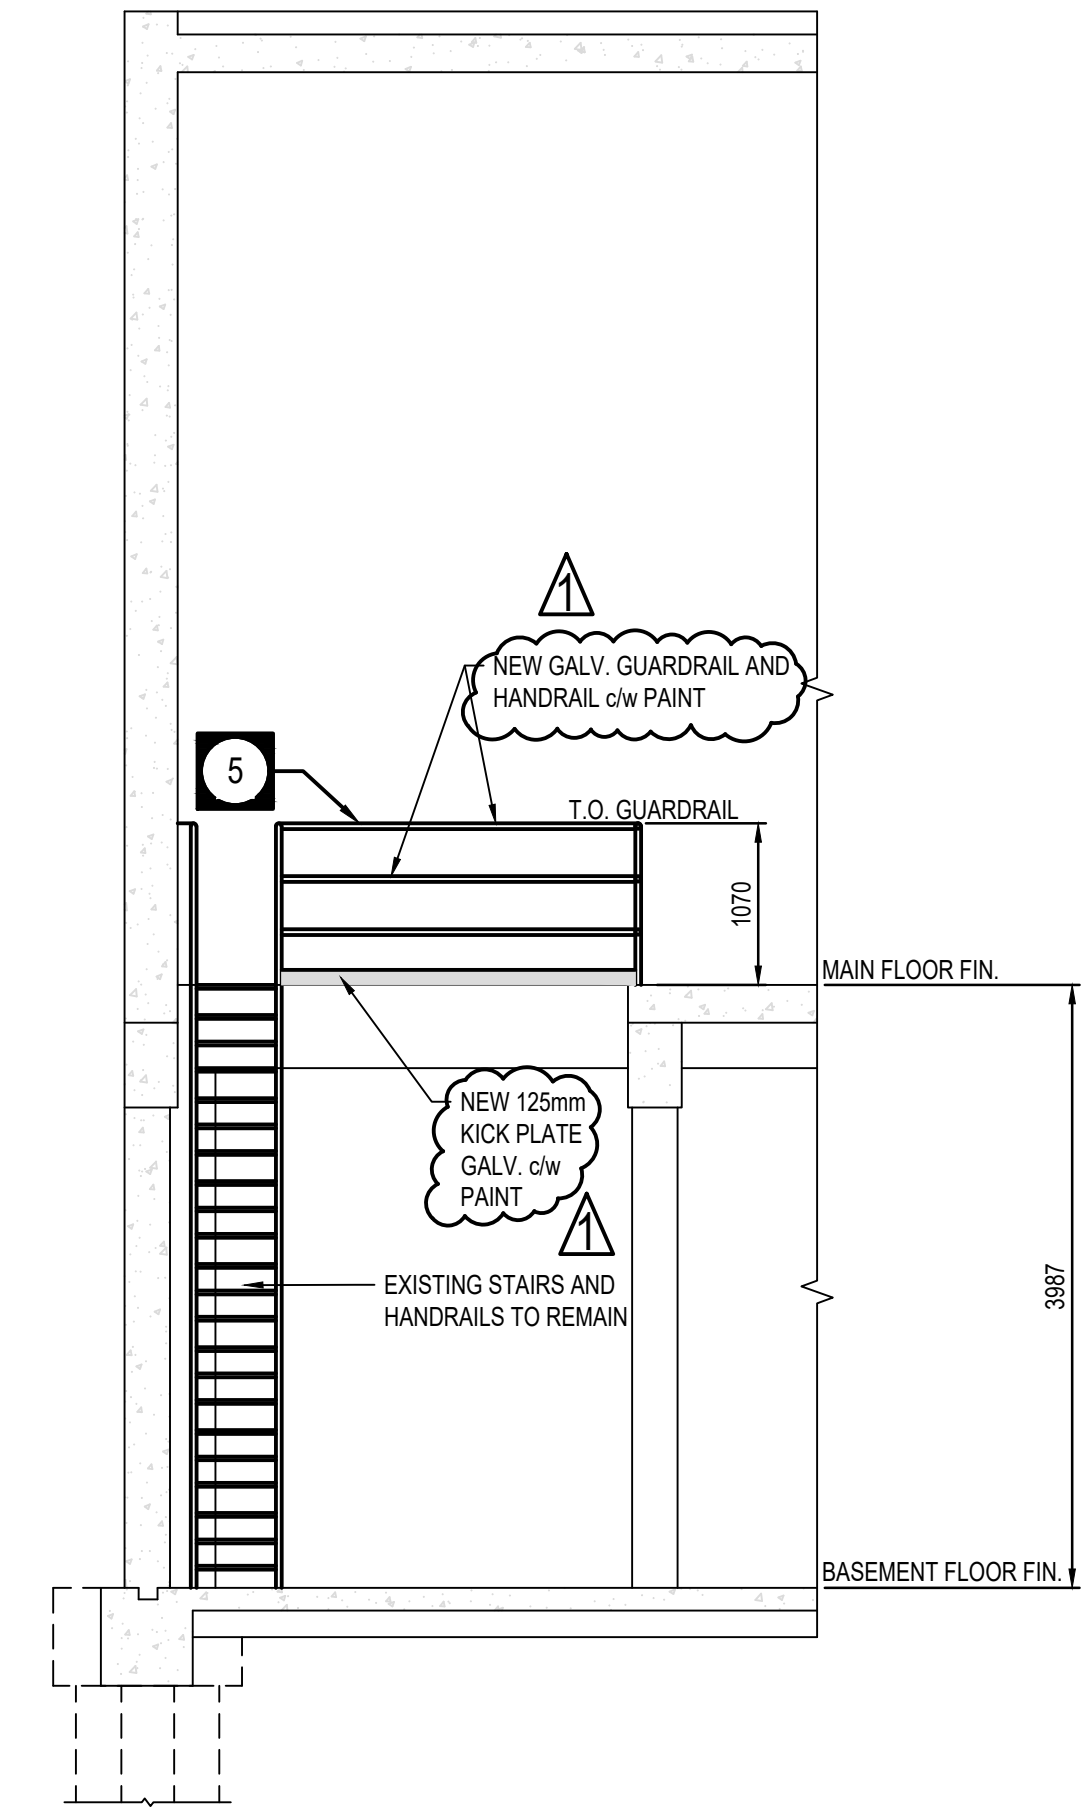

2 SECTION DETAIL  
SCALE: 1:50

TACHE BOOST PUMPING STATION REPAIR LEGEND	
KEYNOTE REMEDIATION ACTION	
1	REPOINT MORTAR JOINTS AS REQUIRED ON CHIMNEY, AND INSTALL NEW ALUMINUM CHIMNEY CAP. REFER TO BUILDING ELEVATIONS.
5	REPLACE EXISTING GUARD AND STAIR RAILING TO CURRENT CODE
8	REPOINT MORTAR JOINTS ON GLASS BLOCKS BOTH EXTERIOR AND INTERIOR AS REQUIRED THROUGHOUT
9	REPLACE BROKEN GLASS BLOCKS AS REQUIRED THROUGHOUT

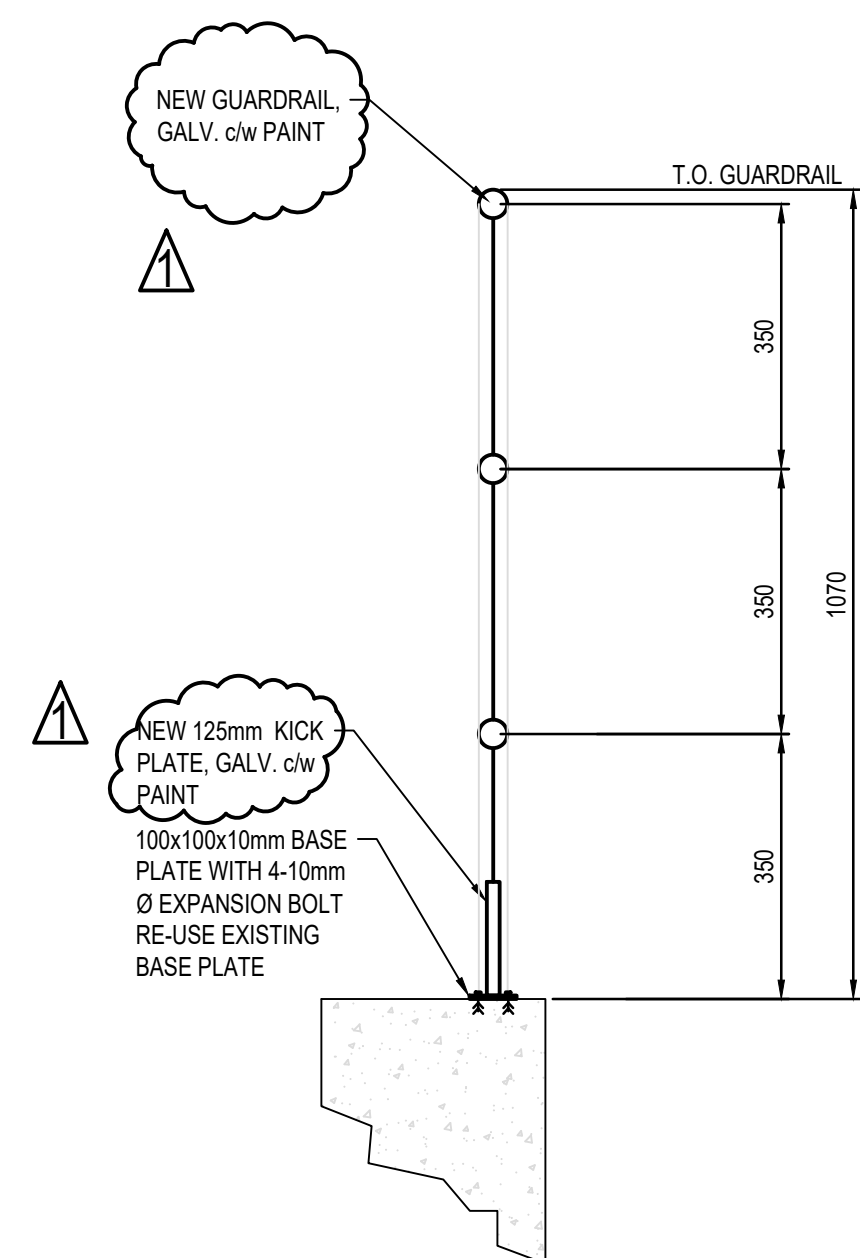

3 SECTION DETAIL  
SCALE: 1:10



NO.	REVISIONS	DATE	DESIGN	CHECK
1	ISSUED FOR ADDENDUM 4	2022-11-14	KS	MH
0	ISSUED FOR CONSTRUCTION	2022-10-11	KS	MH

<b>AECOM</b>	
DESIGNED BY: K. SIDDALL	CHECKED BY: M. HOQUE
DRAWN BY: G. PROFETA	APPROVED BY:
SCALE:	RELEASED FOR CONSTRUCTION BY:
DATE: 2022-11-14	DATE:
CONSULTANT NO.: 60661011	

**THE CITY OF WINNIPEG**  
WATER AND WASTE DEPARTMENT

TACHE BOOSTER PUMPING STATION  
AND SURGE TOWER UPGRADES  
ARCHITECTURAL  
TACHE BOOSTER PUMPING STATION REMEDIATION  
BUILDING SECTION

CITY DRAWING NUMBER 1-0660M-B0007-001	SHEET 6 of 13	REV. 1	SIZE A1
--	------------------	-----------	------------

LAST SAVE: 2022/11/01 12:45 PM  
 PATH: L:\Logos\CAD\PS1\FP001\Drawings\Projects\60661011\0660M-B0007-001-SHEETS\Architectural\CAD\_Line\_15/2022/0006.dwg